
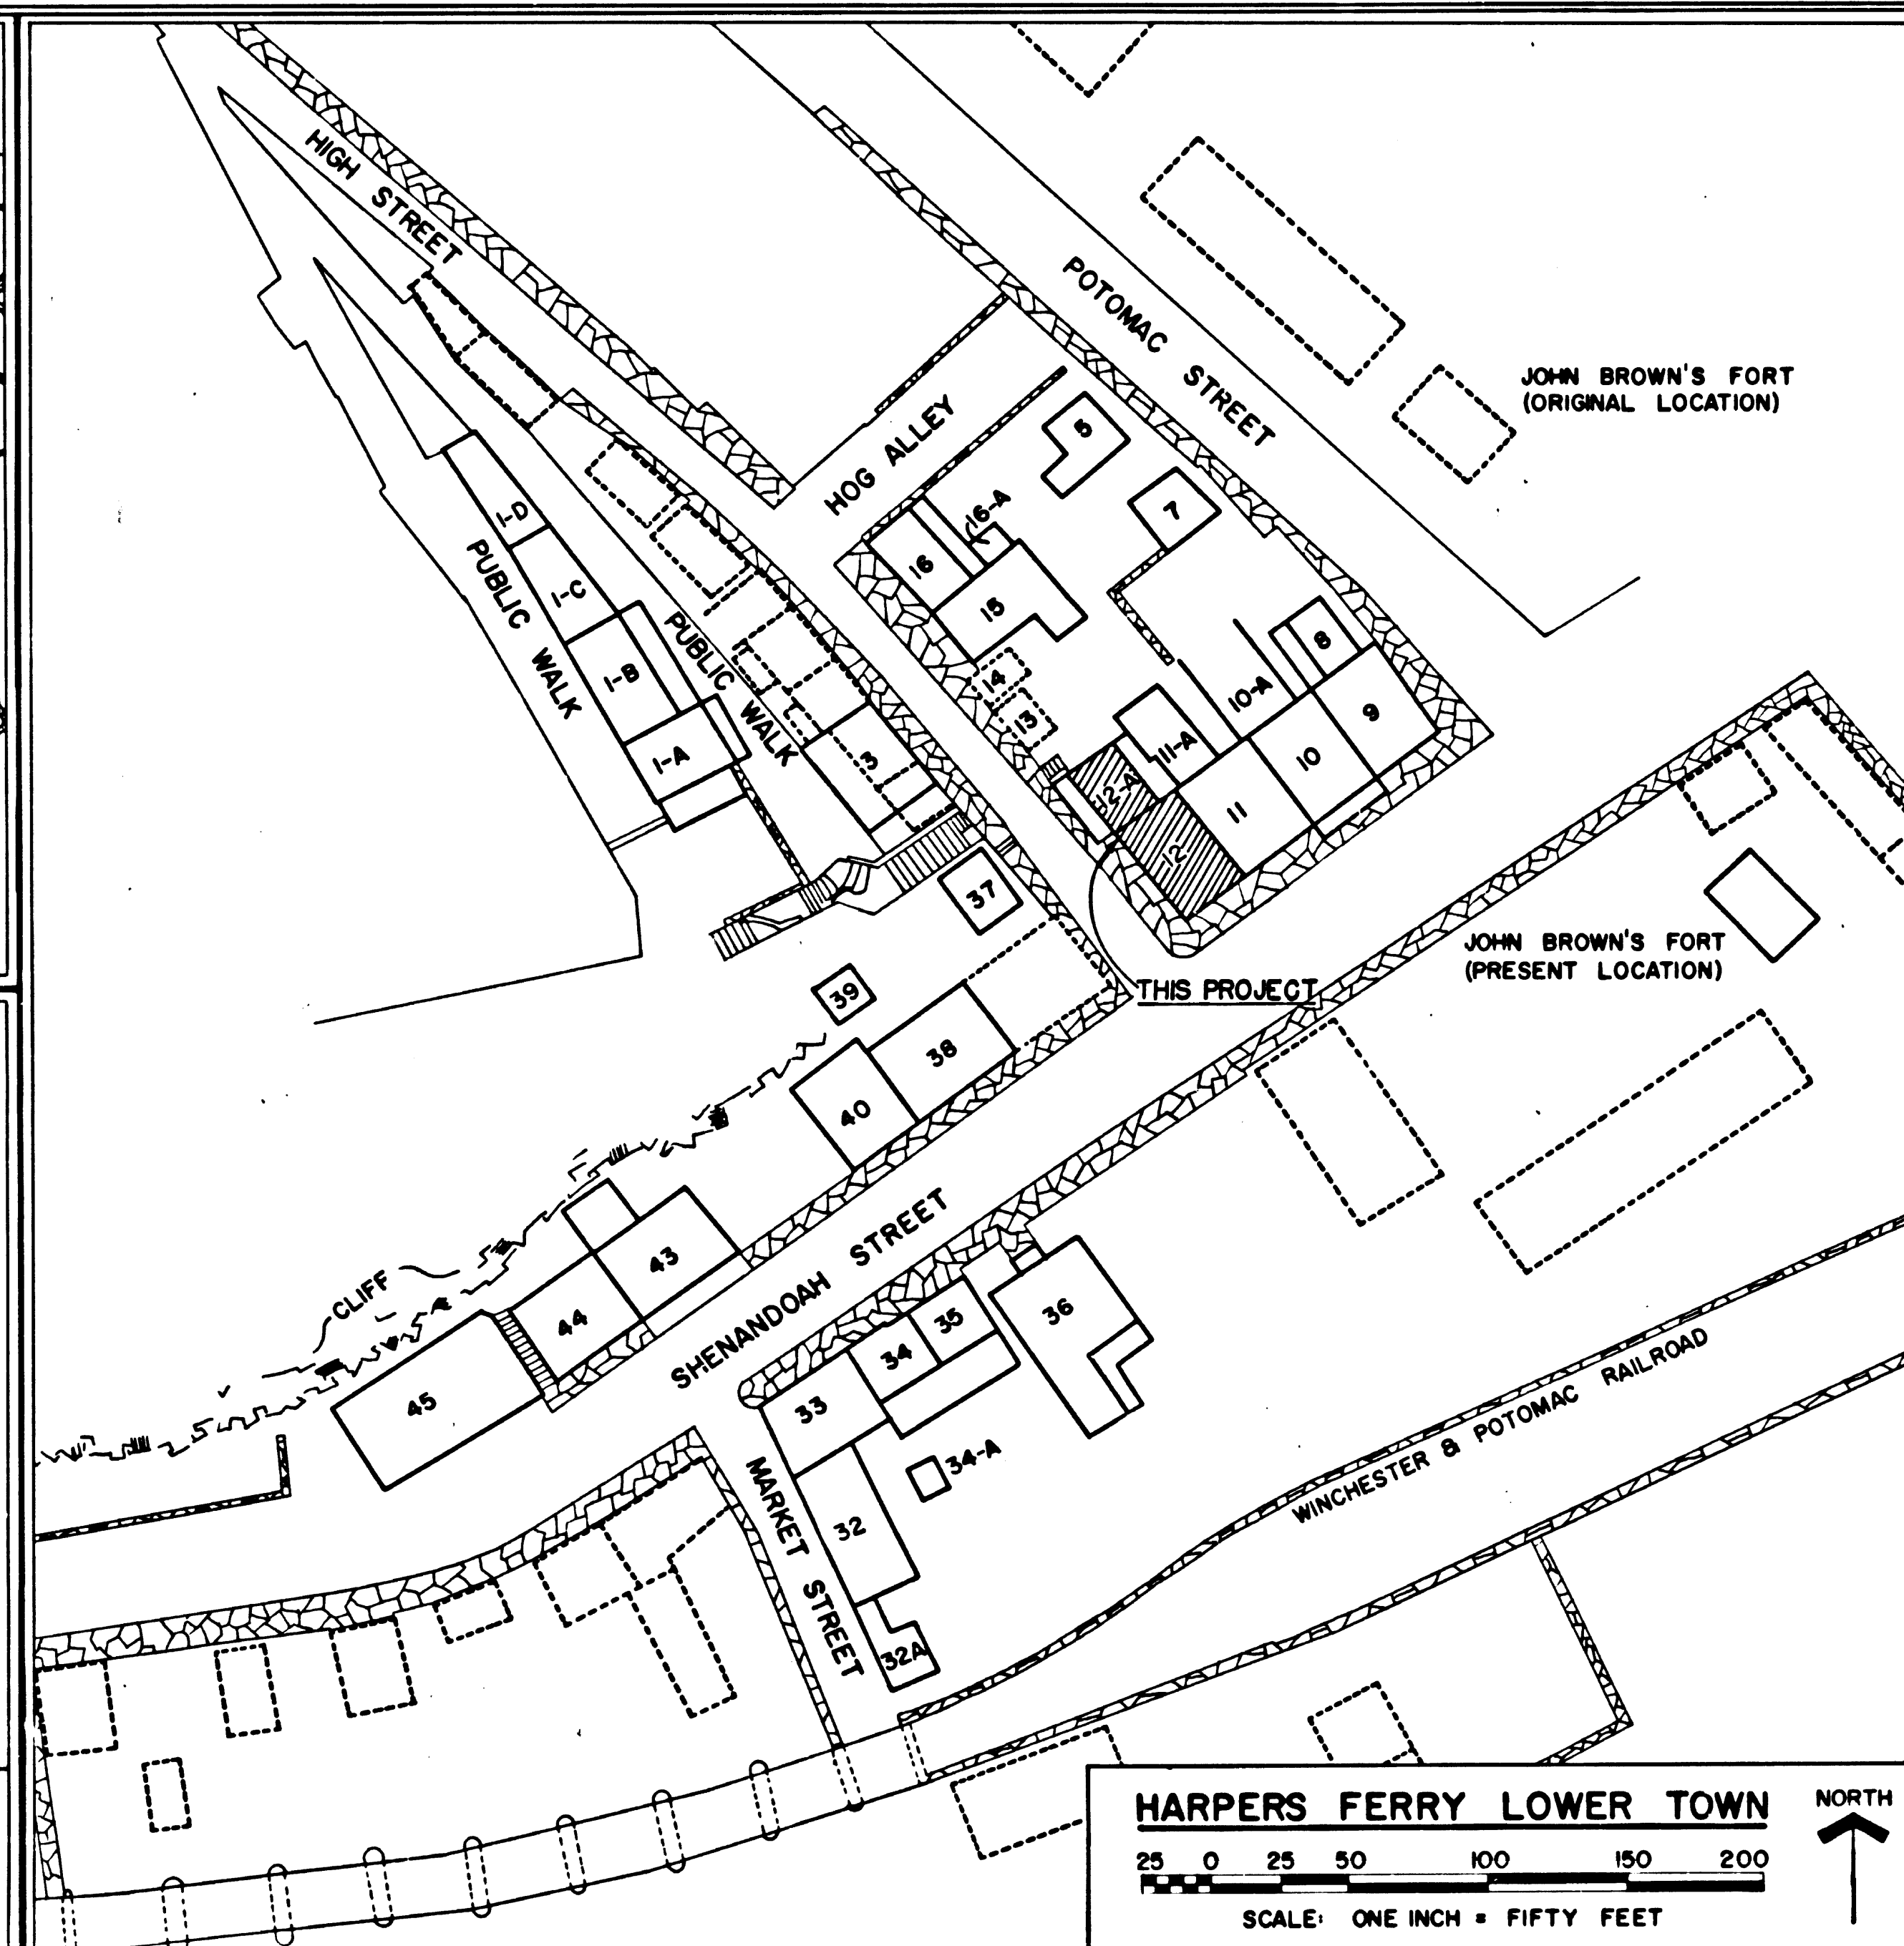
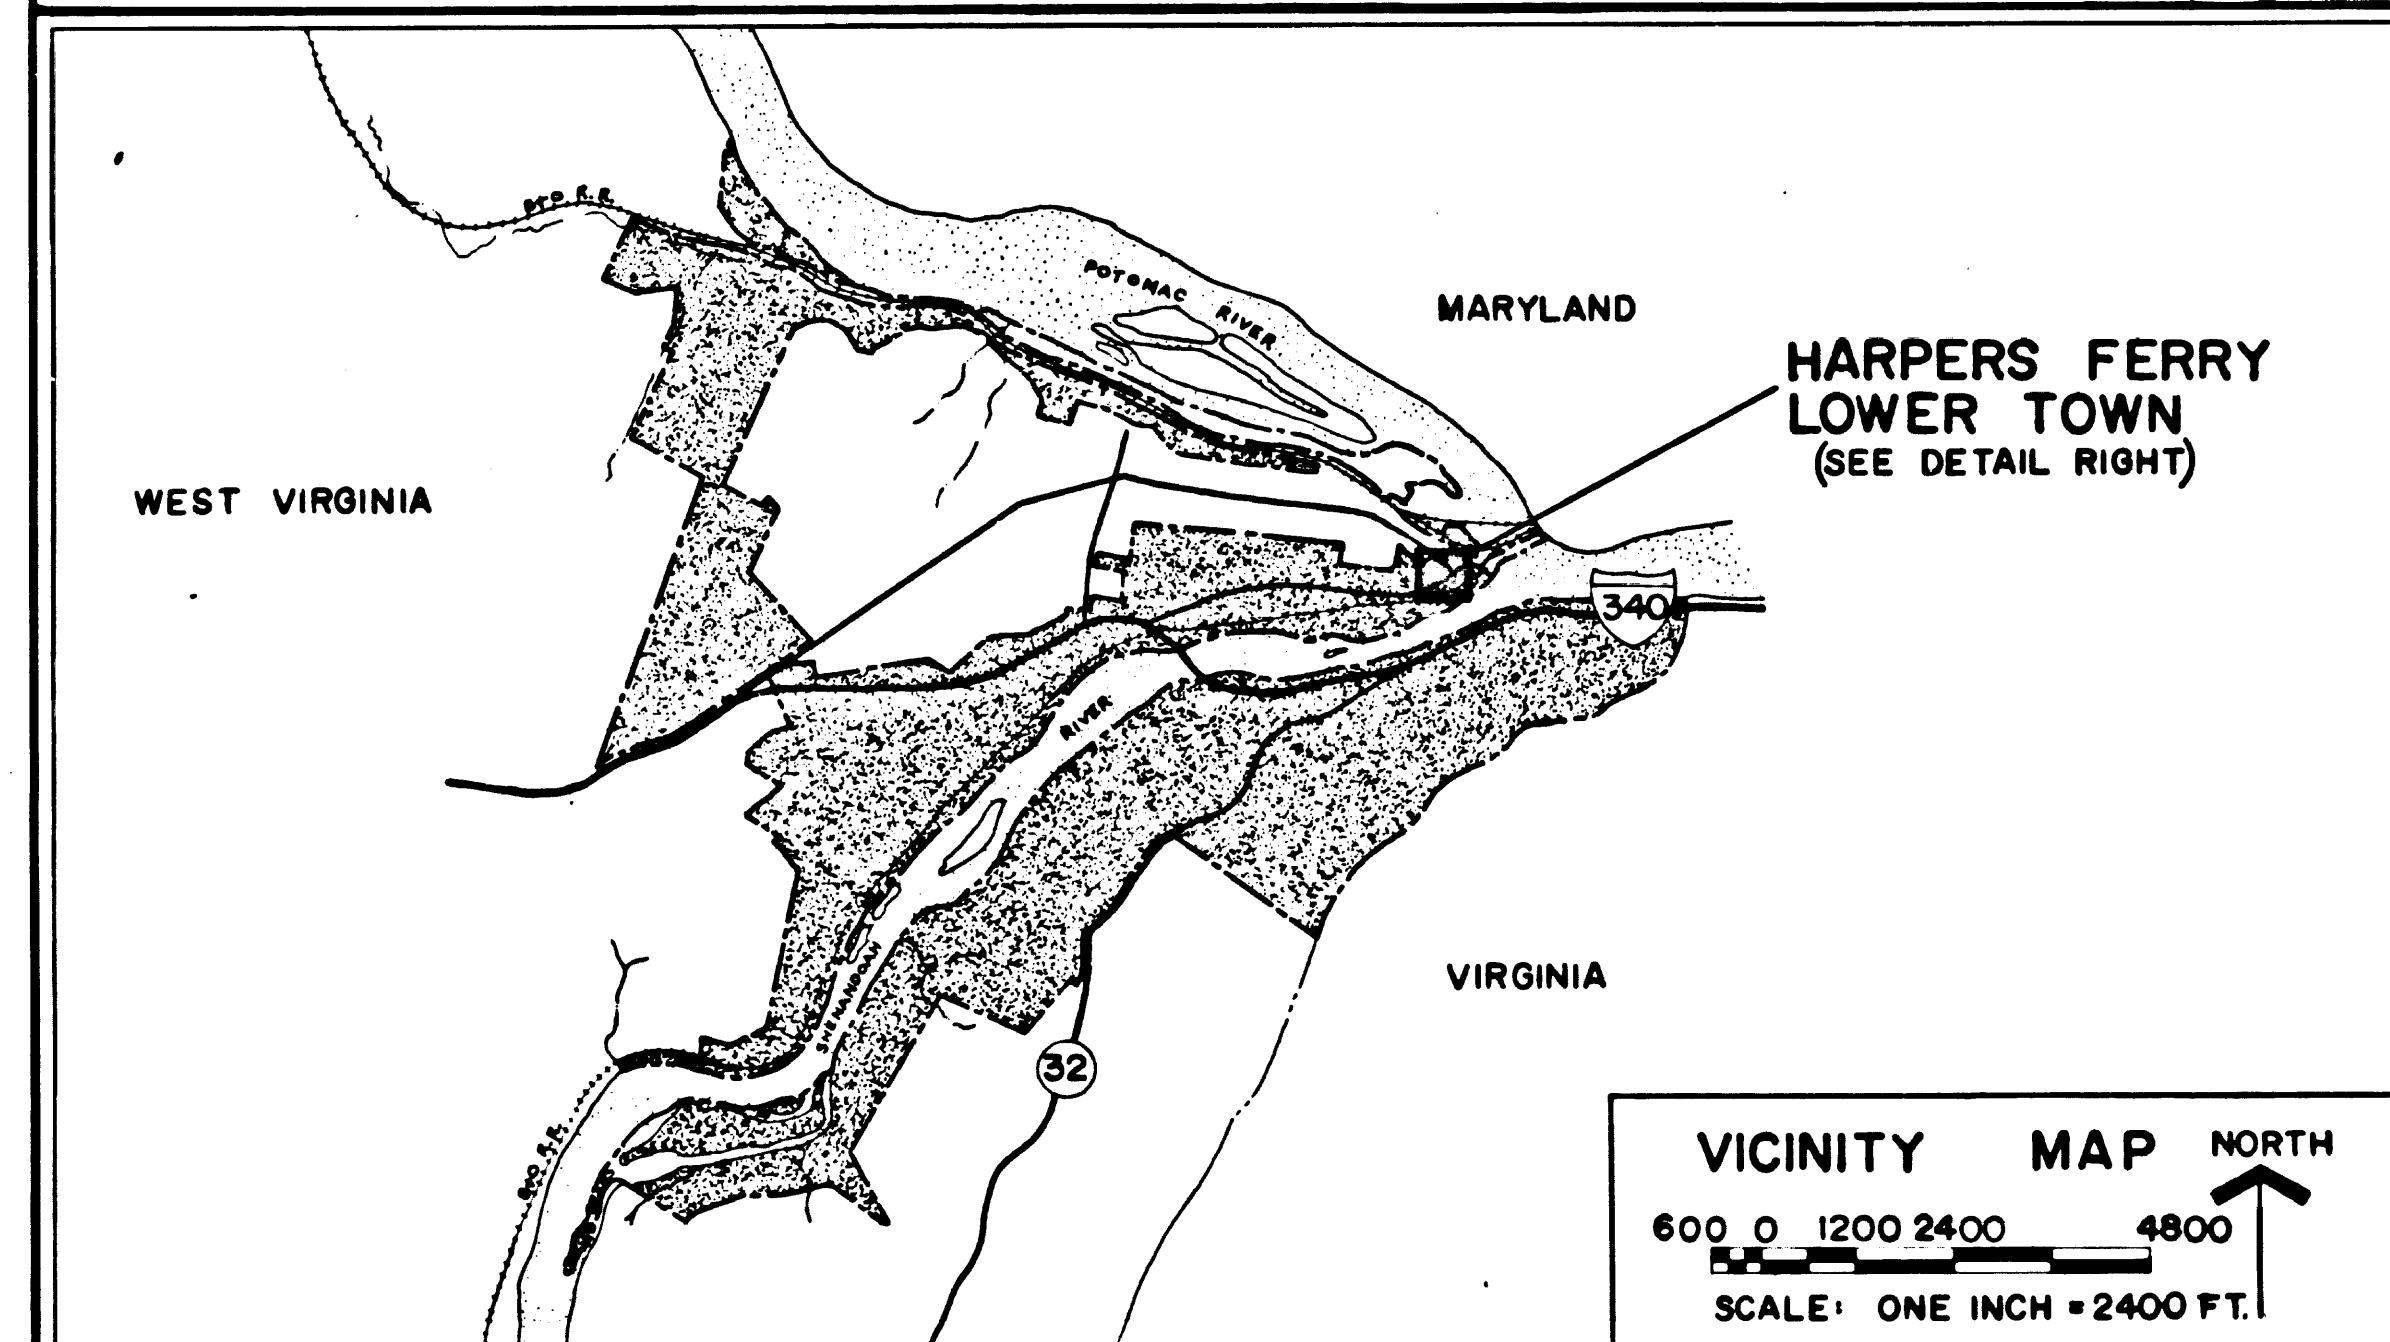


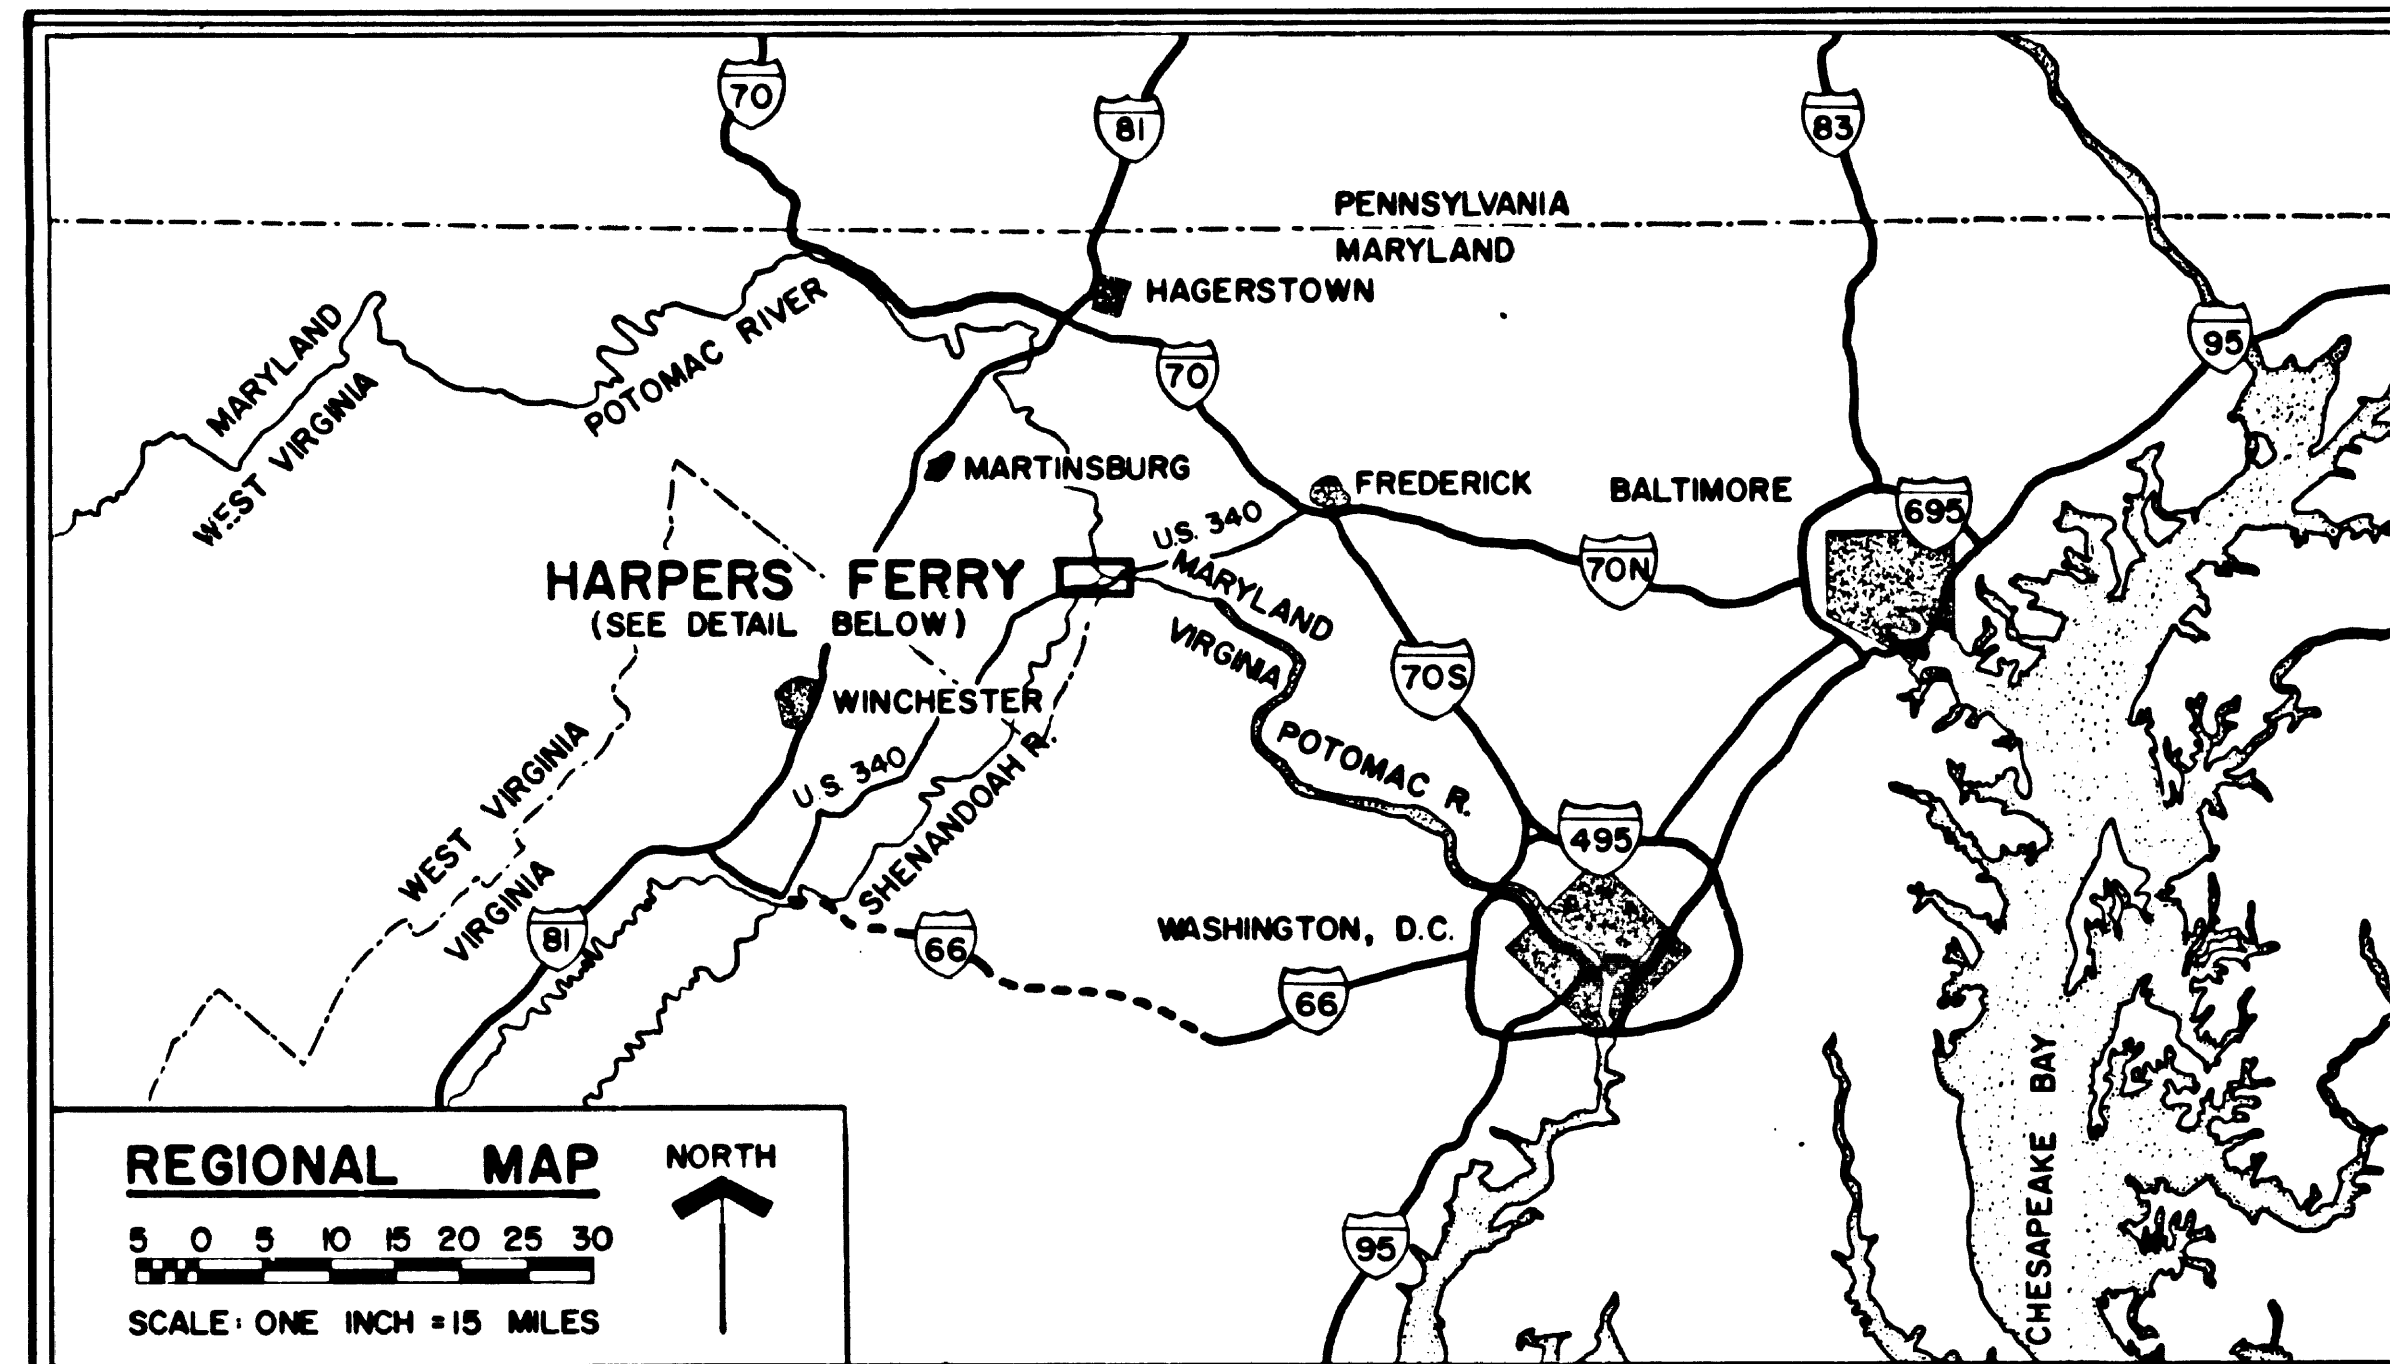

INDEX TO DRAWINGS

- COVER SHEET
- SITE PLAN & SIDEWALK DETAILS
- BASEMENT PLAN & DETAILS
- 1ST FLOOR PLAN & DETAILS
- 2ND FLOOR PLAN & DETAILS
- 3RD FLOOR PLAN & DETAILS
- 4TH FLOOR PLAN & DETAILS
- EAST & WEST ELEVATIONS - BLDG. 12 & 12A
- SOUTH ELEVATIONS - BLDG. 12 & 12A
- LONGITUDINAL SECTION - BLDG. 12 & 12A
- SECTION BLDG. 12 & 12A
- SECTIONS BLDG. 12 & 12A
- SECTION BLDG. 12 & 12A, INTERIOR STAIRS
- WALL SECTION - EAST WALL - BLDG. 12
- WALL SECTION - NORTH WALL - BLDG. 12-A
- SOUTH ELEVATION PORCH BLDG. 12-A
- STAIR DETAILS, PORCH BLDG. 12-A
- F.S. STAIR DETAILS, PORCH BLDG. 12-A
- EXTERIOR STAIRS & SIDEWALK BULKHEAD
- CAST IRON BALCONY RAILING DETAIL, BLDG. 12
- BALCONY DETAILS - BLDG. 12
- FINISH SCHEDULE
- INTERIOR ELEVATIONS - BLDG. 12
- INTERIOR ELEVATIONS - BLDG. 12
- INTERIOR ELEVATIONS - BLDG. 12-A
- EXISTING FIREPLACE MANTELS
- DOOR & WINDOW SCHEDULE
- F.S. BASEMENT DOOR DETAILS - BLDG. 12 & 12A
- F.S. EXT. DOOR DETAIL - BLDG. 12
- F.S. EXT. DOOR DETAIL - BLDG. 12-A
- F.S. INTERIOR DOOR DETAIL - BLDG. 12 (1st & 2nd FL.)
- F.S. INTERIOR DOOR DETAIL - BLDG. 12 (3rd & 4th FL.)
- F.S. INTERIOR DOOR DETAIL - BLDG. 12A
- F.S. BASEMENT WINDOW DETAILS - BLDG. 12 & 12A
- F.S. WINDOW DETAILS - BLDG. 12 CRONAFLEX
- F.S. WINDOW DETAILS - BLDG. 12A (1st FL.)
- F.S. WINDOW DETAILS - BLDG. 12A (S. WALL 2nd FL.)
- F.S. WINDOW DETAILS - BLDG. 12A (W & N WALLS 2nd FL.)
- F.S. SHUTTER DETAILS - BLDG. 12
- F.S. GUTTER & DOWNSPOUT DETAILS - BLDG. 12 & 12A
- F.S. JACK ARCH DETAIL - BLDG. 12
- F.S. JACK ARCH DETAIL - BLDG. 12
- F.S. JACK ARCH DETAIL - BLDG. 12
- F.S. JACK ARCH DETAIL - BLDG. 12A
- F.S. JACK ARCH DETAIL - BLDG. 12A
- BASEMENT PLAN & DETAILS
- 1st FLOOR PLAN & DETAILS
- 2nd FLOOR PLAN & DETAILS
- 3rd FLOOR PLAN & DETAILS
- 4th FLOOR PLAN & DETAILS
- FRAMING SECTIONS - BLDG. 12 & 12A
- FRAMING SECTIONS - BLDG. 12 & 12A
- FRAMING SECTIONS - BLDG. 12
- FRAMING SECTIONS - BLDG. 12 & 12A
- STAIR FRAMING ISOMETRIC - BLDG. 12
- STAIR FRAMING ISOMETRIC - BLDG. 12
- WALL SECTIONS - BLDG. 12 & 12A
- WALL SECTIONS - BLDG. 12 & 12A
- BASEMENT PLAN - BLDG. 12 & 12A
- 1st FLOOR PLAN - BLDG. 12 & 12A
- 2nd FLOOR PLAN - BLDG. 12 & 12A
- 3rd FLOOR PLAN - BLDG. 12 & 12A
- 4th FLOOR PLAN - BLDG. 12 & 12A
- ELECTRICAL DETAILS
- BASEMENT DRAINAGE PLAN - BLDG. 12 & 12A

IFB - 3850 - 73A PROJECT NO.

CONTRACT NO. CX-3000-8-9017
PROJECT SUPERVISOR: CHARLES WOLFORD
CONTRACTOR: W. HARLEY MILLER, INC.
125 SOUTH CHURCH ST.
MARTINSBURG, W. VA.

AS-CONSTRUCTED DRAWINGS

Code	REVISION	Date	Initial
A	AS CONSTRUCTED	4/6/65	GLS

CONSTRUCTION DRAWING
This drawing has been prepared in compliance with the Historic Structures Report.
Approved by JACK FISH
DIRECTOR NCR
Date 8/4/71
Checked by [Signature] DSC

BRANCH OF HISTORIC PRESERVATION
UNITED STATES
DEPARTMENT OF THE INTERIOR
NATIONAL PARK SERVICE
DENVER SERVICE CENTER
NATIONAL CAPITAL TEAM

PREPARED
RSJ/WLB
DESIGNED
JACOBS
DRAWN
BARLOW
CHECKED
8-78
DATE


TITLE OF DRAWING
PHASE II-B RESTORATION
LOCATION WITHIN PARK
BUILDING 12 & 12A LOWER TOWN
NAME OF PARK
HARPERS FERRY NATIONAL HISTORIC PARK
N. C. R. JEFFERSON W. VA.
REGION COUNTY STATE


DRAWING NO.
385
25006 A
PCIP
PKG
J10
SHEET
1
OF 65

ABBREVIATIONS					
A.B.	ANCHOR BOLT	F.H.	FLAT HEAD	REQ'D	REQUIRED
APPROX.	APPROXIMATE	FIN	FINISH	RM	ROOM
BD	BOARD	FL/FLR	FLOOR	SECT	SECTION
BLDG	BUILDING	FS	FULL SIZE	SHT	SHEET
BLK	BLOCK	GA	GAUGE	SIM	SIMILAR
CMU	CONCRETE MASONRY UNIT	GALV	GALVANIZE	STL	STEEL
COL	COLUMN	HIST	HISTORIC	STRUCT	STRUCTURAL
CONC	CONCRETE	HORIZ	HORIZONTAL	T & B	TOP AND BOTTOM
CONN	CONNECTION	HP	HIGH POINT	T & G	TONGUE AND GROOVE
CONST	CONSTRUCTION	JT	JOINT	TYP	TYPICAL
CONT	CONTINUOUS	MAX	MAXIMUM	WD	WOOD
CR(S)	COURSE(S)	MET	METAL	WI	WROUGHT IRON
CSK	COUNTERSINK	MIN	MINIMUM		
DET/DTL	DETAIL	MO	MASONRY OPENING		
DIA	DIAMETER	NIC	NOT IN CONTRACT		
DWG	DRAWING	NO	NUMBER		
EA	EACH	NOM	NOMINAL		
EL/ELEV	ELEVATION	NPS	NATIONAL PARK SERVICE		
EQ	EQUAL	OC	ON CENTER		
EXIST	EXISTING	OPNG	OPENING		
EXP	EXPANSION/EXPOSURE	OPP	OPPOSITE		
EXT	EXTERIOR	ORIG	ORIGINAL		

REDUCED SIZE REPRODUCTION


Harpers Ferry N. H. P.

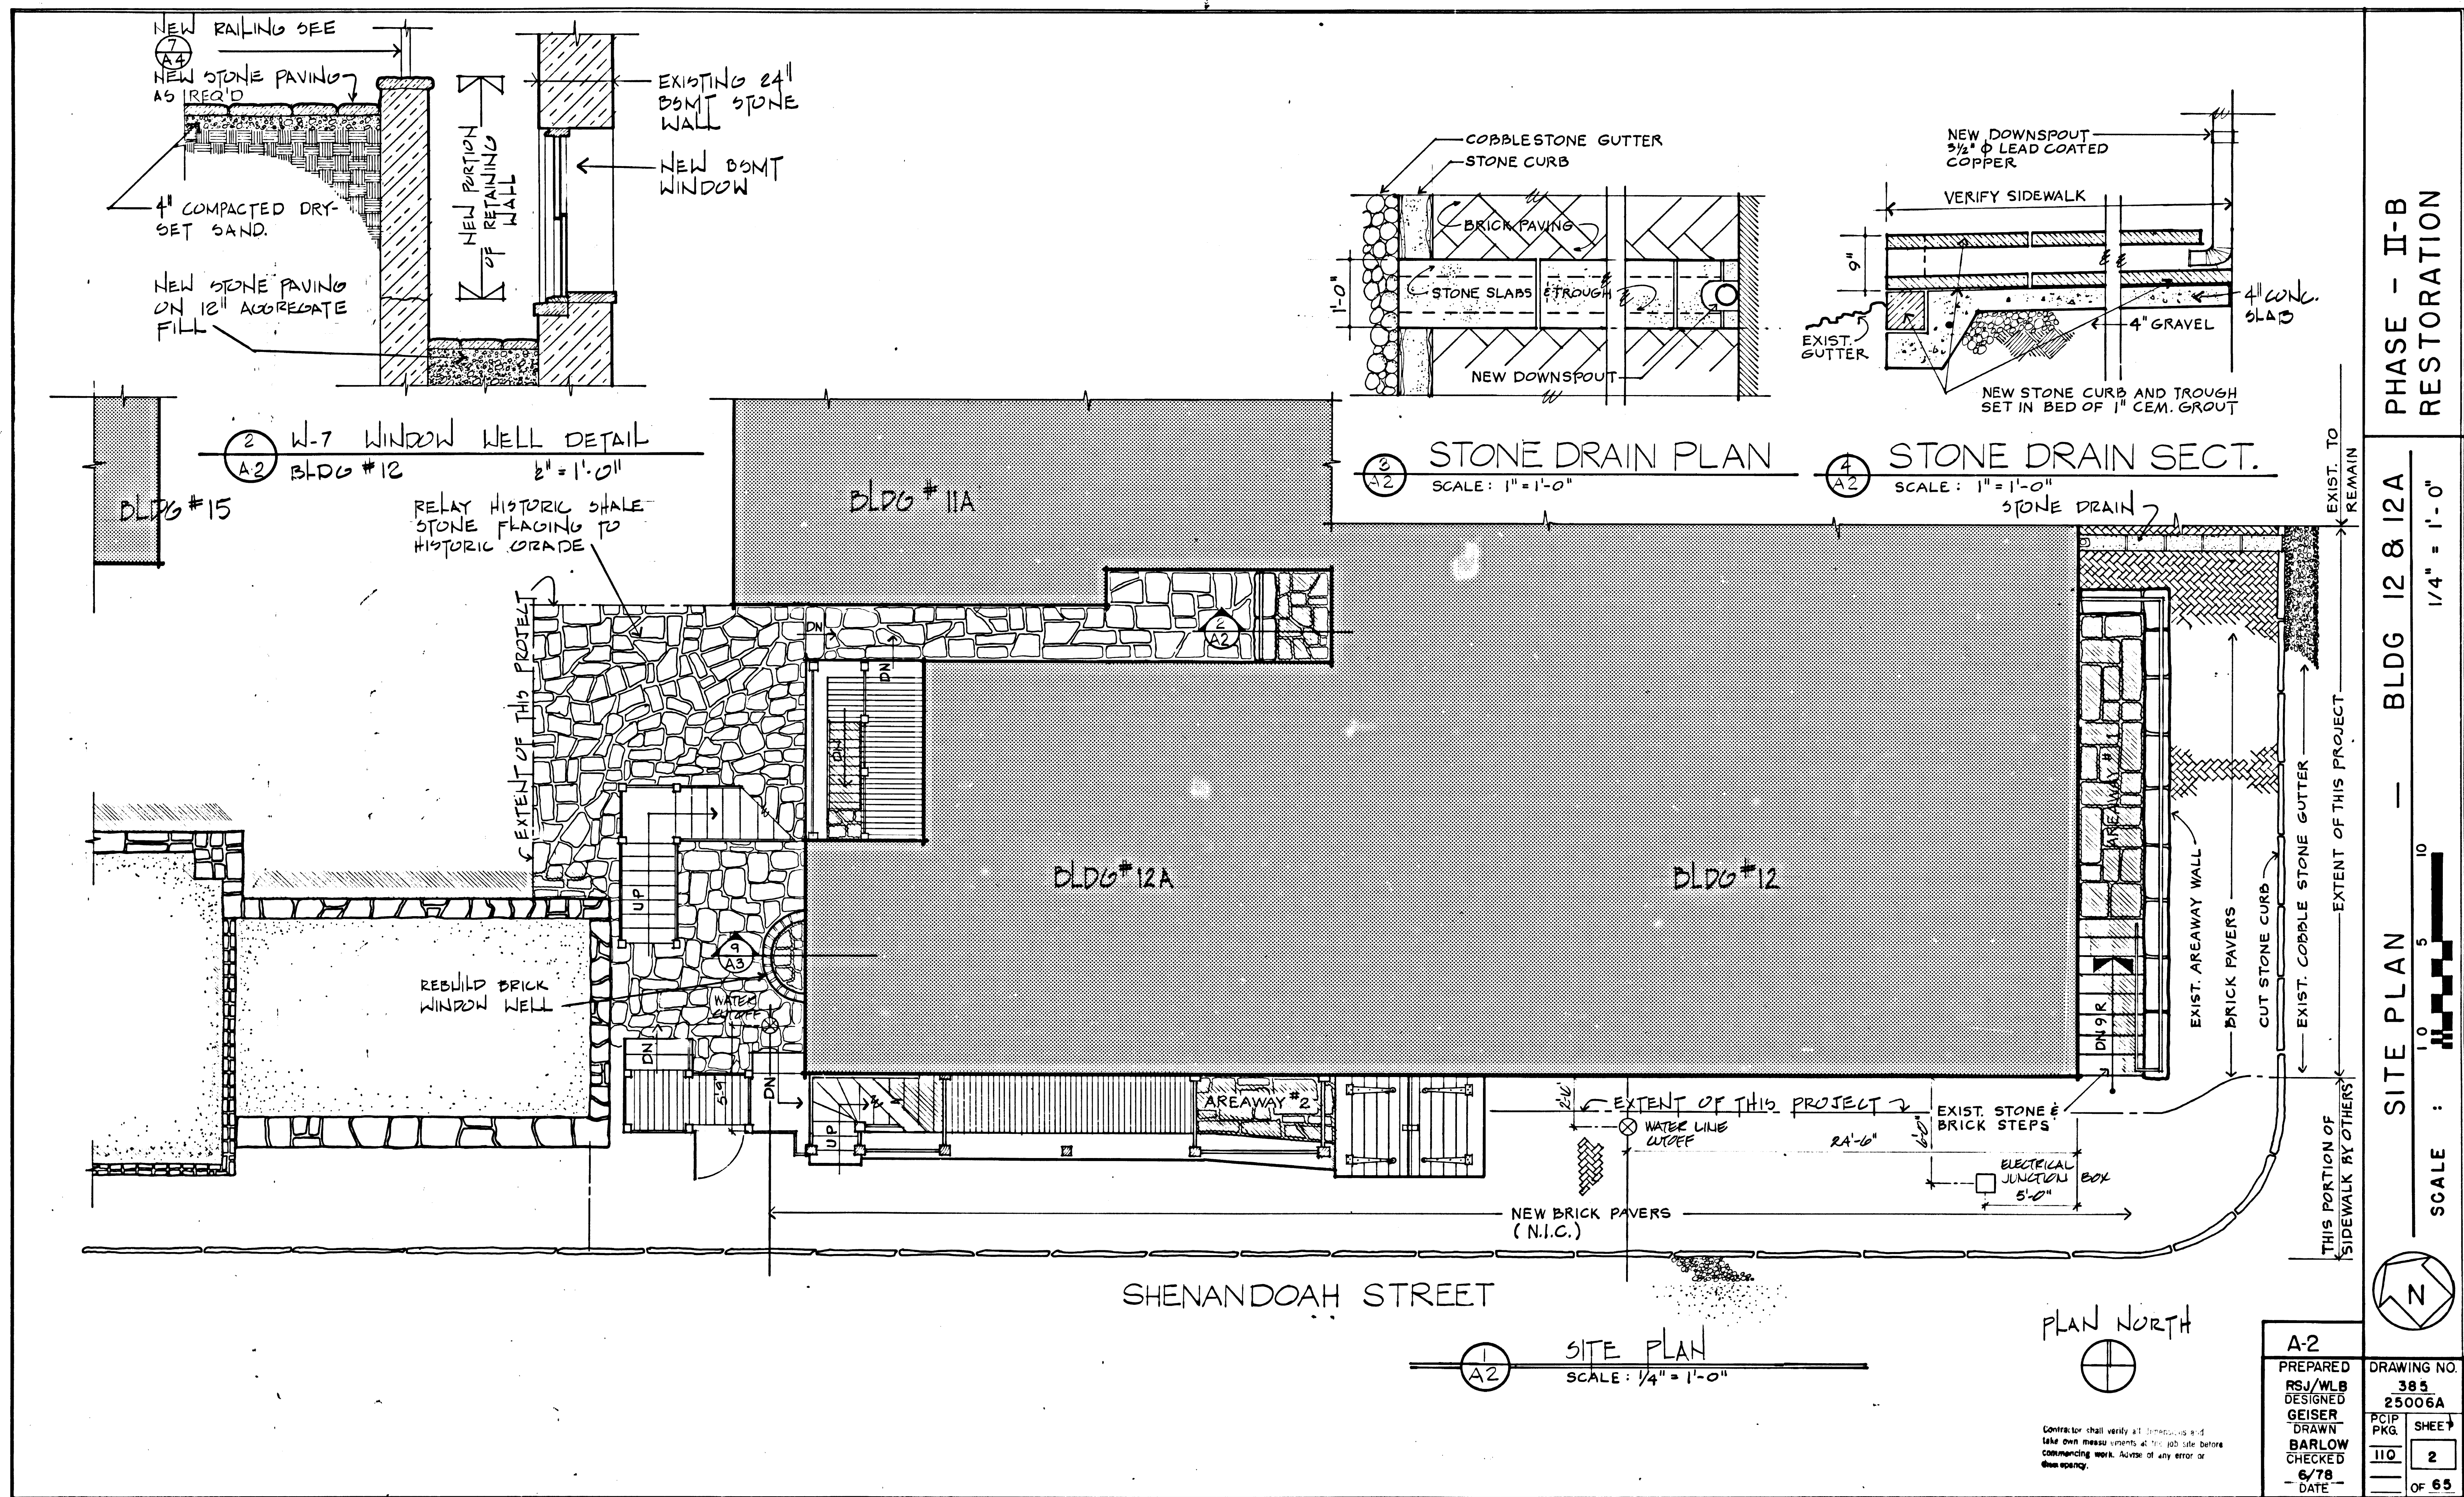

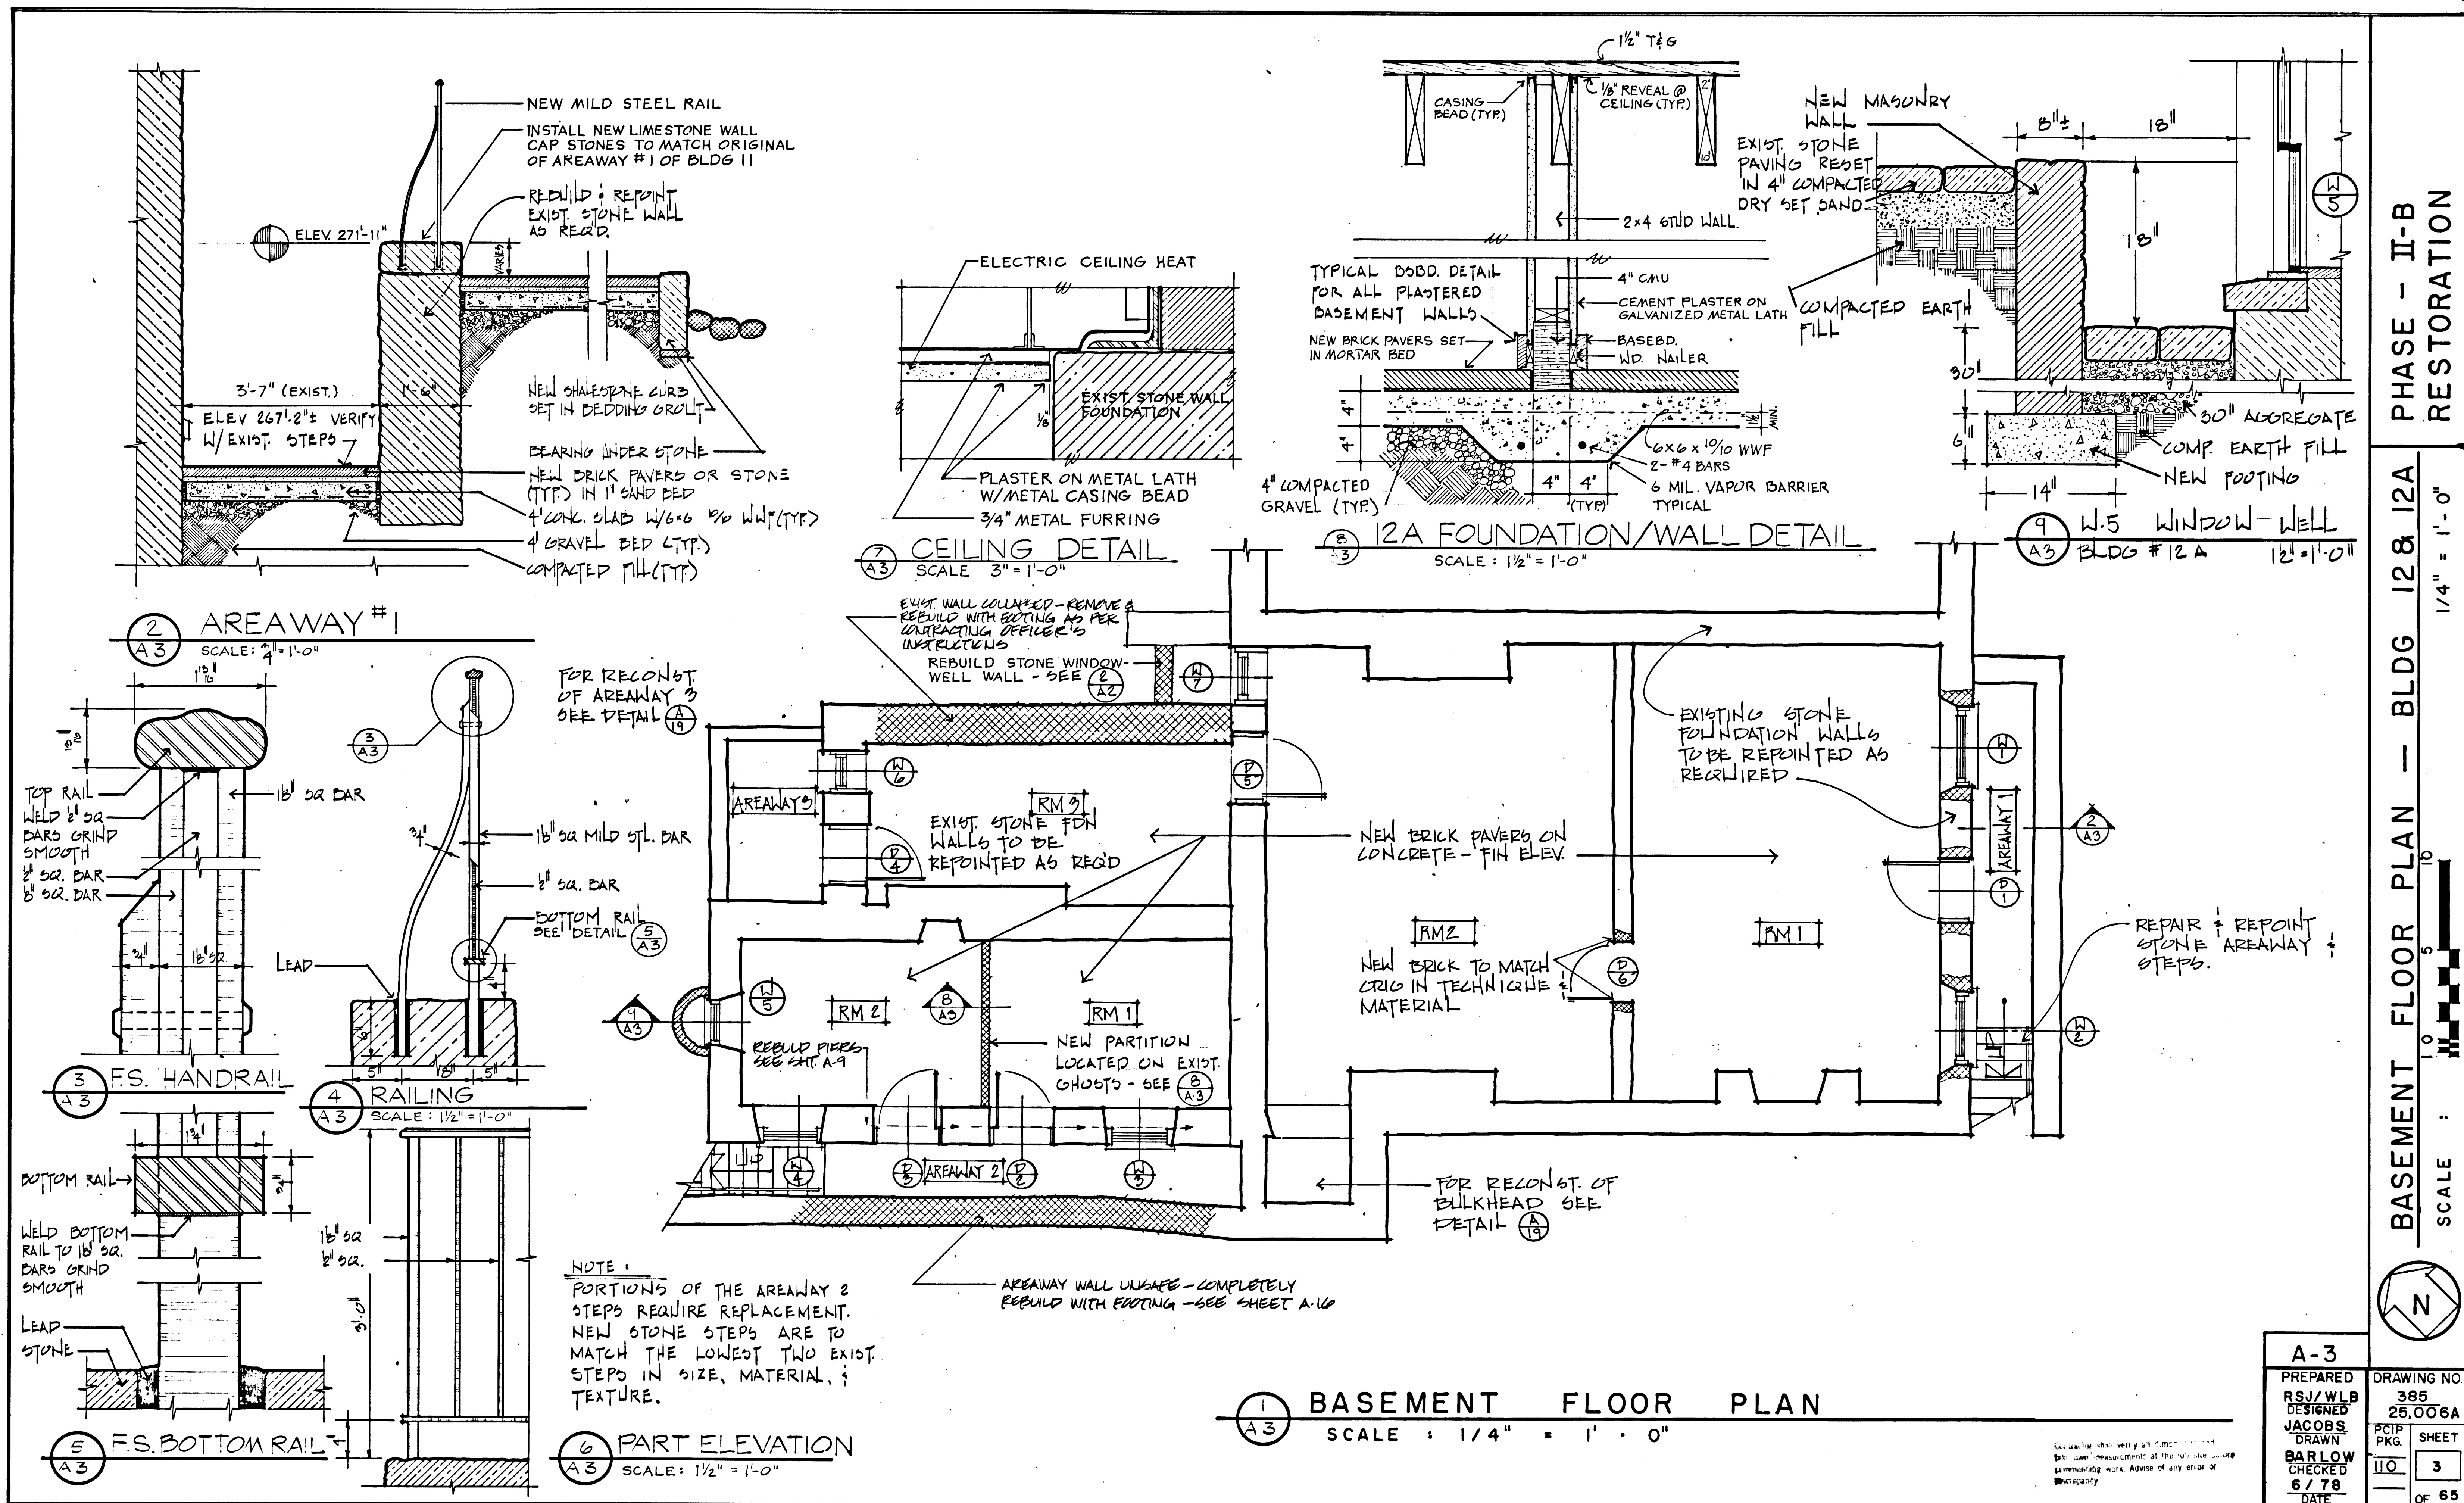



PHASE - II-B
RESTORATION

FIRST FLOOR PLAN - BLDG 12 & 12A
SCALE: 1/4" = 1'-0"

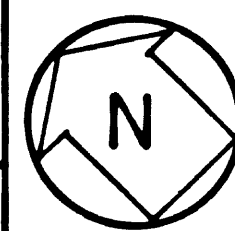


A-4		DRAWING NO.
PREPARED	RSJ/WLB	385
DESIGNED	JACOBS	23,006A
DRAWN	BARLOW	PKG.
CHECKED	6/78	SHEET
DATE		4
		OF 65

Contractor shall verify all dimensions and take own measurements at the job site before commencing work. Advise of any error or discrepancy.

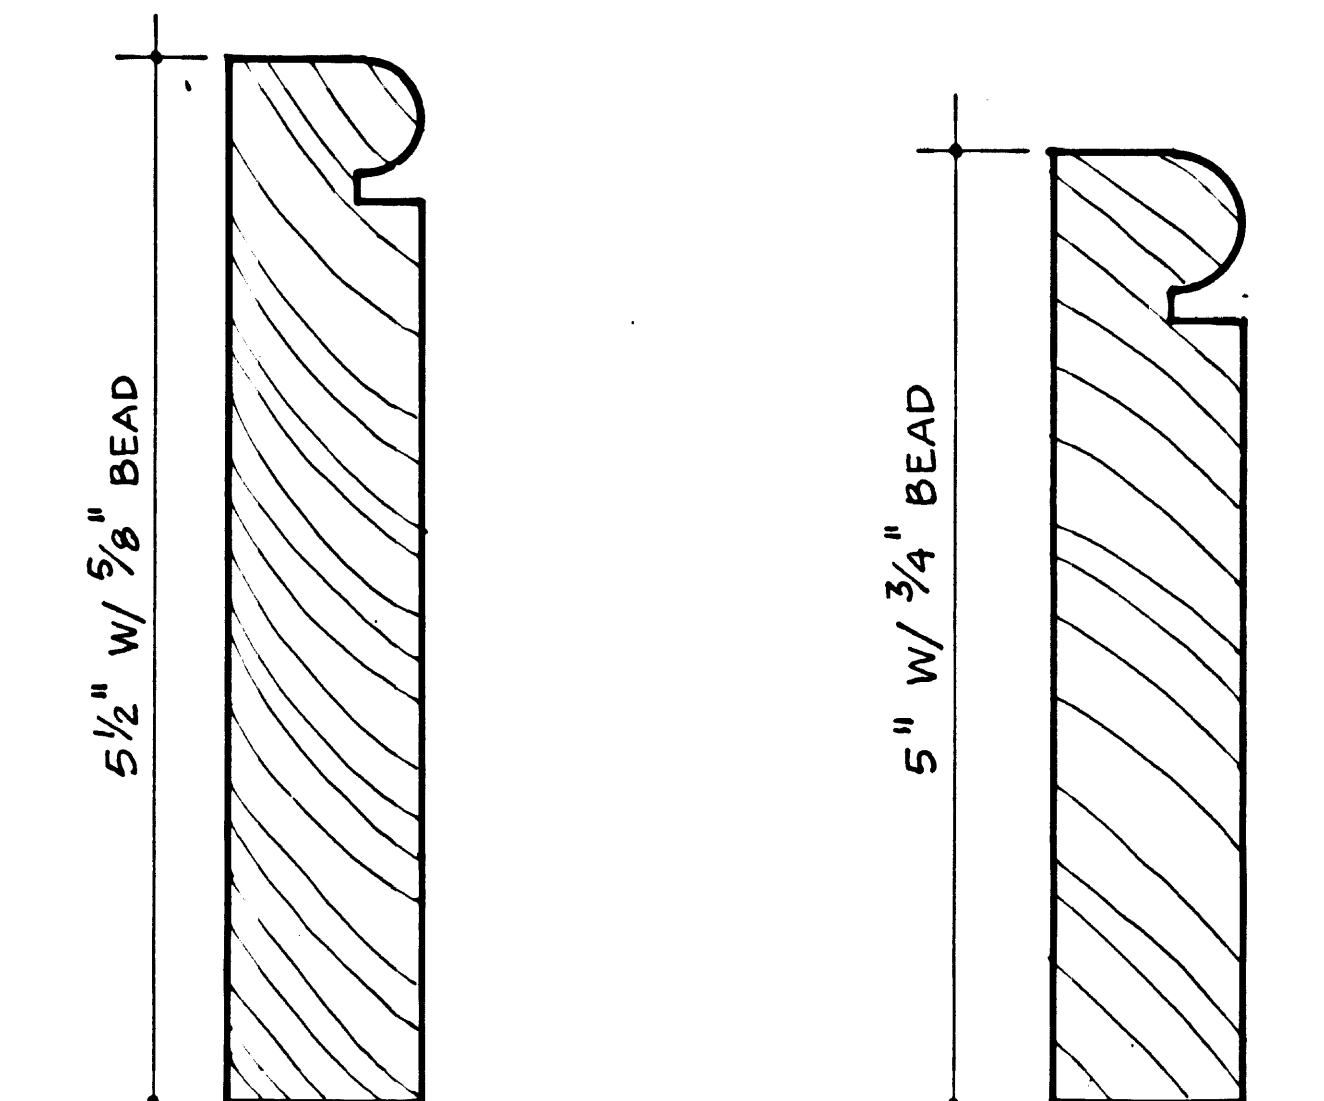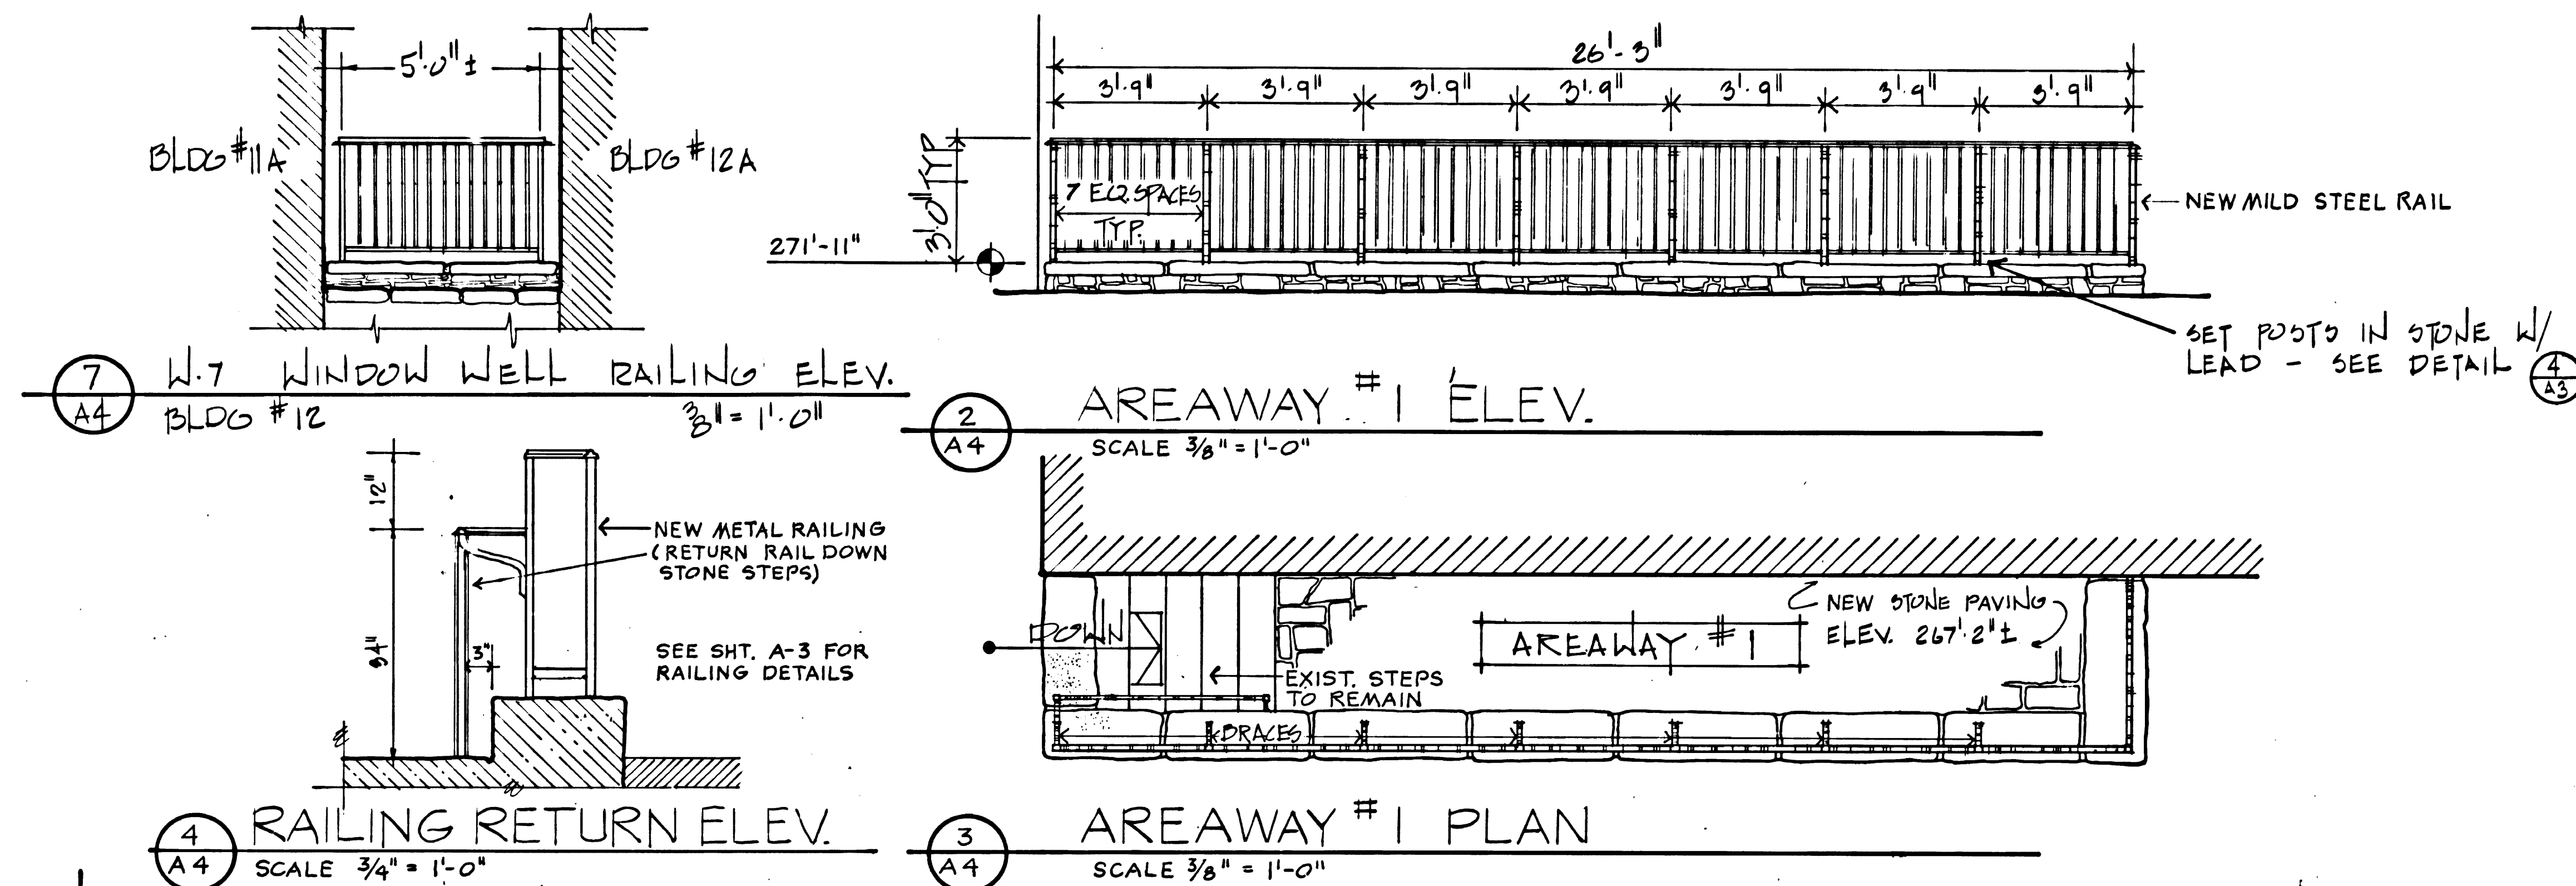

F.S. 1ST FLOOR BASEBD.
BLDG 12A

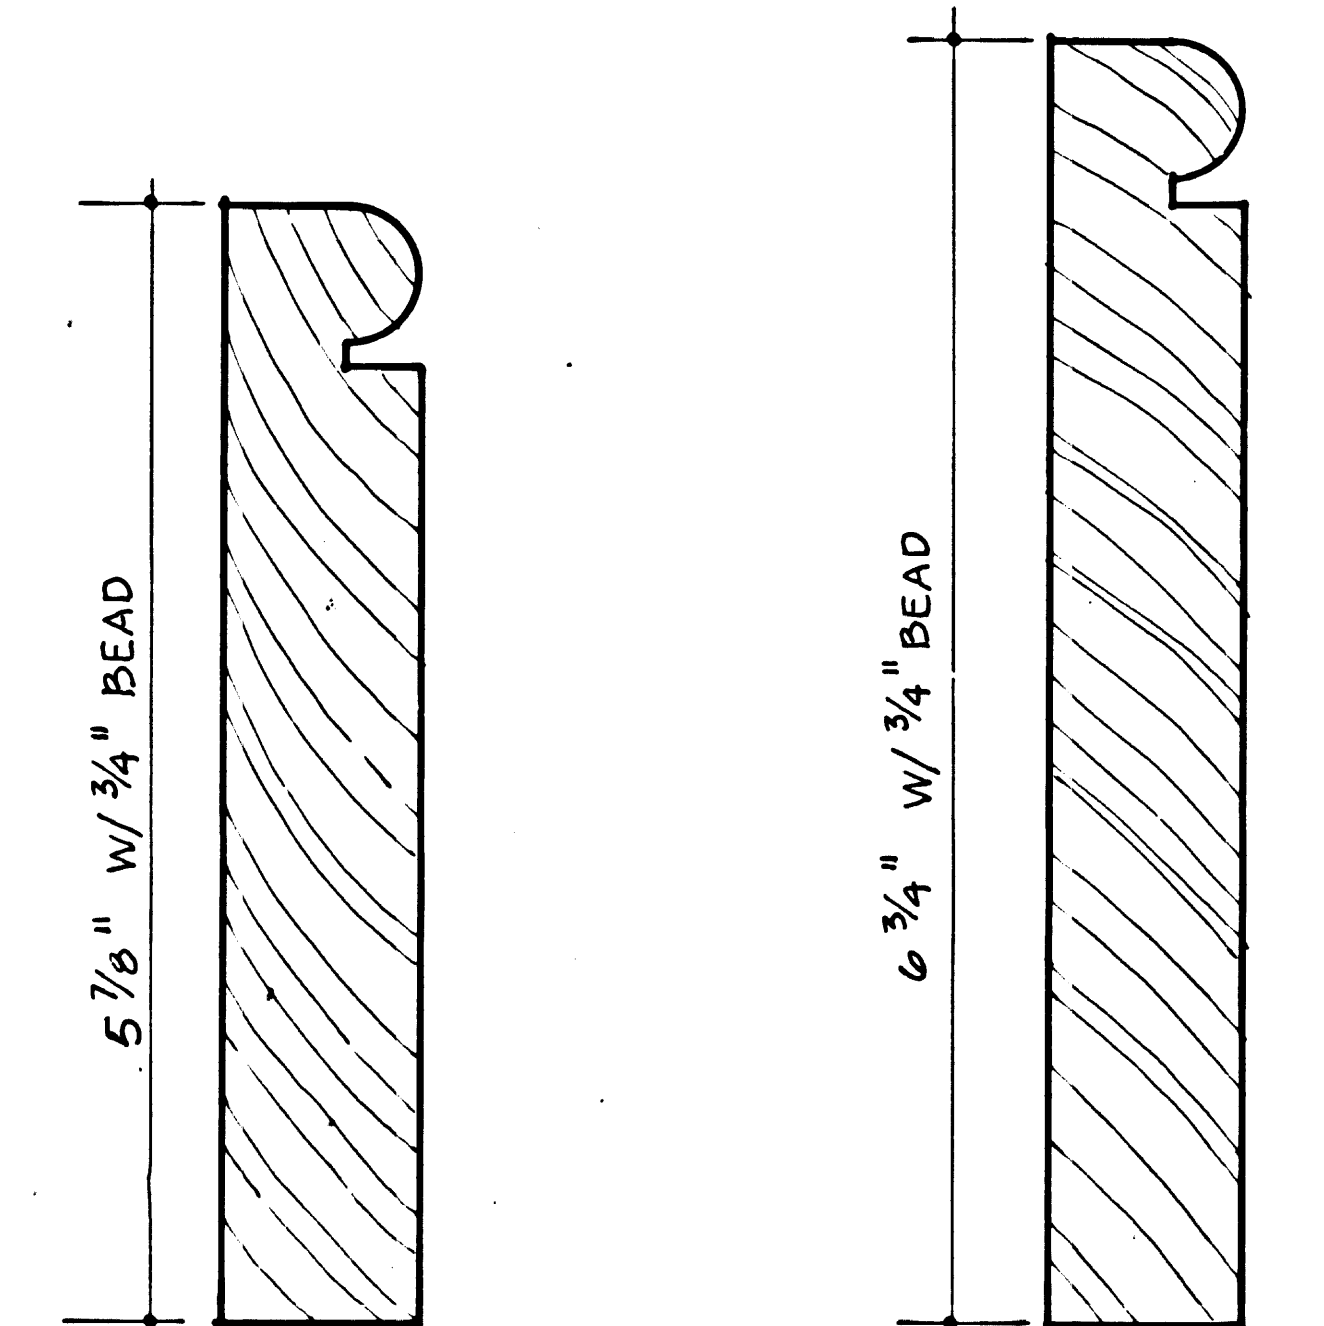


F.S. 1ST FLOOR BASEBD.
BLDG 12


INSTALL NEW JOIST DECKING, STAIRS & RAILING SEE SHT A-19 FOR DETAILS.

RECONSTRUCT STAIR TO 2ND FL. 12A REAR PORCH

RECONSTRUCT WINDOW WELL AS DIRECTED BY PROJECT SUPERVISOR SEE

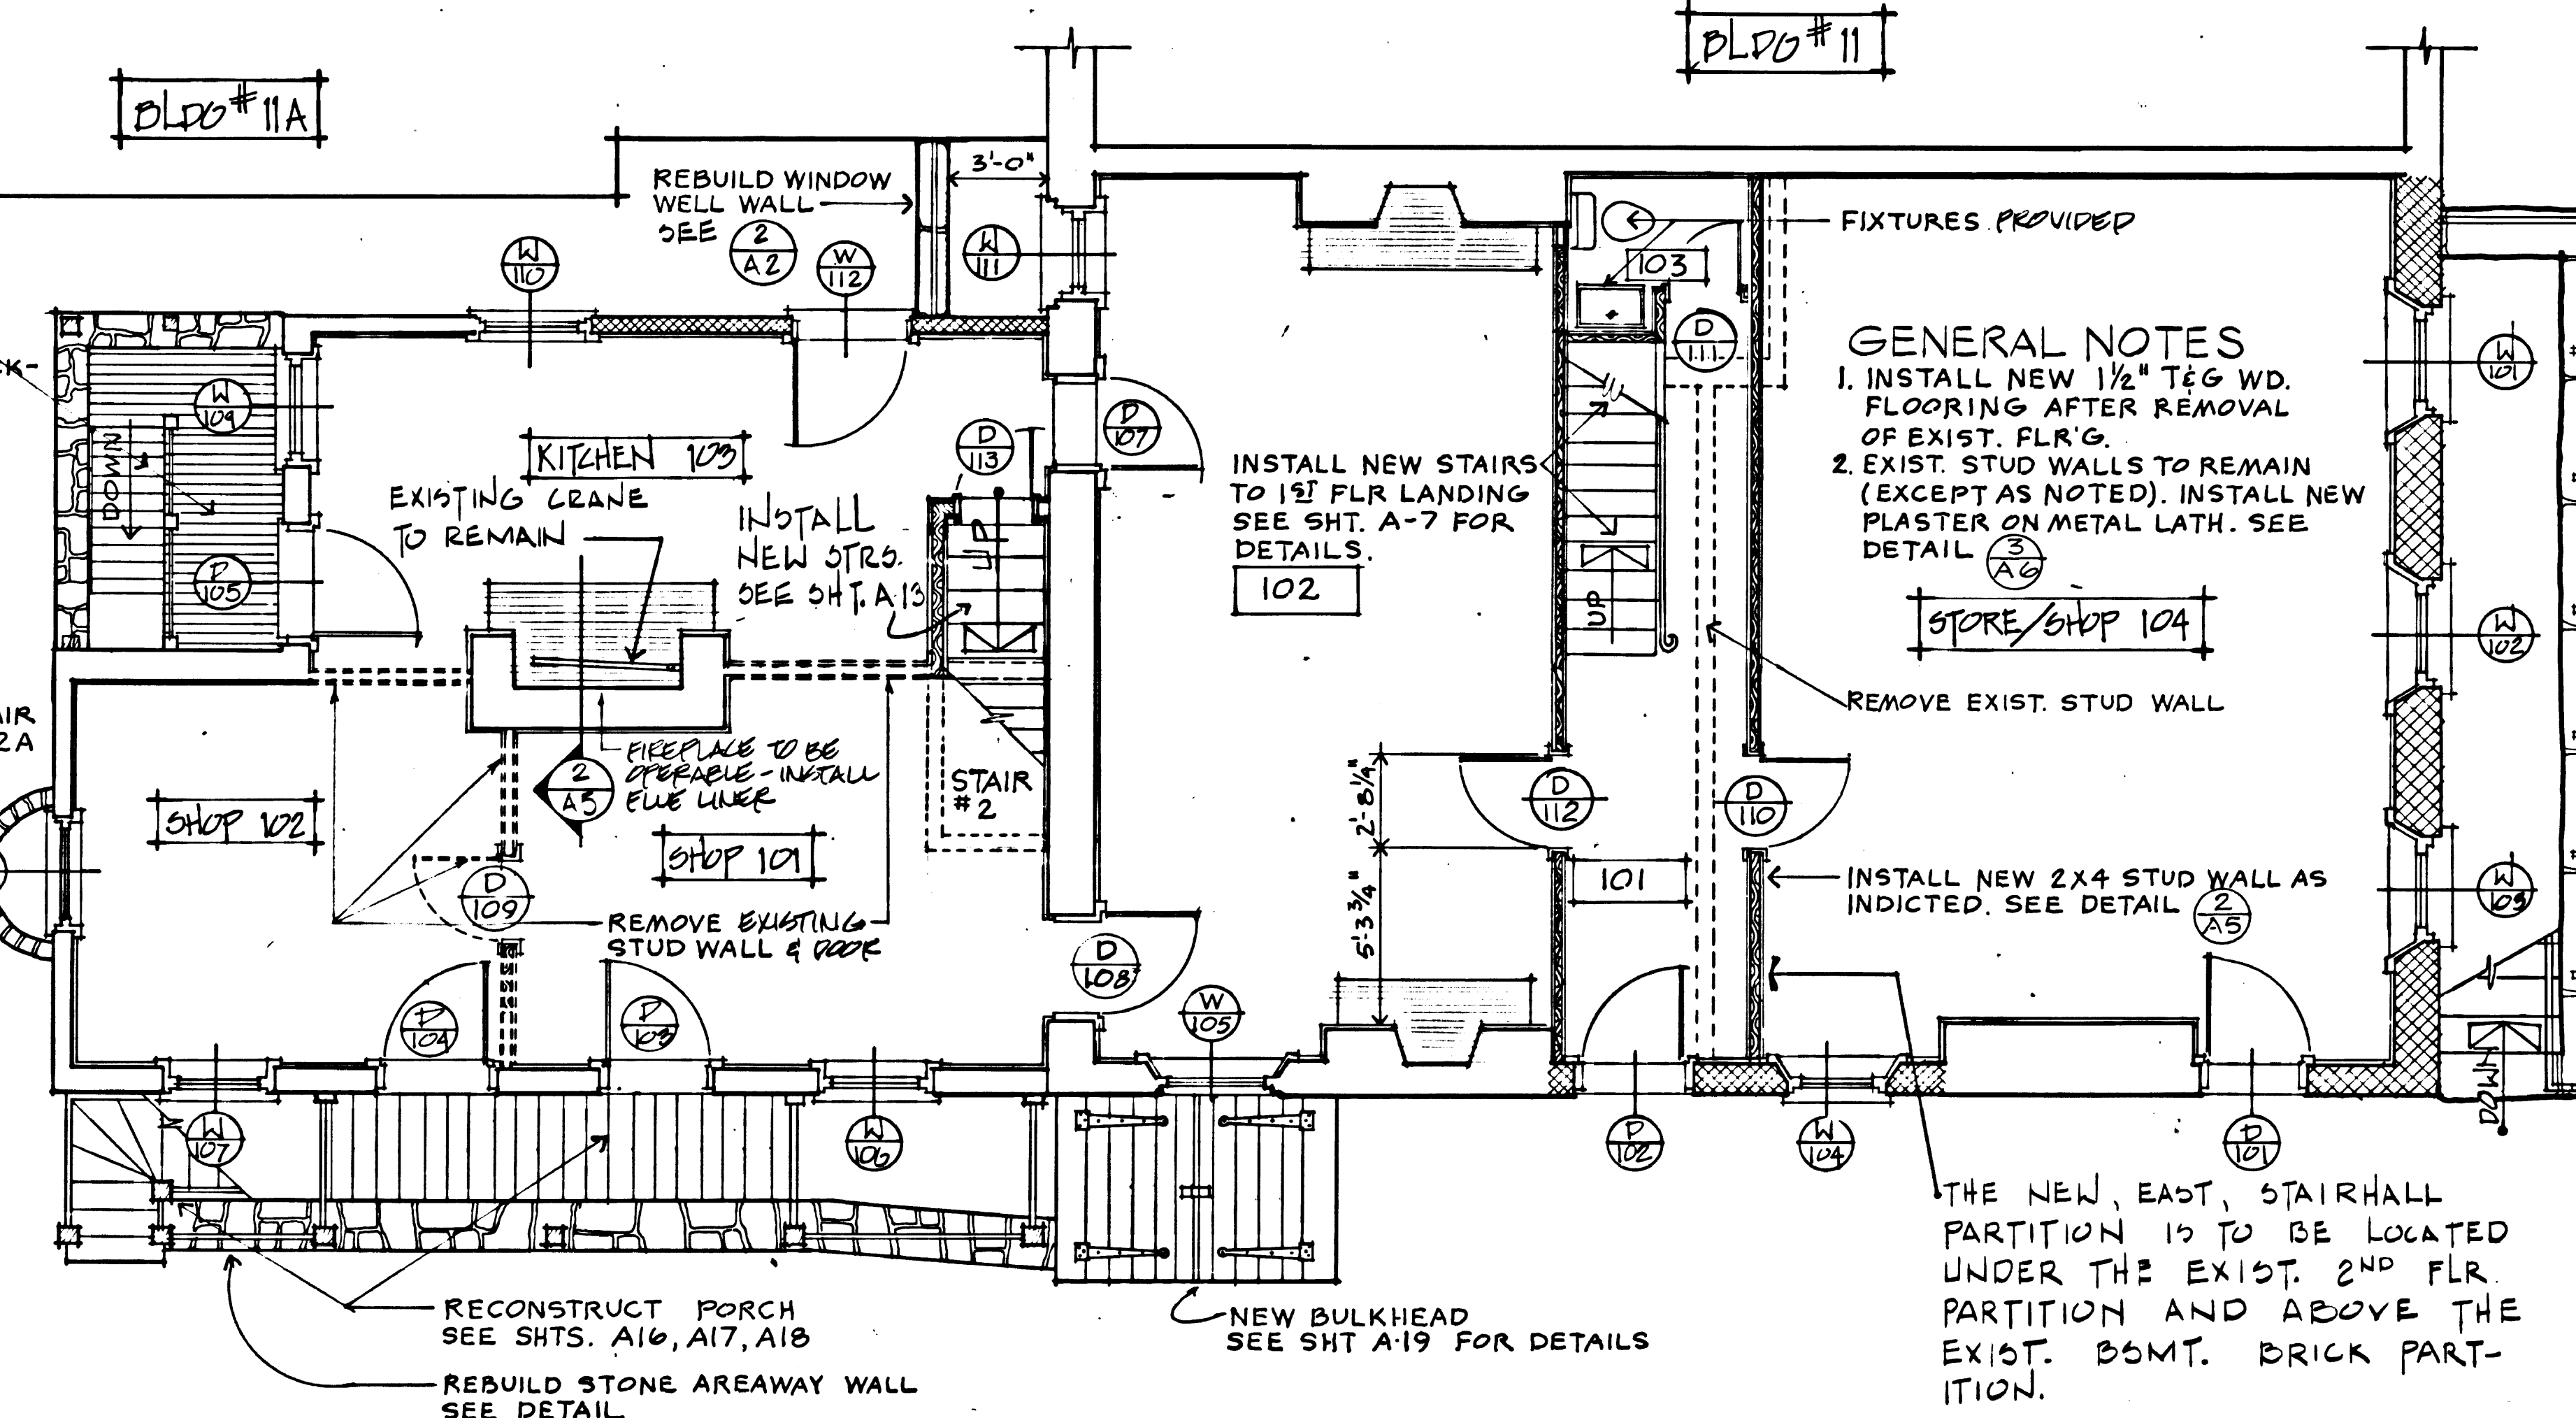


1 FIRST FLOOR PLAN
SCALE: 1/4" = 1'-0"

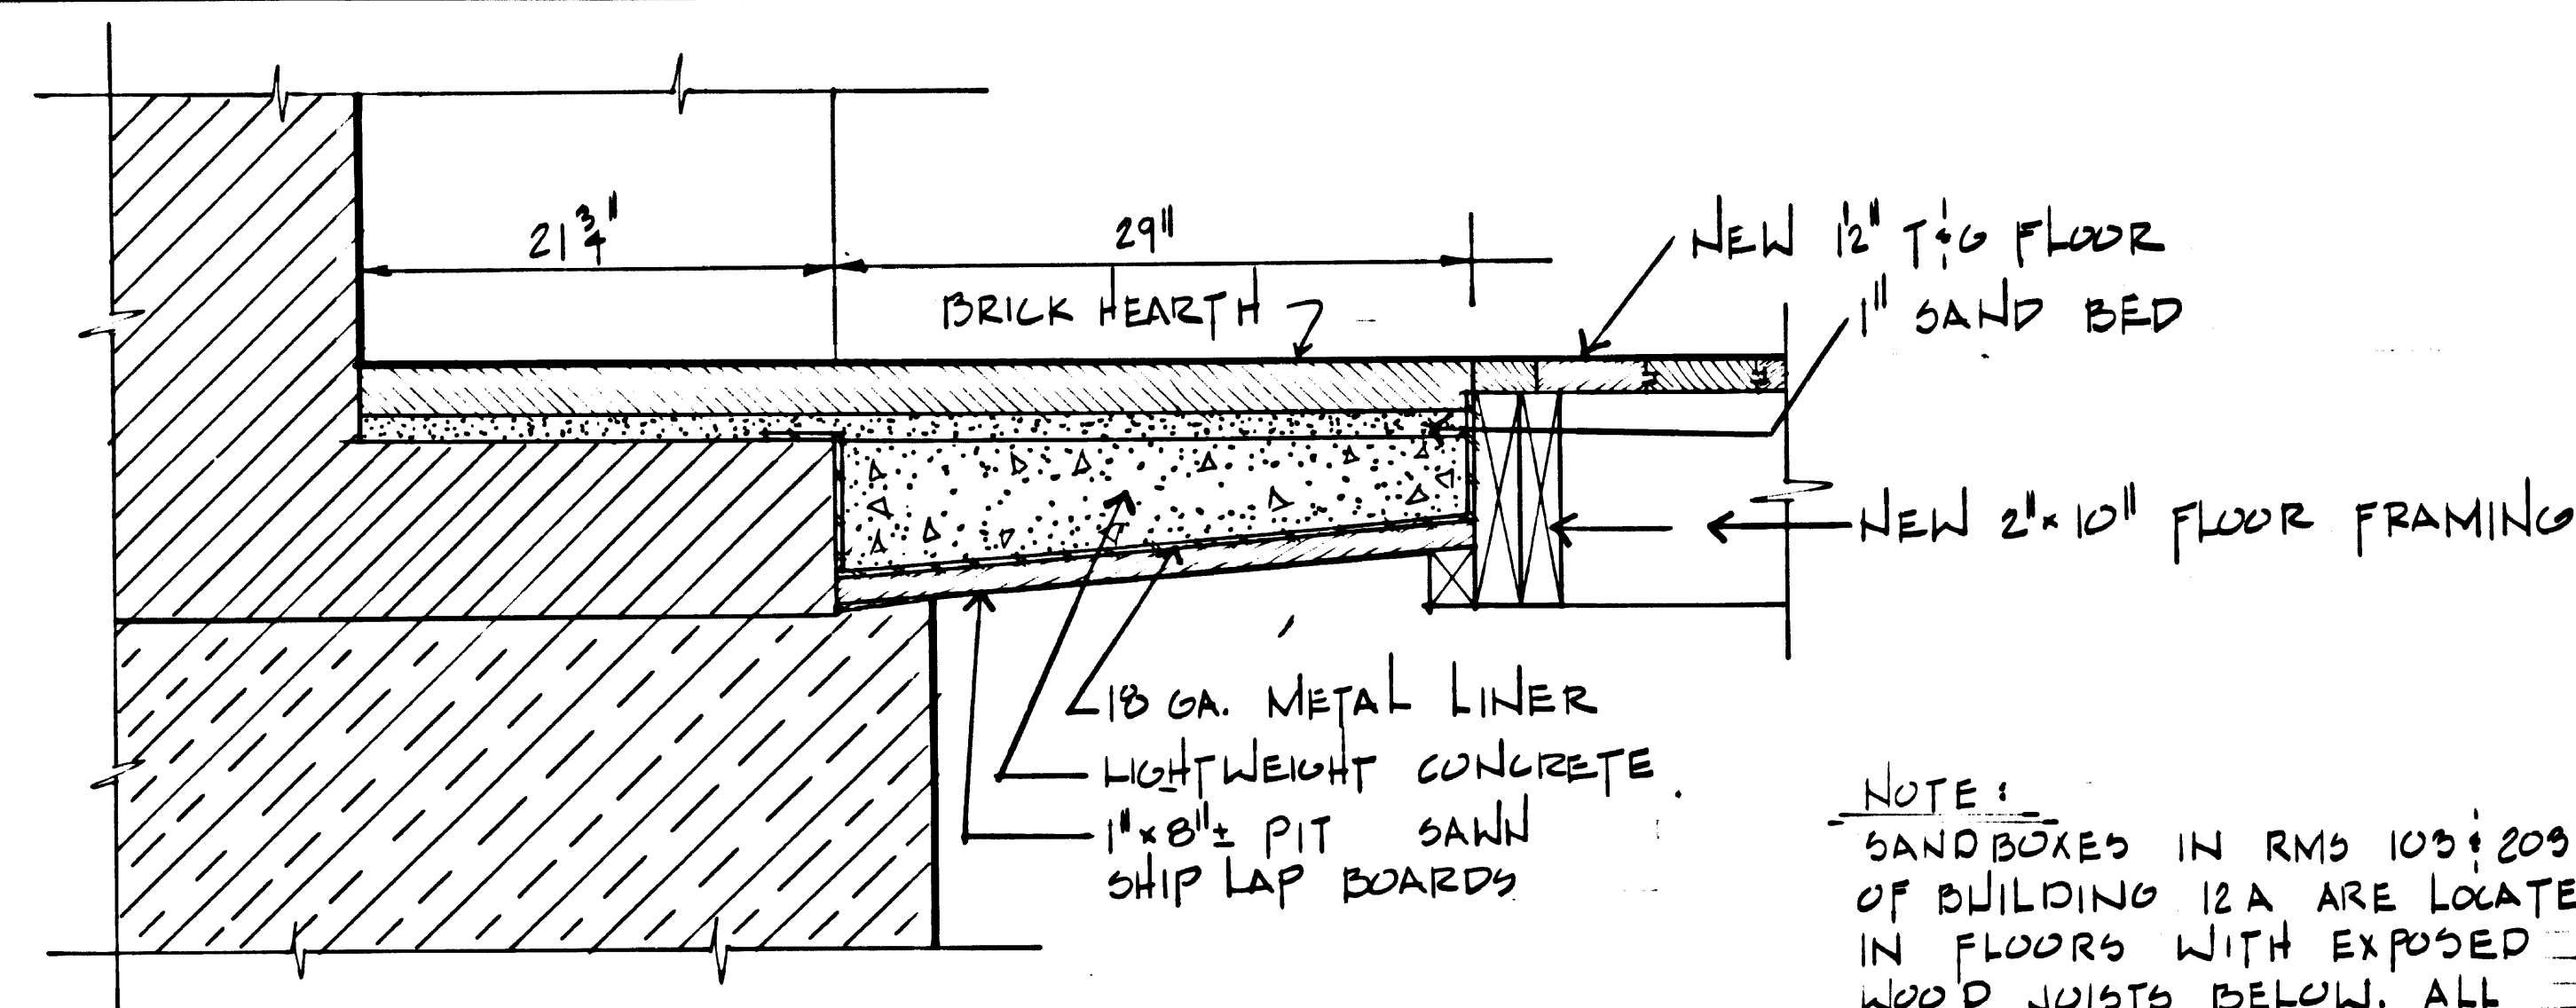


2 SECTION - 1ST FLOOR FIREPLACE
A5 BLDG # 12A 1/2" = 1'-0"


NOTE:
SANDBOXES IN RMS 105 & 205 OF BUILDING 12A ARE LOCATED IN FLOORS WITH EXPOSED WOOD JOISTS BELOW. ALL REQUIRED RECONSTRUCTION IN WOOD WILL BE SIMILAR IN SIZE, TEXTURE, & METHOD OF CONSTRUCTION TO EXIST. PORTIONS OF THESE SANDBOXES.

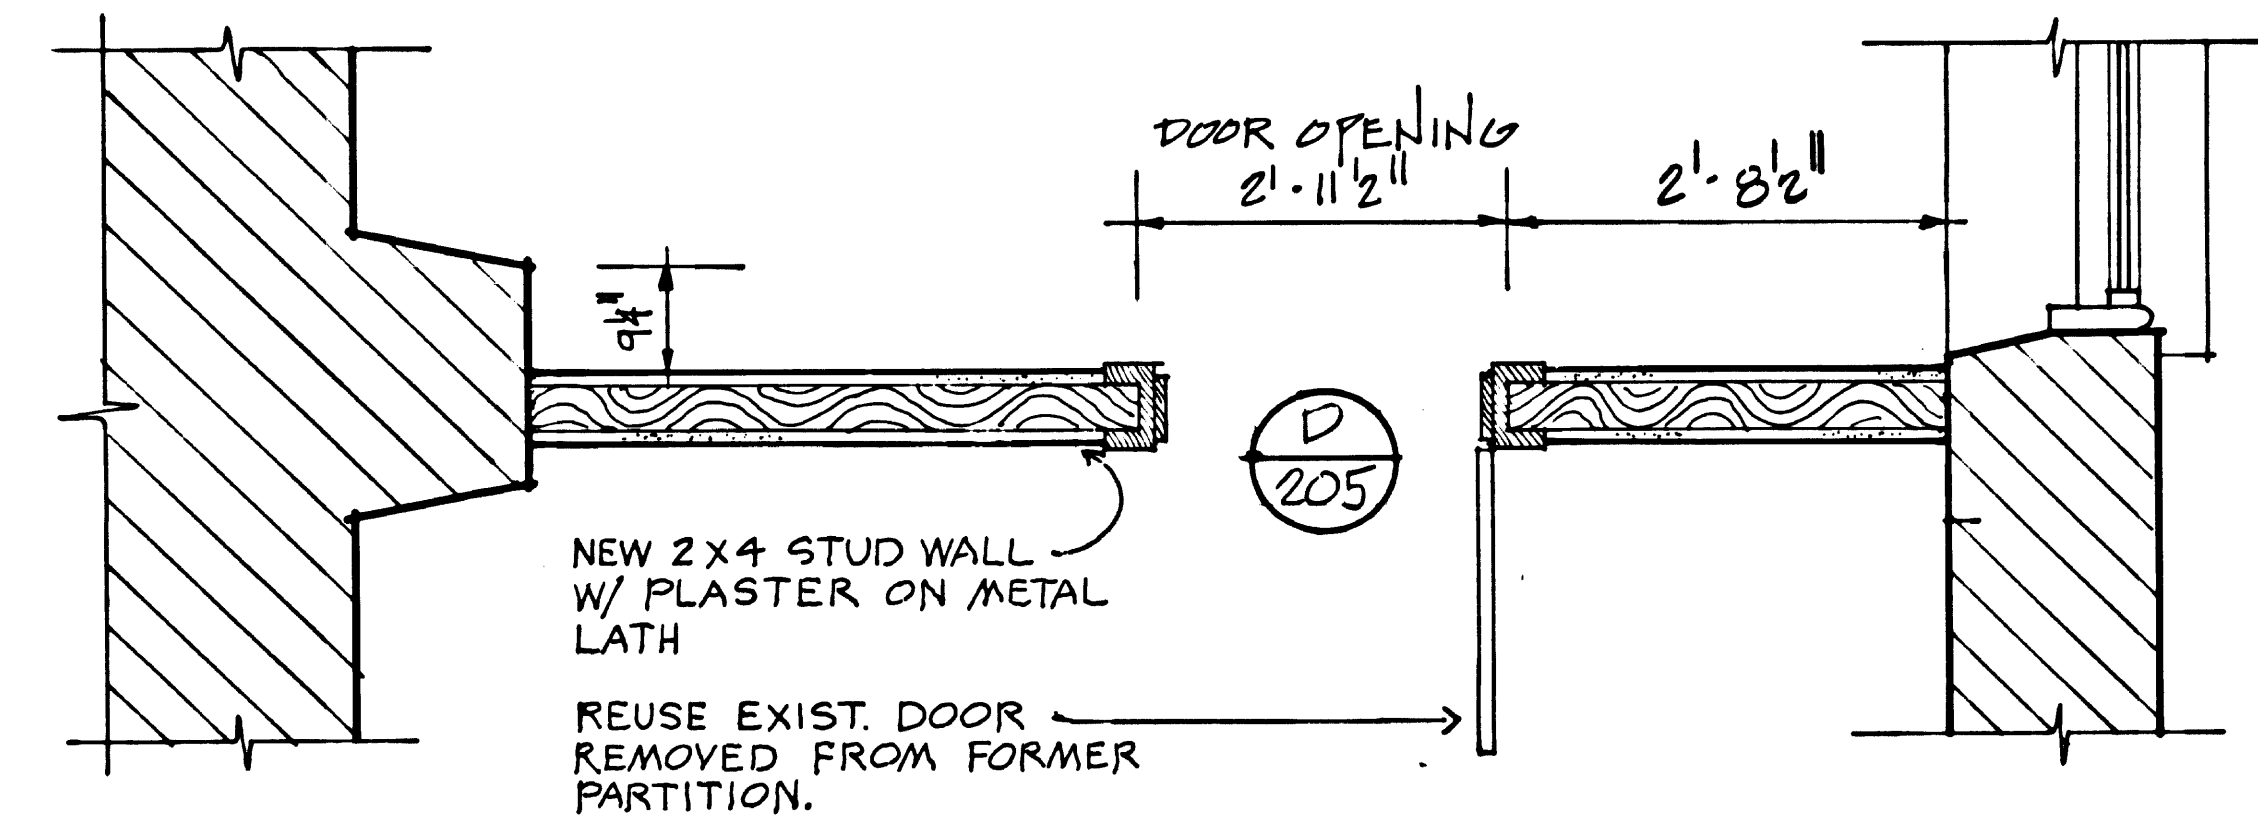

3 PARTITION PLAN-SECTION
A5 SCALE: 3/4" = 1'-0"

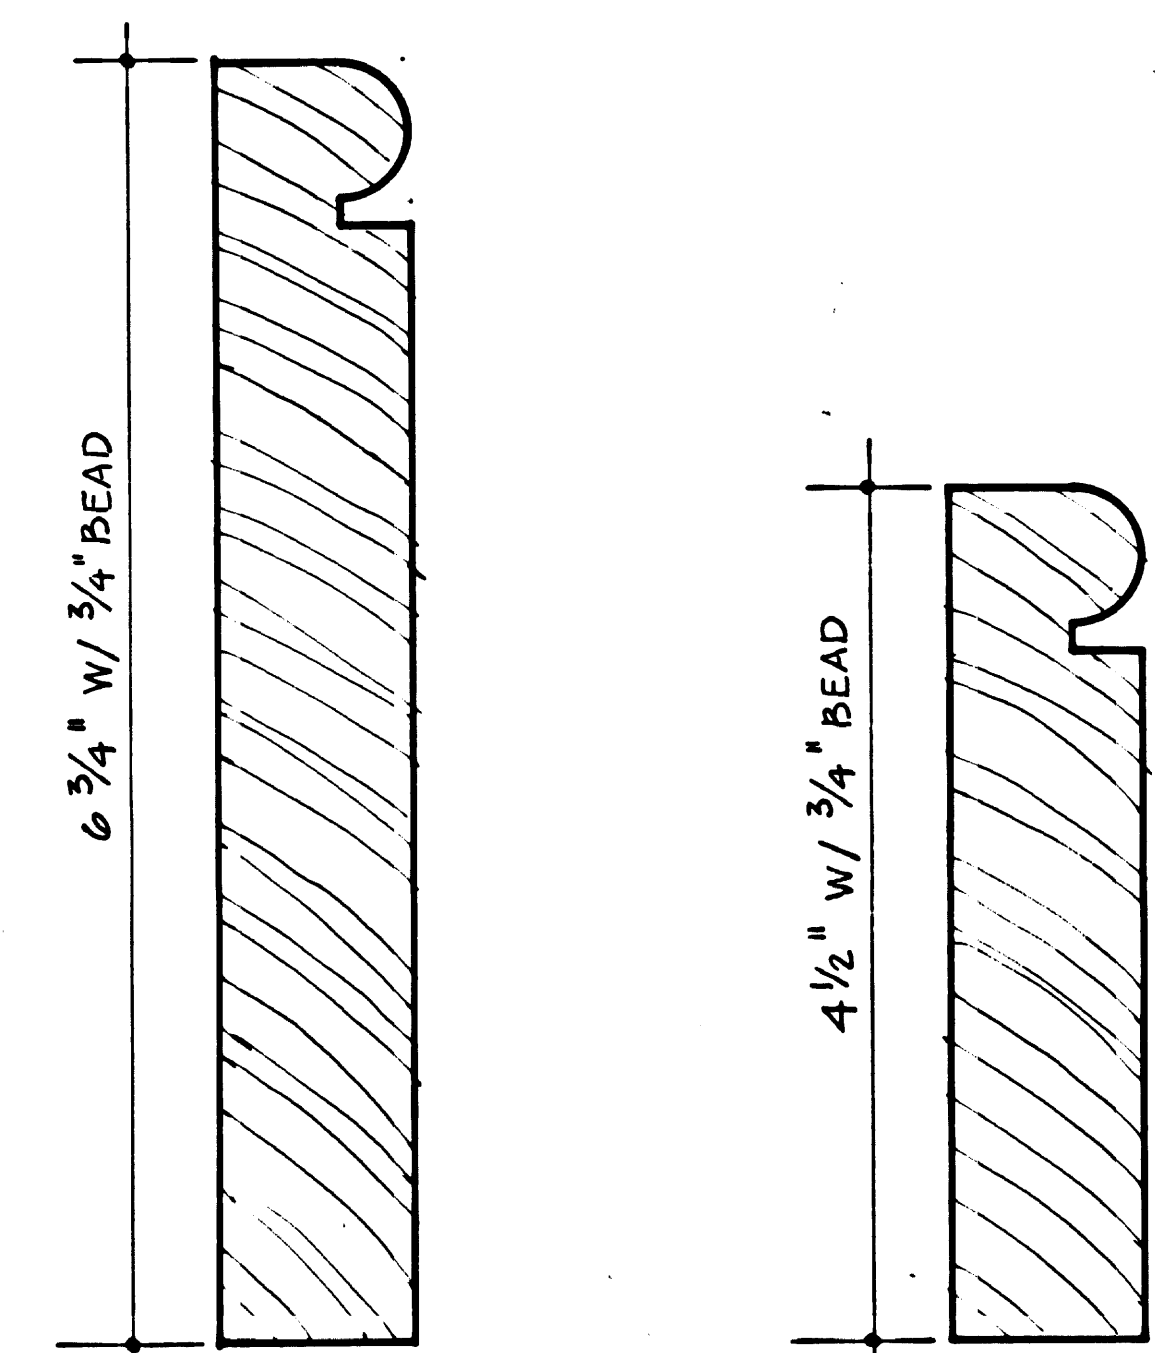

4 F.S. BASEBOARD DETAILS
A5 2ND FLR.

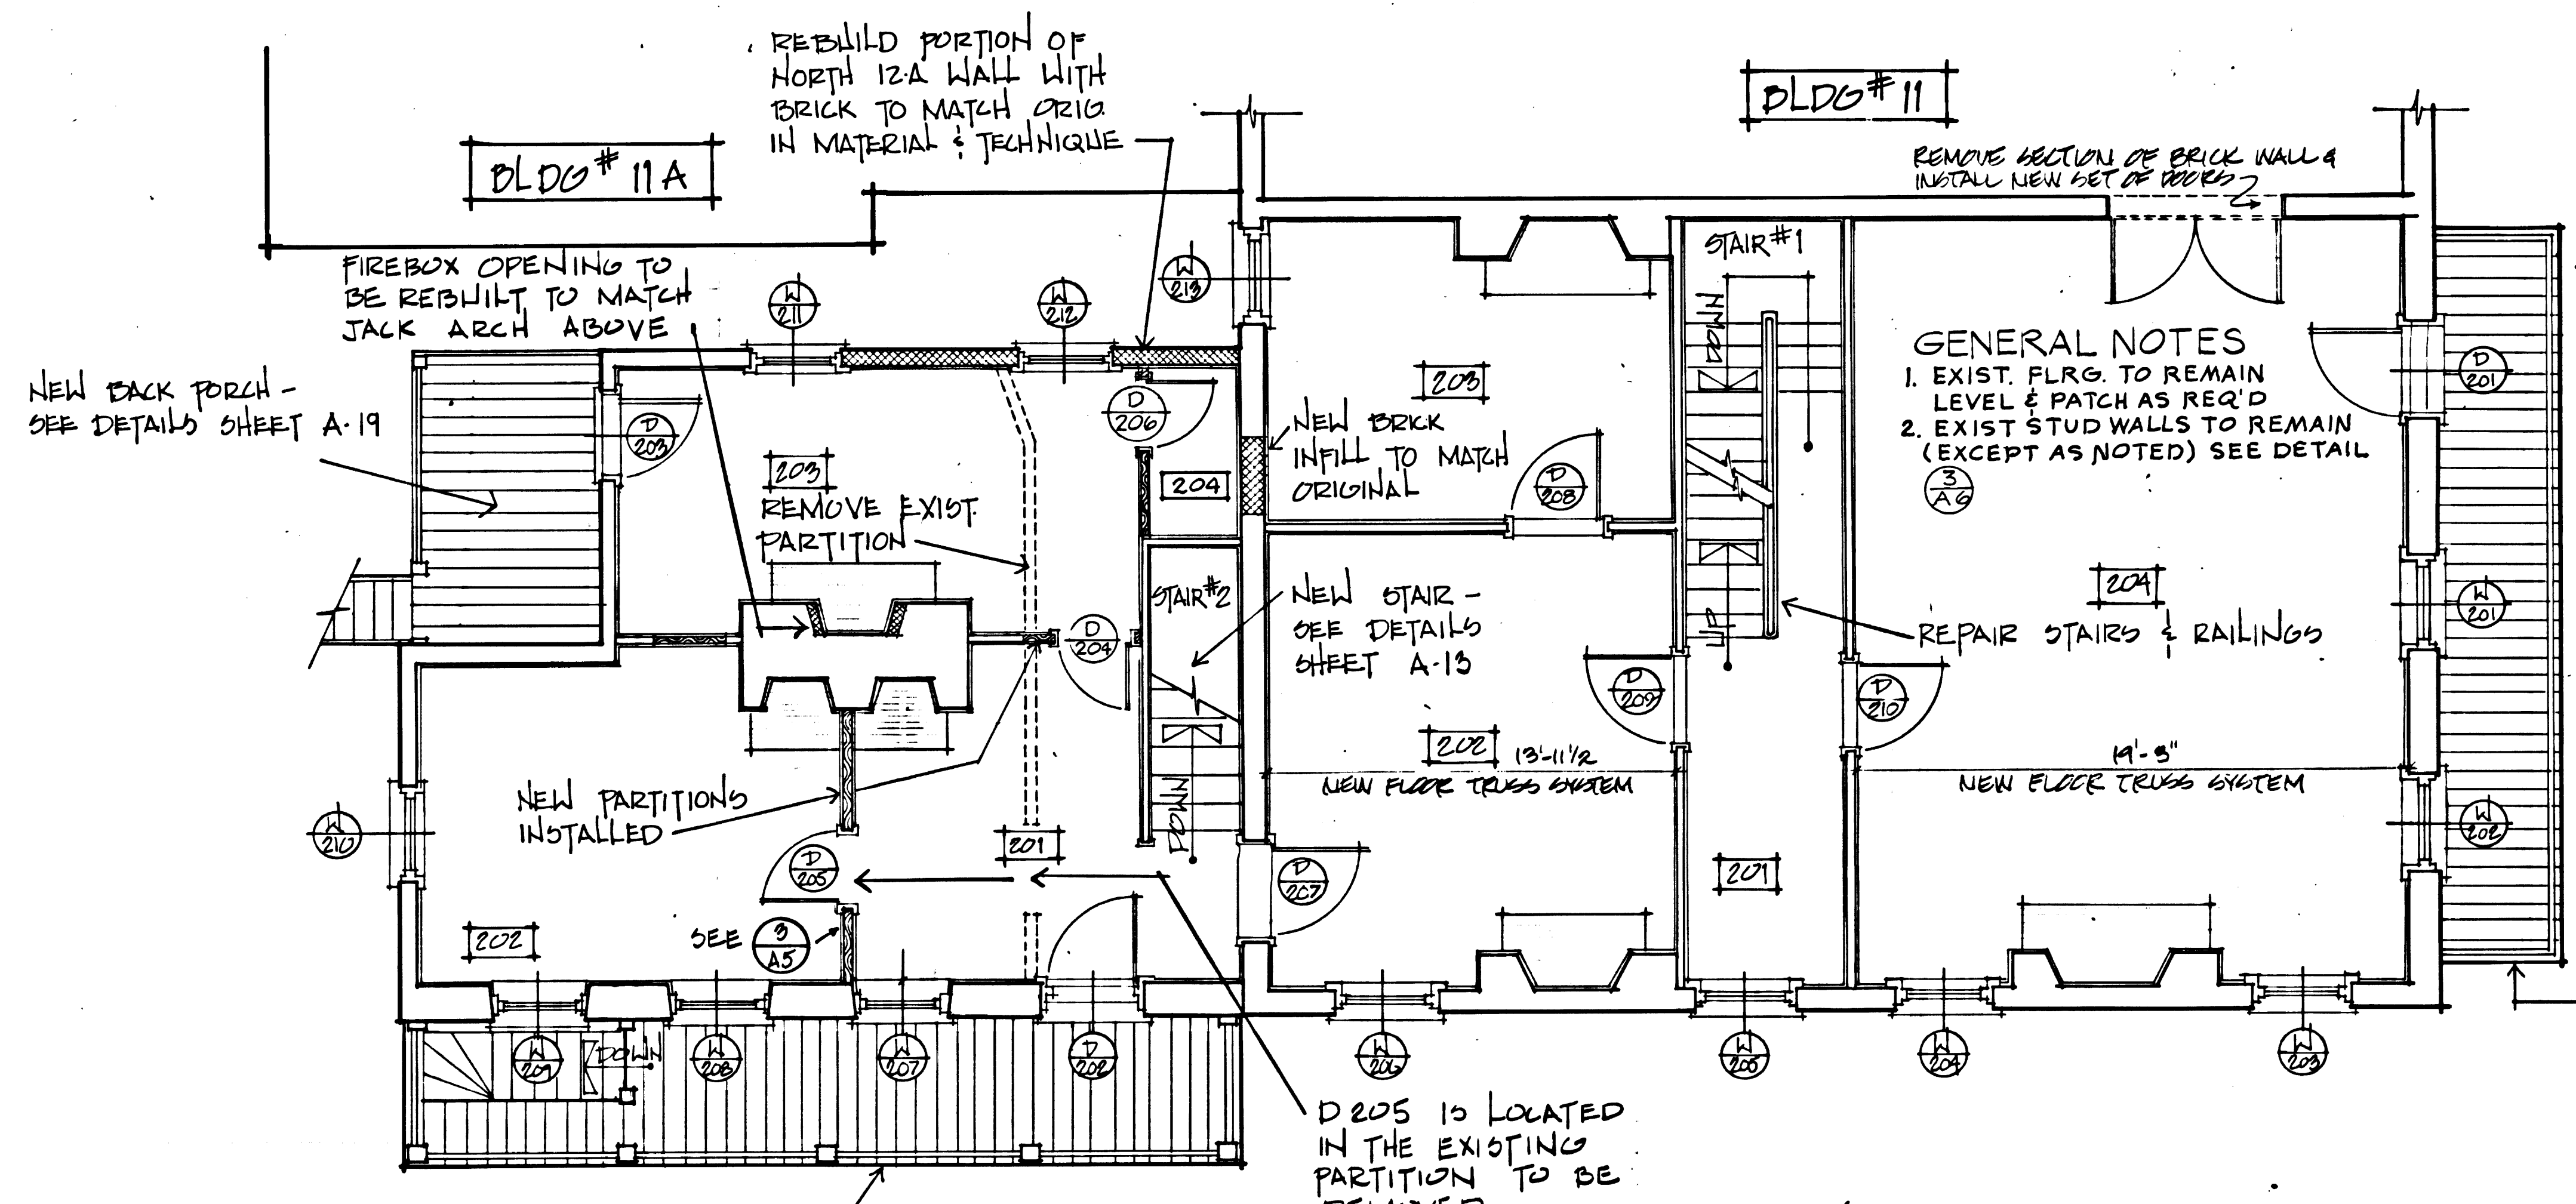

1 SECOND FLOOR PLAN
A5 SCALE: 1/4" = 1'-0"

- FIREPLACE RECON.**
1. ALL SANDBOXES ARE TO BE REBUILT USING EXIST. BRICKS IN THEIR SAME LOCATIONS IF AVAILABLE.
 2. NEW DAMPERS TO BE INSTALLED IN ALL FIREPLACES.
 3. EXISTING FLUES ARE TO BE CLEARED OF ALL DEBRIS.
 4. THE FIREBOX WILL BE REPAIRED & REPLASTERED AS REQUIRED.
- INSTALL NEW BALCONY - SEE DETAILS SHEETS A20 & A21


GENERAL NOTES
1. EXIST. FLRG. TO REMAIN LEVEL & PATCH AS REQ'D
2. EXIST. STUD WALLS TO REMAIN (EXCEPT AS NOTED) SEE DETAIL

PHASE - II-B
RESTORATION


SECOND FLOOR PLAN - BLDG 12 & 12A
SCALE: 1/4" = 1'-0"

A-5		DRAWING NO.	
PREPARED	RSJ/WLB	385	
DESIGNED	JACOBS	25,006A	
DRAWN	BARLOW	PKG.	SHEET
CHECKED	6/78	110	5
DATE			OF 65


Contractor shall verify all dimensions and take own measurements at the job site before commencing work. Advise of any error or discrepancy.

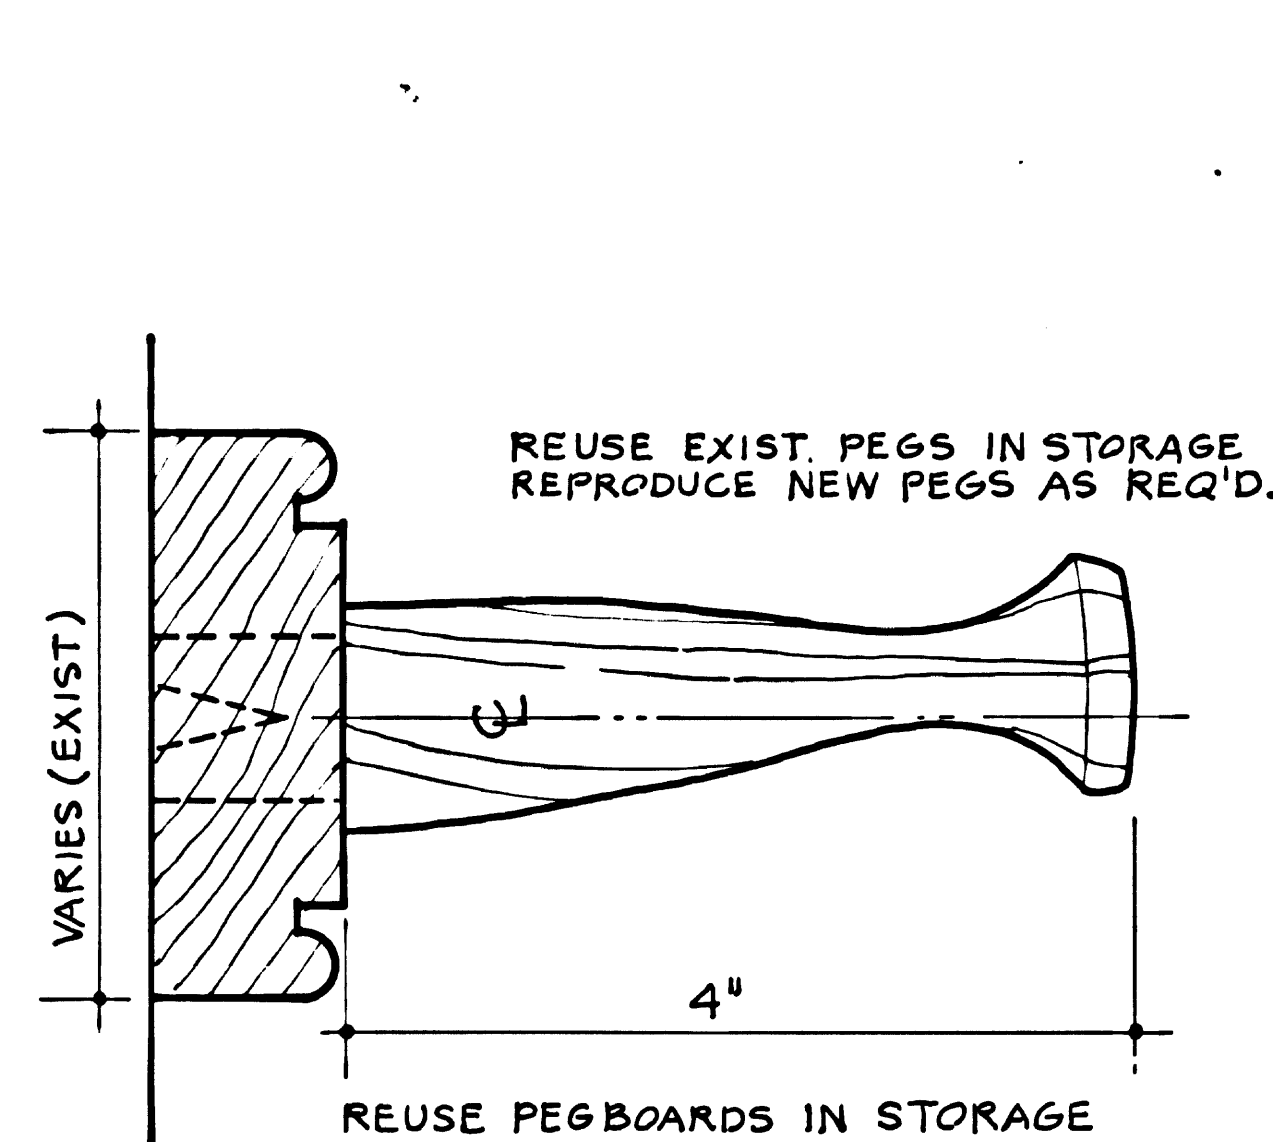


5 PEG BOARD DETAIL
A-6 FULL SIZE

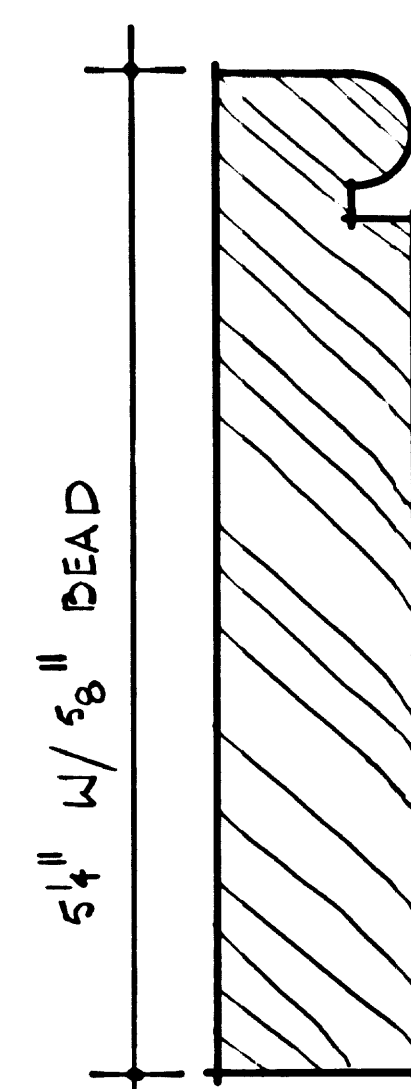


2 F.S. 3RD FLR. BASEBD.
A-6 FULL SIZE

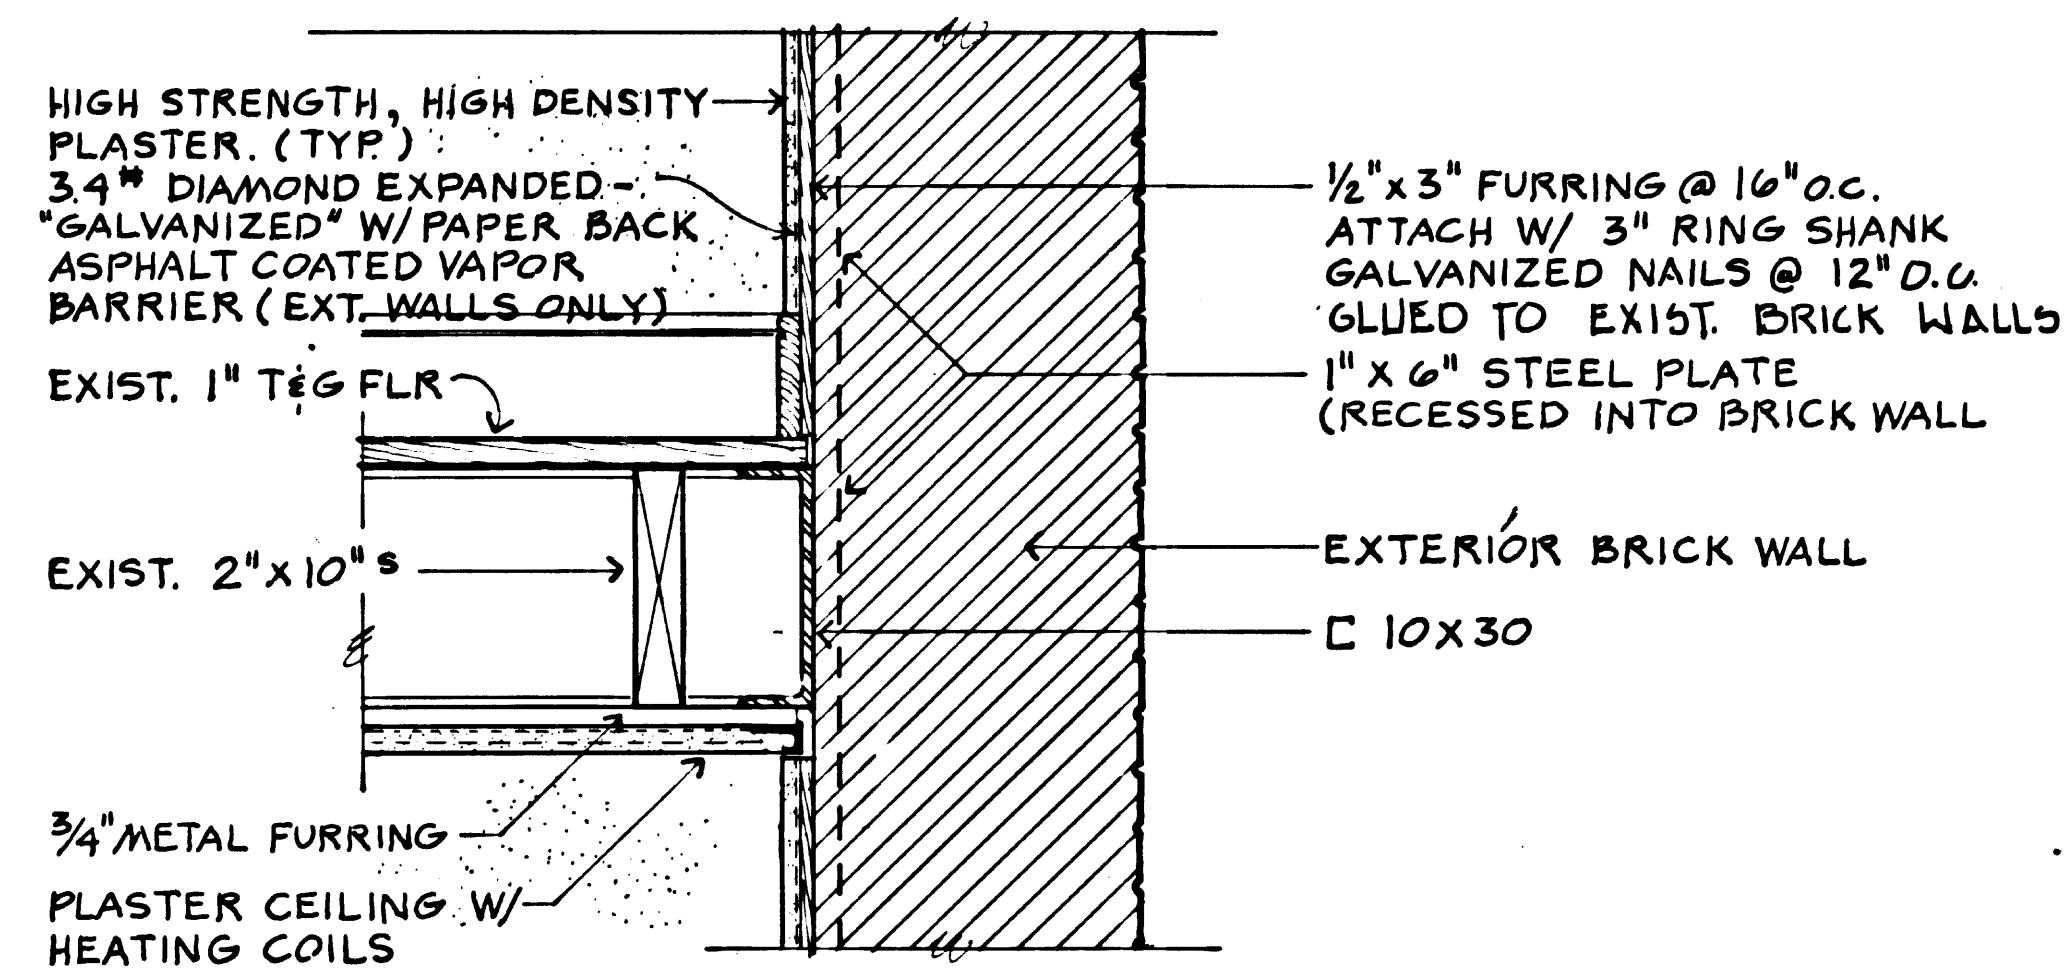

4 WALL SECTION
A-6 SCALE 1/2" = 1'-0"

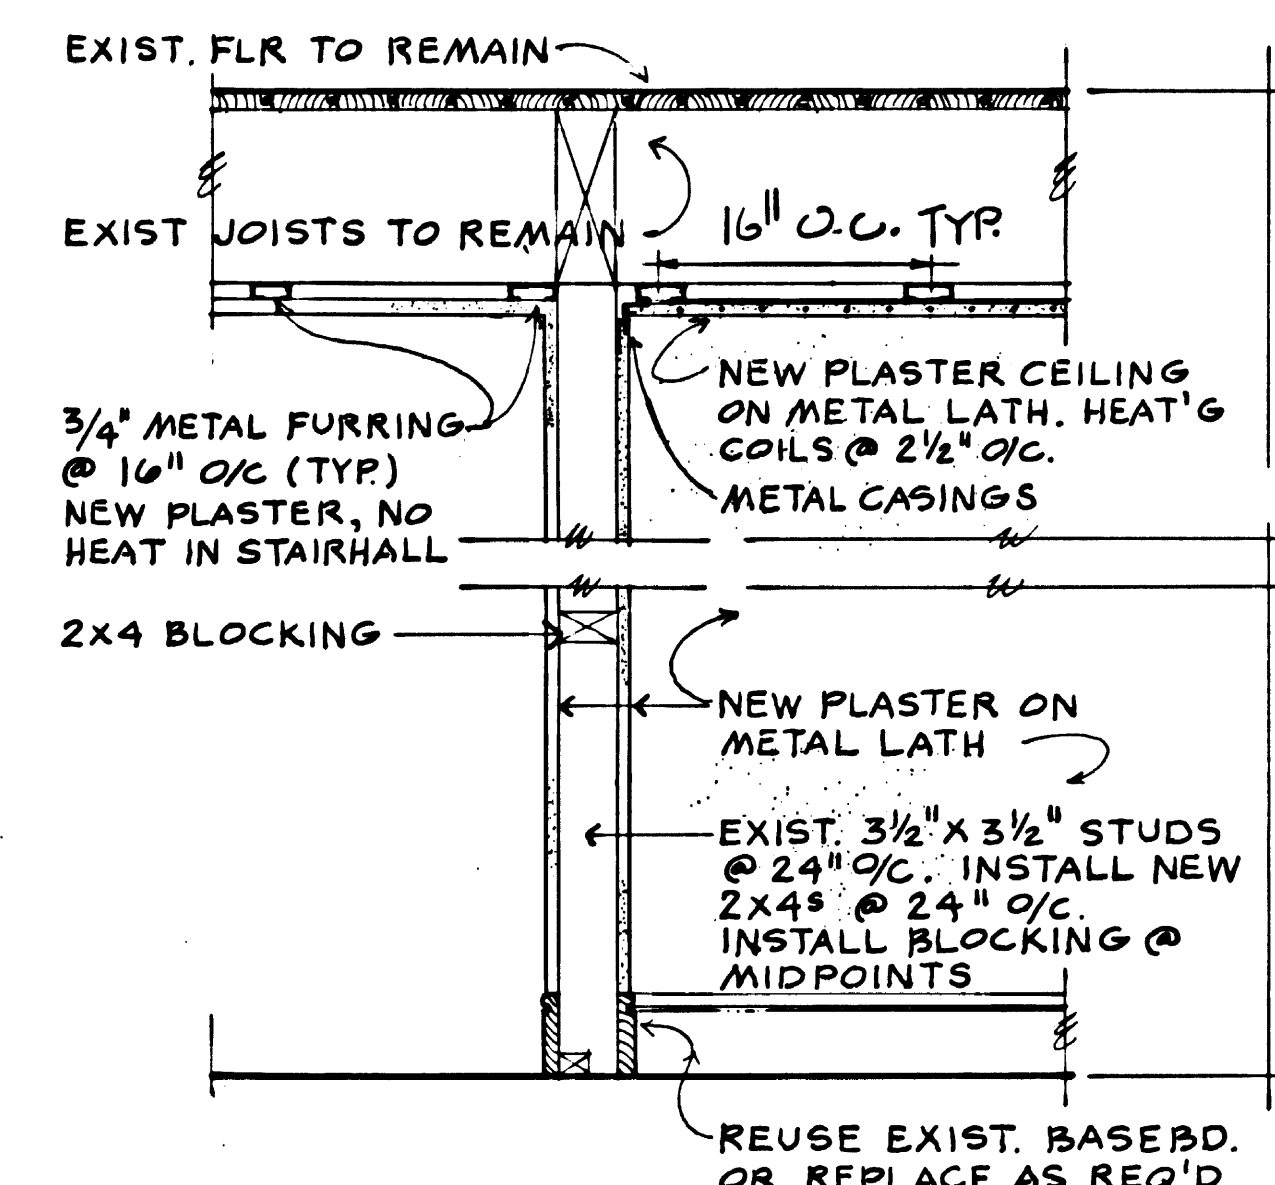

3 WALL SECTION
A-6 SCALE: 1" = 1'-0"

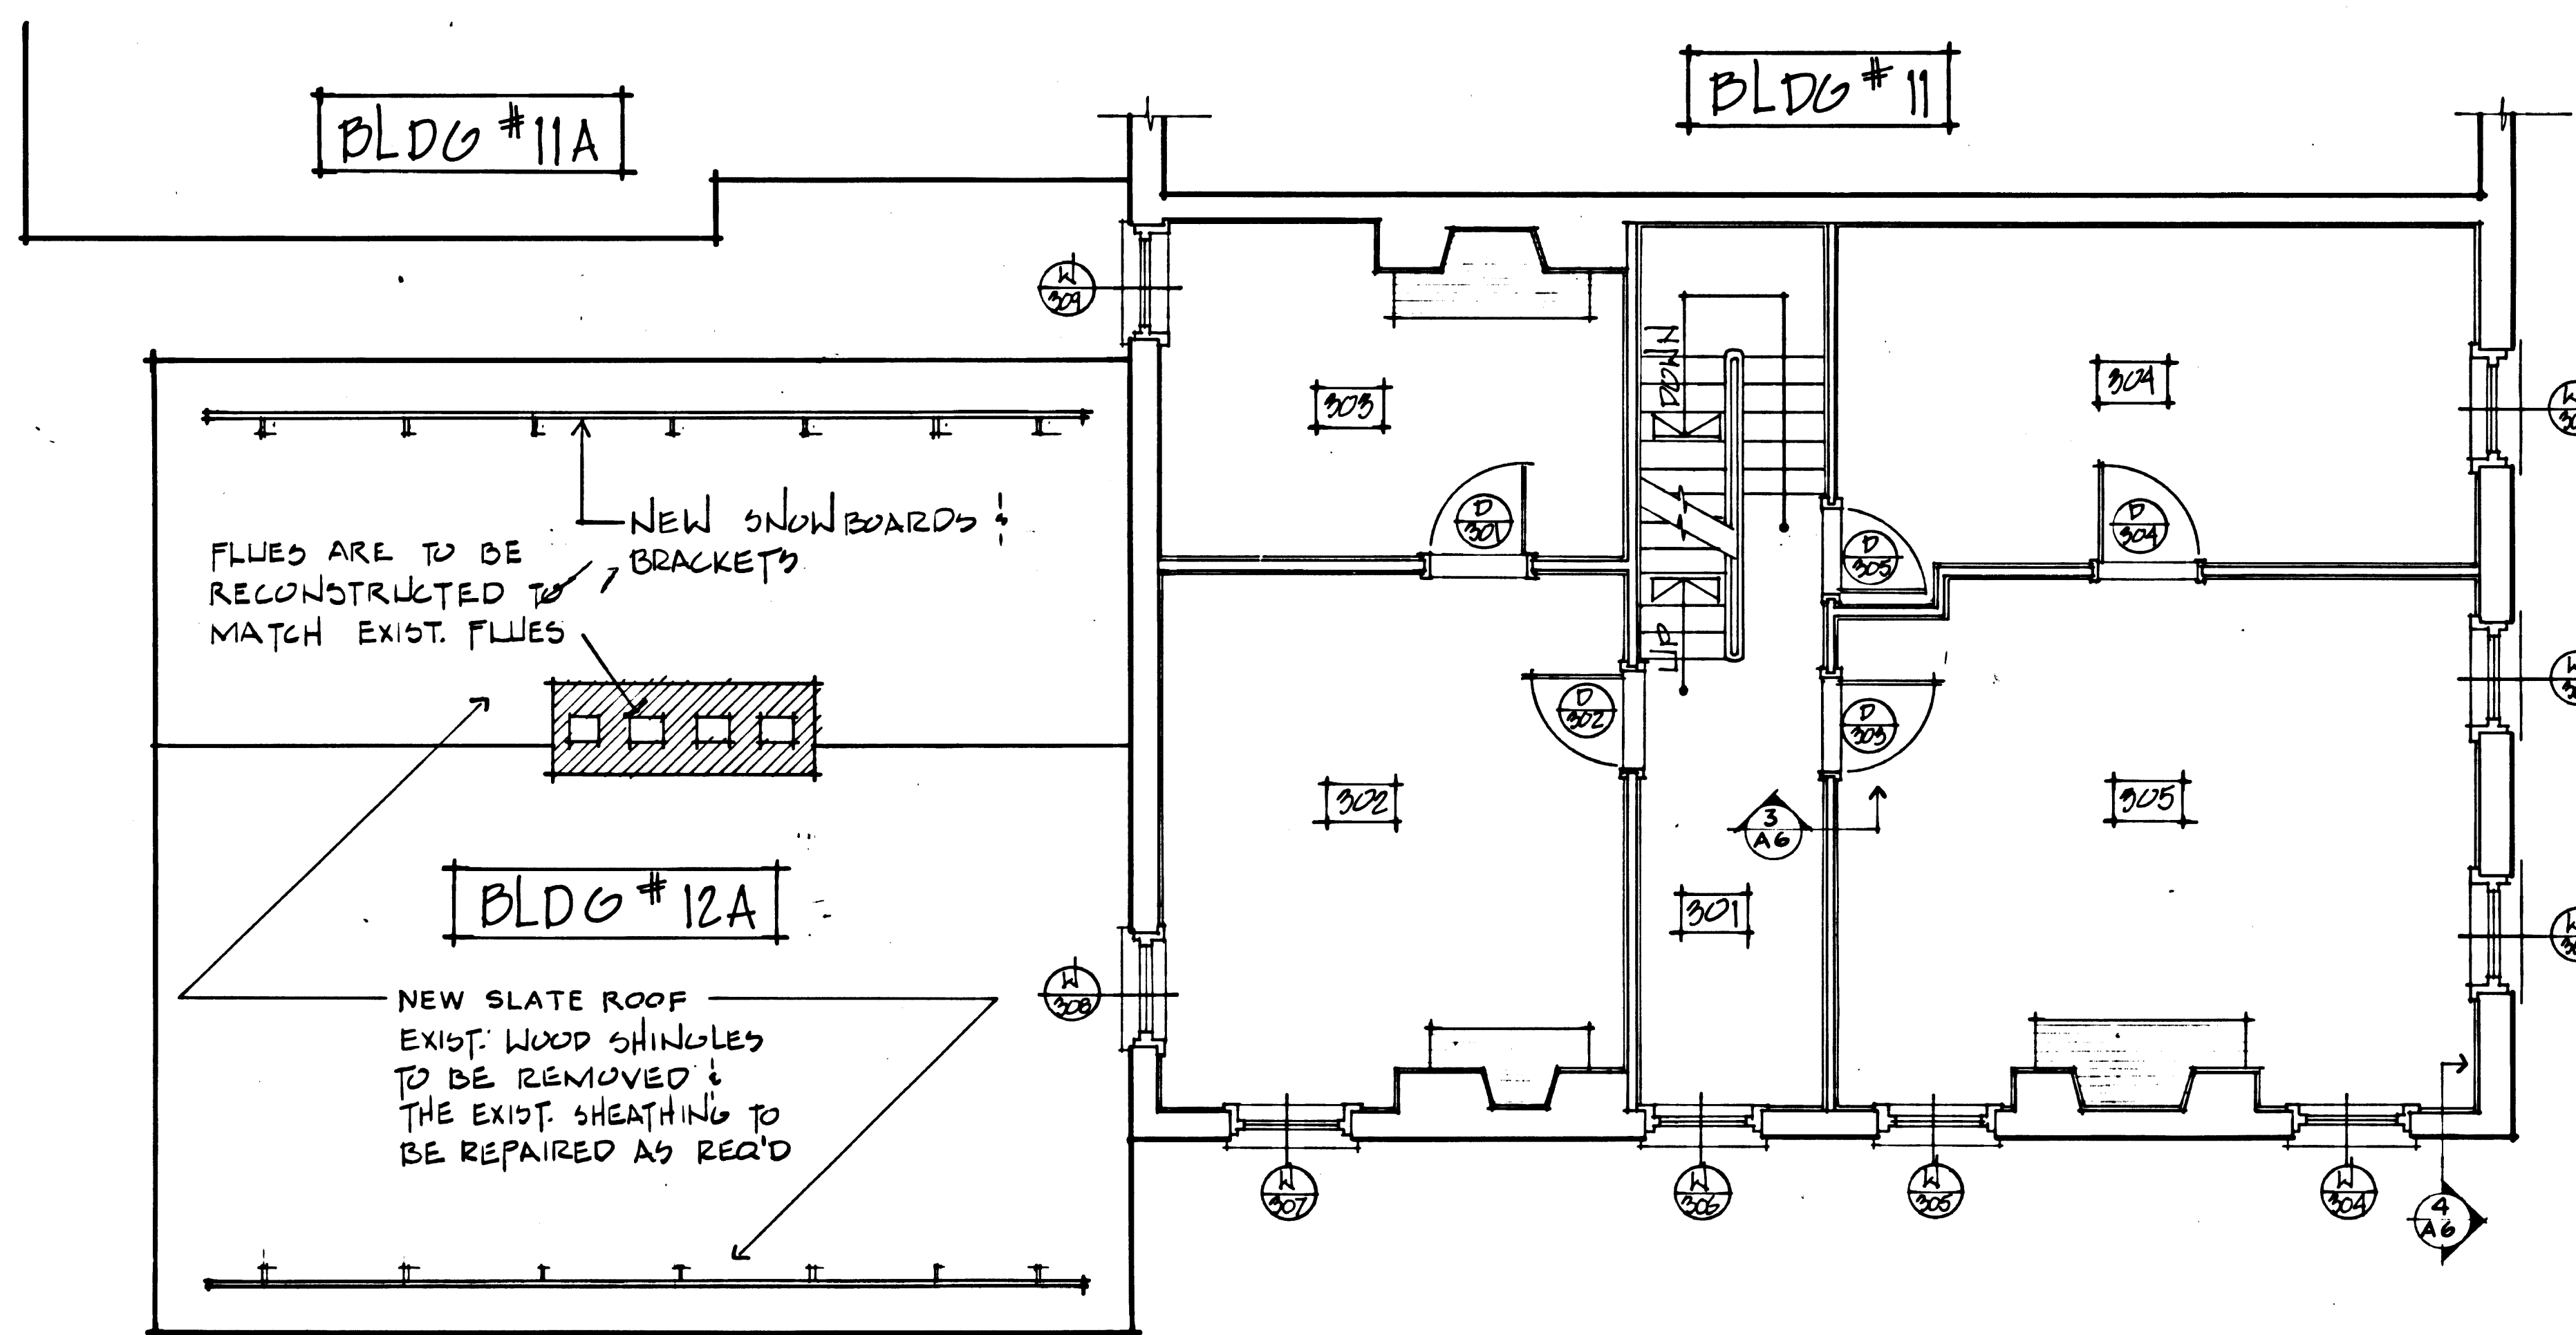


1 THIRD FLOOR PLAN
A-6 SCALE : 1/4" = 1'-0"

GENERAL NOTES
1. EXIST. FLRG. TO REMAIN LEVEL & PATCH AS REQ'D.
2. EXIST. STUD WALLS TO REMAIN SEE DETAIL 3/6


PHASE - II-B
RESTORATION

THIRD FLOOR PLAN - BLDG 12 & 12A
SCALE : 1/4" = 1'-0"

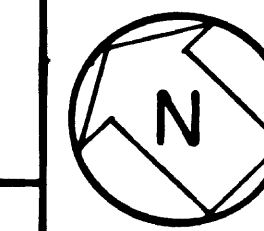


A-6		DRAWING NO. 385	
PREPARED	RSJ/WLB	DESIGNED	JACOBS
DRAWN	BARLOW	CHECKED	6/78
DATE			
SHEET 6		OF 65	


Contractor shall verify all dimensions and take own measurements at the job site before commencing work. Assume all errors are his responsibility.

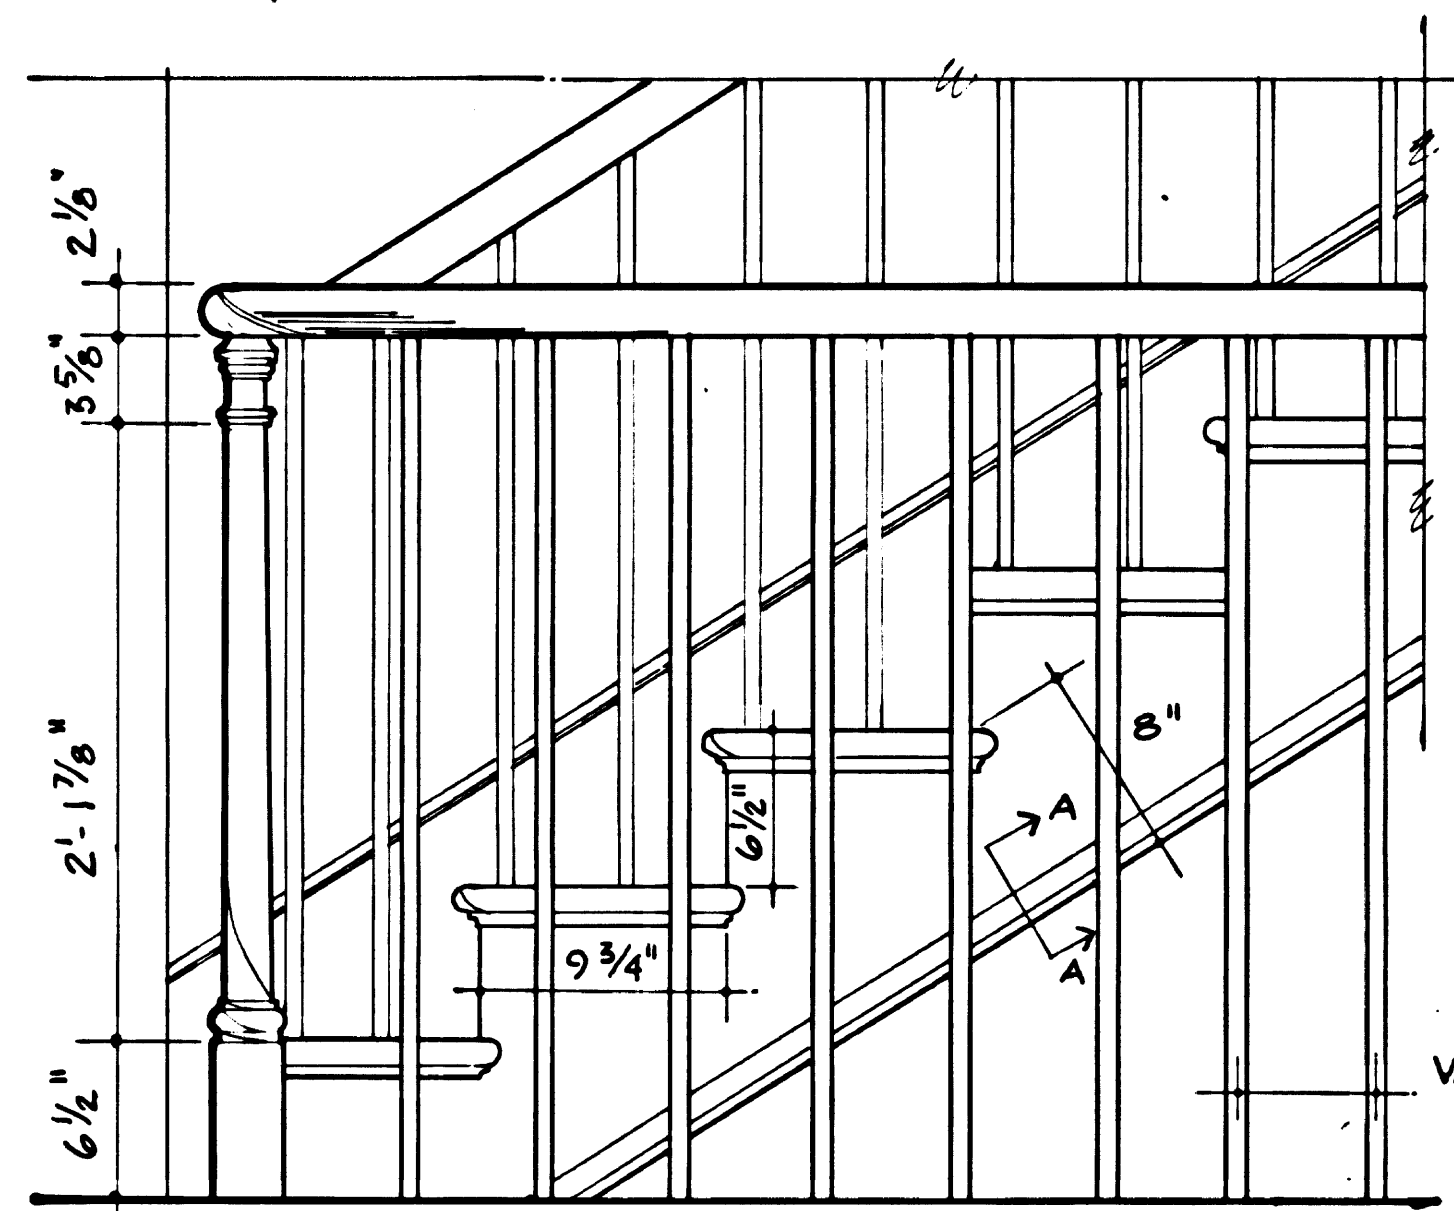


④ PARTIAL STAIR#1 ELEV.
SCALE: 1 1/2" = 1'-0"

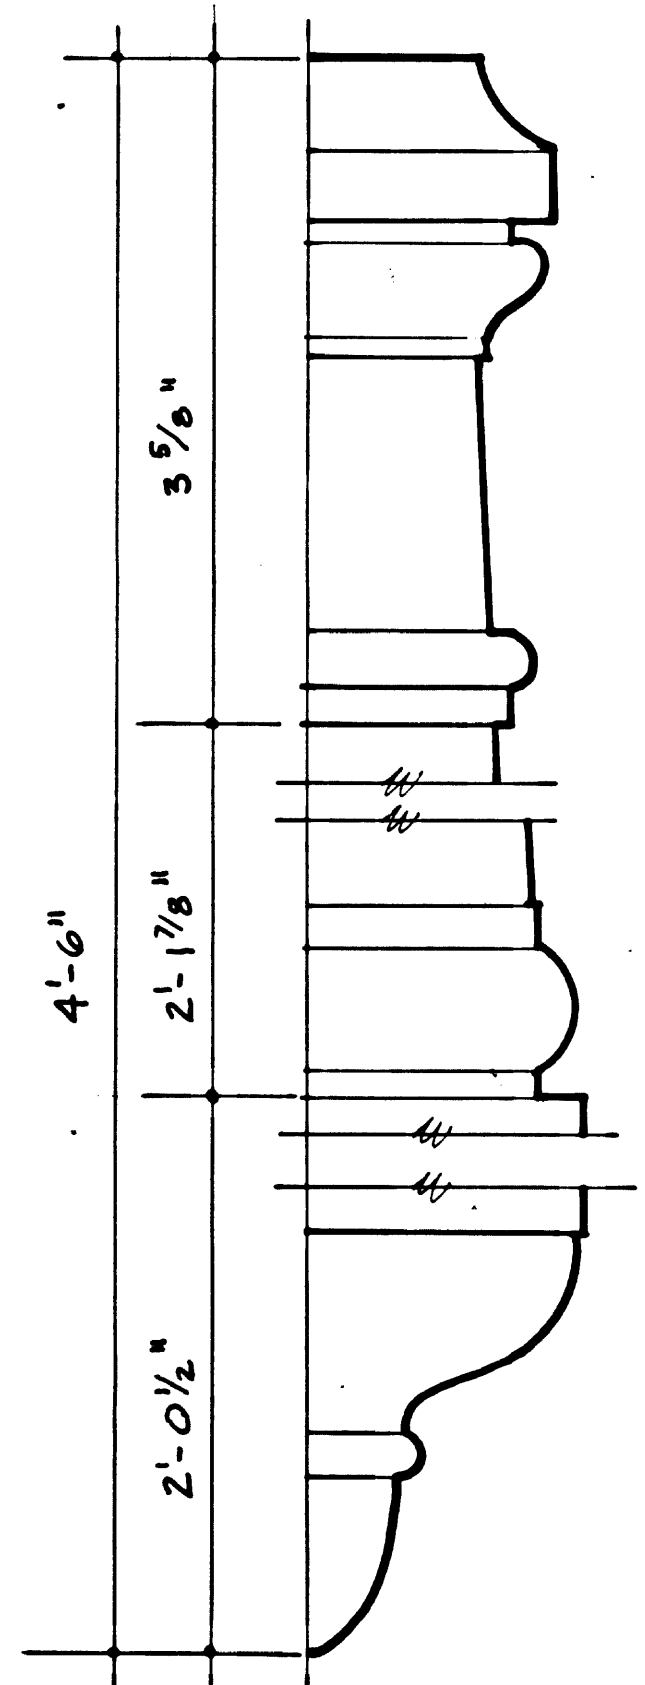

③ F.S. NEWEL POST
& DROP

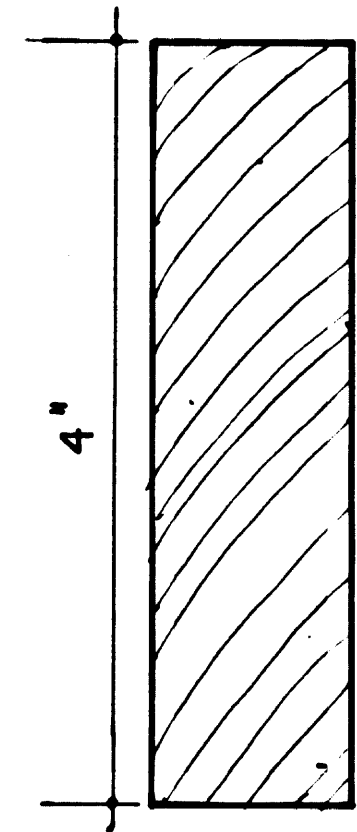


② F.S. BASEBD.
4TH FLOOR

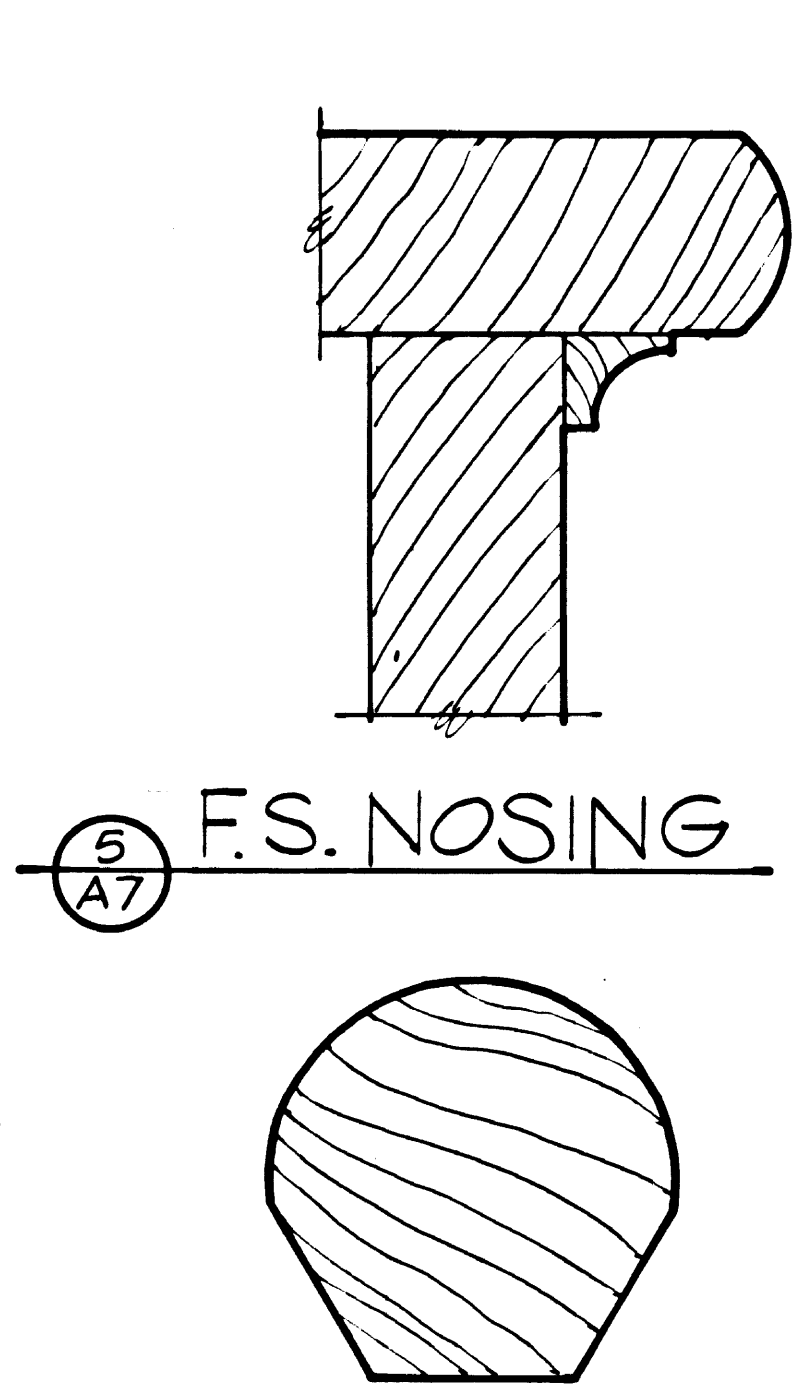


⑤ F.S. NOSING


⑥ F.S. HANDRAIL

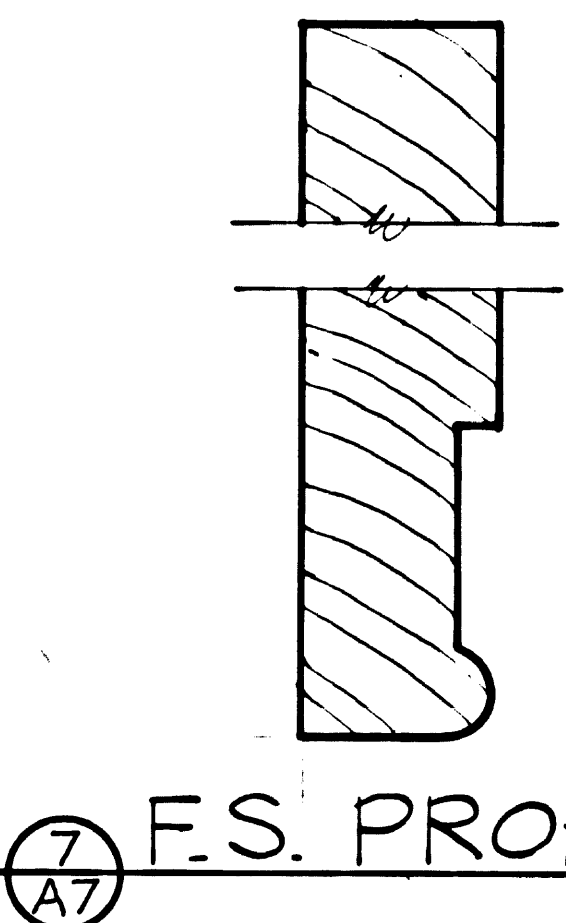


⑦ F.S. PROFILE A-A

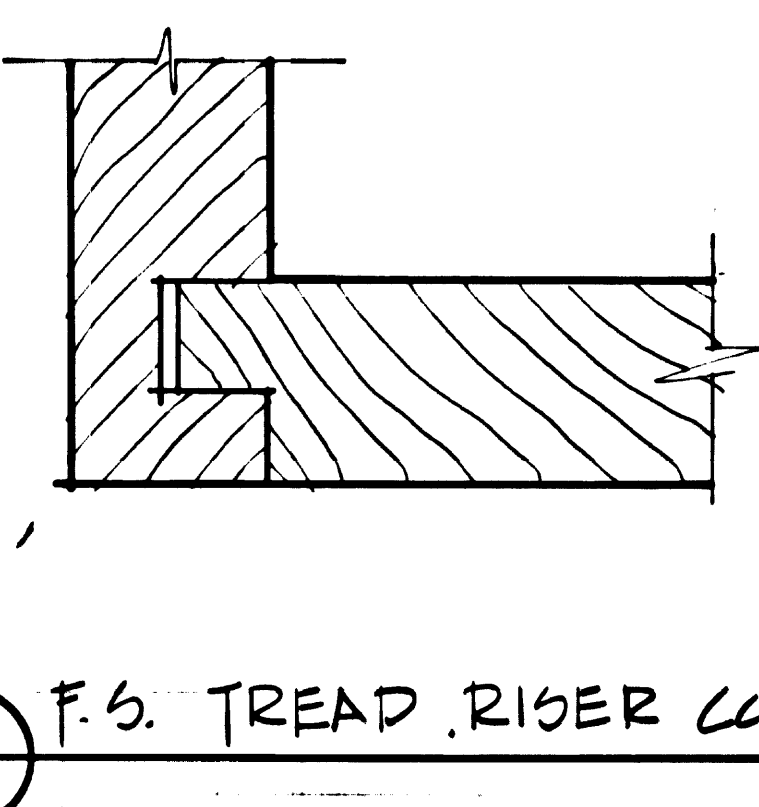

⑧ F.S. TREAD RISER CONN.

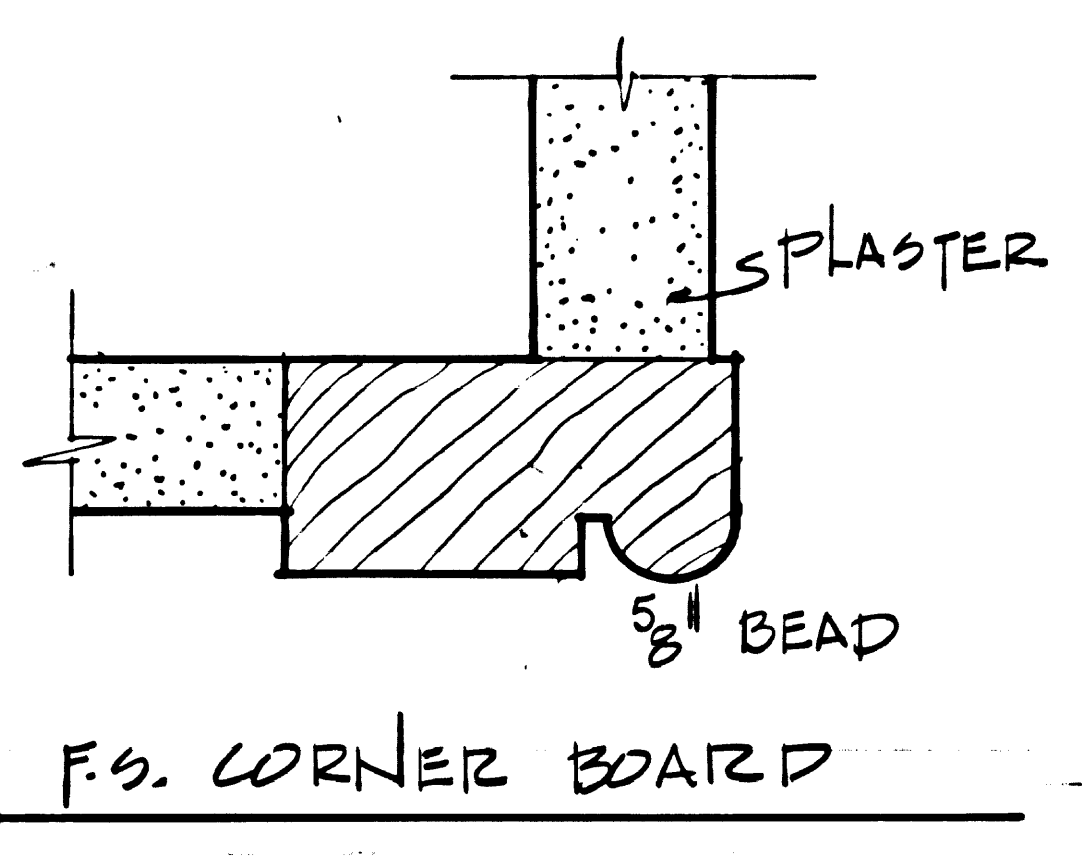


⑨ F.S. CORNER BOARD

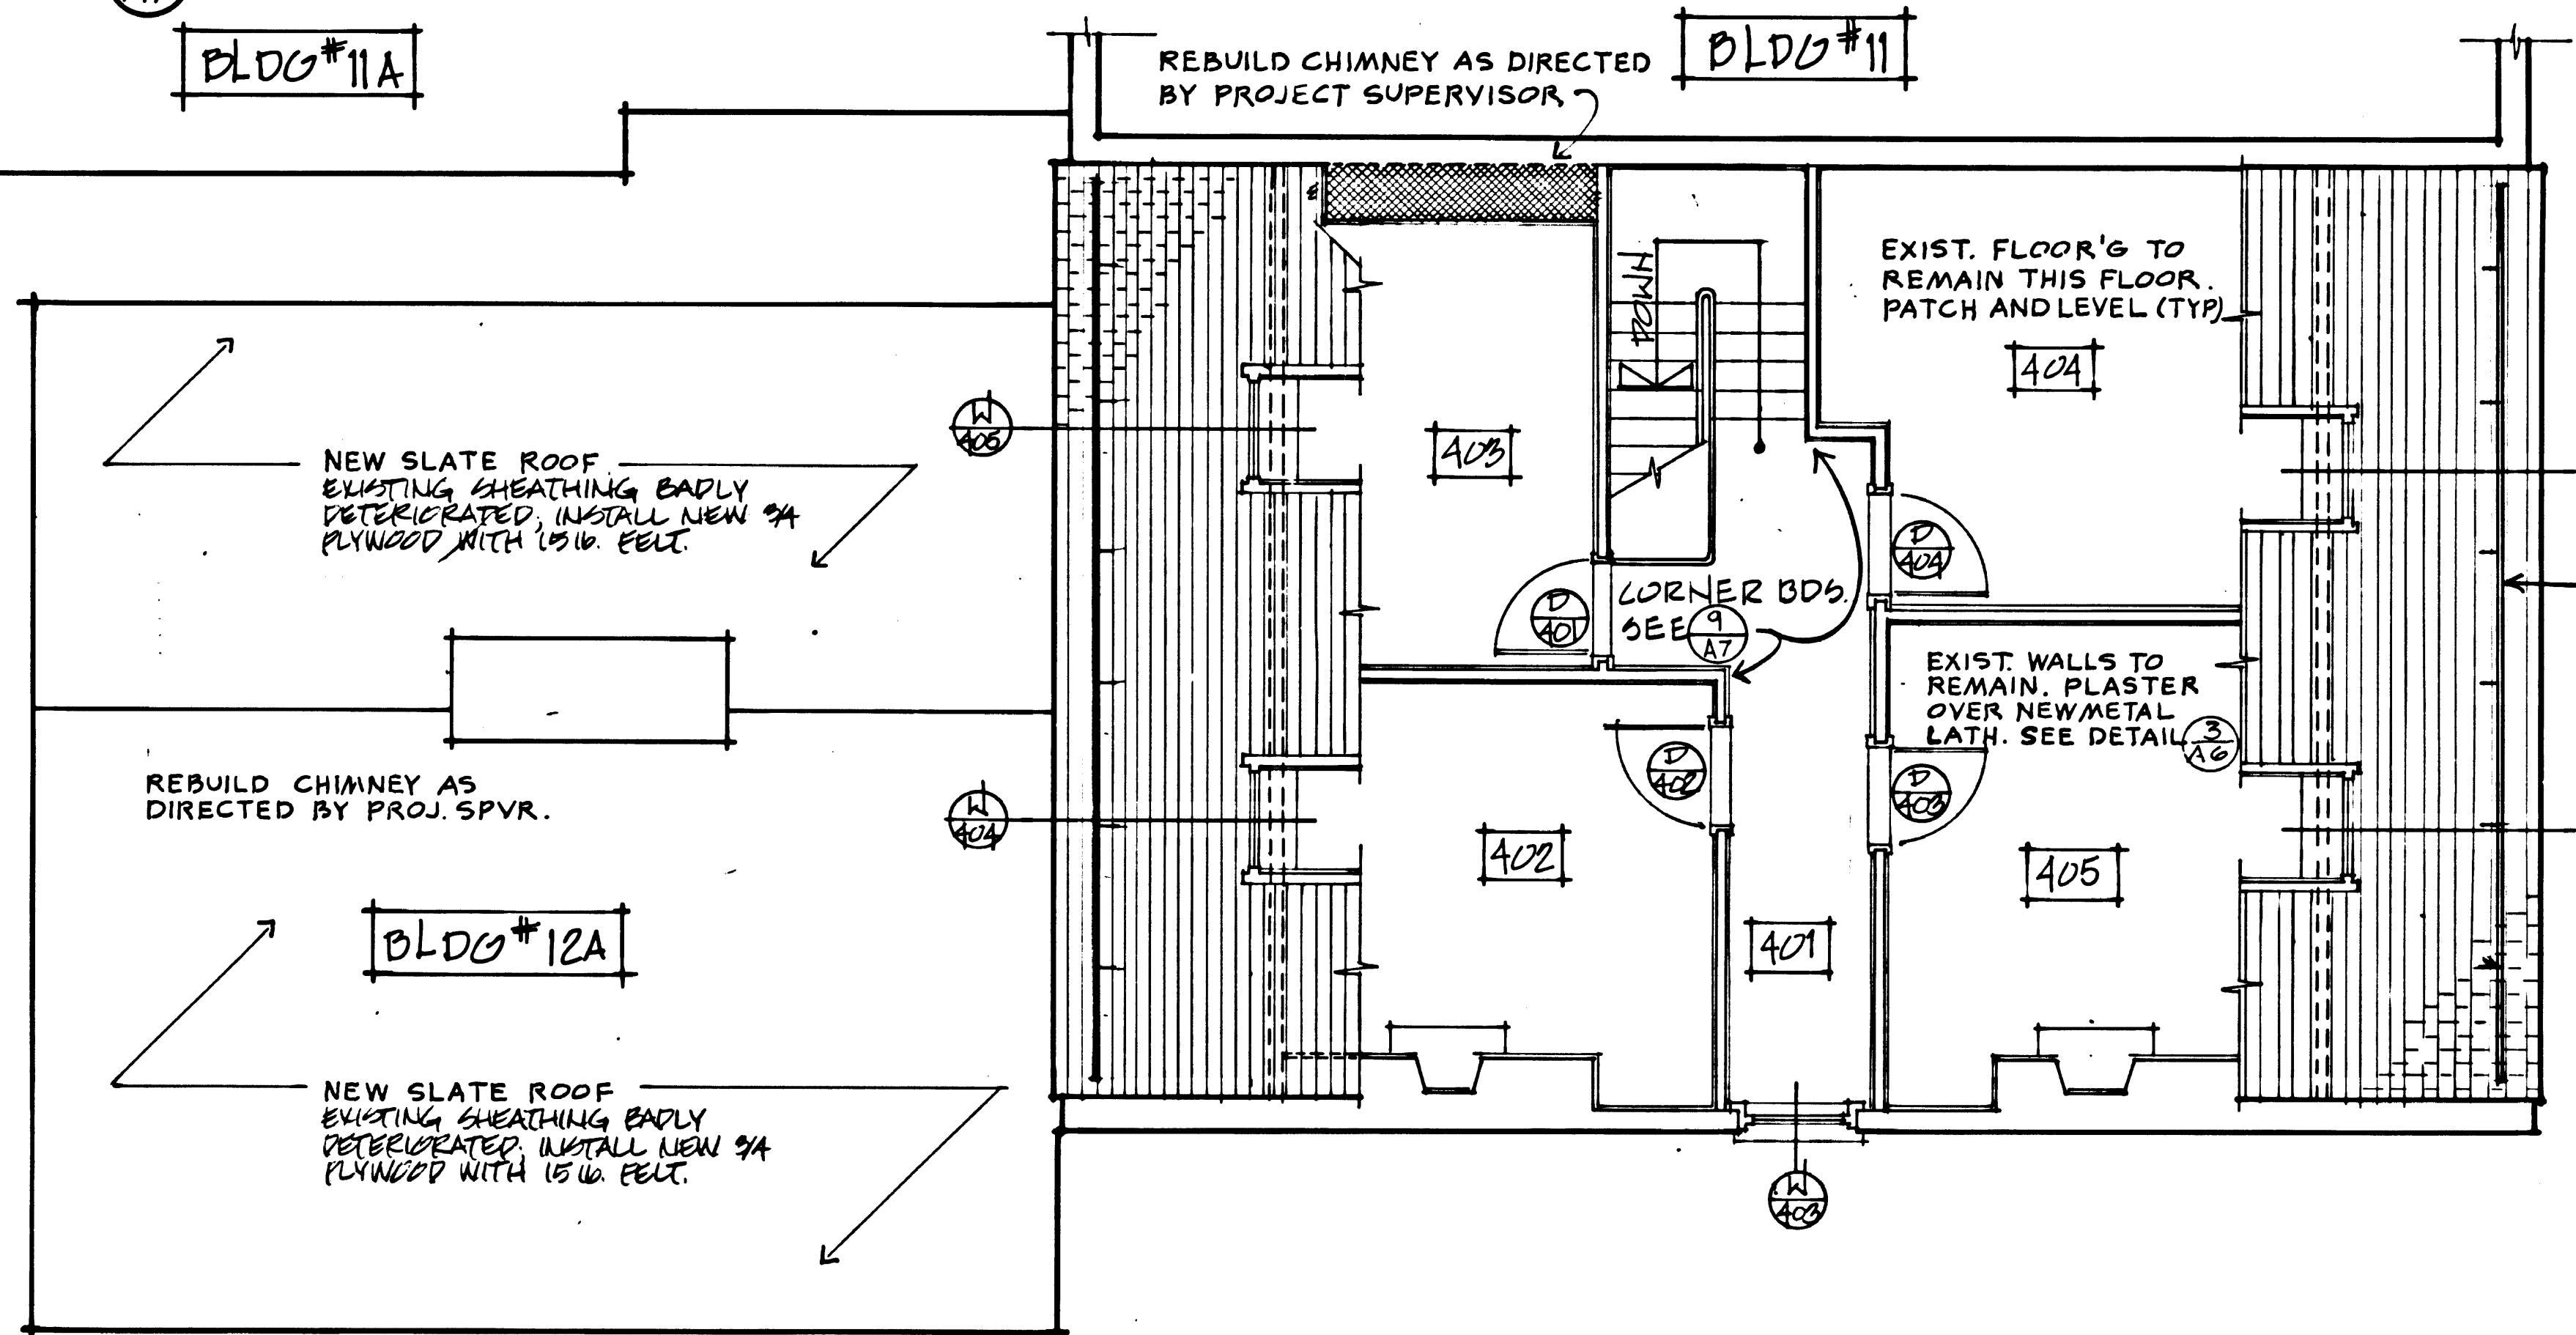

① FOURTH FLOOR PLAN
SCALE: 1/4" = 1'-0"


PHASE - II-B
RESTORATION

FOURTH FLOOR PLAN - BLDG 12 & 12A
SCALE: 1/4" = 1'-0"

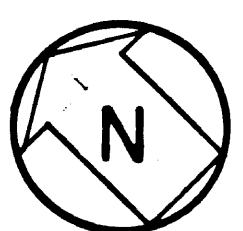


A-7		DRAWING NO.	
PREPARED	RSJ/WLB	385	
DESIGNED	JACOBS	25,006A	
DRAWN	BARLOW		
CHECKED	6/78		
DATE			
PCIP PKG.		SHEET	
110		7	
		OF 65	

Contractor shall verify all dimensions and take own measurements at all times before commencing work. Advise of any need for clarification.

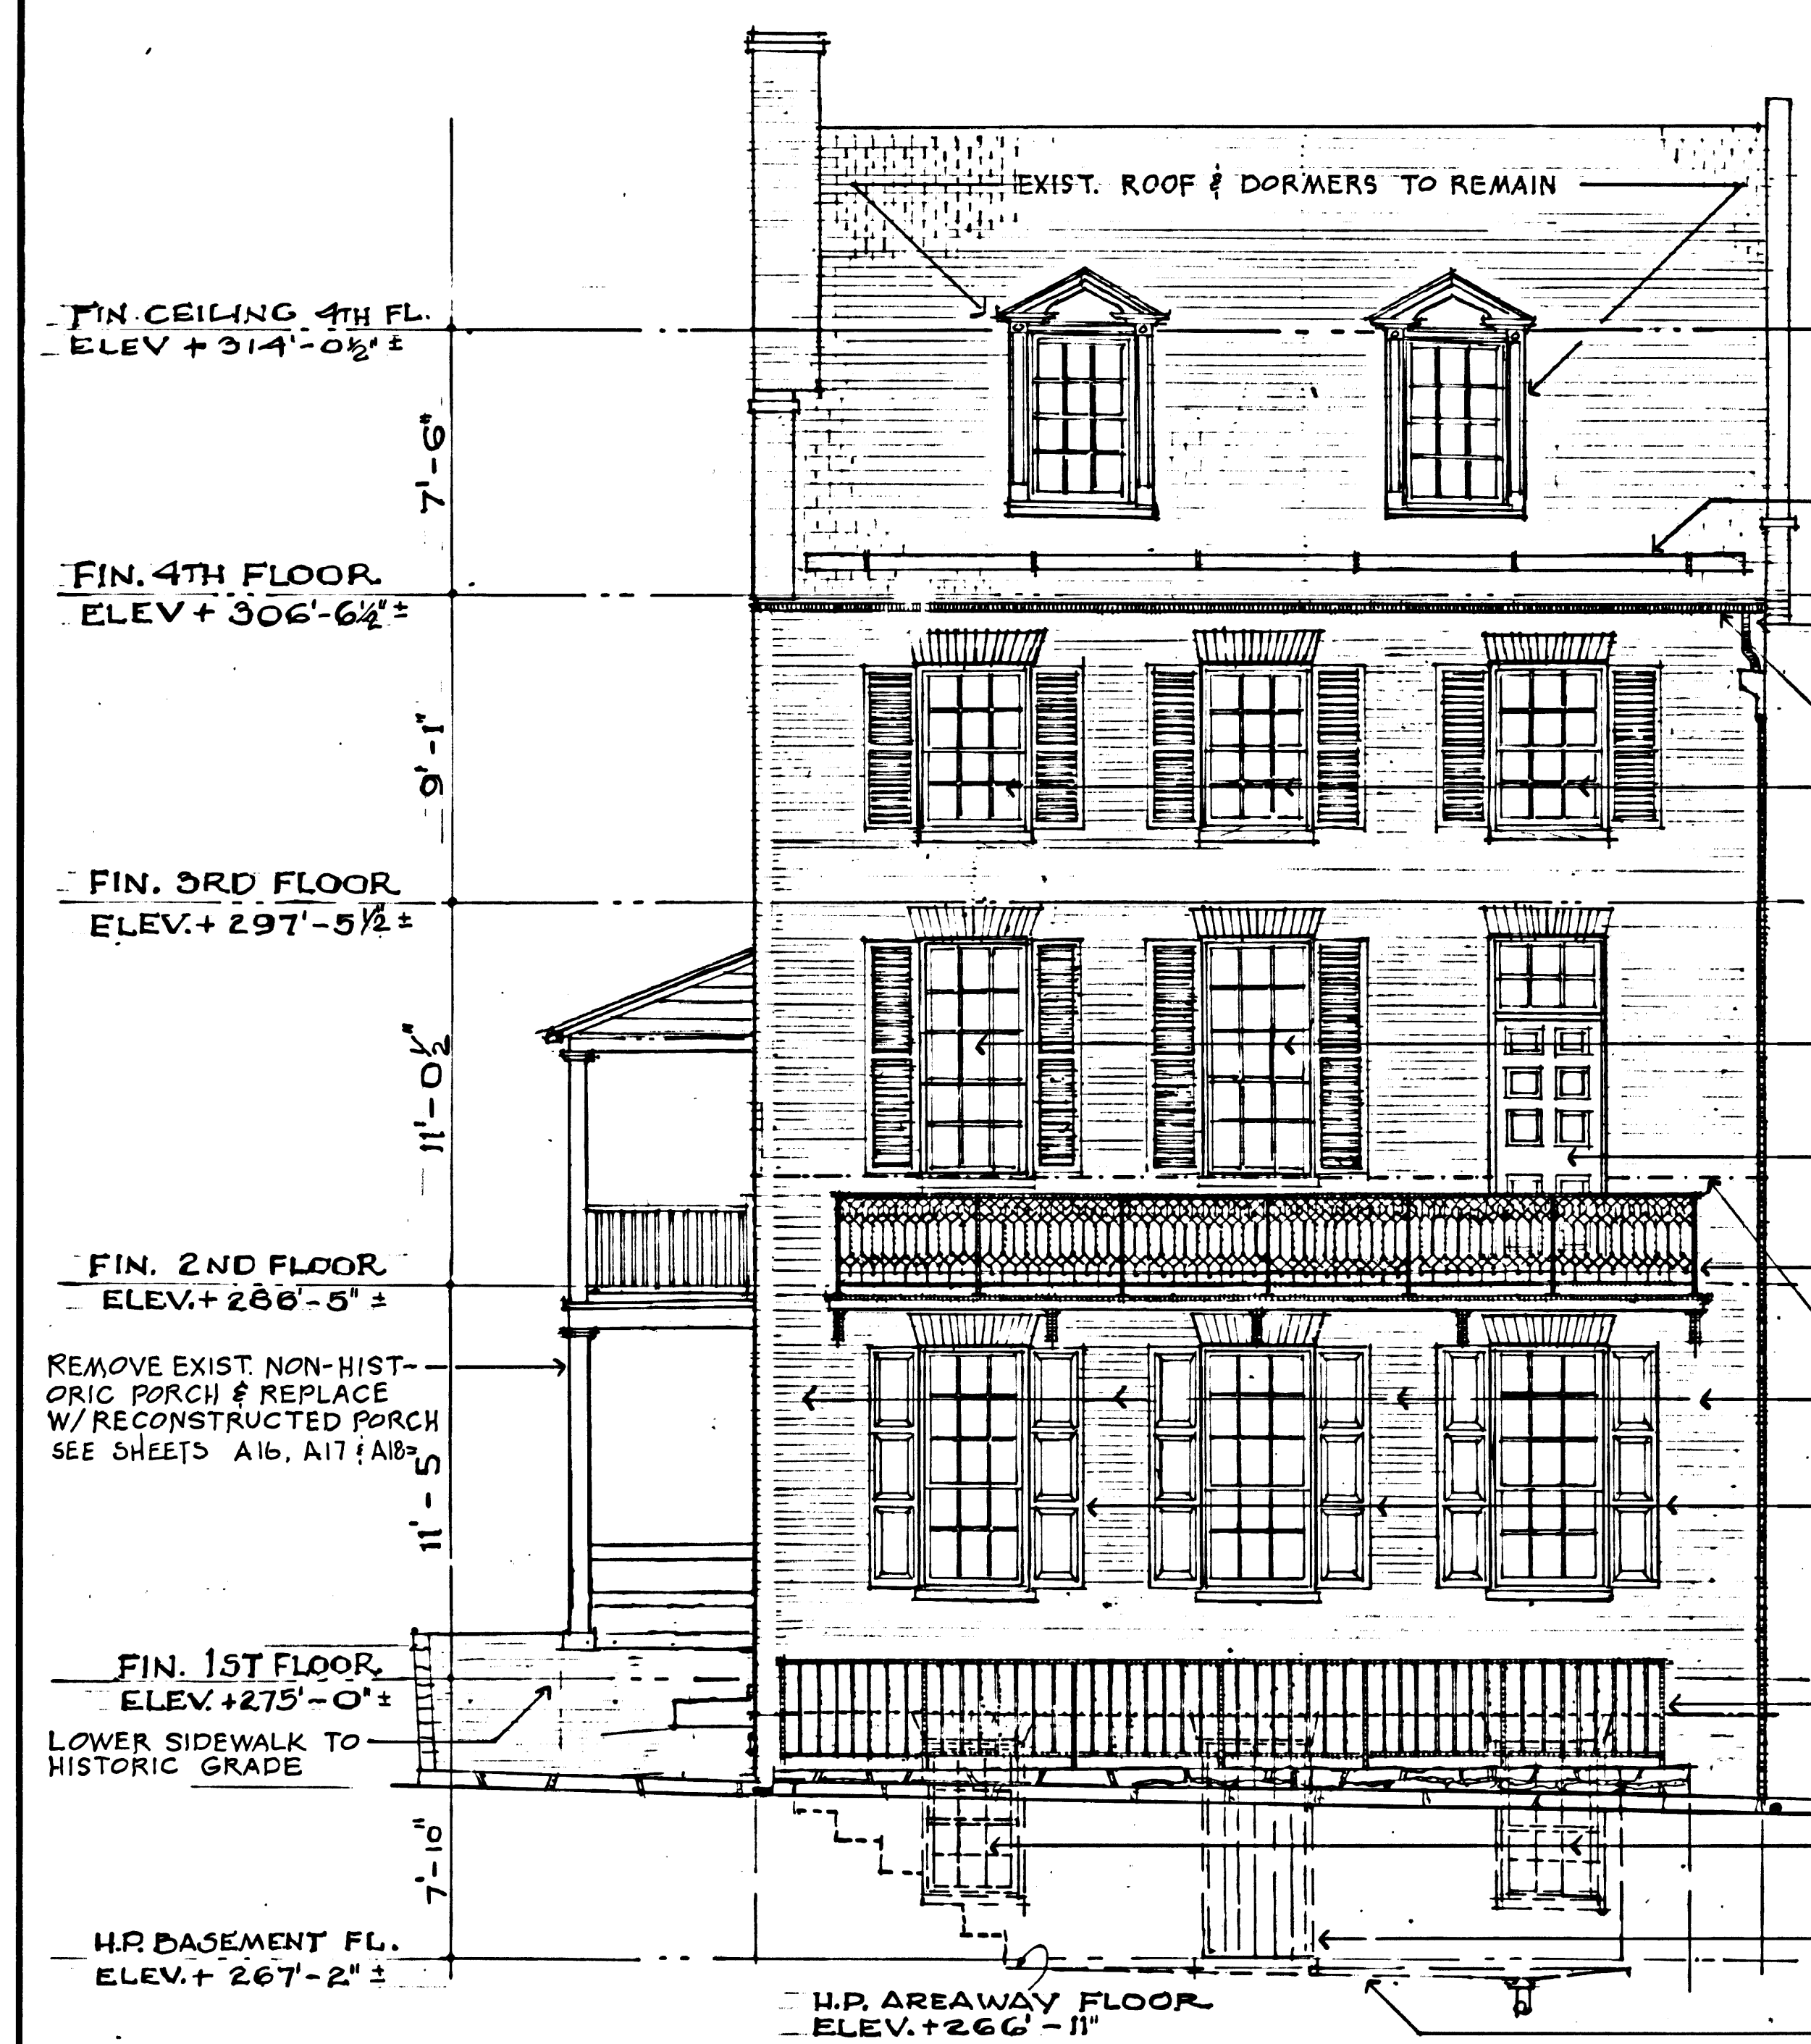

1
A-8
EAST ELEVATION BLDG 12 & 12A

- REPLACE EXISTING SNOW-BOARDS - BRACKETS TO REMAIN
- NEW GUTTER TO ATTACH W/ BLDG #11 EXIST. DOWNSPOUT
- NEW GUTTERS & DOWNSPOUTS
- REPAIR EXIST. WINDOWS AS REQ'D. INSTALL NEW SHUTTERS
- INSTALL NEW SASH & SHUTTERS IN ORIGINAL MASONRY OPENINGS TO MATCH HISTORIC.
- REPAIR EXIST. HISTORIC DOOR & TRANSOM IN ORIGINAL MASONRY OPENING.
- NEW CAST IRON BALCONY SEE SHEETS A-20 & A-21
- NEW BRICK WORK TO MATCH ORIGINAL. REPLACES NON-HISTORIC STORE FRONT. (OUTLINED AREA ONLY)
- INSTALL NEW WINDOW FRAMES, SASH, AND SHUTTERS TO MATCH HISTORIC.
- NEW MILD STEEL RAILING
- REMOVE EXIST. BRICK INFILL IN STONE BASEMENT WALL. INSTALL NEW WINDOWS, FRAMES & SASH.
- REMOVE EXIST. BRICK INFILL. INSTALL NEW DOOR & FRAME
- AREAWAY UNCOVERED BY ARCHEOLOGIST. INSTALL NEW STONE FLOOR. EXIST. STONE & BRICK STEPS TO REMAIN.

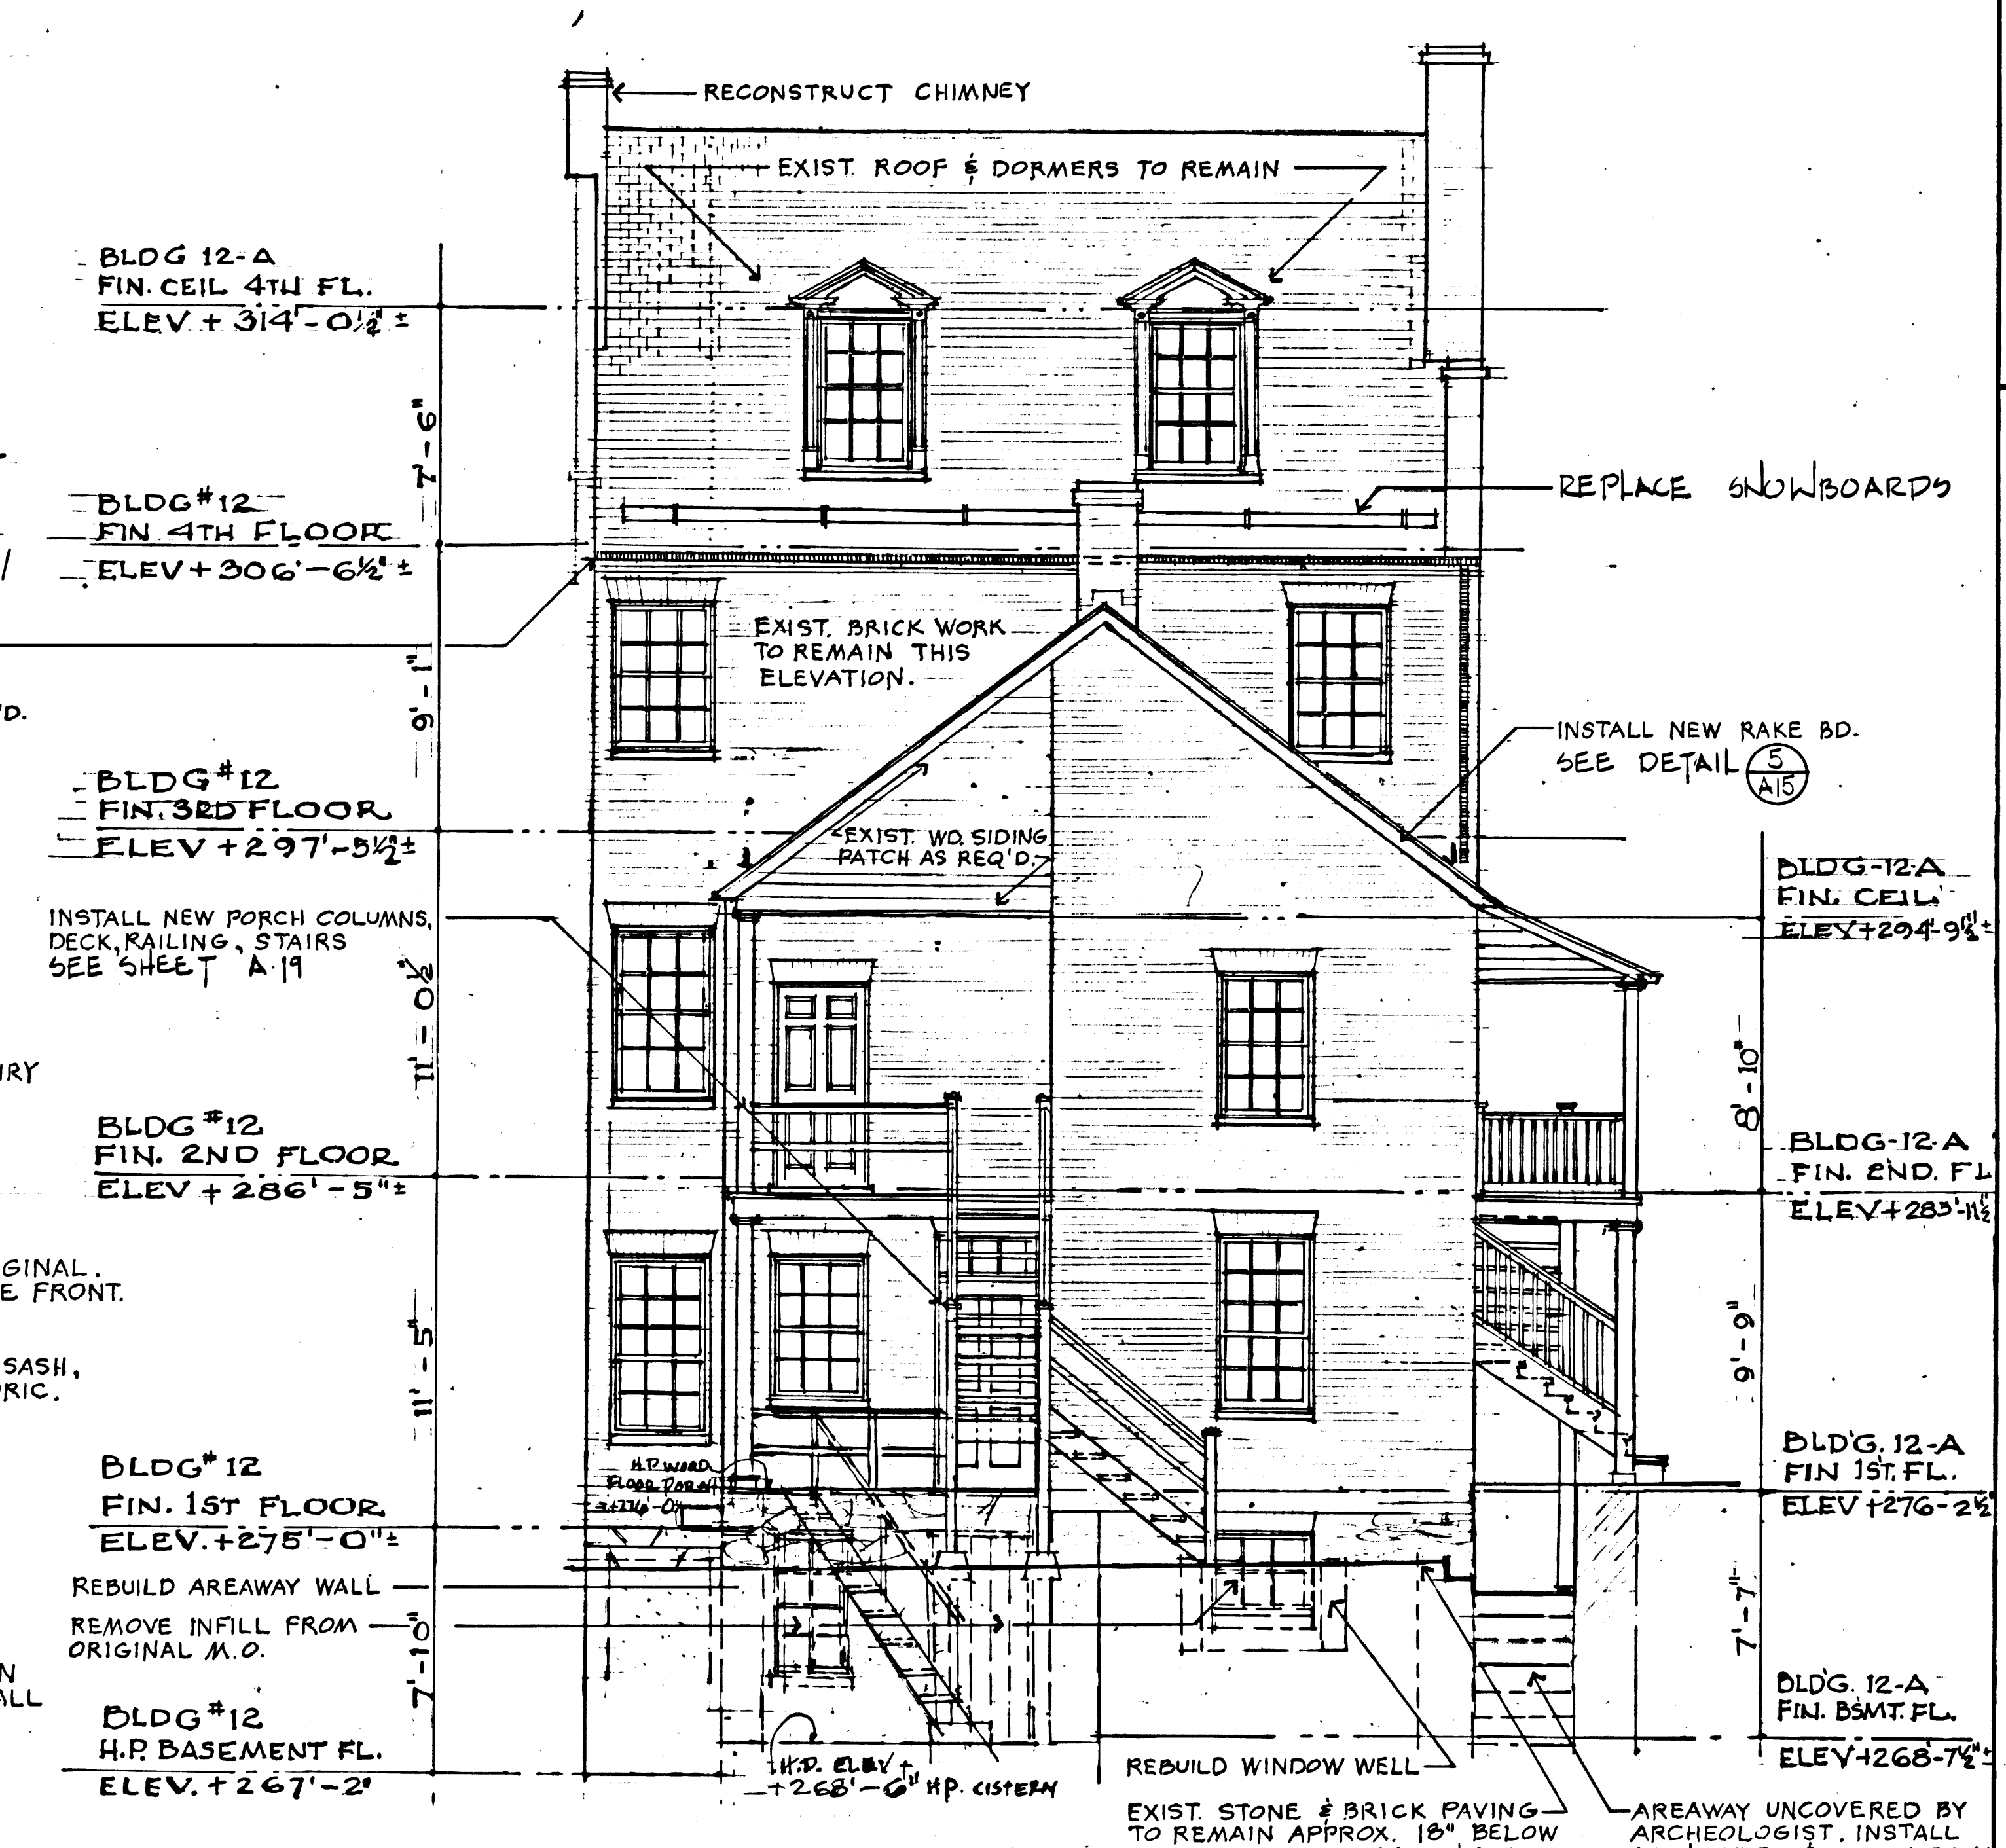

2
A-8
WEST ELEVATION BLDG 12 & 12A
SCALE 1/4" = 1'-0"


- BLDG 12-A FIN. CEIL 4TH FL. ELEV. + 314'-0 1/2"
- BLDG #12 FIN. 4TH FLOOR ELEV. + 306'-6 1/2"
- BLDG #12 FIN. 3RD FLOOR ELEV. + 297'-5 1/2"
- INSTALL NEW PORCH COLUMNS, DECK, RAILING, STAIRS SEE SHEET A-19
- BLDG #12 FIN. 2ND FLOOR ELEV. + 286'-5"
- BLDG #12 FIN. 1ST FLOOR ELEV. + 275'-0"
- REBUILD AREAWAY WALL REMOVE INFILL FROM ORIGINAL M.O.
- BLDG #12 H.P. BASEMENT FL. ELEV. + 267'-2"

PHASE II B
RESTORATION

EAST & WEST ELEVATIONS BUILDINGS 12 & 12A
SCALE 1/4" = 1'-0"

A-8		DRAWING NO.	25006A
PREPARED	RSJ/WLB	DESIGNED	GERNER
DRAWN	BARLOW	CHECKED	6/78
DATE			

110
8
OF 65

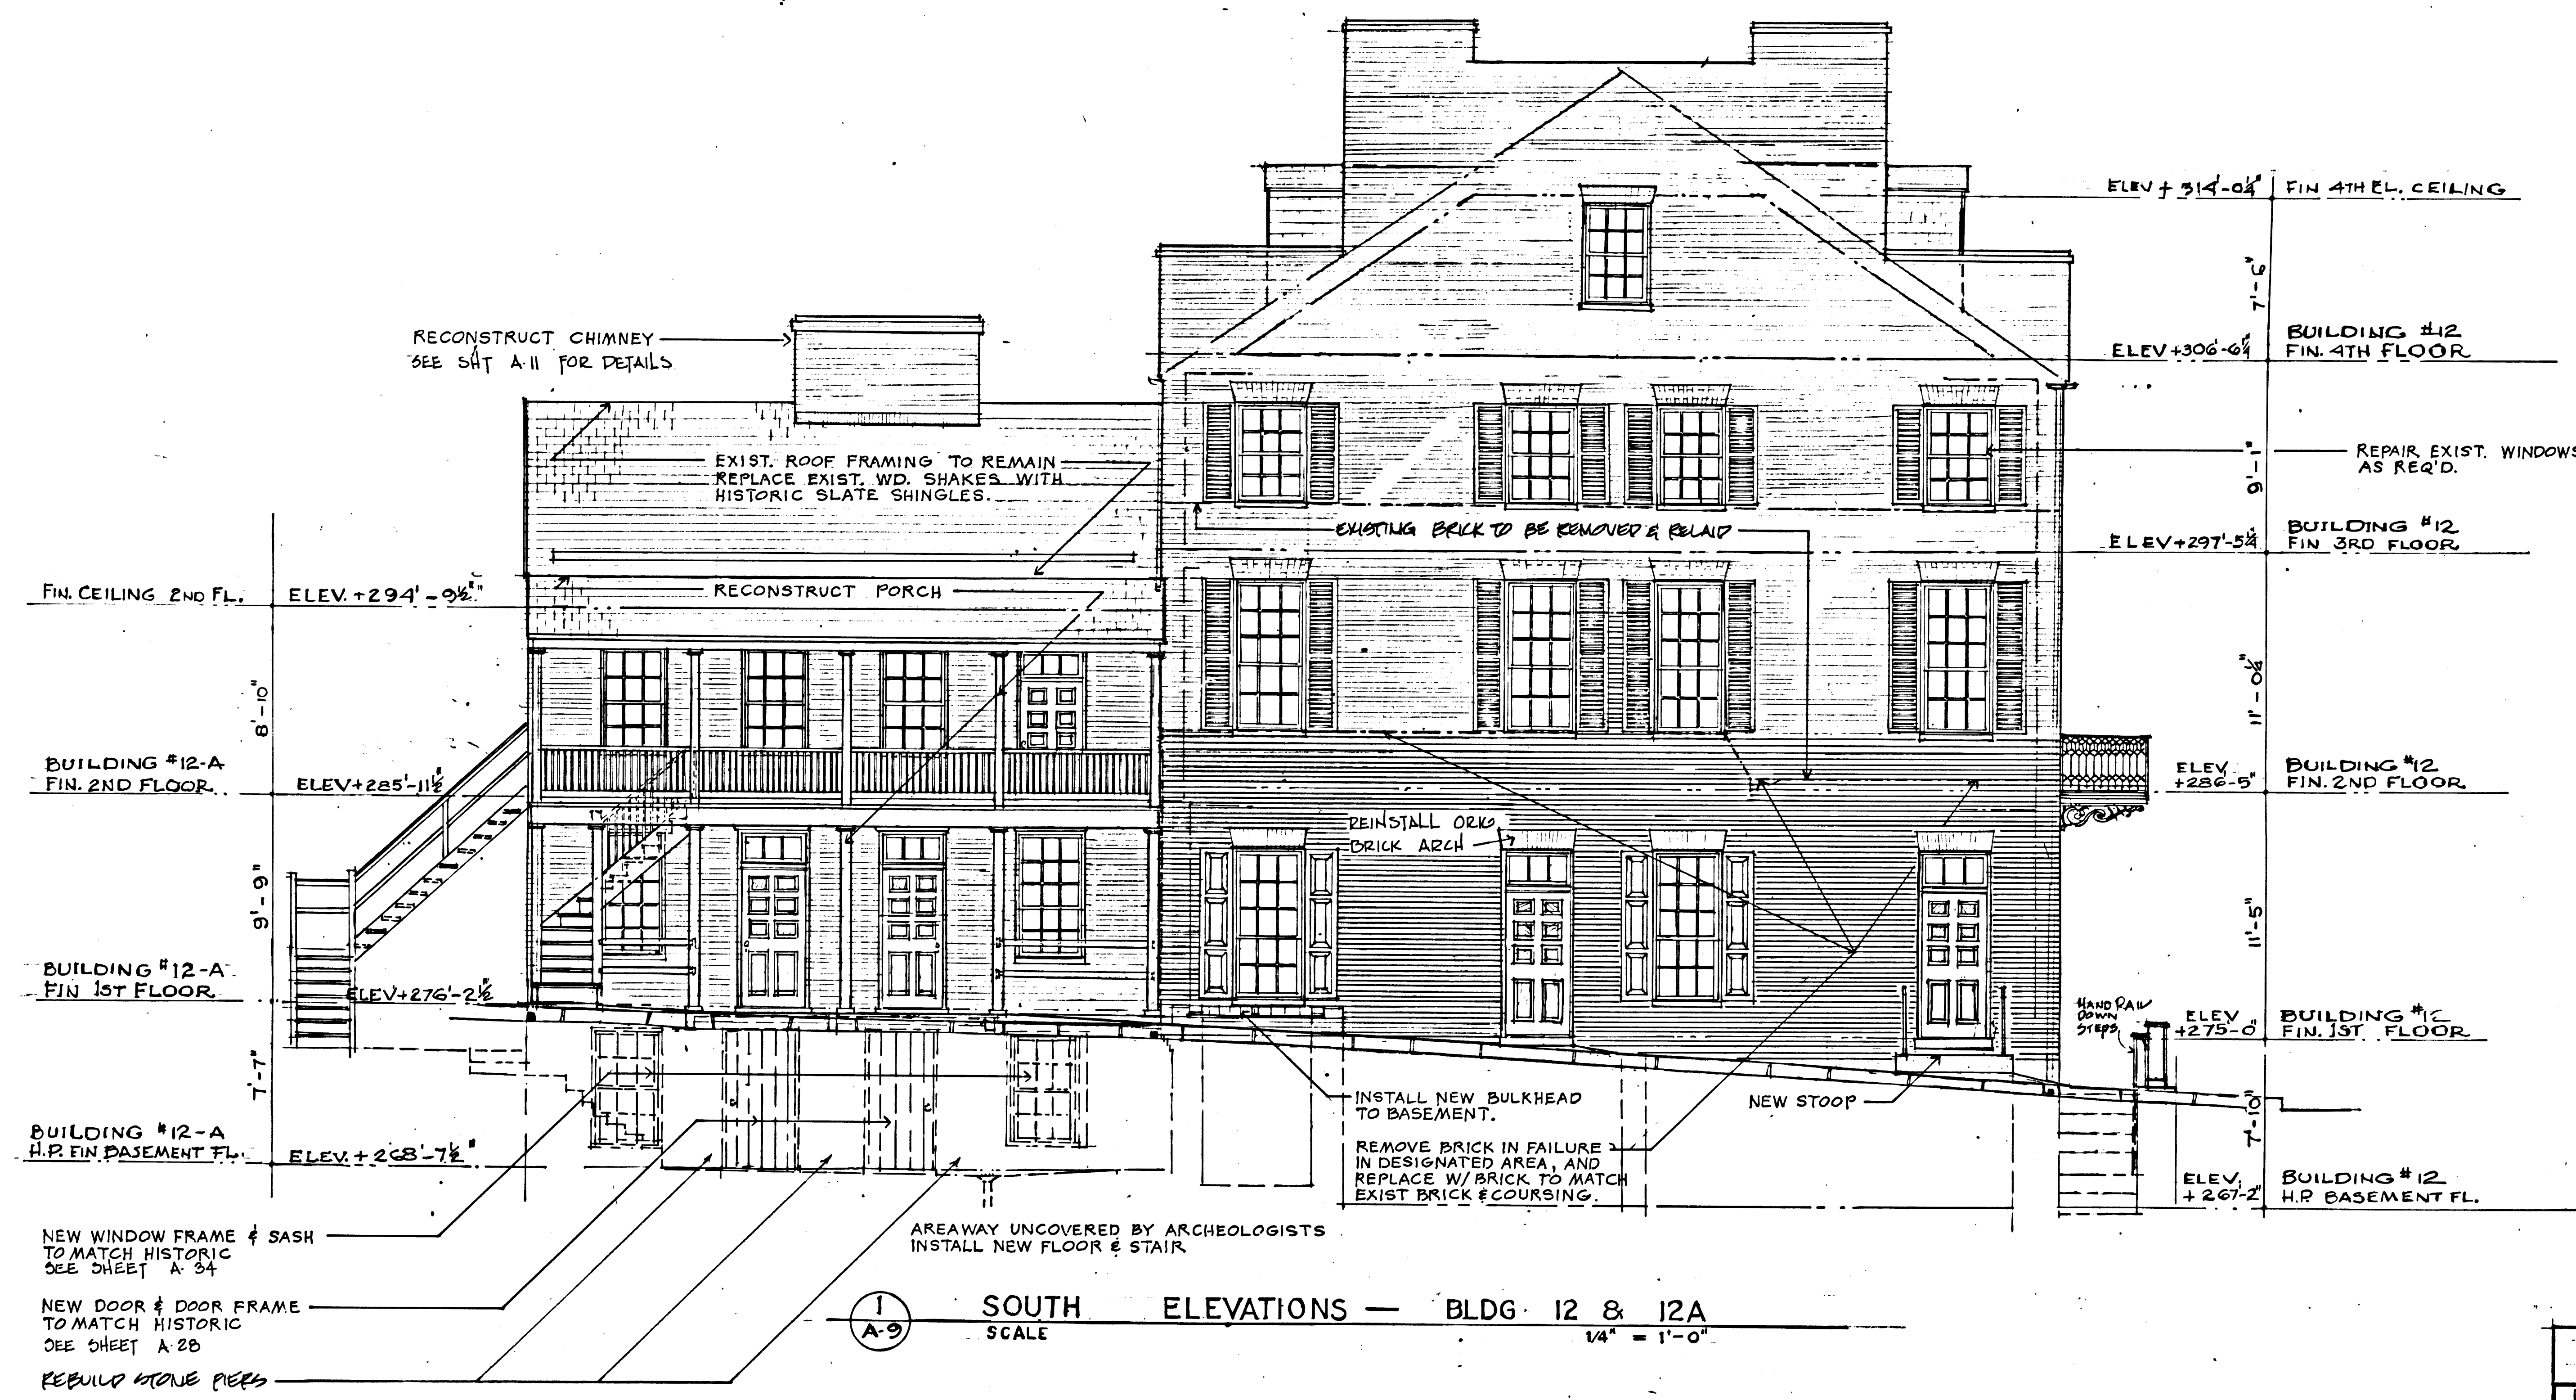

1 A-9 SOUTH ELEVATIONS — BLDG 12 & 12A
SCALE 1/4" = 1'-0"


PHASE II, B
RESTORATION

SOUTH ELEVATIONS BUILDINGS 12 & 12A

SCALE 1" = 10 FEET 1/4" = 1'-0"

A-9		DRAWING NO.	1385
PREPARED	RSJ/WLB	DESIGNED	GERNER
DRAWN	BARLOW	CHECKED	6/78
DATE			
PKG	110	SHEET	9
		OF	65

Contractor shall verify all dimensions and take own measurements in the field before commencing work. Advise of any error or discrepancy.

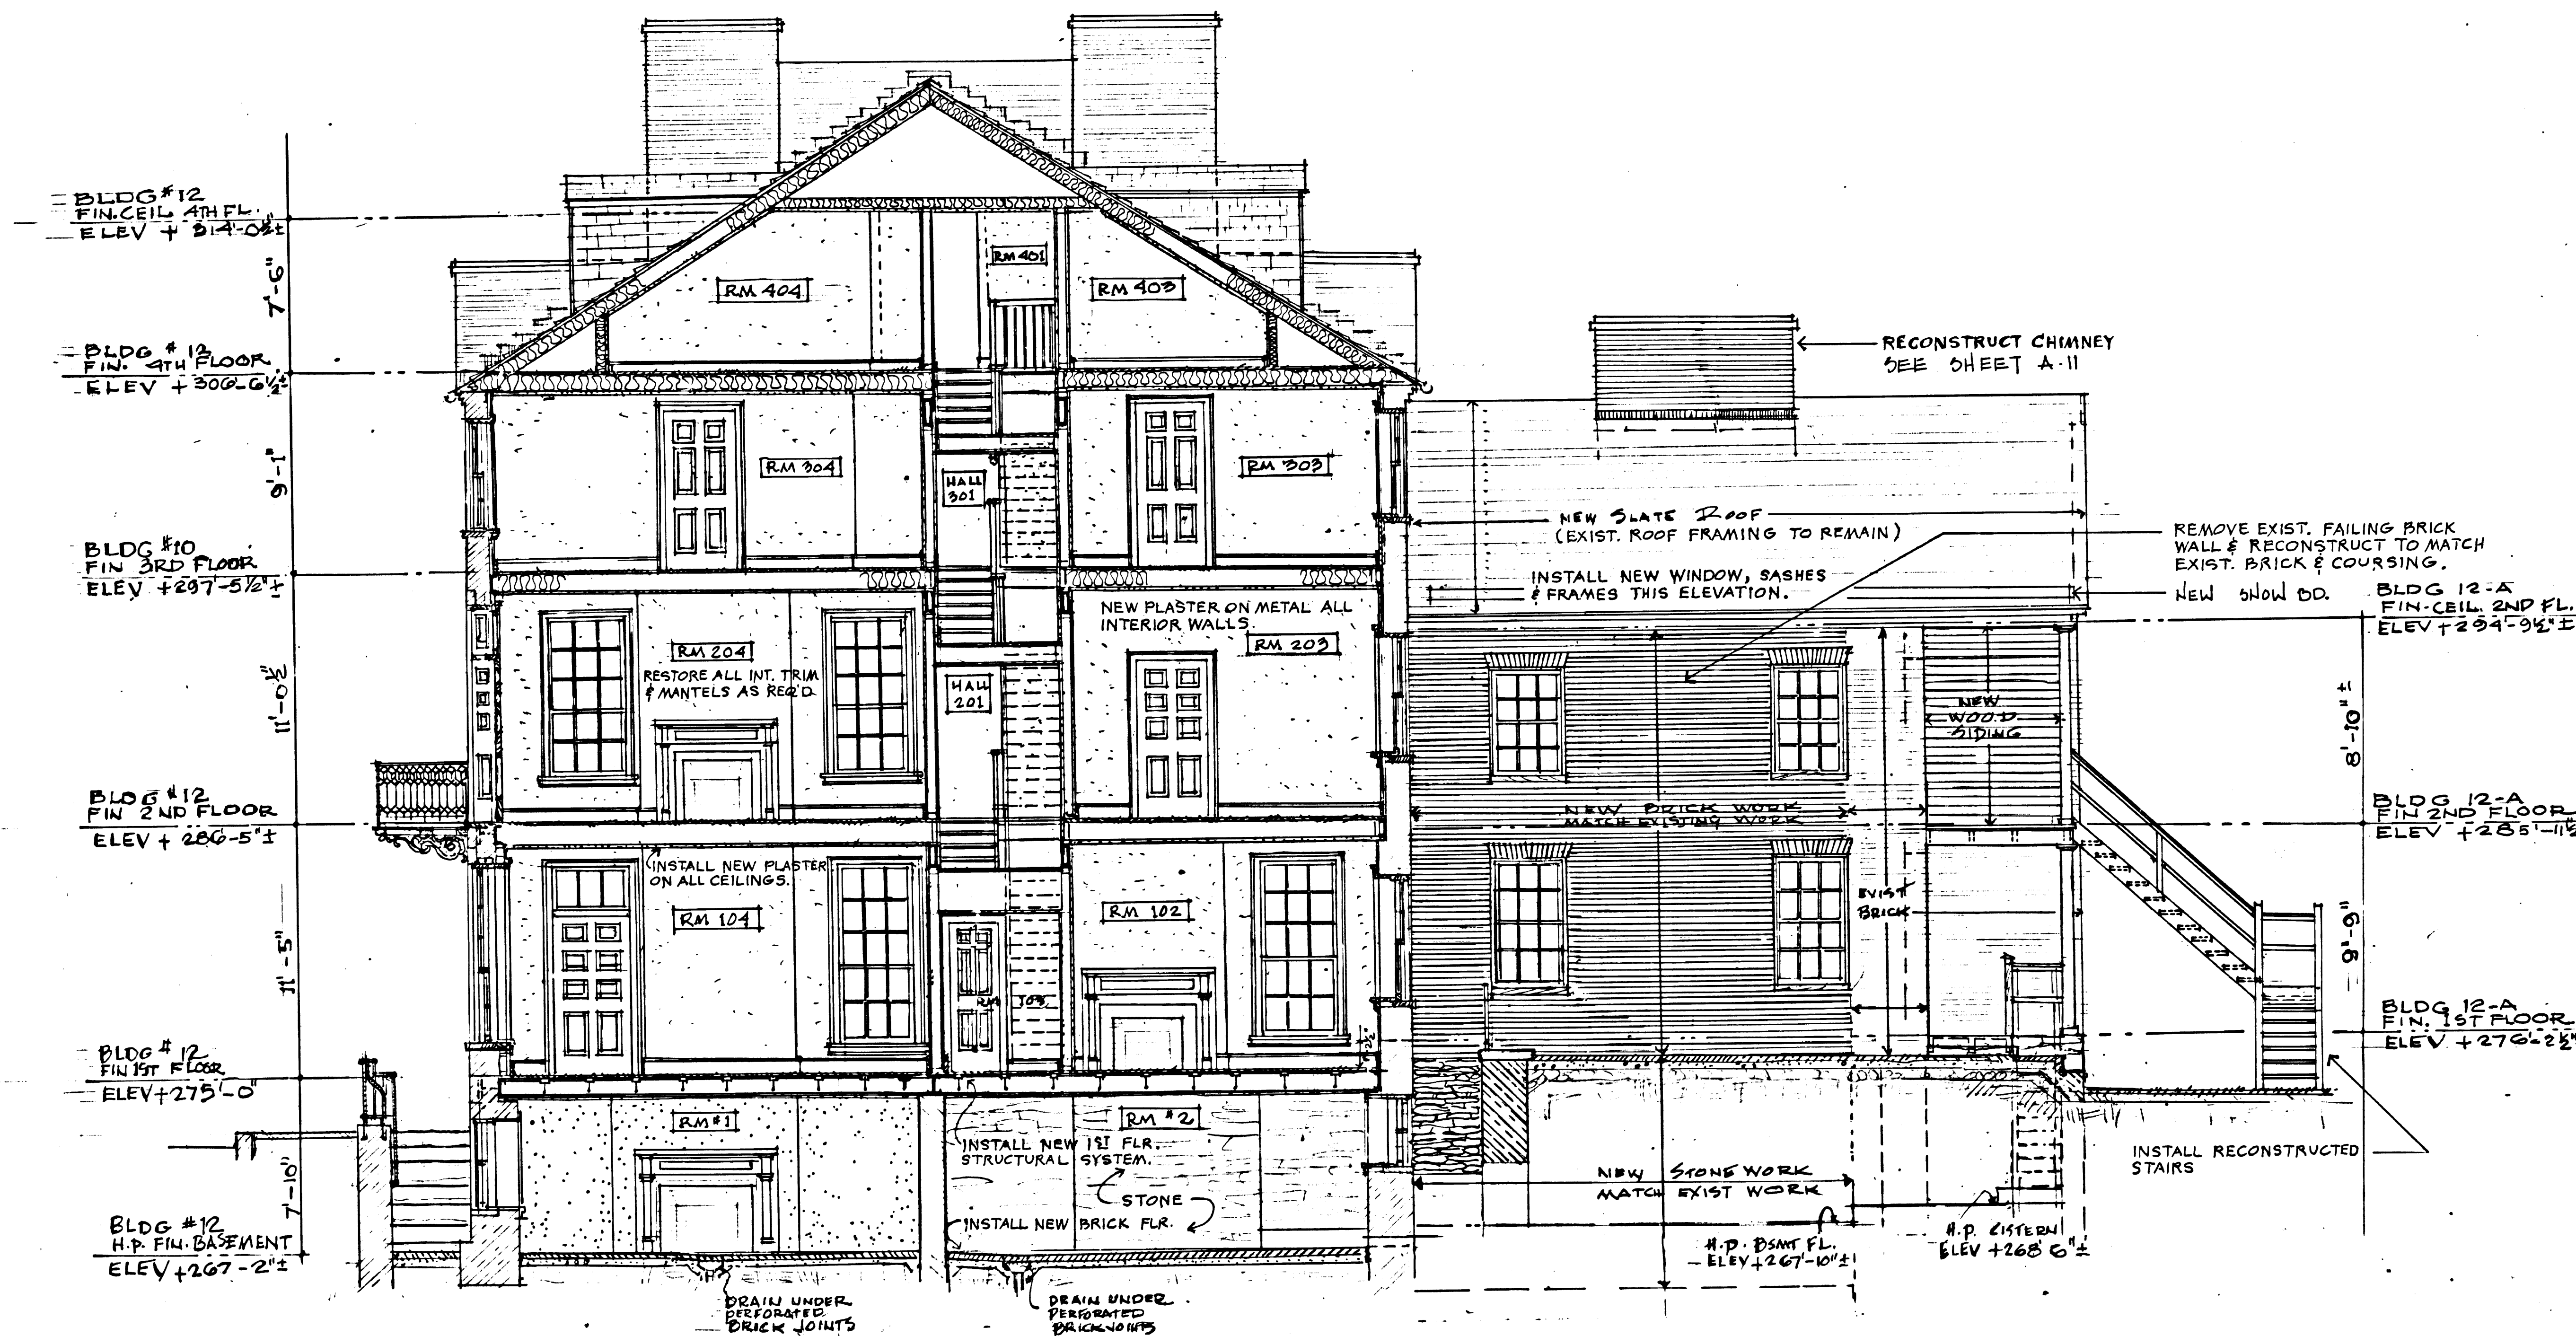


SECTION
SCALE = 1/4" = 1' - 0"

PHASE - II-B
RESTORATION

LONGITUDINAL SECT. BLDG 12 NORTH ELEV BLDG 12-A
SCALE : 1/4" = 1' - 0"

A-10	DRAWING NO. 385
PREPARED R53/WLB	2500GA
DESIGNED GERNER	PKG SHEET
DRAWN BARLOW	10
CHECKED 6/78	OF 65
DATE	


Contractor shall verify all dimensions and take own measurements at the job site before commencing work. Advise of any error in discrepancy.

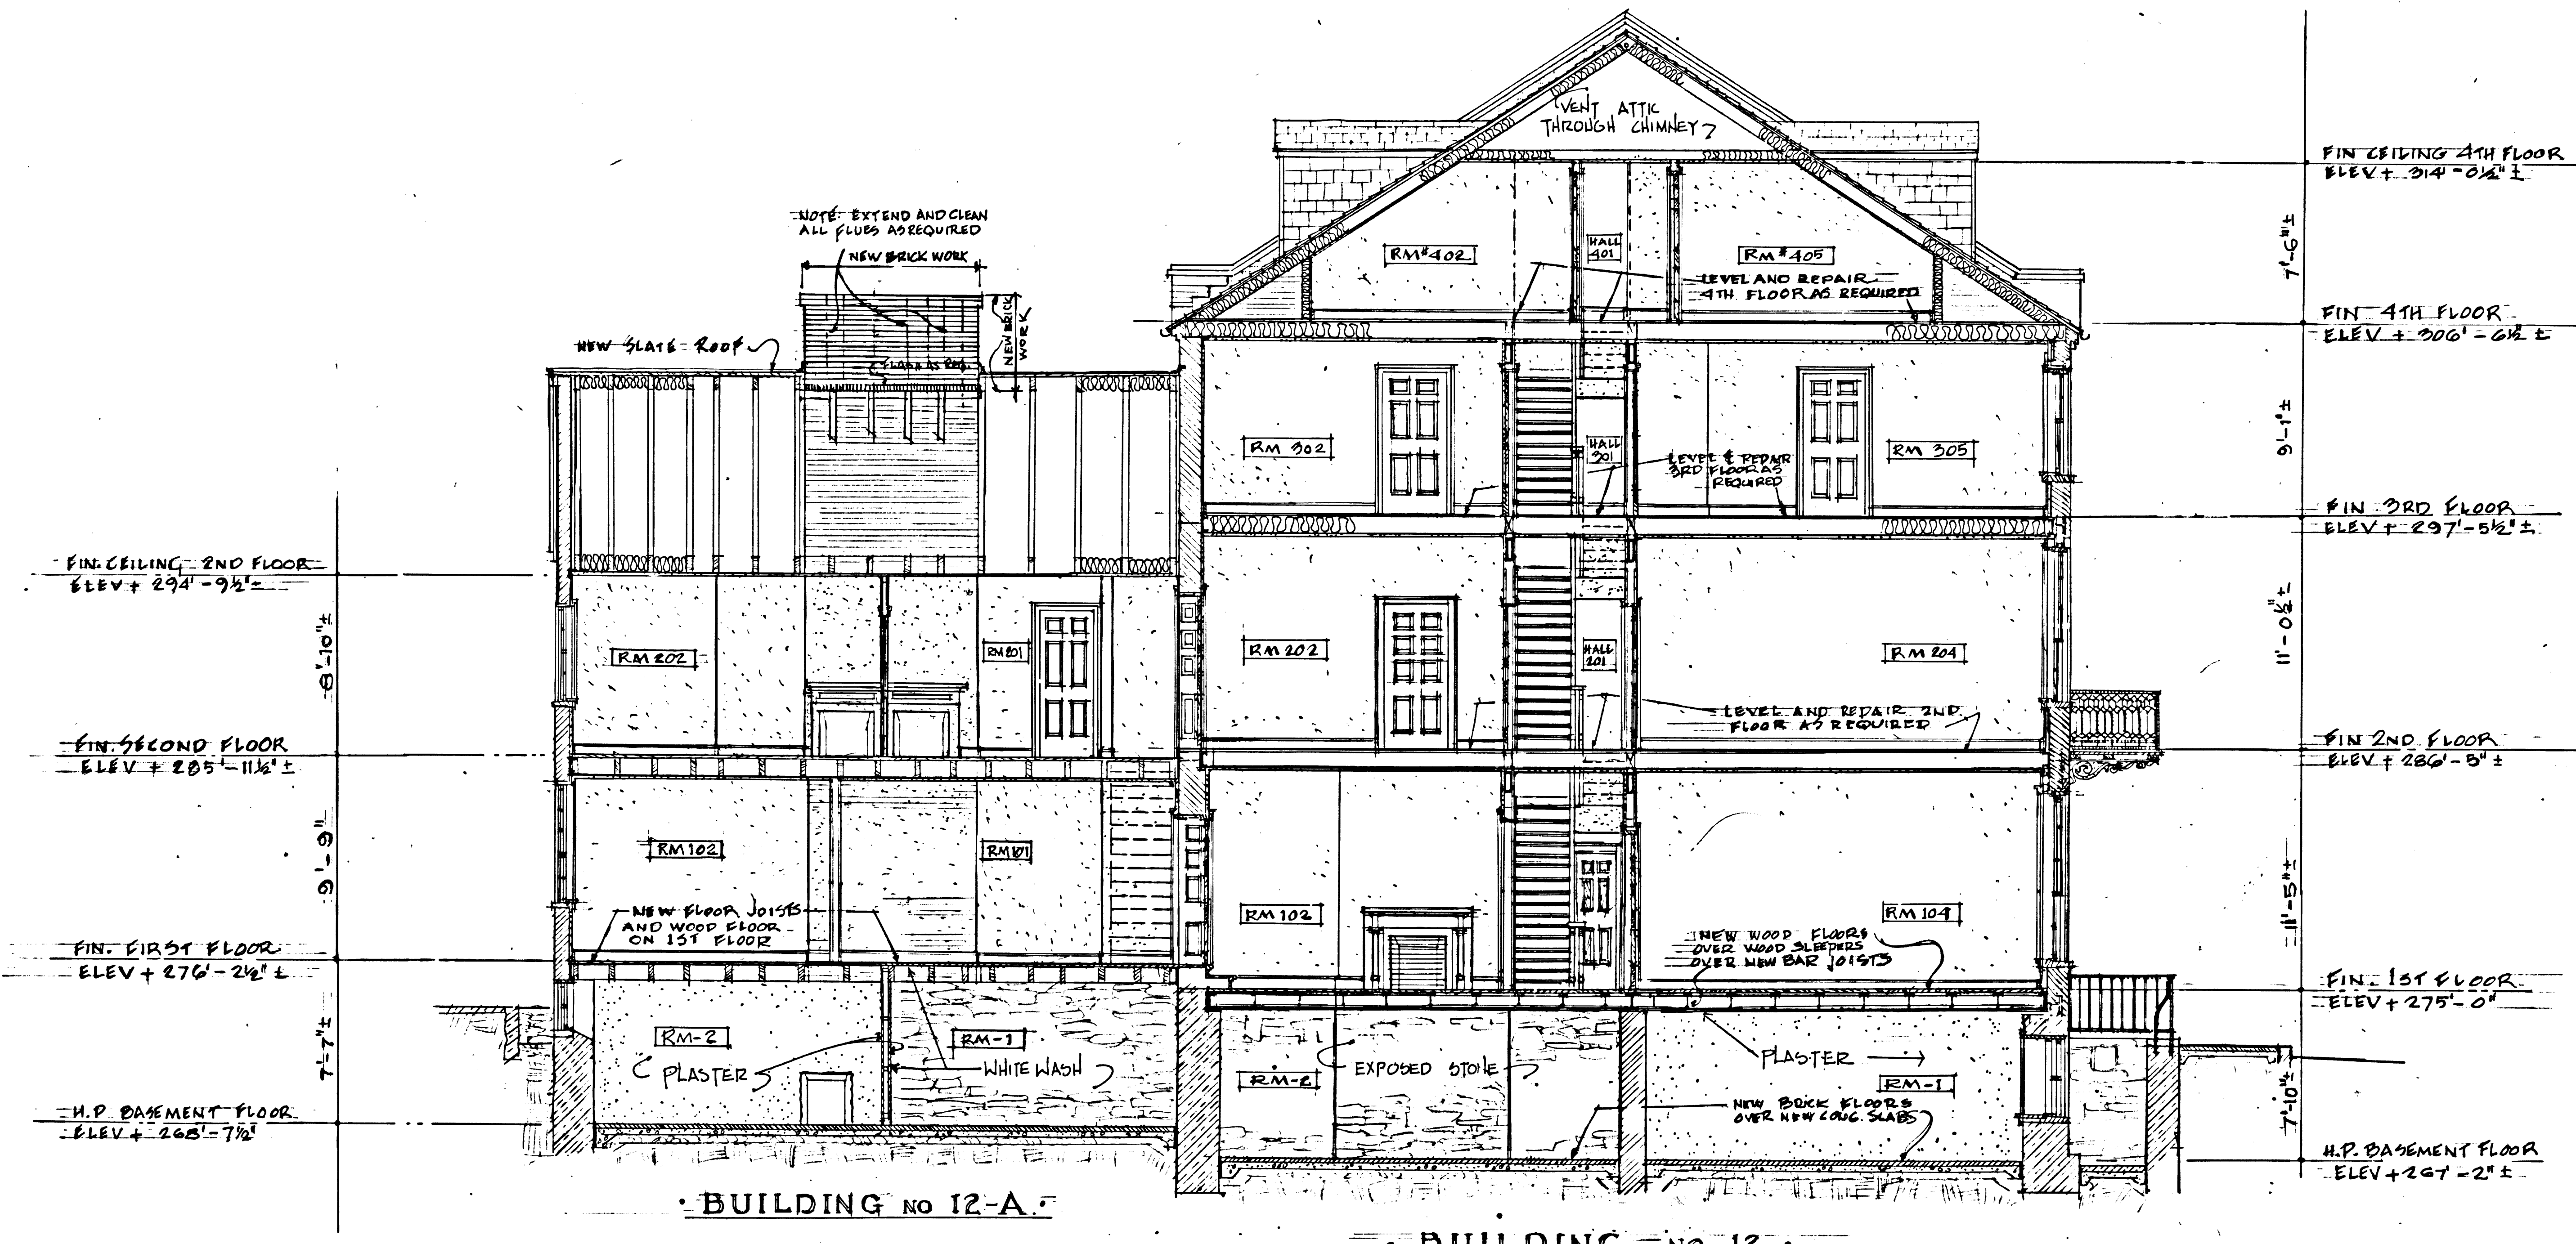

SECTION
SCALE = 1/4" = 1'-0"


PHASE - II-B
RESTORATION

SECTION - BLDG 12 & 12A

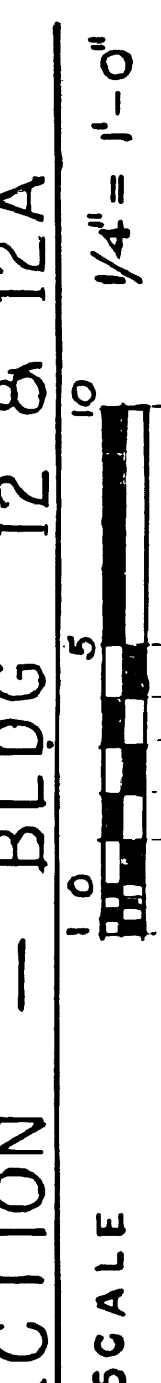


A-II	
PREPARED RSJ/WLB	DRAWING NO. 385
DESIGNED GERNER	25006A
DRAWN BARLOW	PCIP PKG
CHECKED 6/78	SHEET 11
DATE	OF 65

Contractor shall verify all dimensions and take own measurements at the job site before commencing work. Adjust all dimensions as indicated.

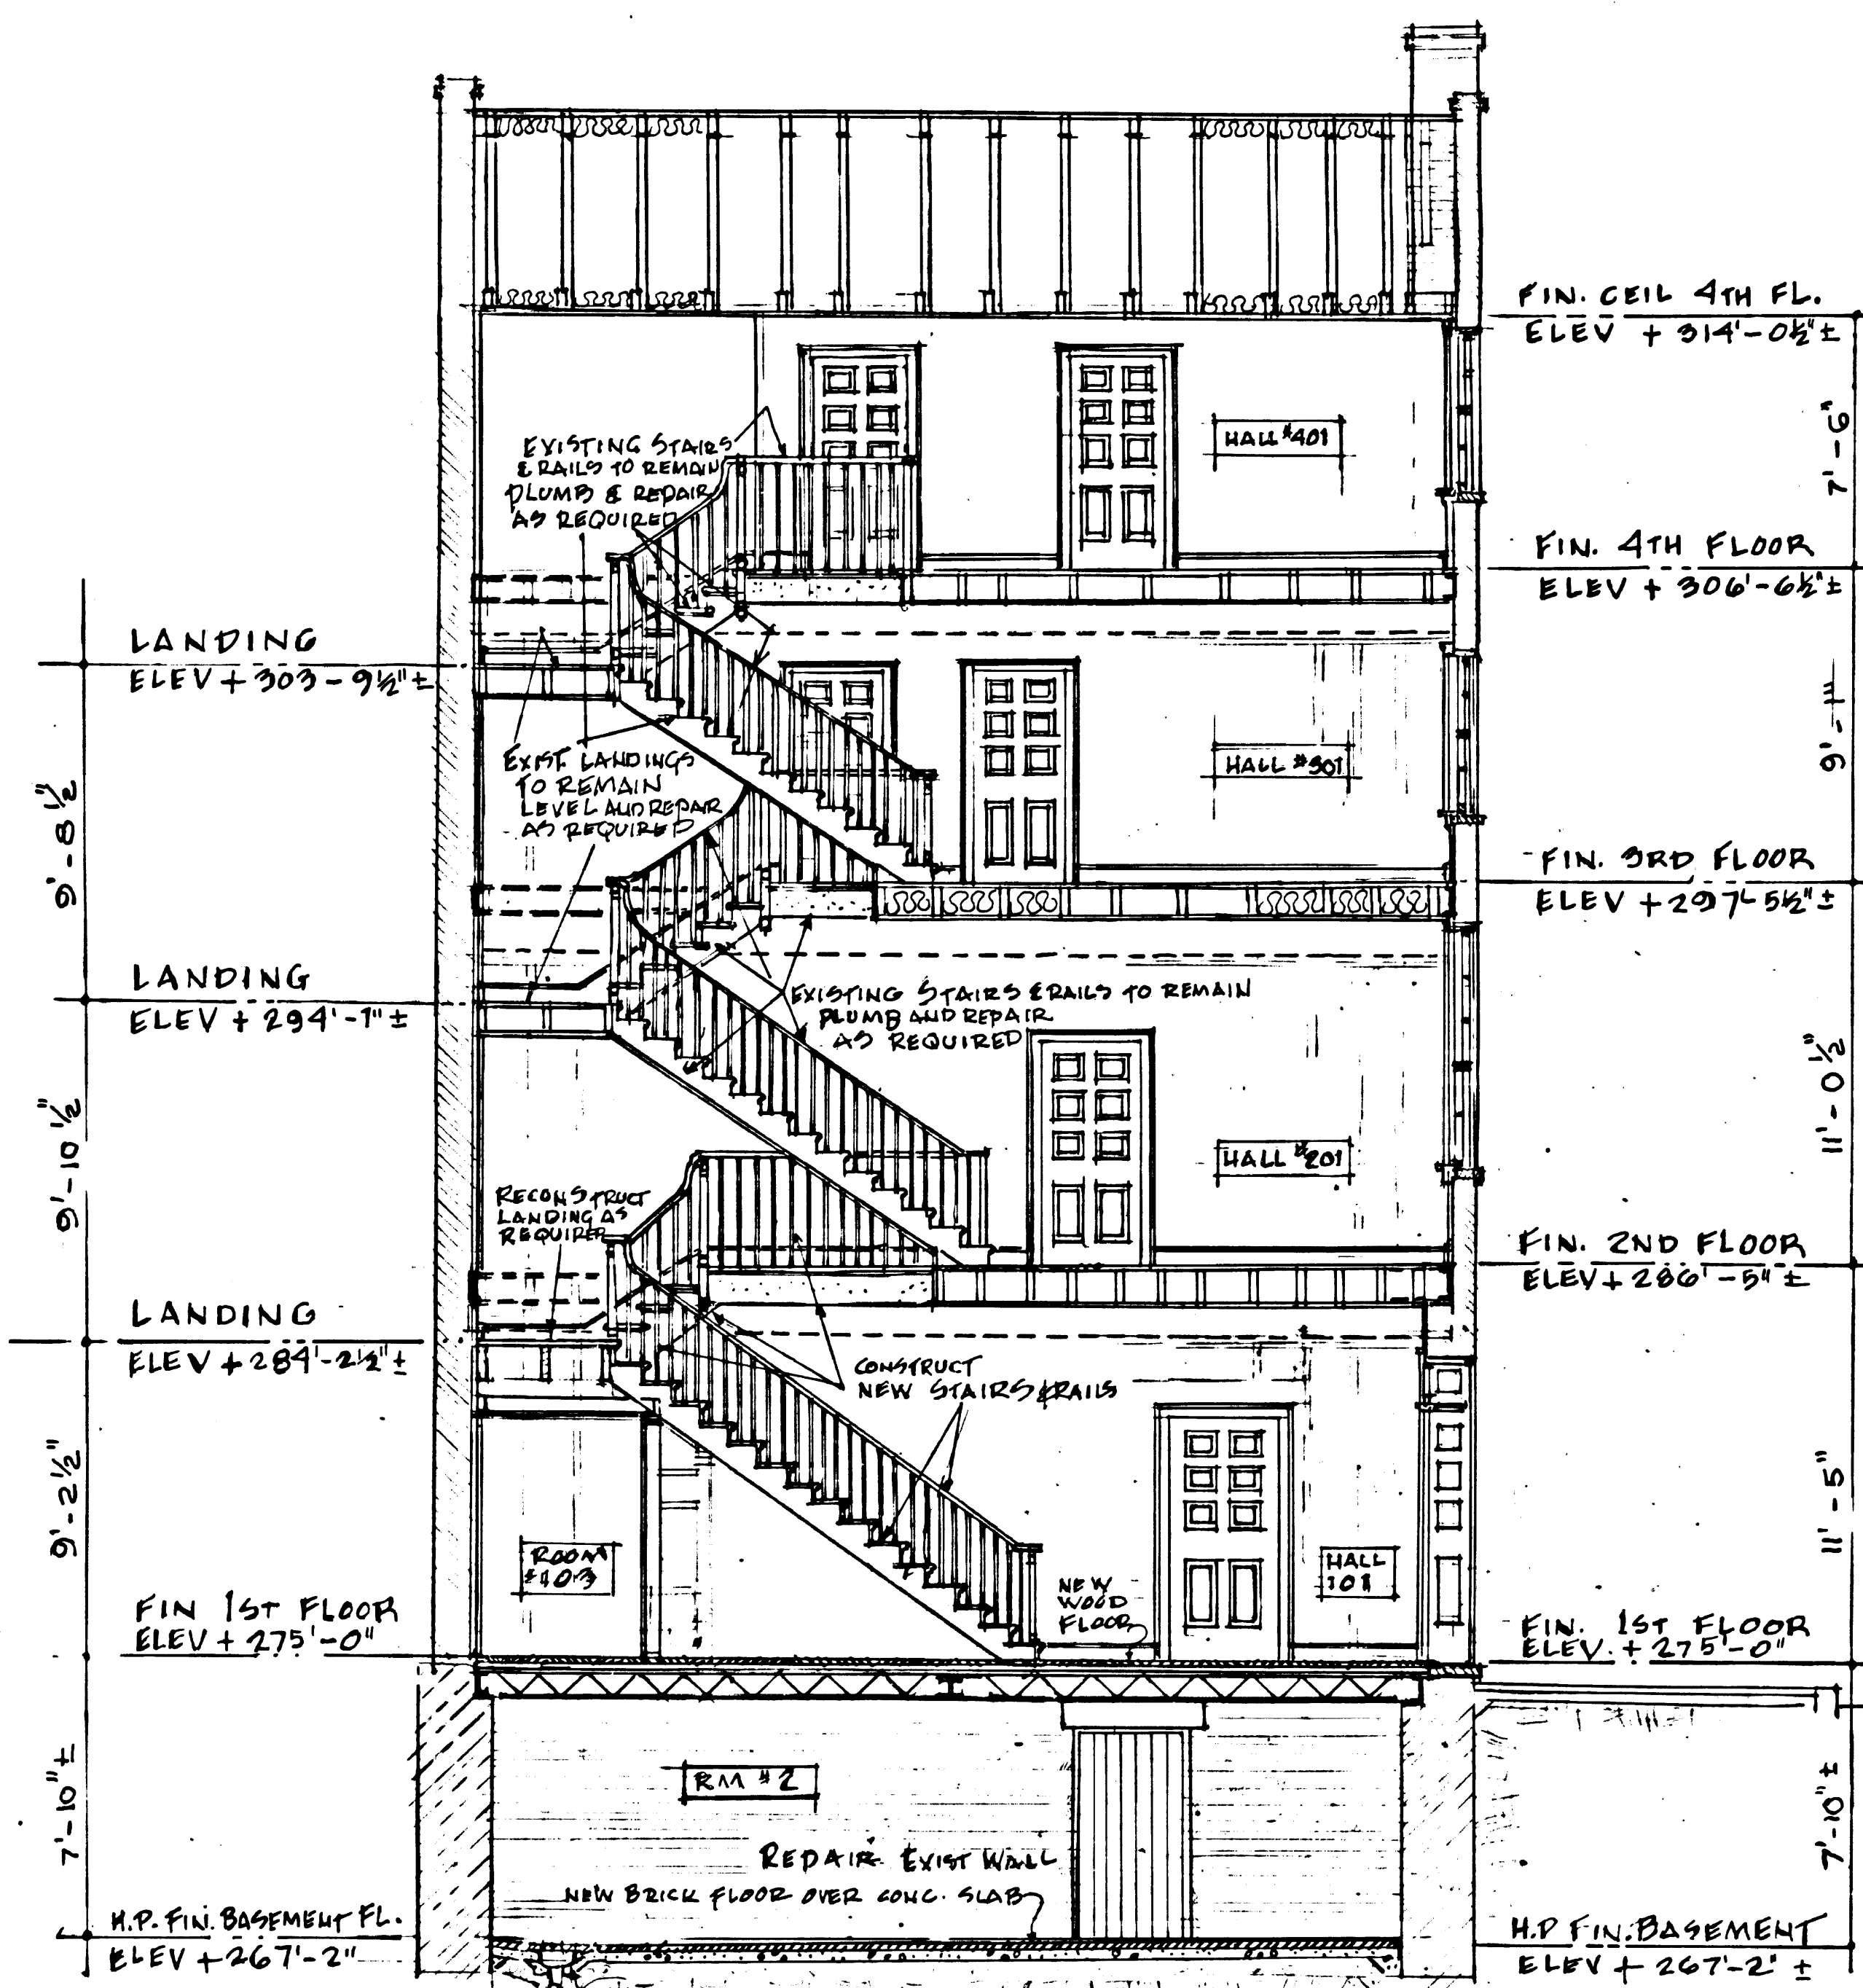

SECTION 1
BLDG #12

SCALE 1/4" = 1'-0"

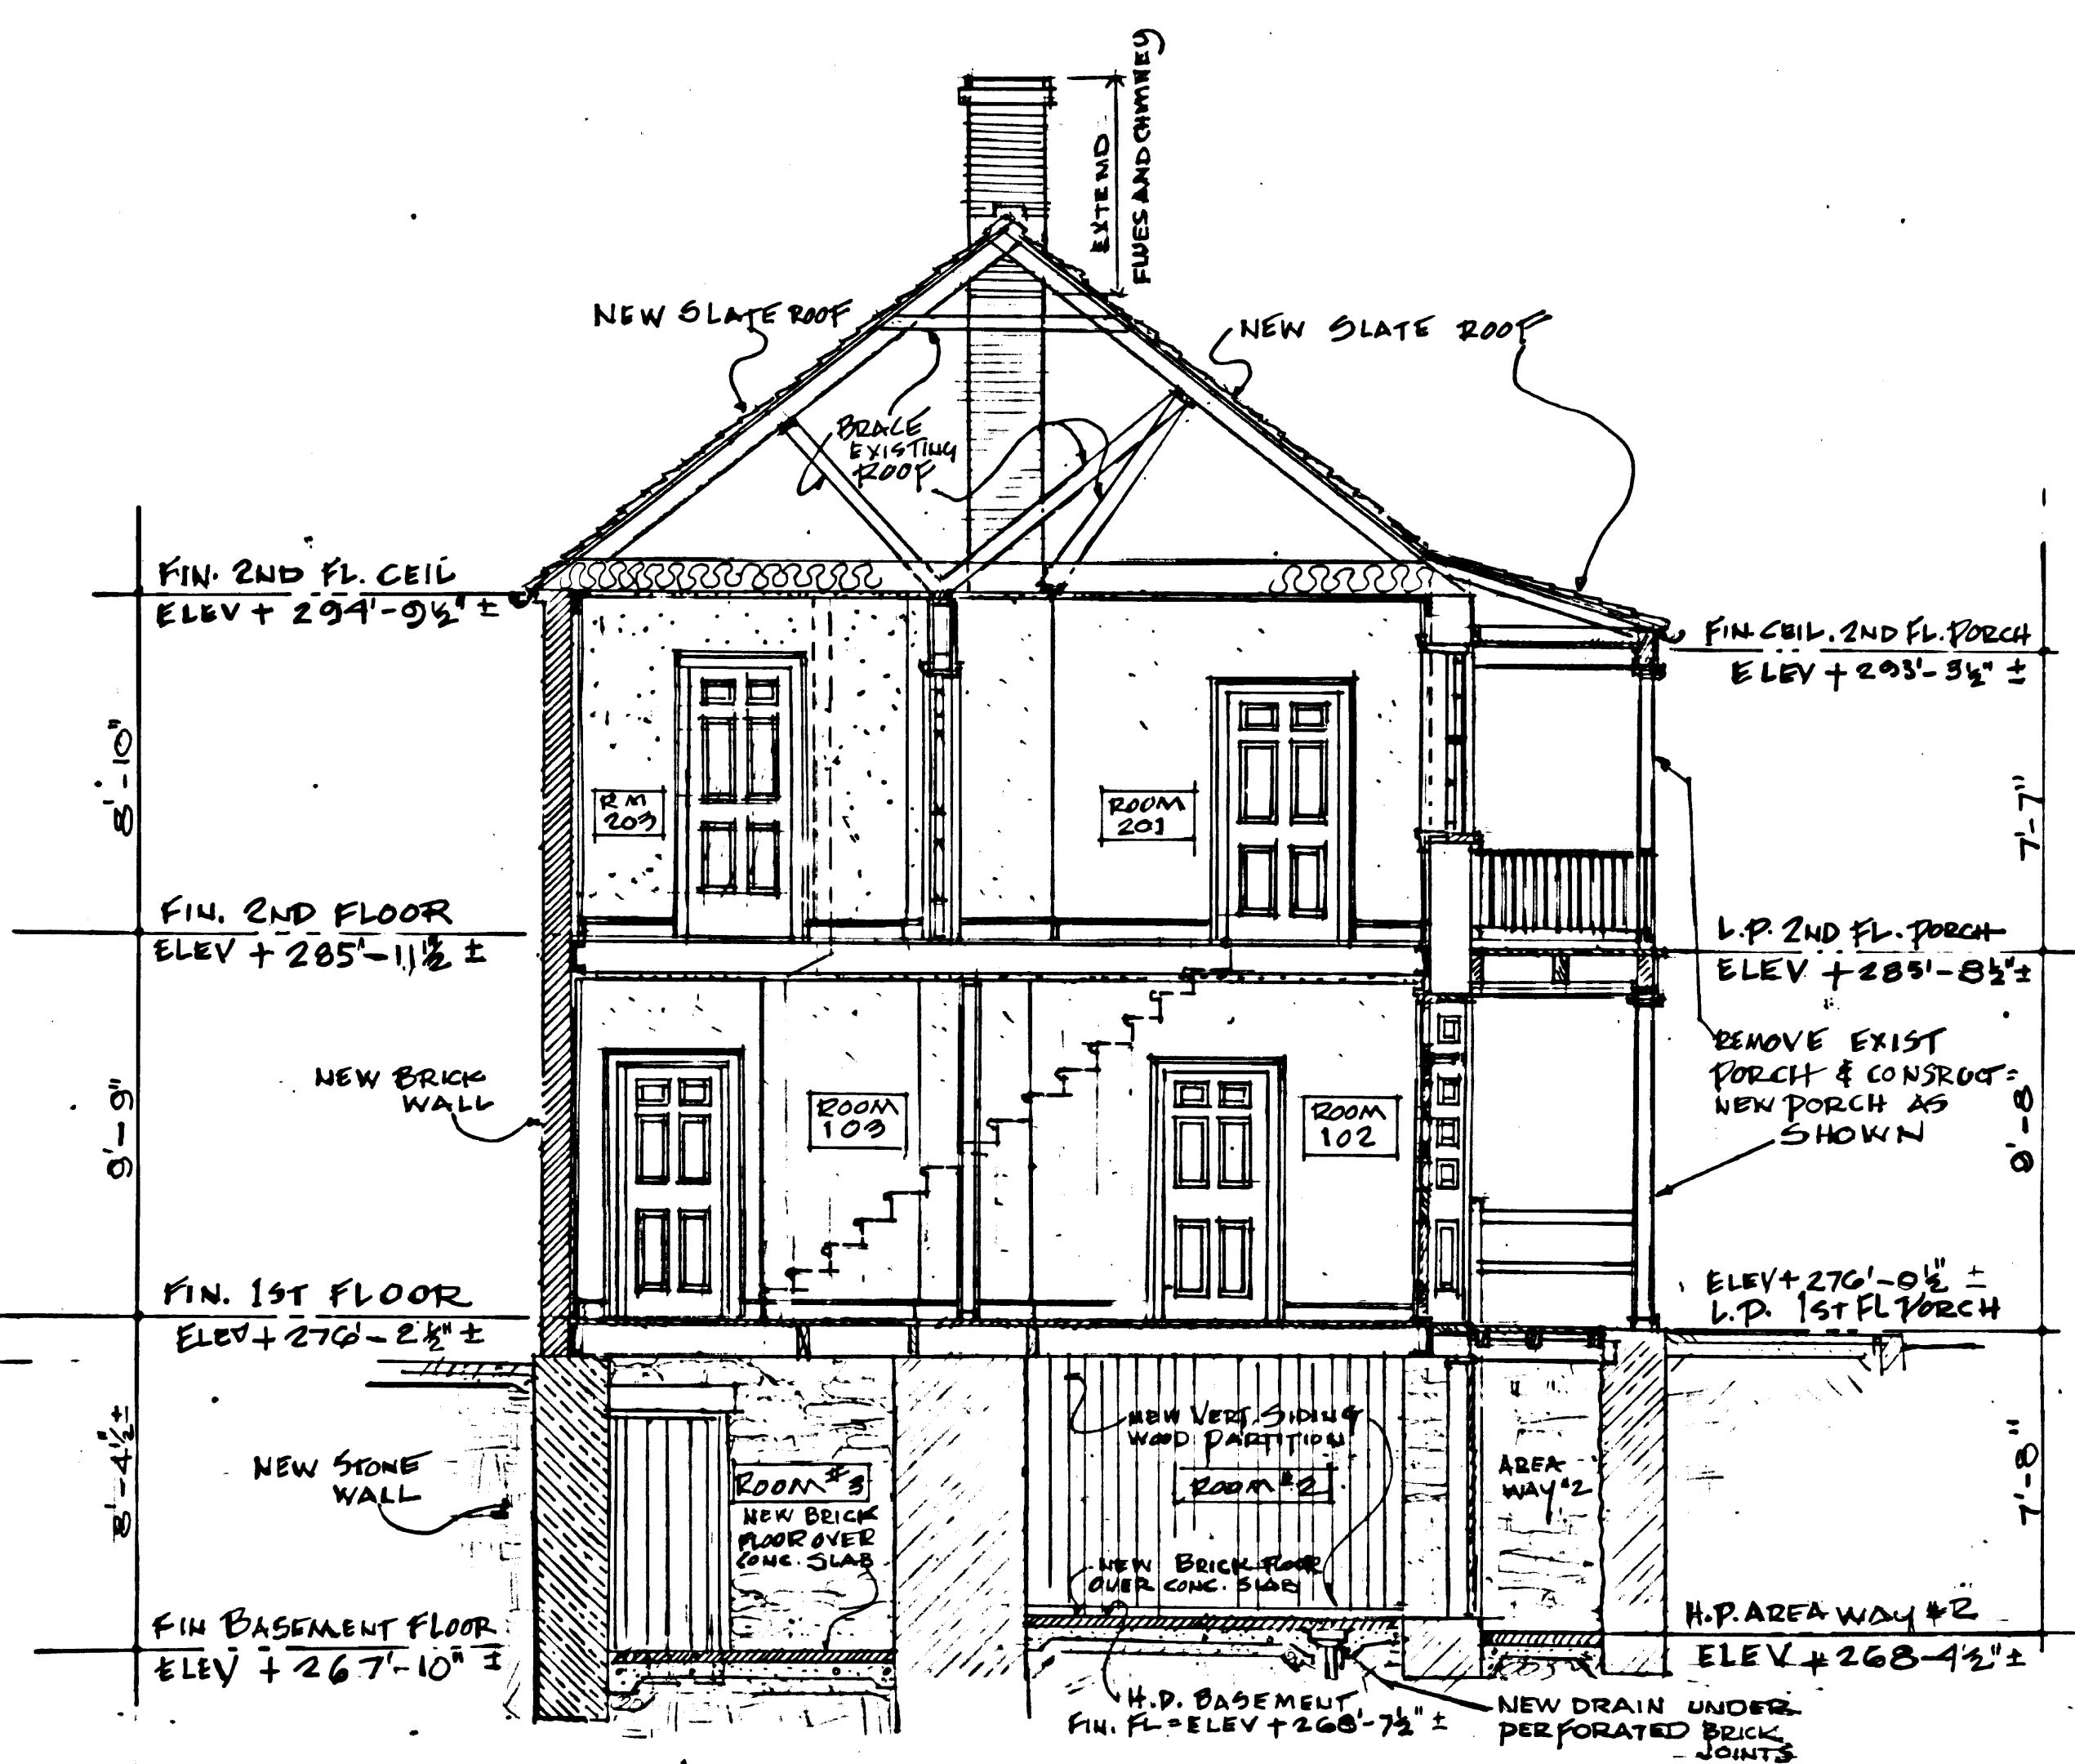

SECTION 2
BLDG 12-A




PHASE - II-B
RESTORATION

SECTIONS - BUILDINGS 12 & 12A

SCALE 1/4" = 1'-0"

A-12		DRAWING NO. 385	
PREPARED RSJ/WLB	DESIGNED GERNER	PKG	SHEET
DRAWN BARLOW	CHECKED 6/78	110	12
DATE			OF 63

Contractor shall verify all dimensions and take own measurements at the job site before commencing work. Advise of any error in writing.

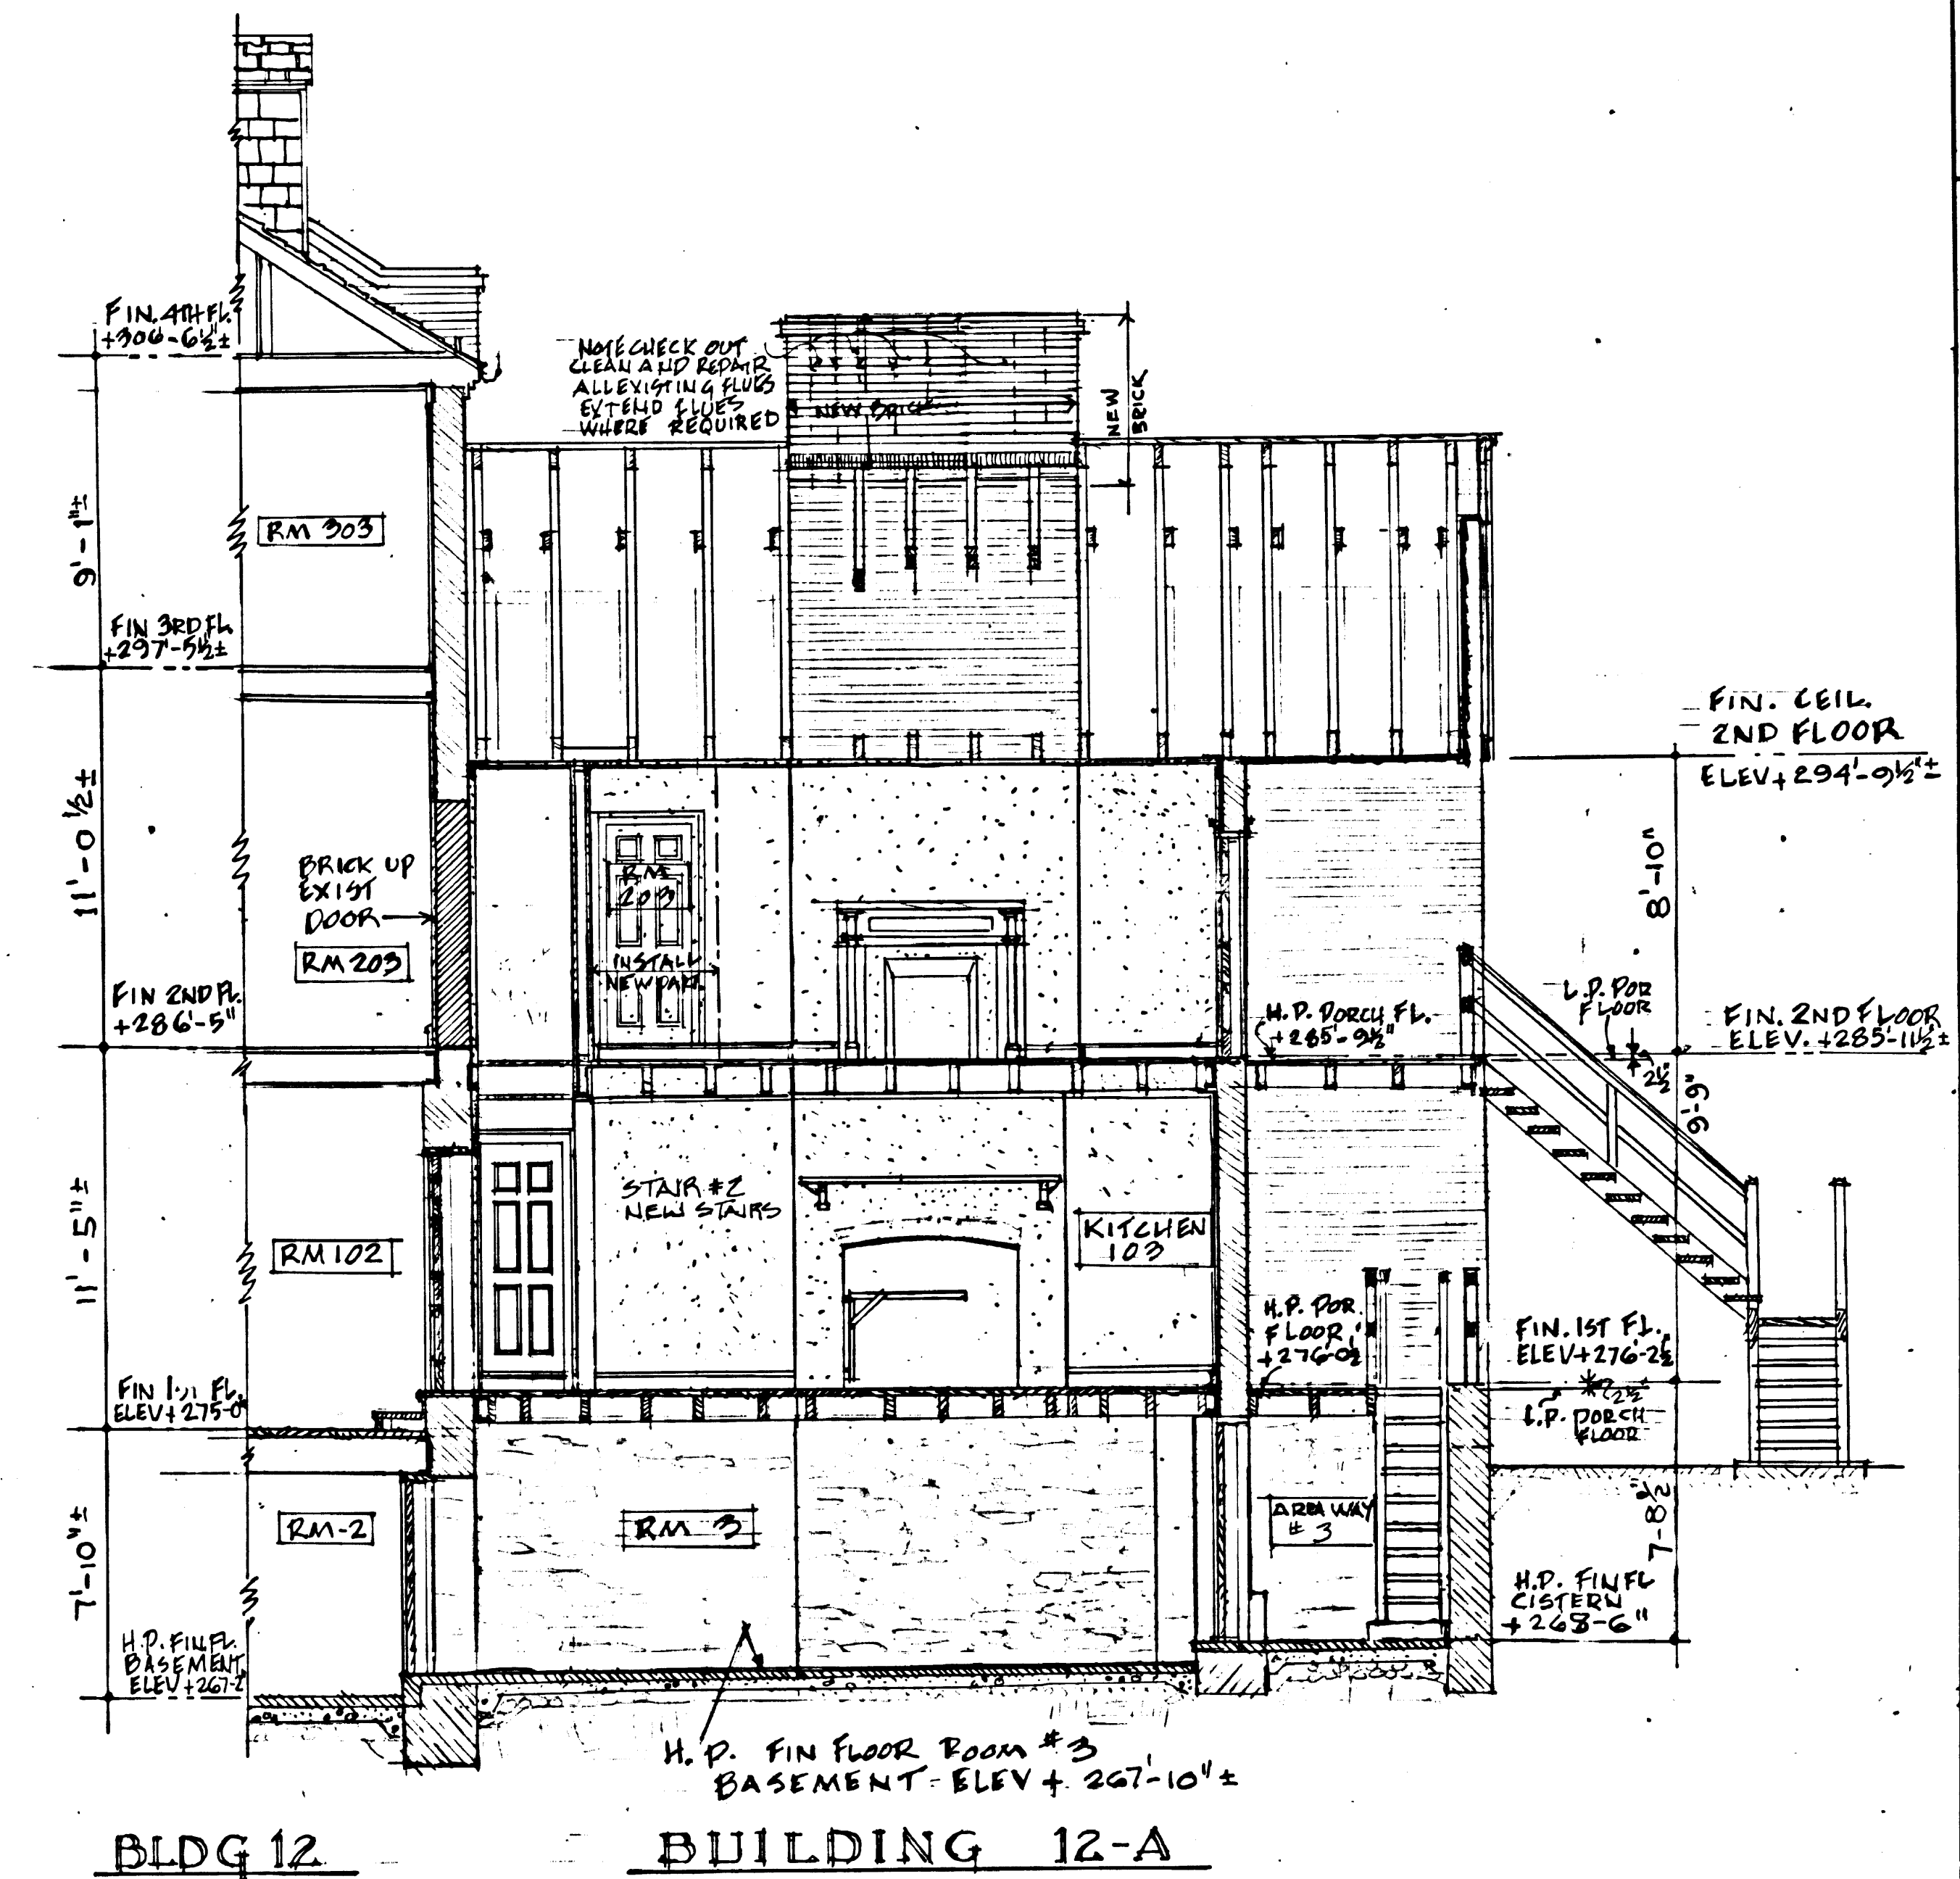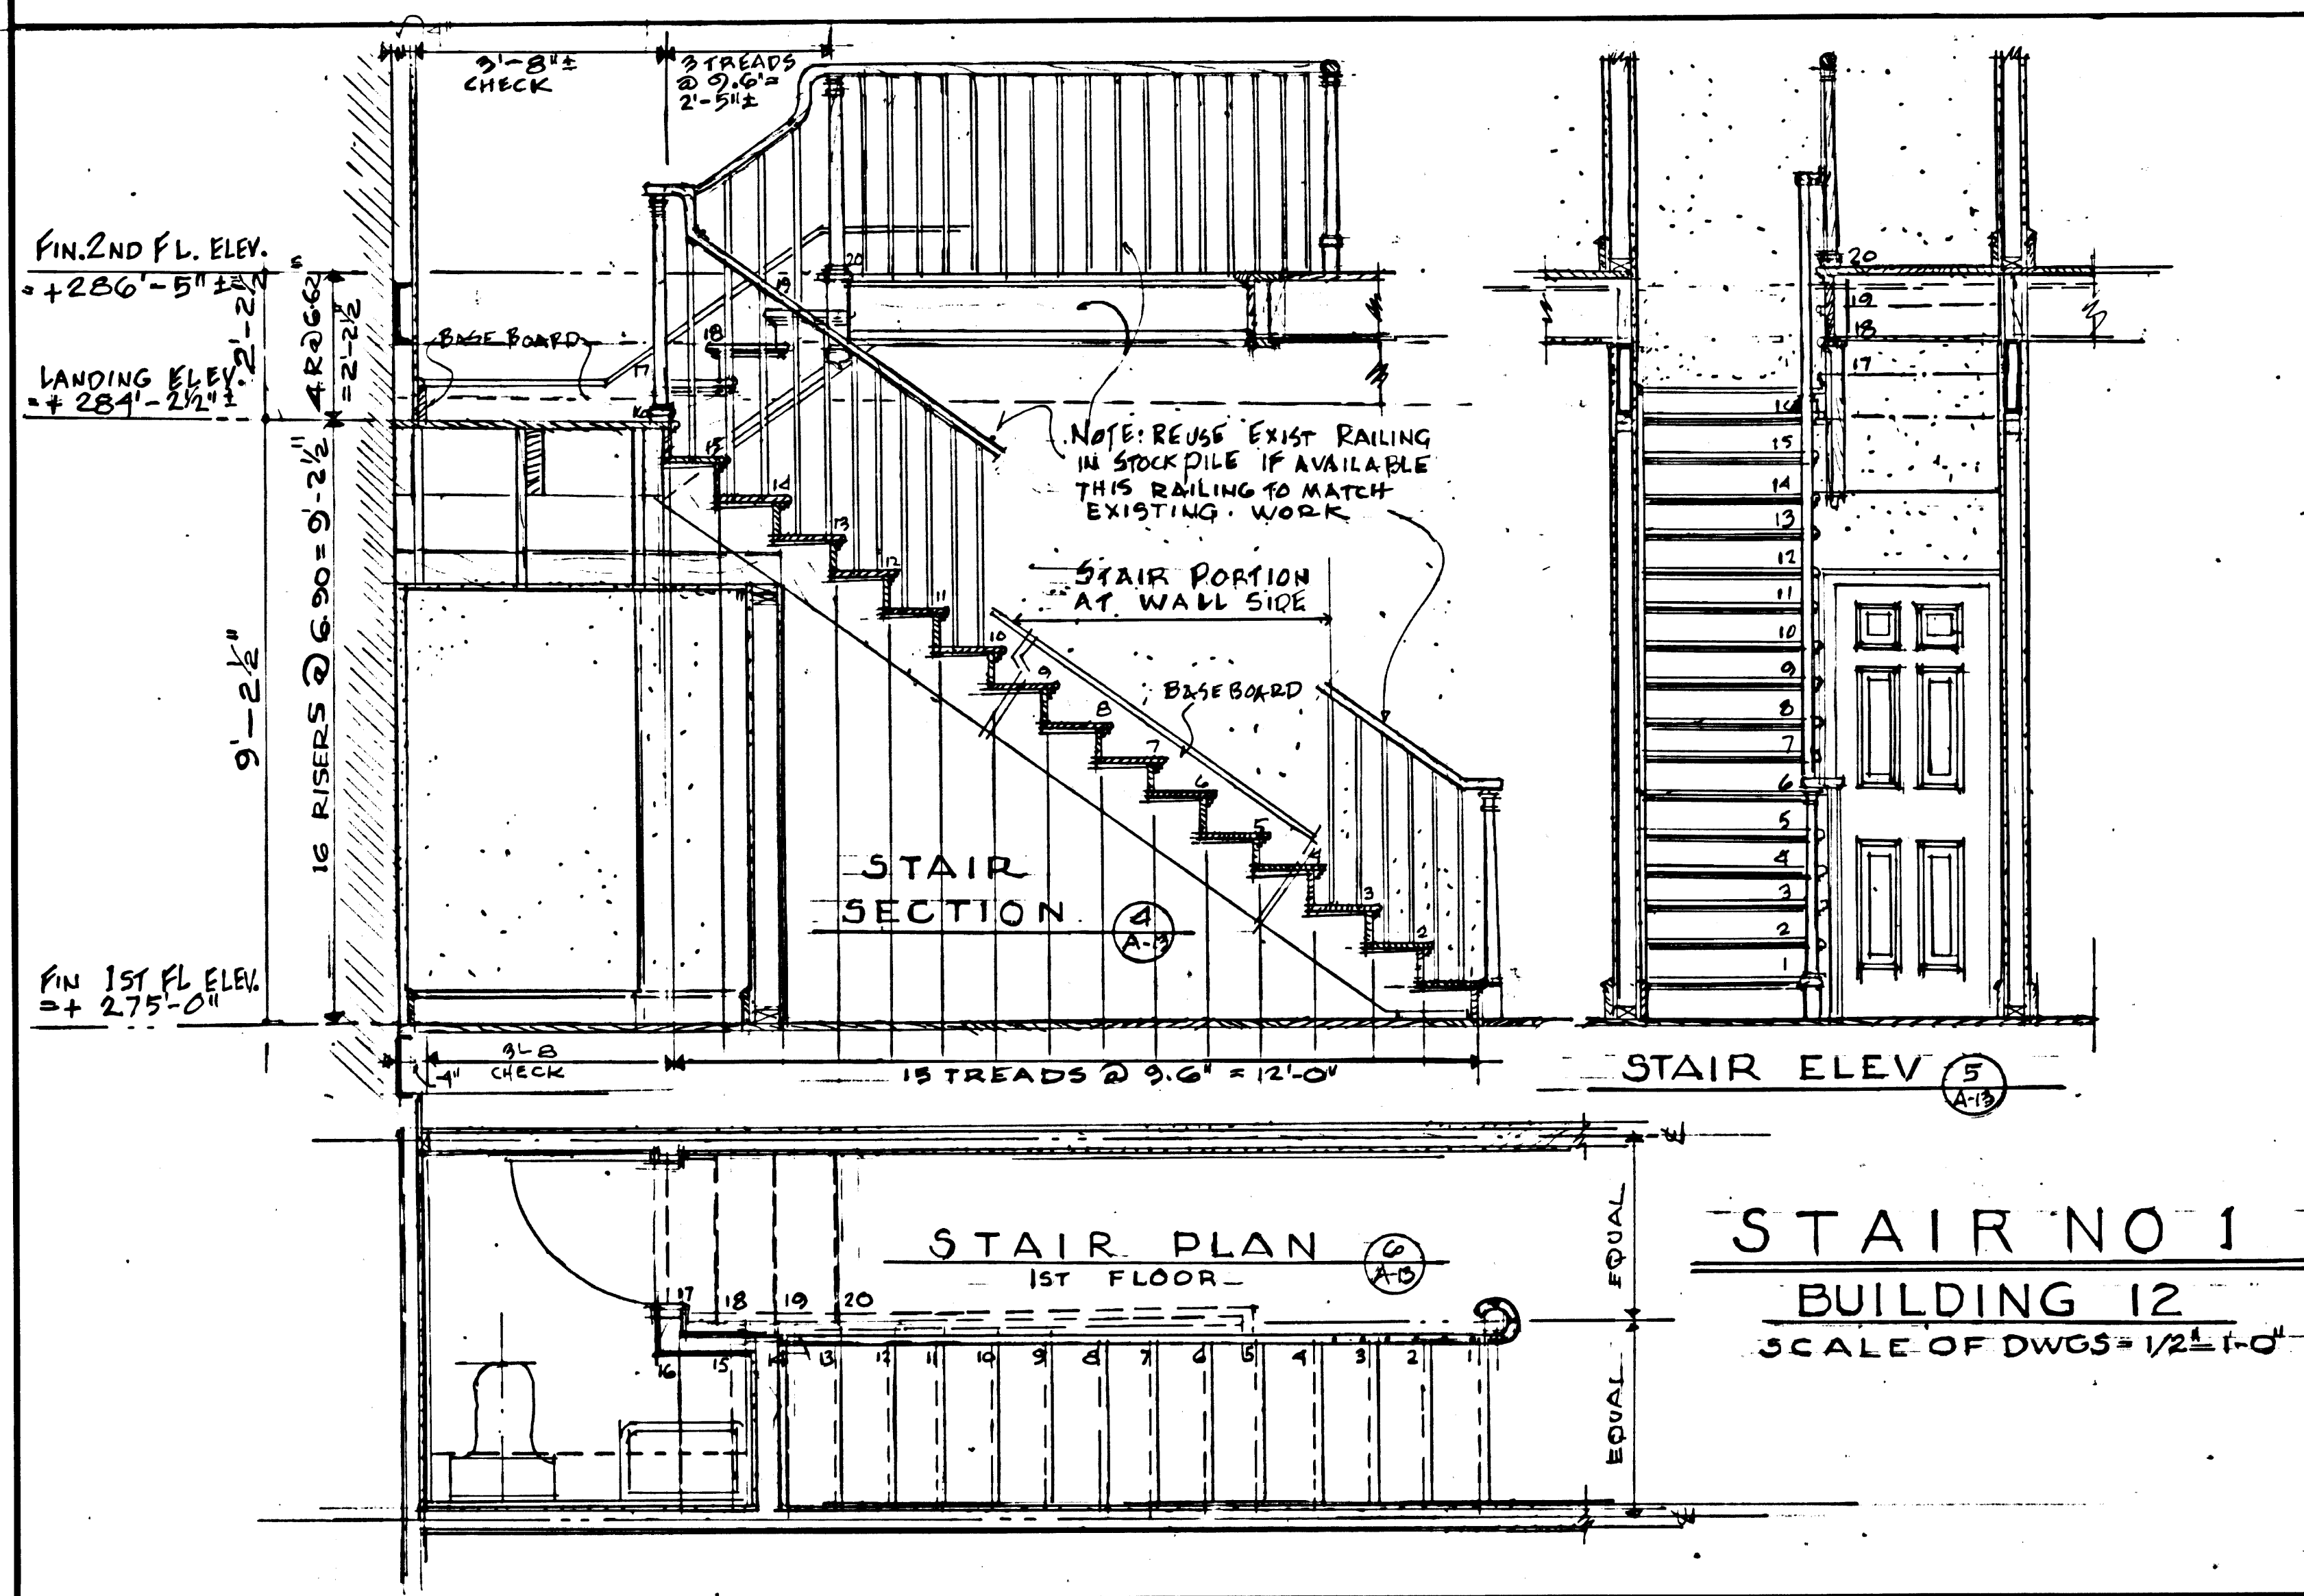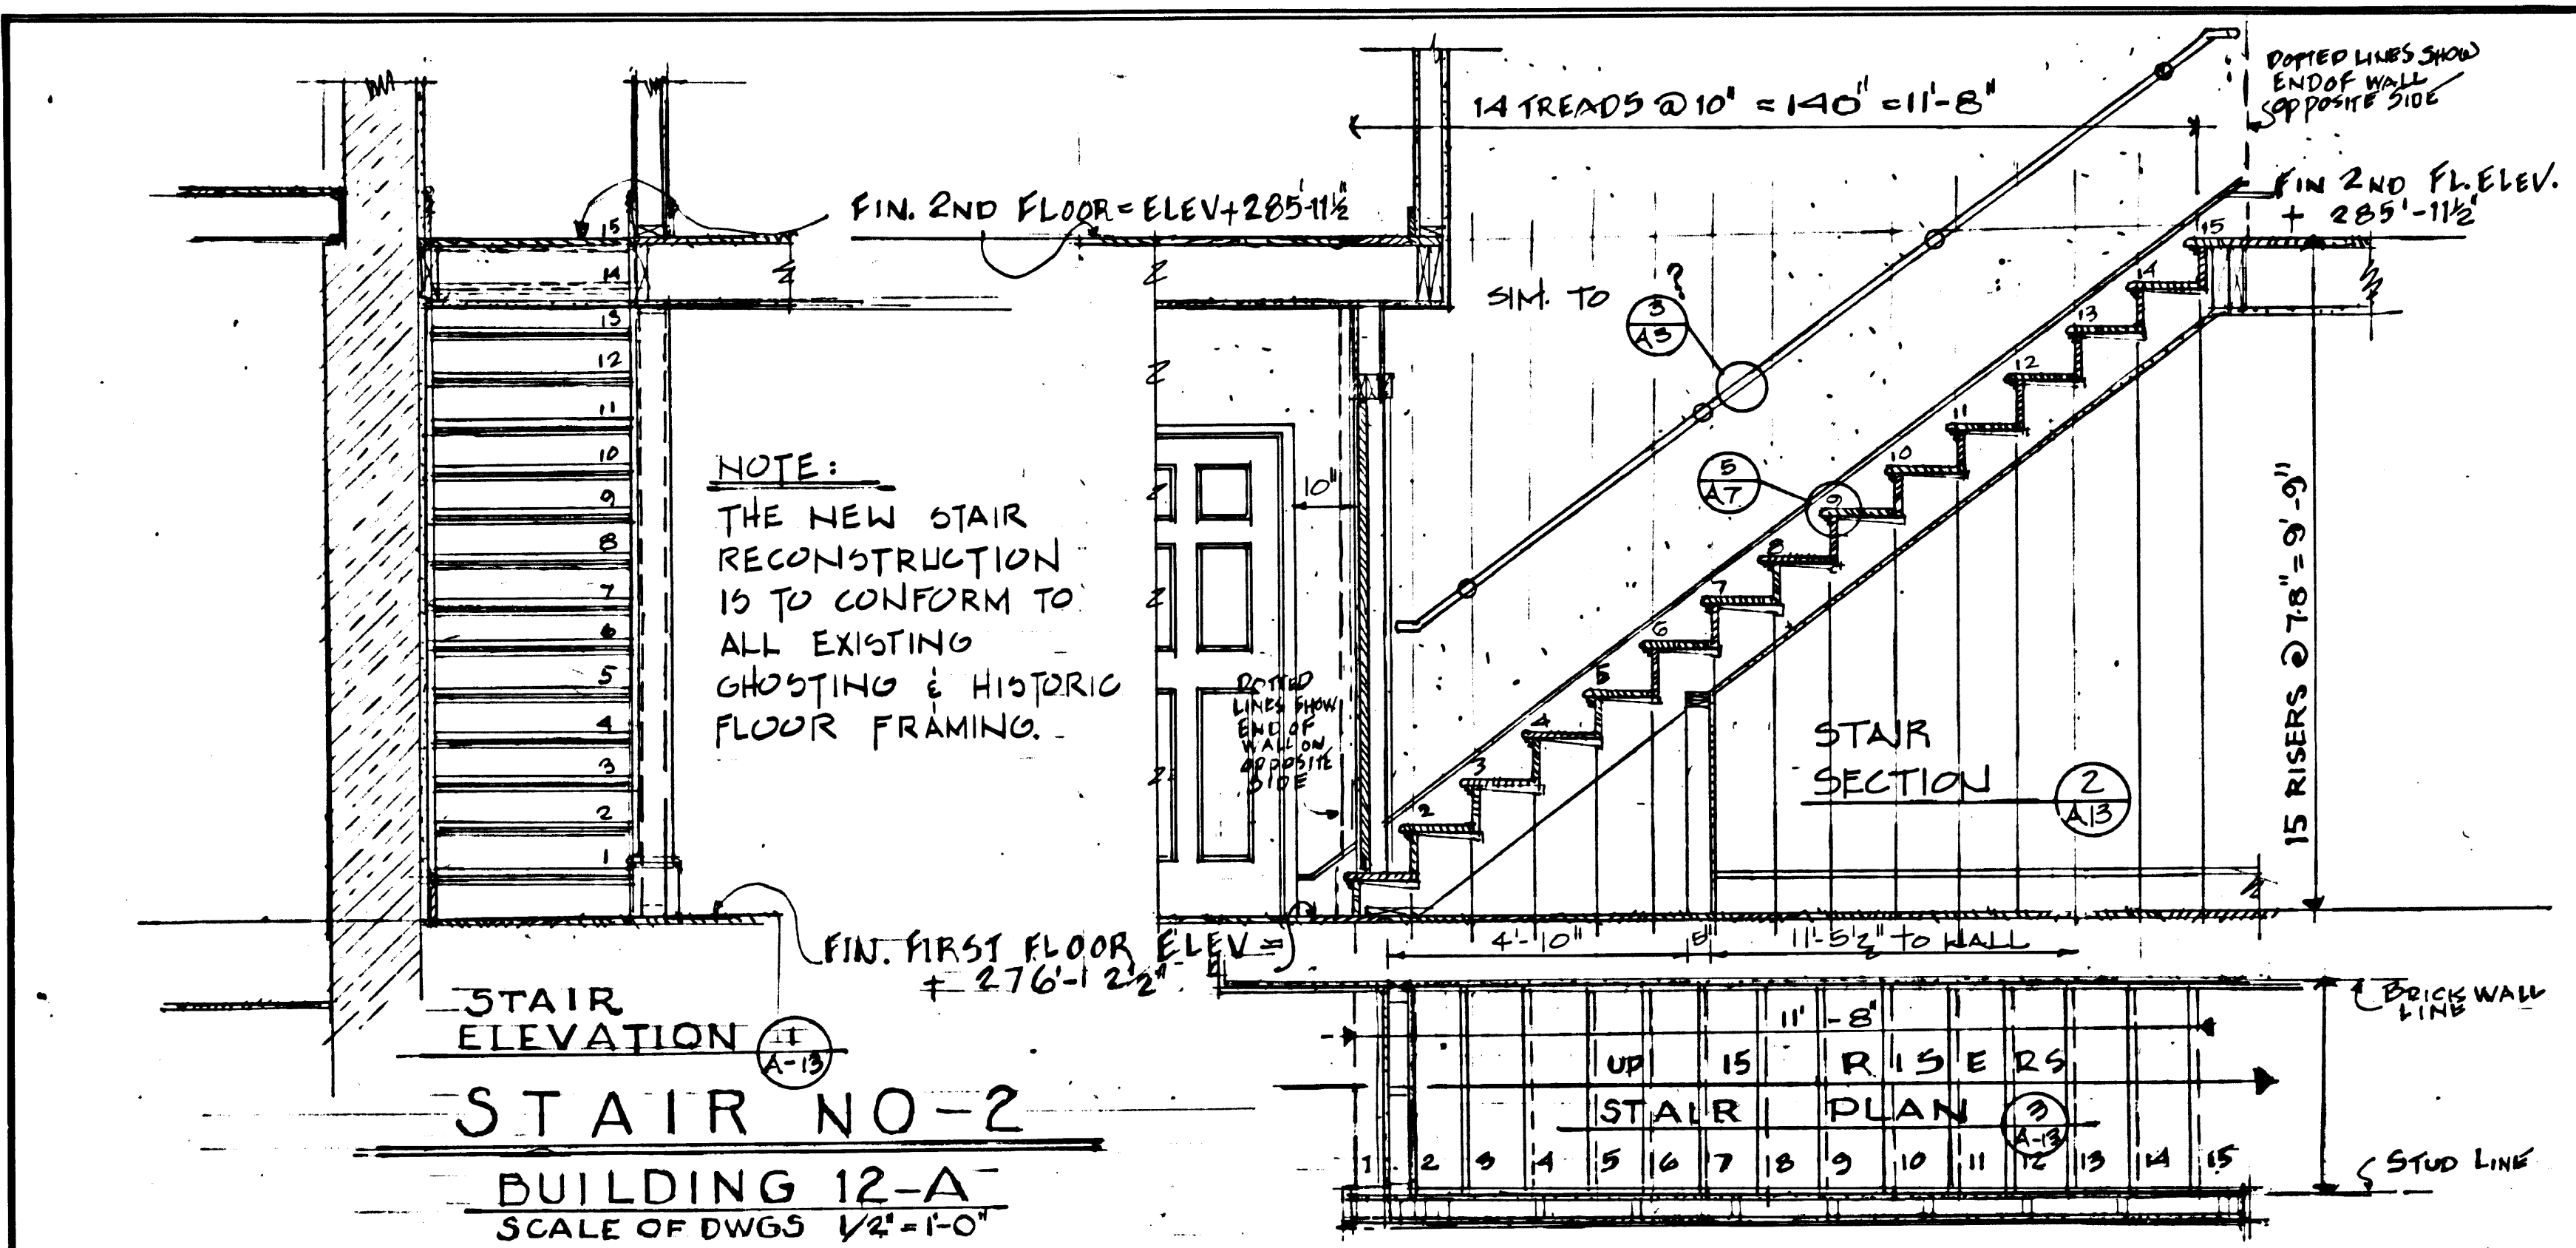


SECTION
 SCALE 1/4" = 1'-0"

Contractor shall verify all dimensions and take own measurements at the job site before commencing work. Advise of any discrepancies.

PHASE - II-B
 RESTORATION

SECTION BLDG 12-A INTERIOR STAIRS BLDG 12 & 12A
 SCALE : AS NOTED

A-13		DRAWING NO.	385
PREPARED	RSU/WLB	DESIGNED	GERNER
DRAWN	BARLOW	CHECKED	6/78
DATE			
PKG.	110	SHEET	13
		OF 65	

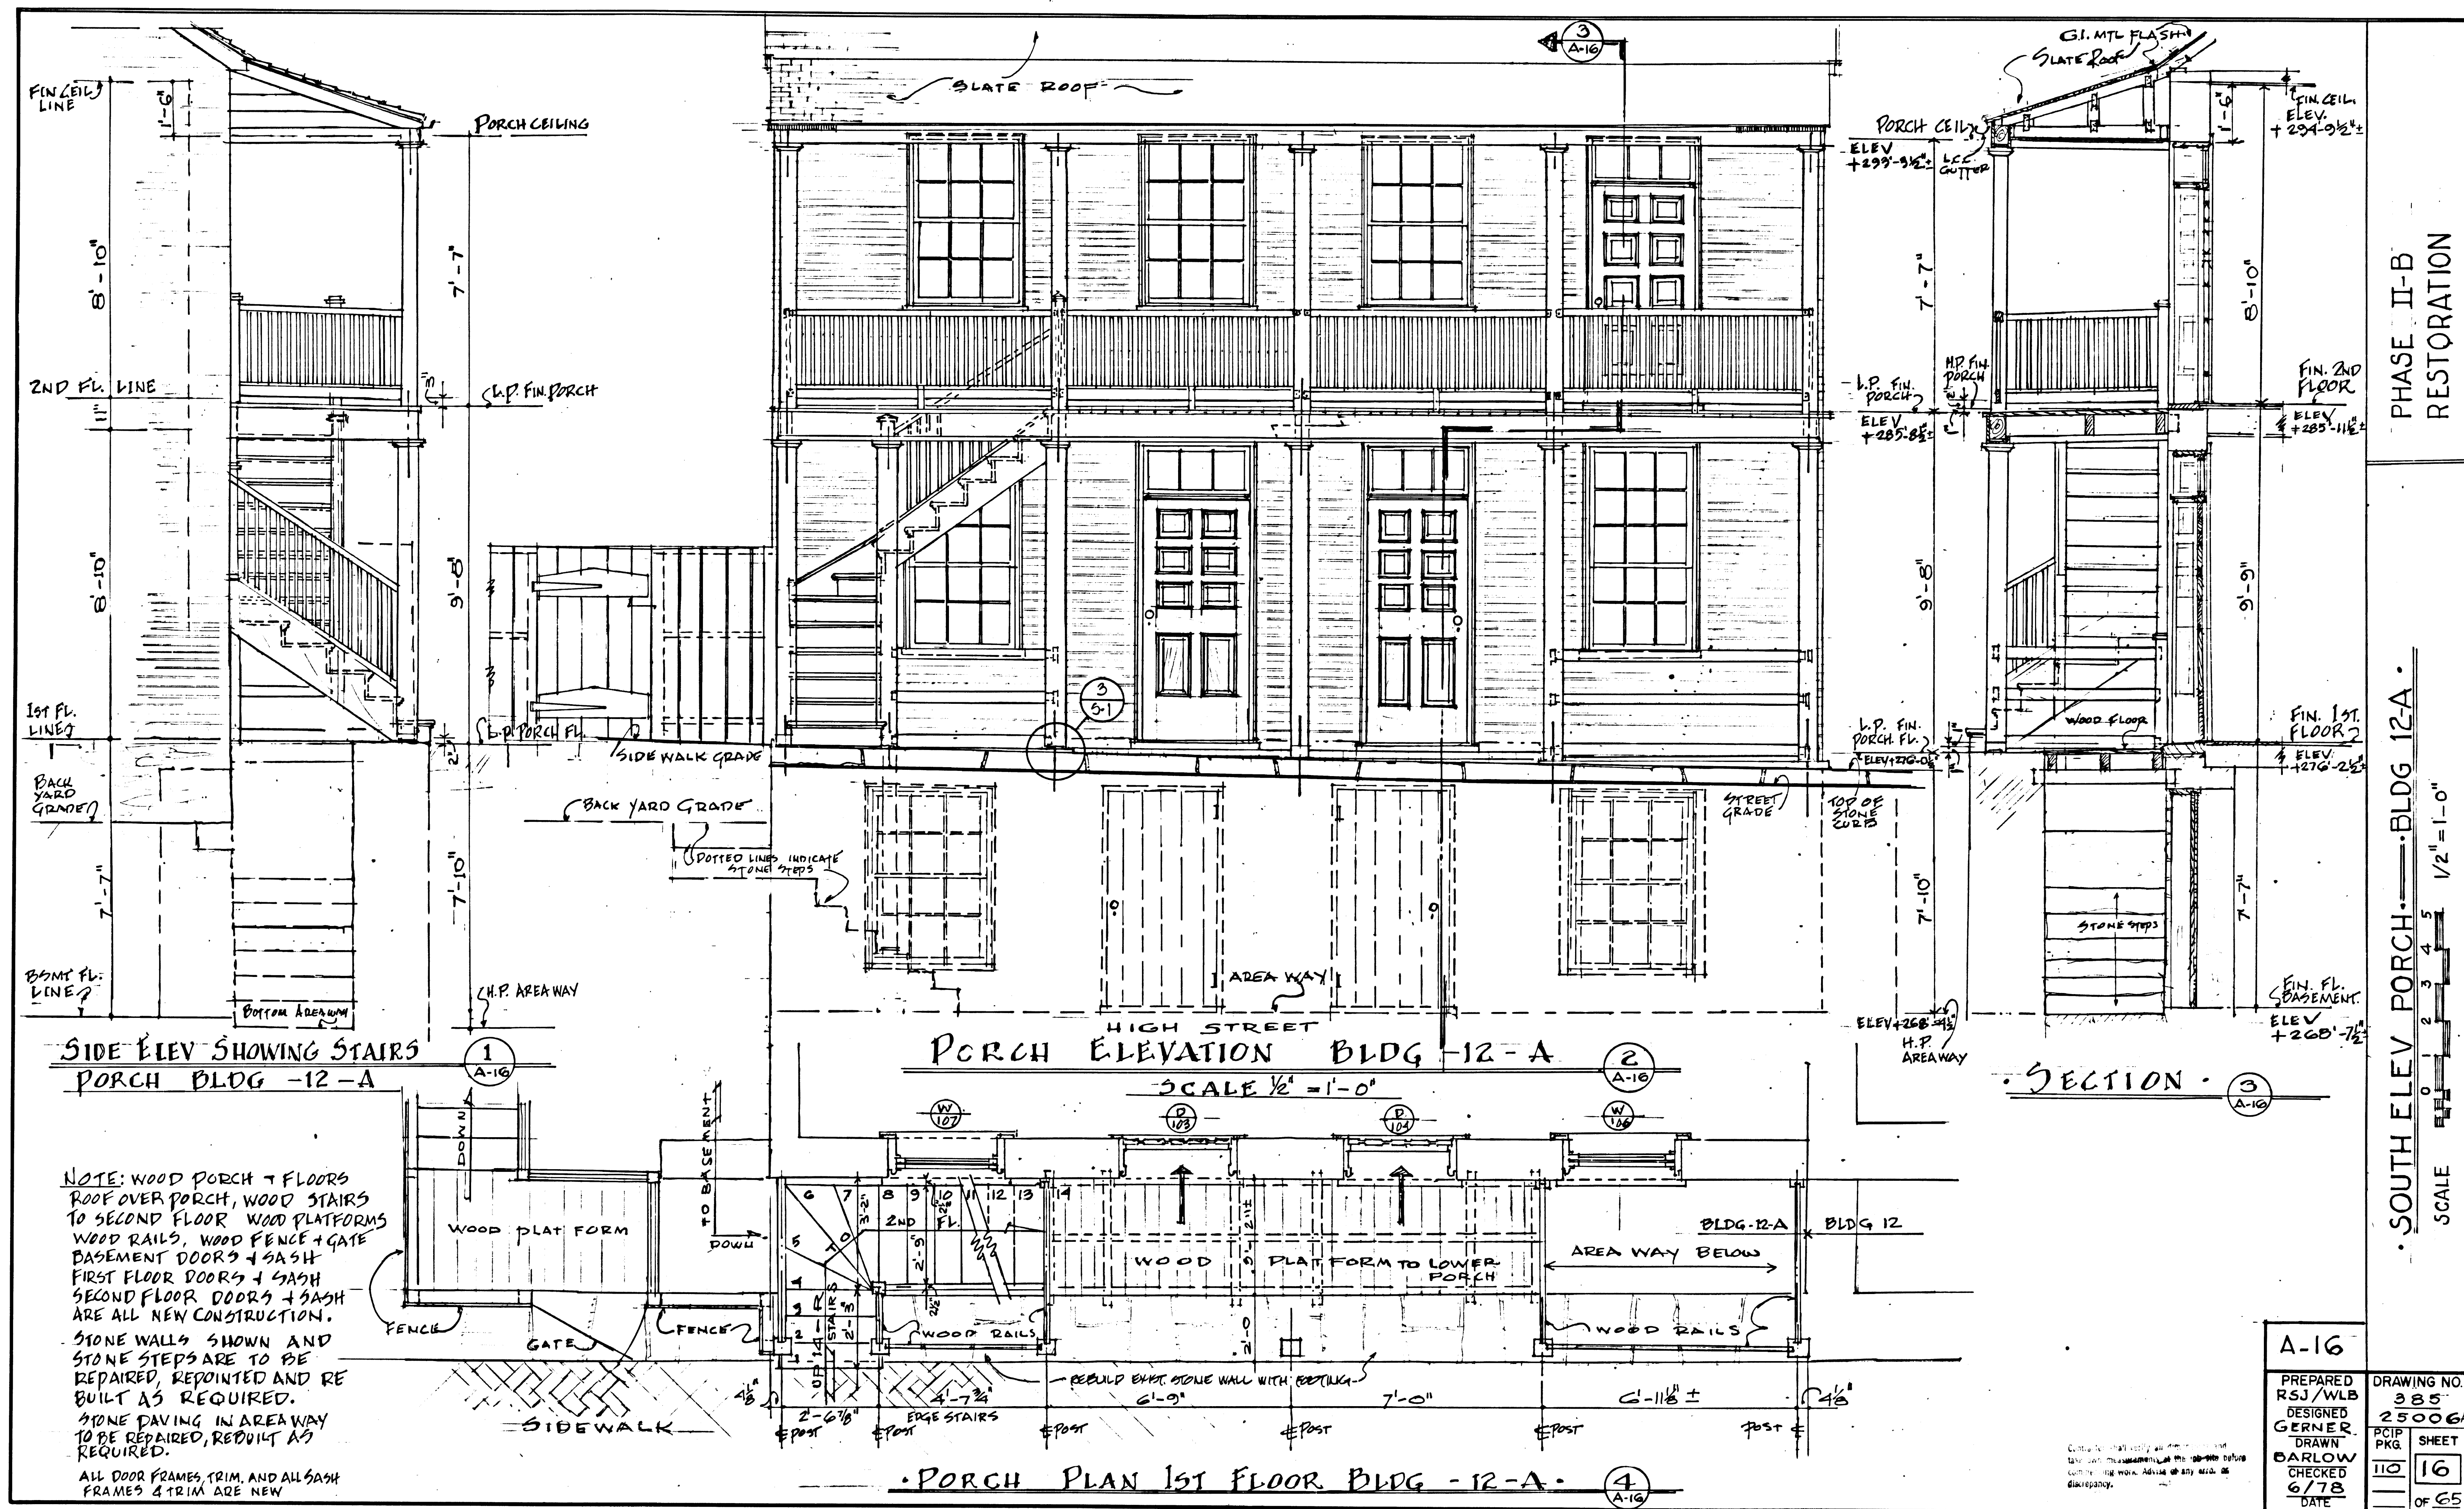


PHASE II-B RESTORATION

• SOUTH ELEV PORCH • BLDG 12-A •

A-16

PREPARED
RSJ/WLB
DESIGNED
Gerner.
DRAWN
BARLOW
CHECKED
6/78
DATE


DRAWING NO.	
385	
25006	
PCIP PKG.	SHEET
110	16
	OF 65

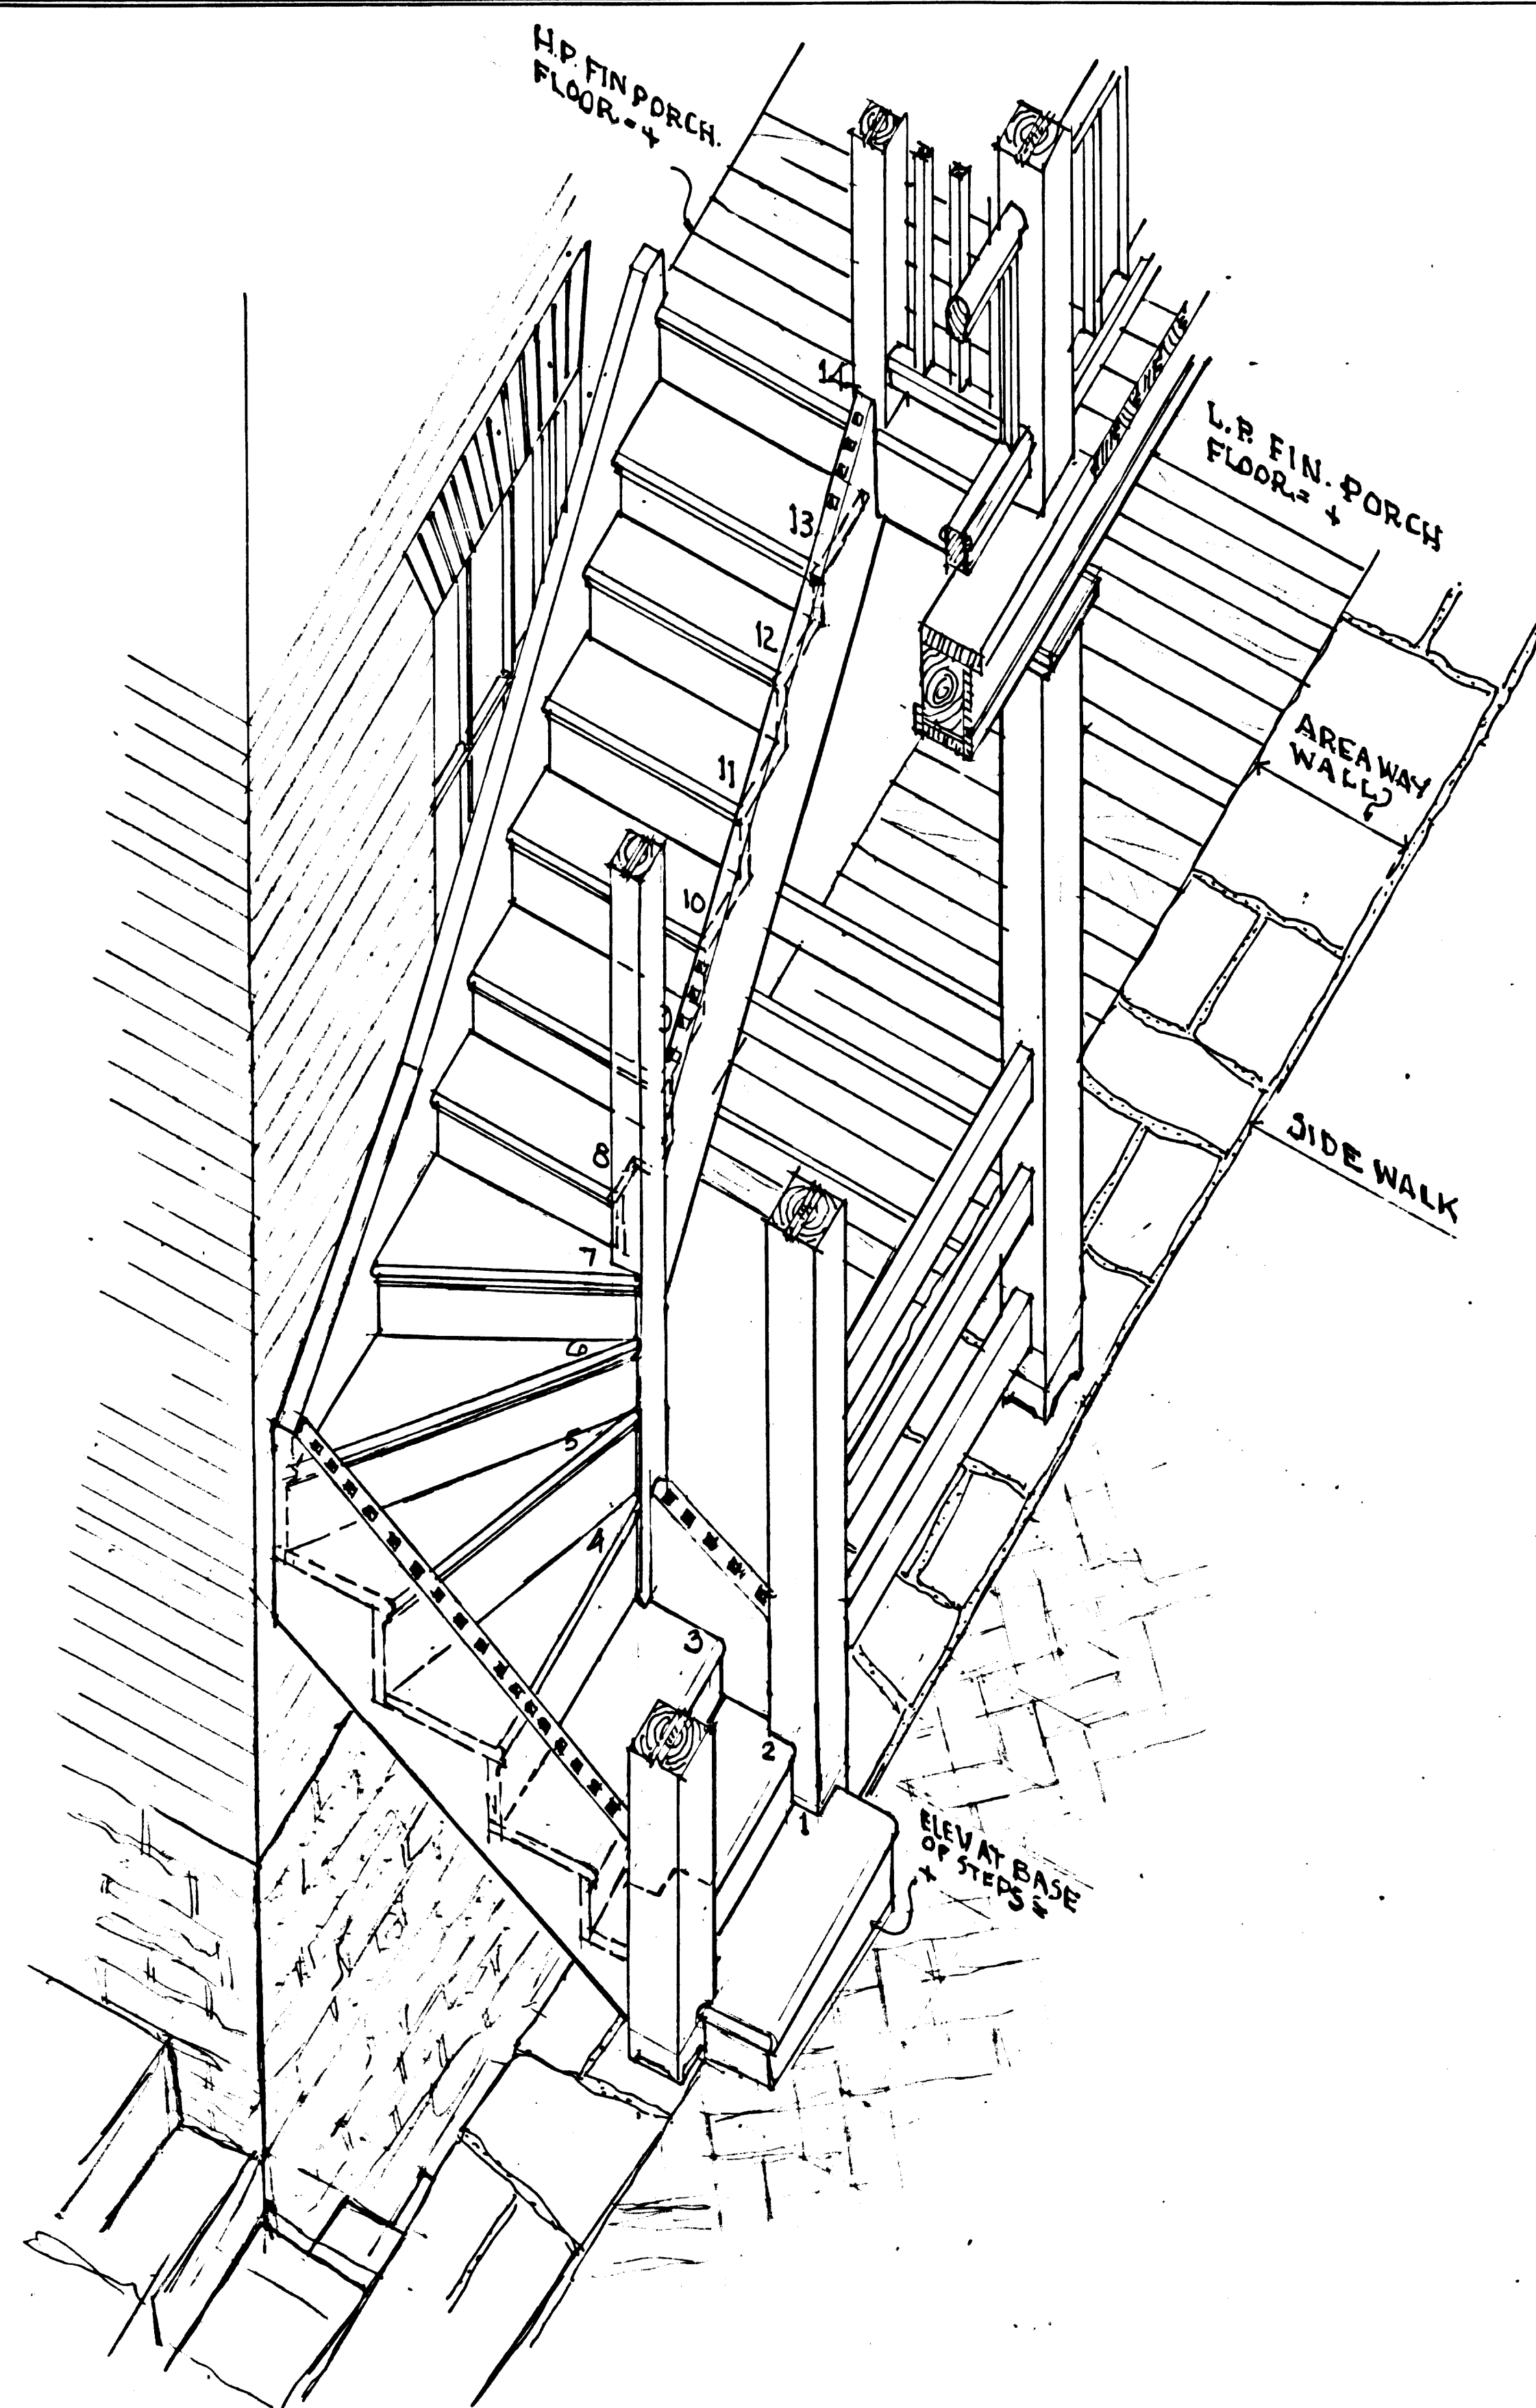

• ISOMETRIC OF STAIRS TO FRONT PORCH BLDG 12A •

SCALE 3/4" = 1'-0"

1
A-17

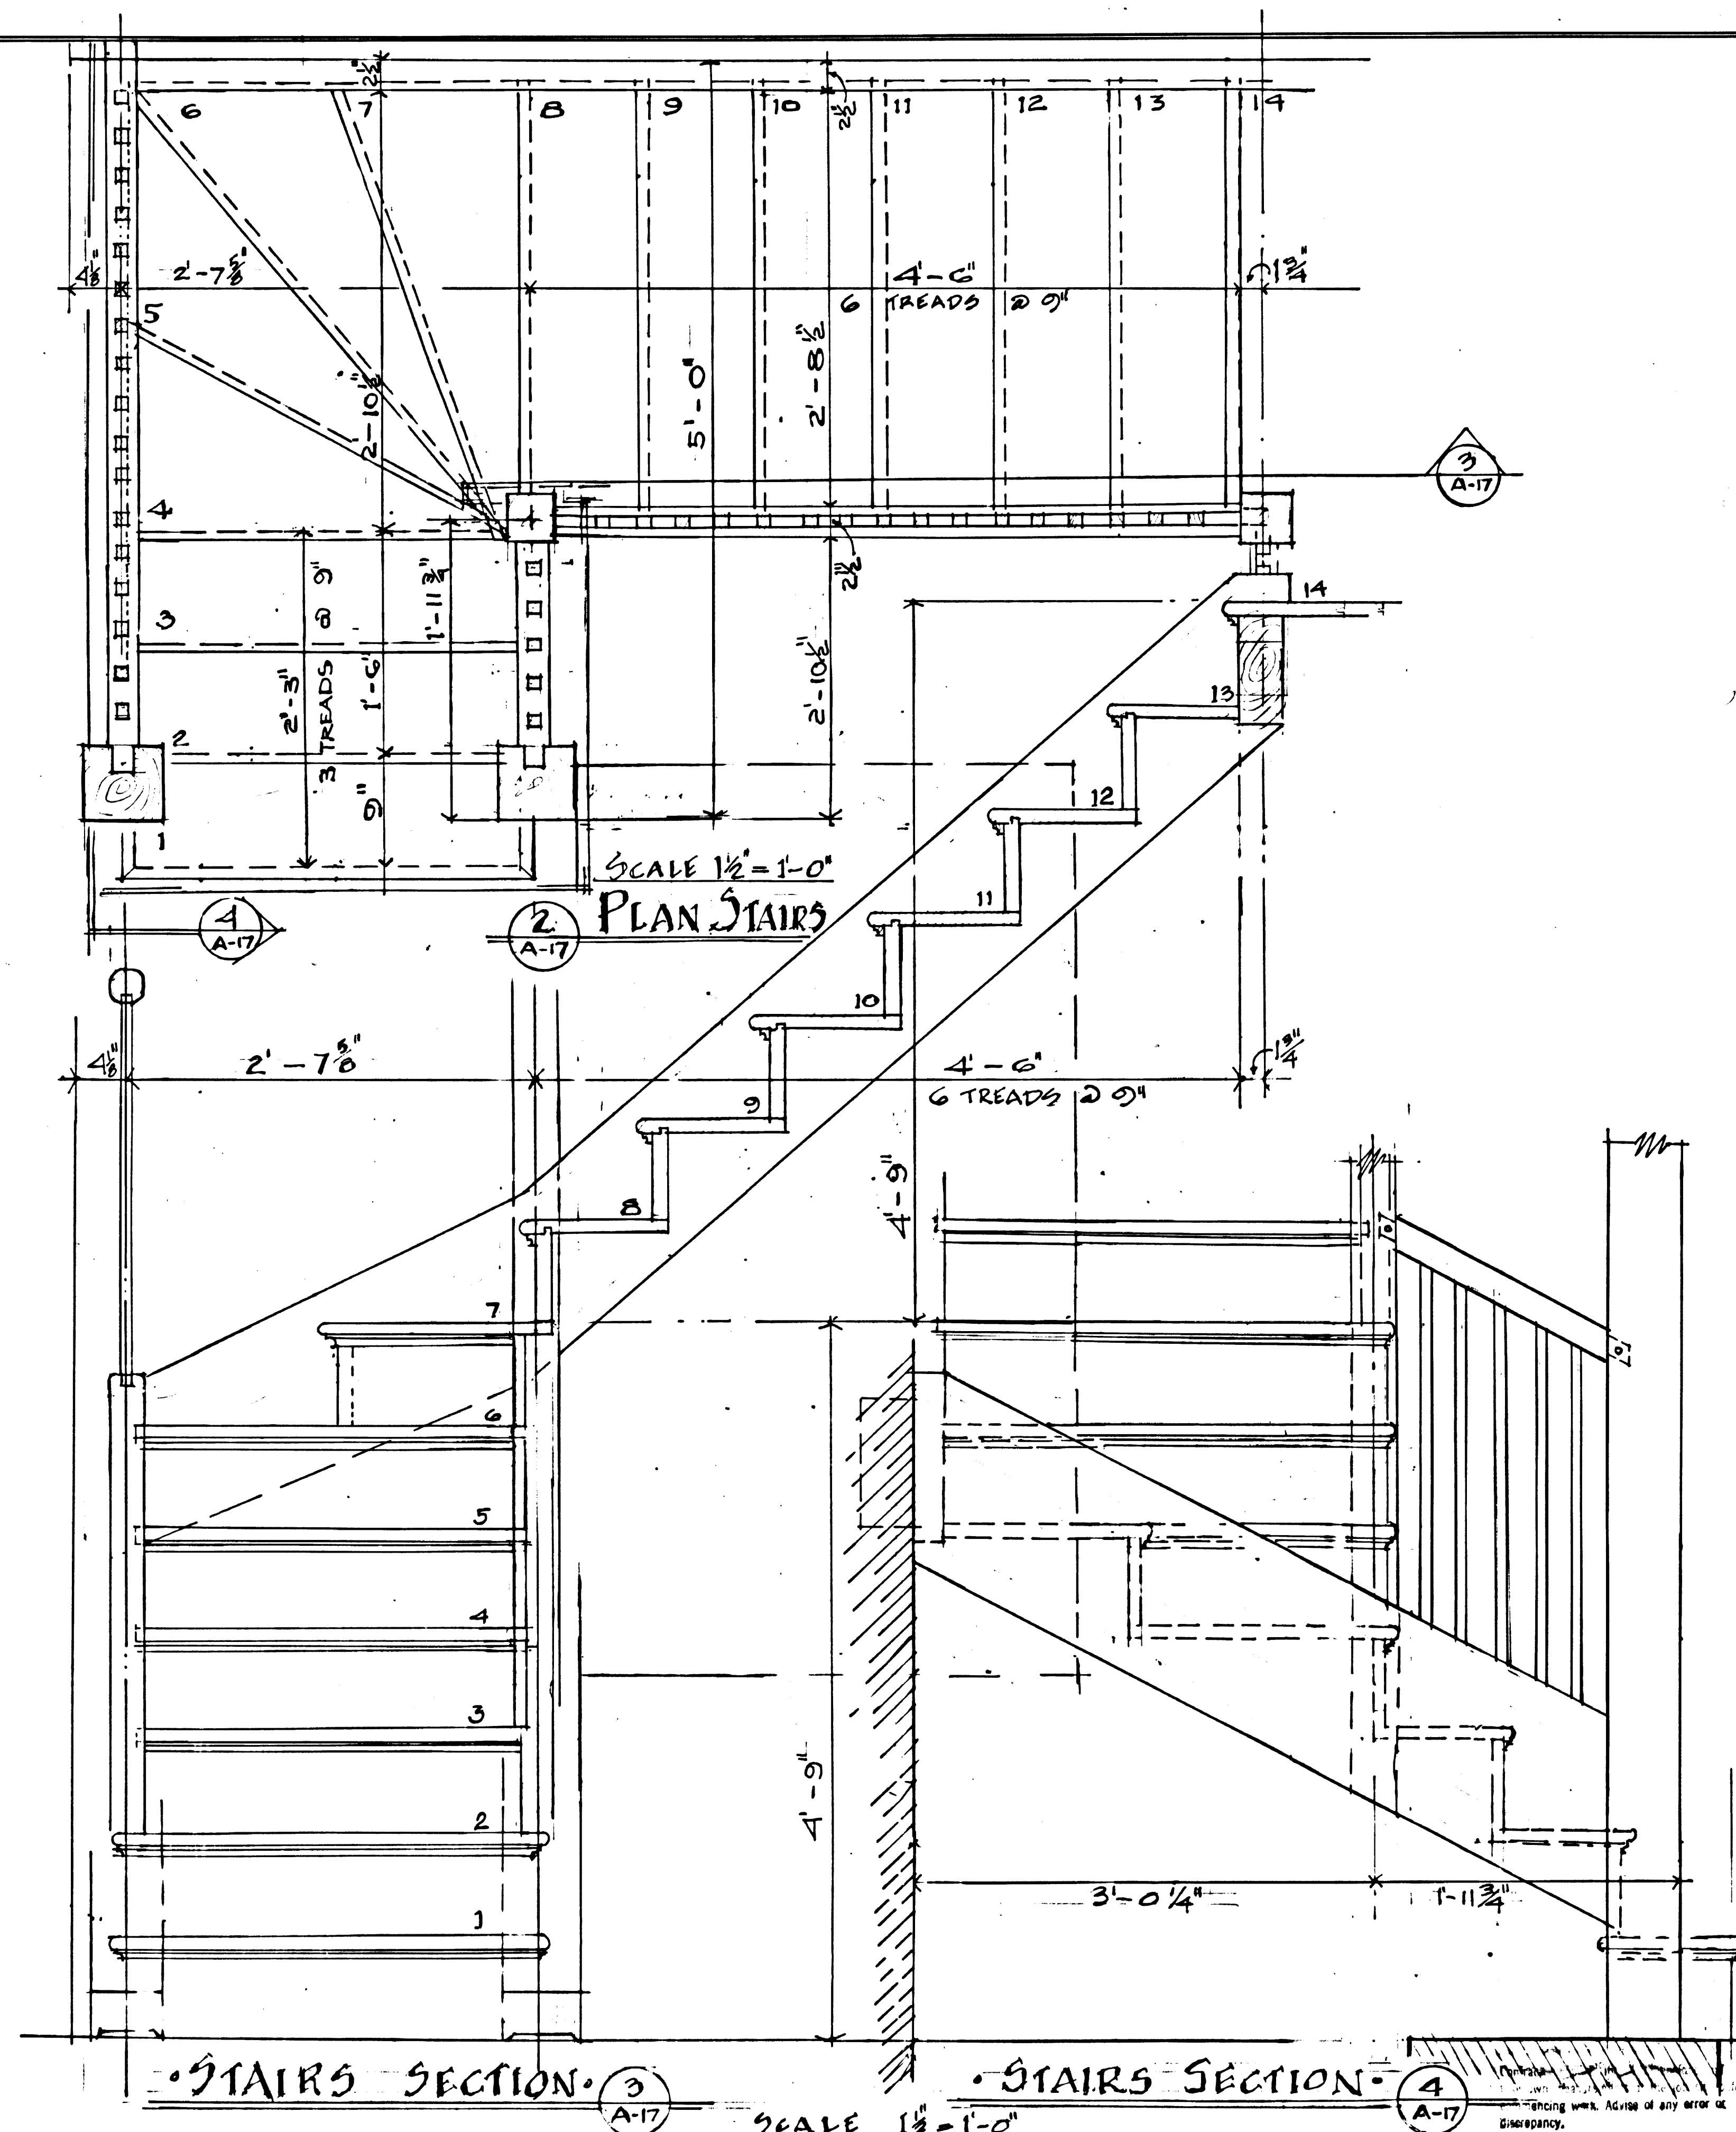

• STAIRS SECTION •

3
A-17

• STAIRS SECTION •

4
A-17

A-17



PREPARED
RSJ/FSG
DESIGNED
GERNER
DRAWN
BARLOW
CHECKED
6/78
DATE

DRAWING NO.
385
25006A
SHEET
17
OF 65

STAIR DETAILS PORCH BLDG 12A

PHASE II-B EXTERIOR
RESTORATION BLDG 12 & 12A

SCALE 1/2" = 1'-0"
2 FEET

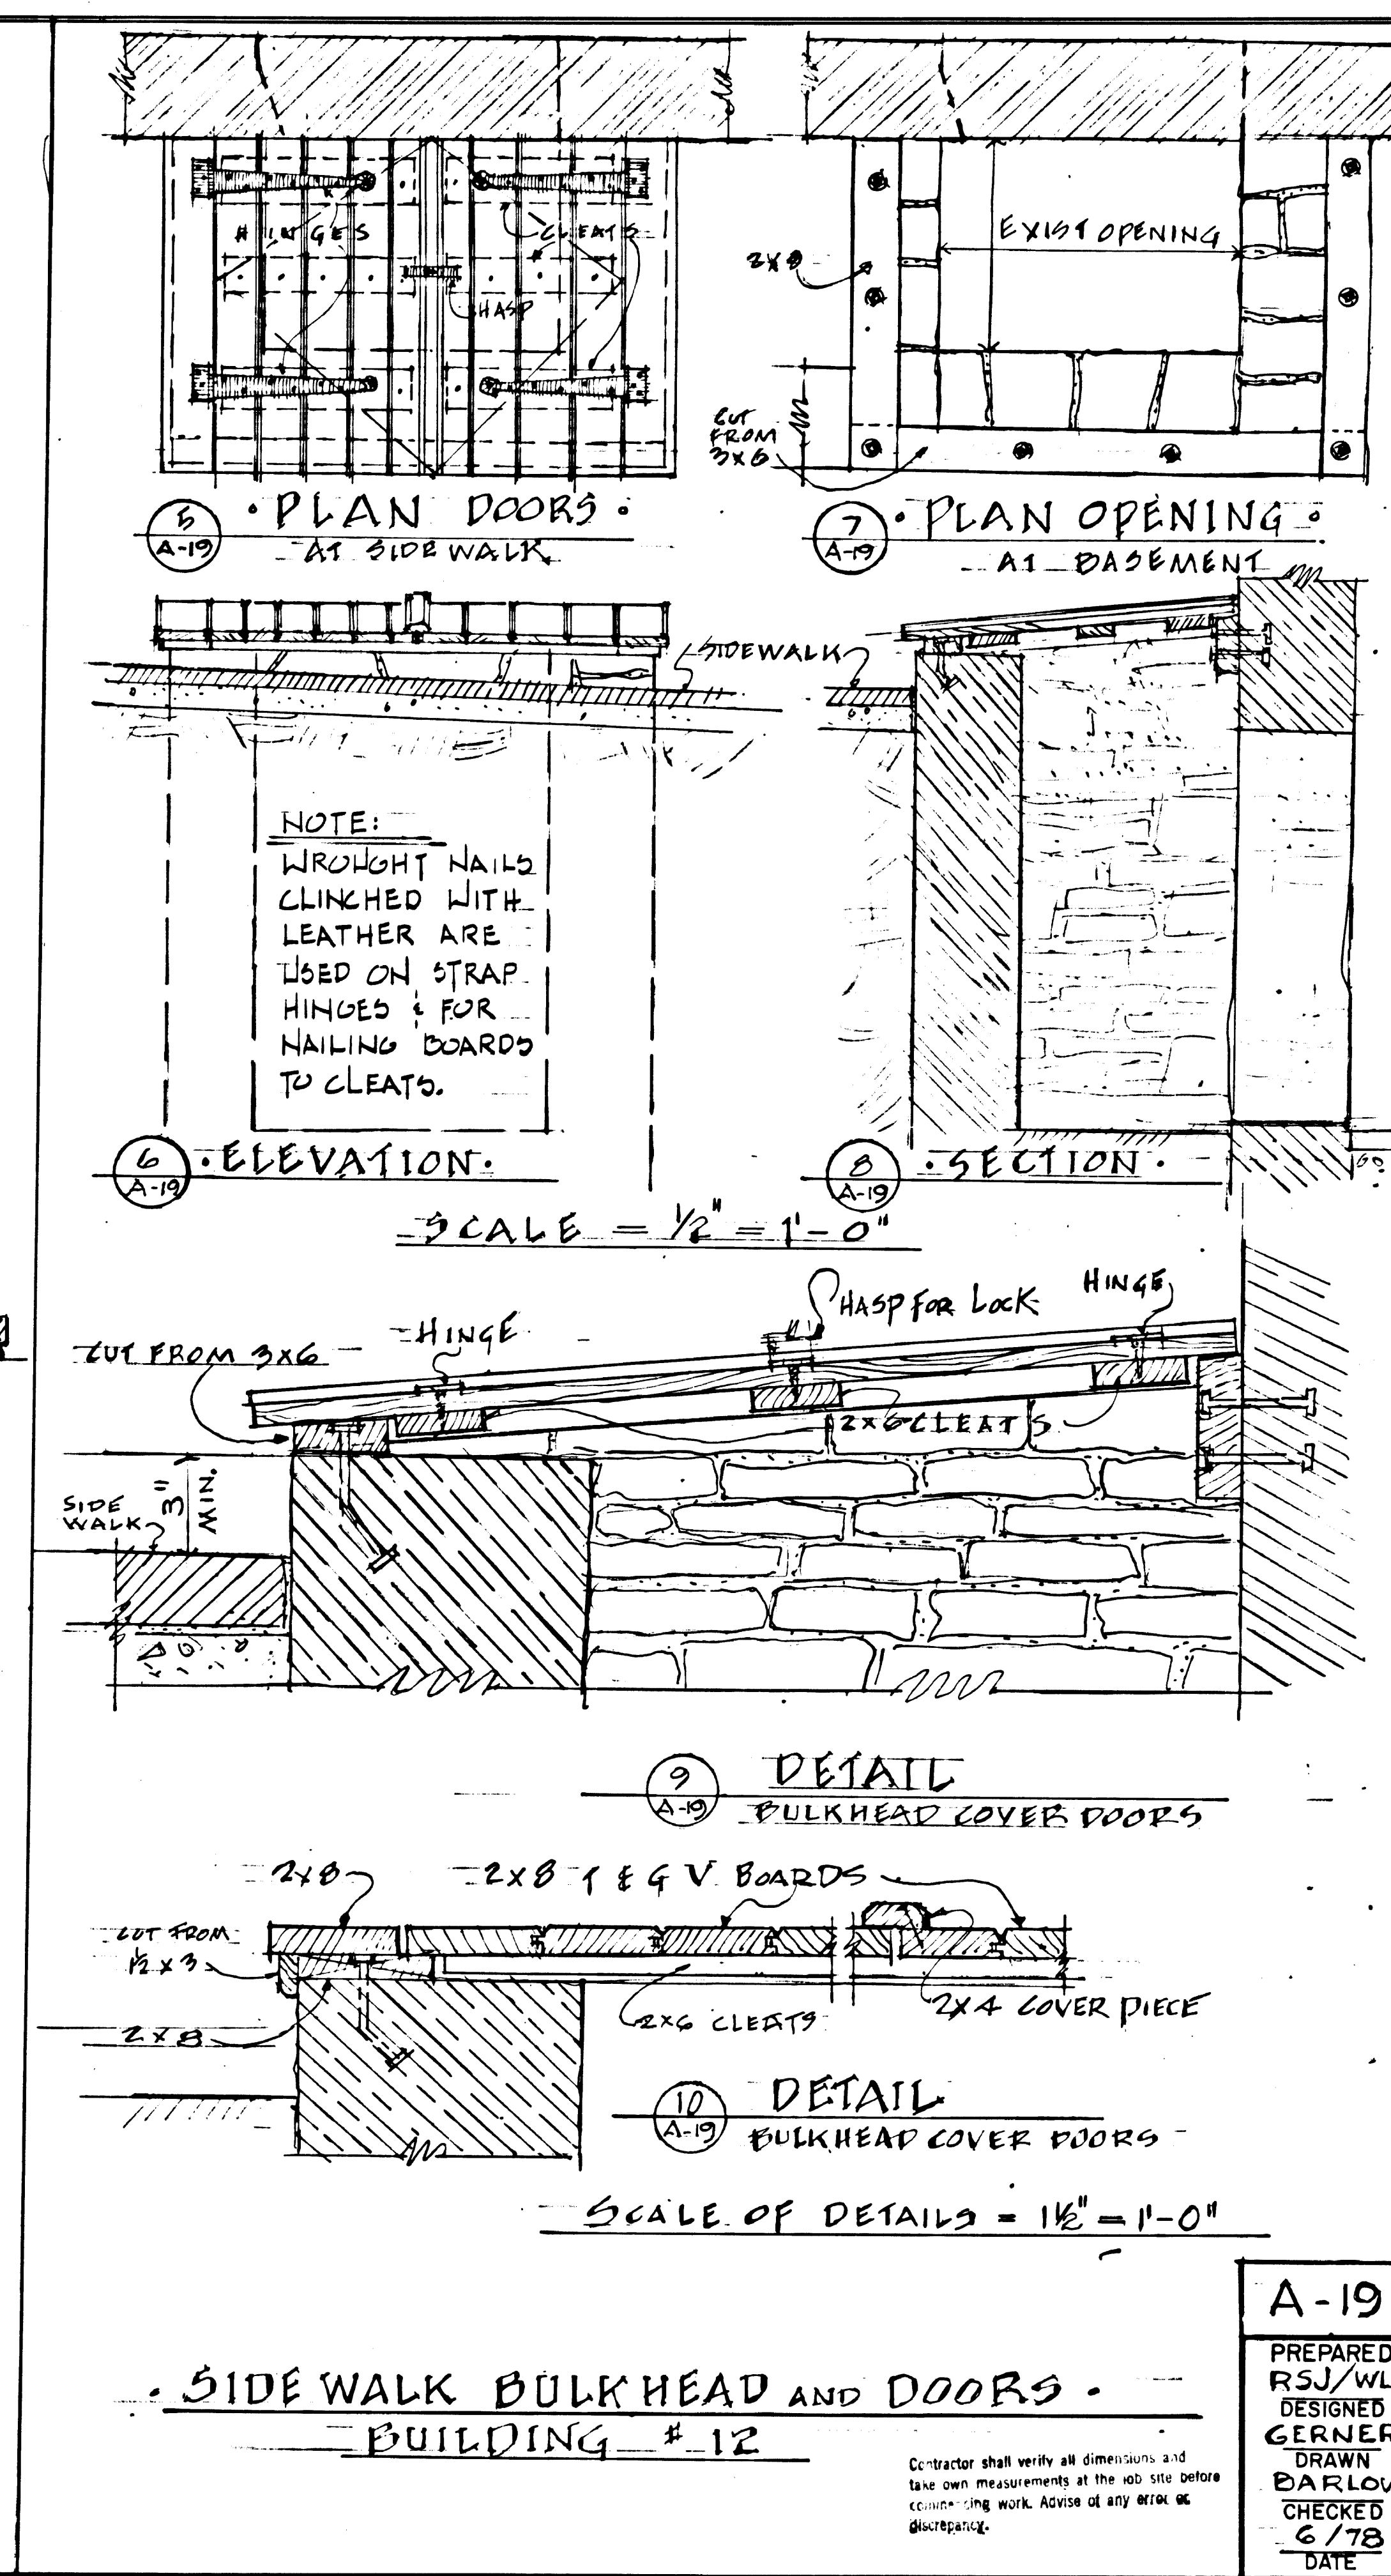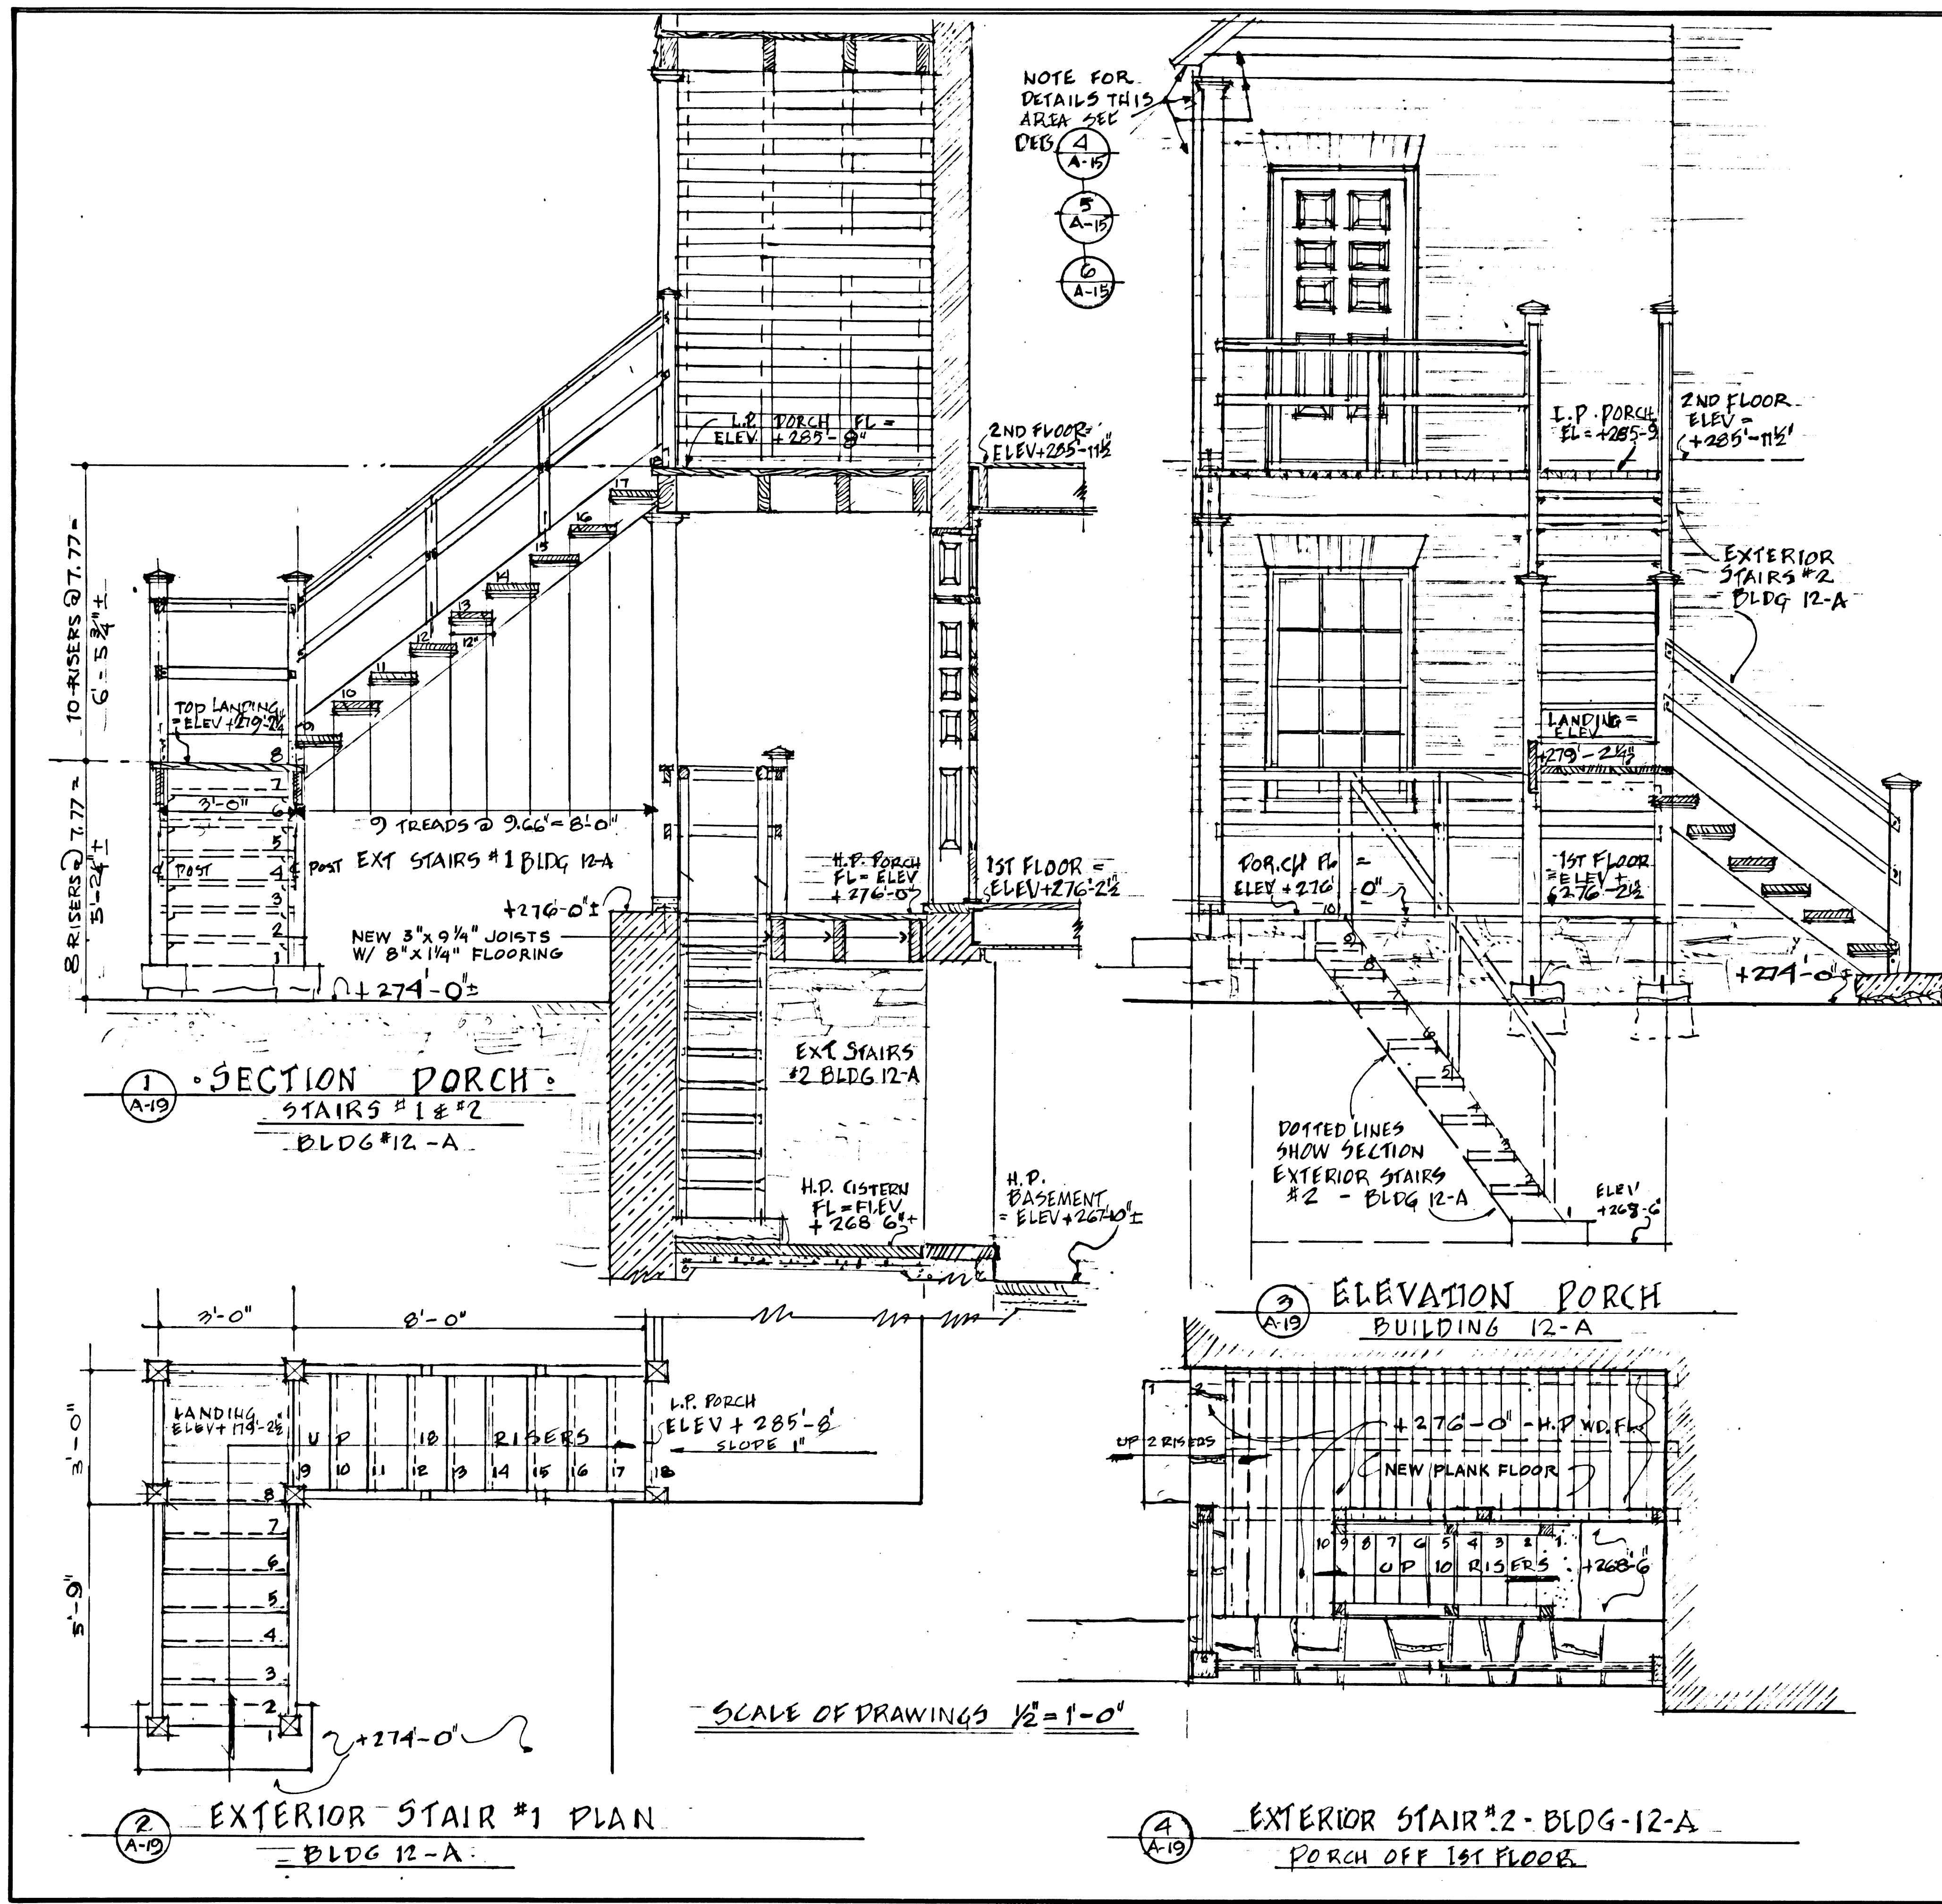


PHASE II-B
RESTORATION


EXTERIOR STAIRS AND SIDEWALK BULKHEAD BLDG 12&12-A

SCALE: AS NOTED


A-19	
PREPARED RSJ/WLB	DRAWING NO. 385
DESIGNED GERNER	25006
DRAWN BARLOW	PKG. SHEET
CHECKED 6/78	110 19
DATE	OF 65

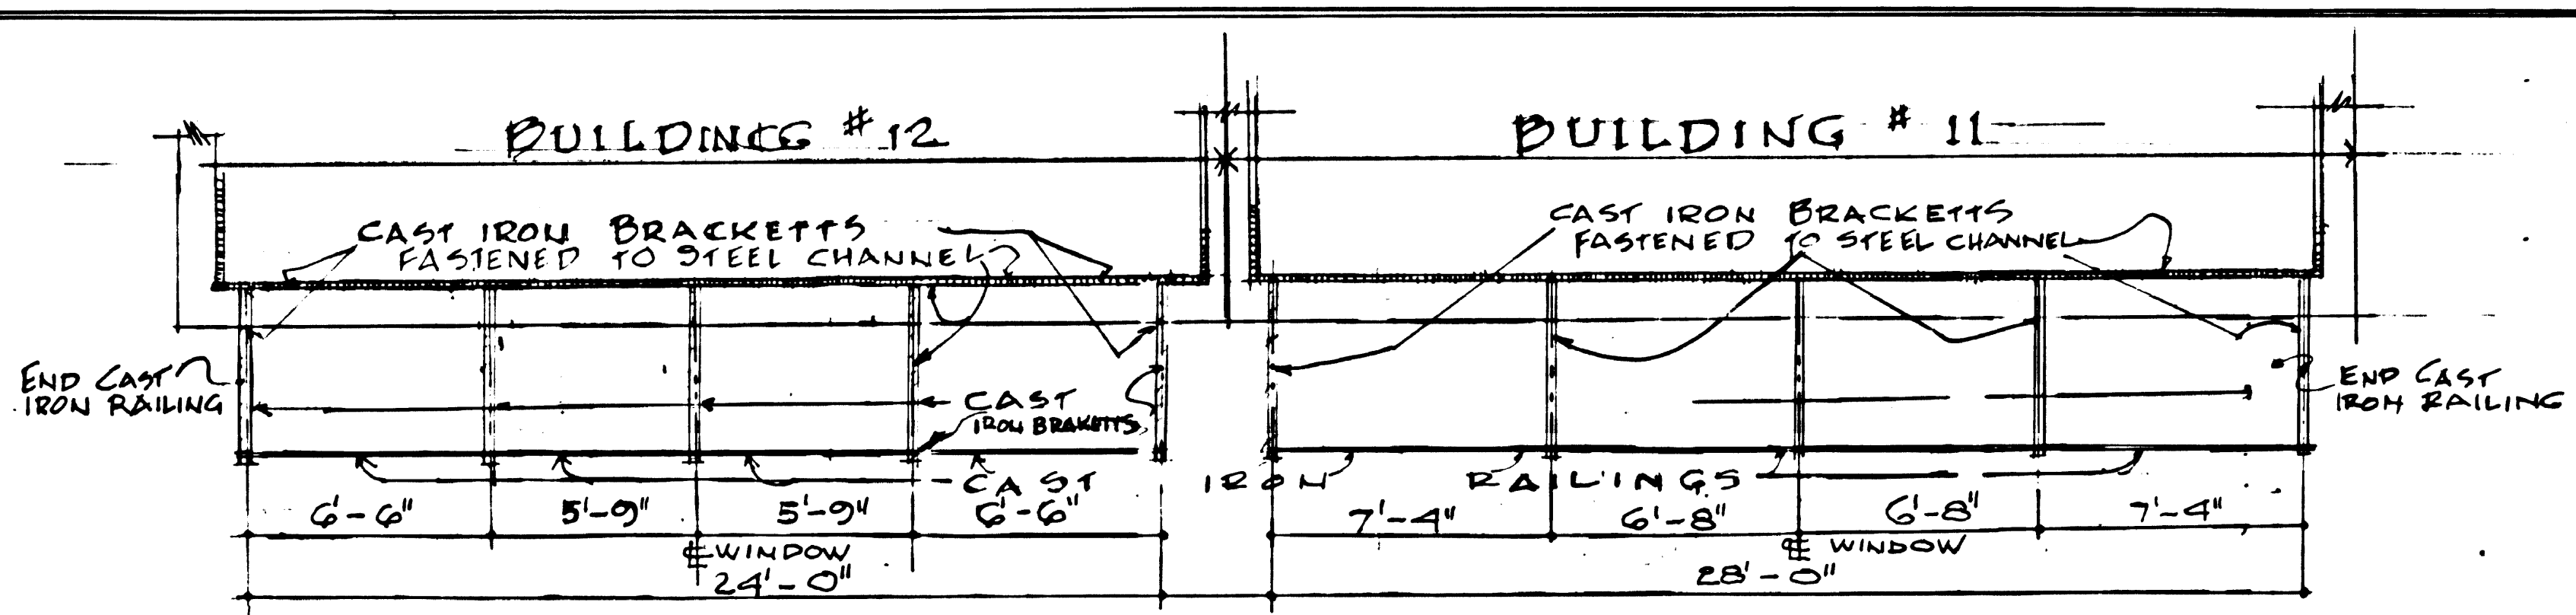


1 PLAN OF BALCONY
SHOWING LOCATION OF BRACKETTS AND RAILING
SCALE = 1/4" = 1'-0"

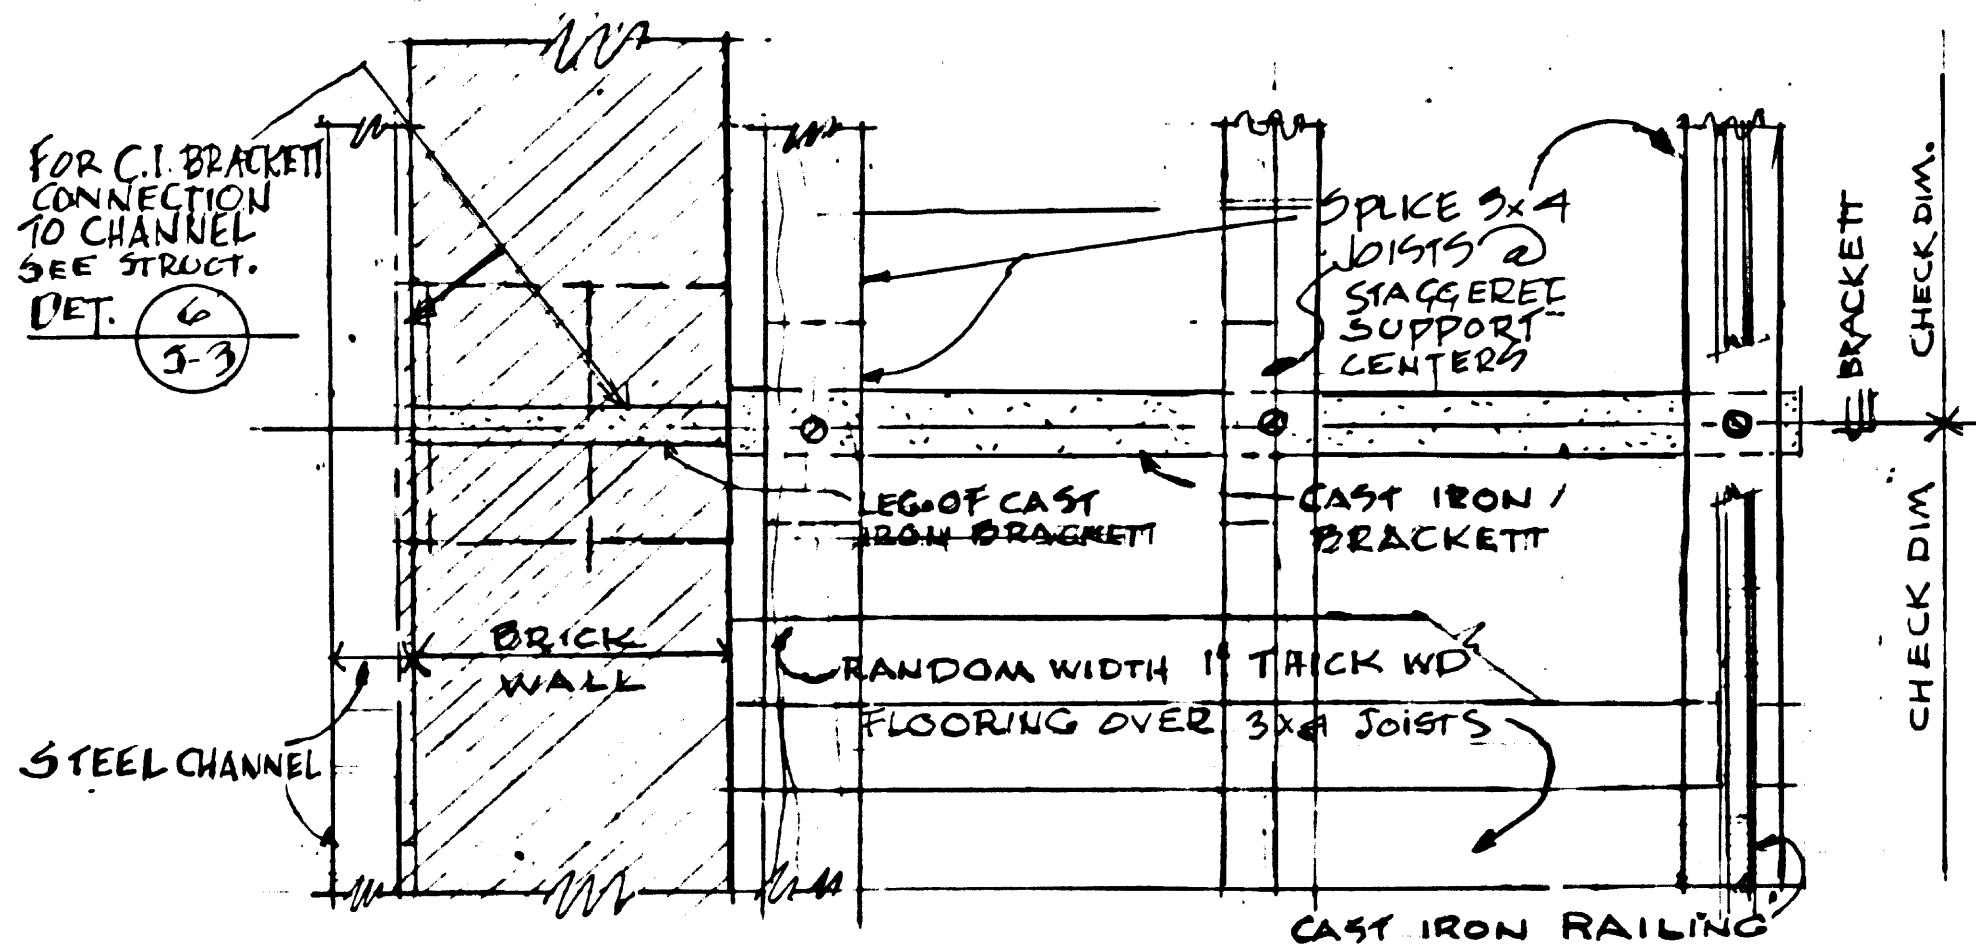

2 DETAIL PLAN OF BALCONY
SHOWING BRACKETTS
SCALE = 1/2" = 1'-0"

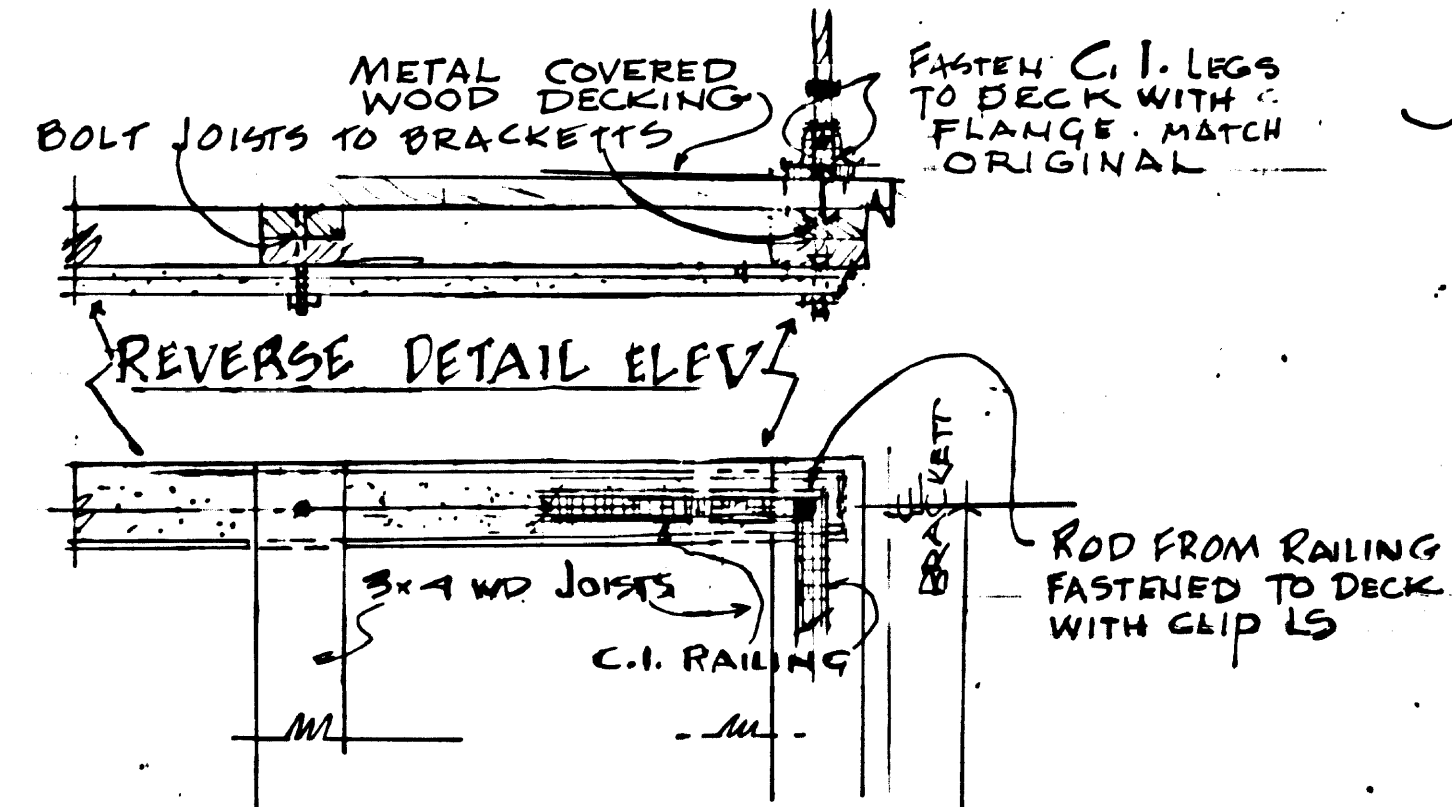


3 DETAIL PLAN
SHOWING CORNER
SCALE = 1/2" = 1'-0"

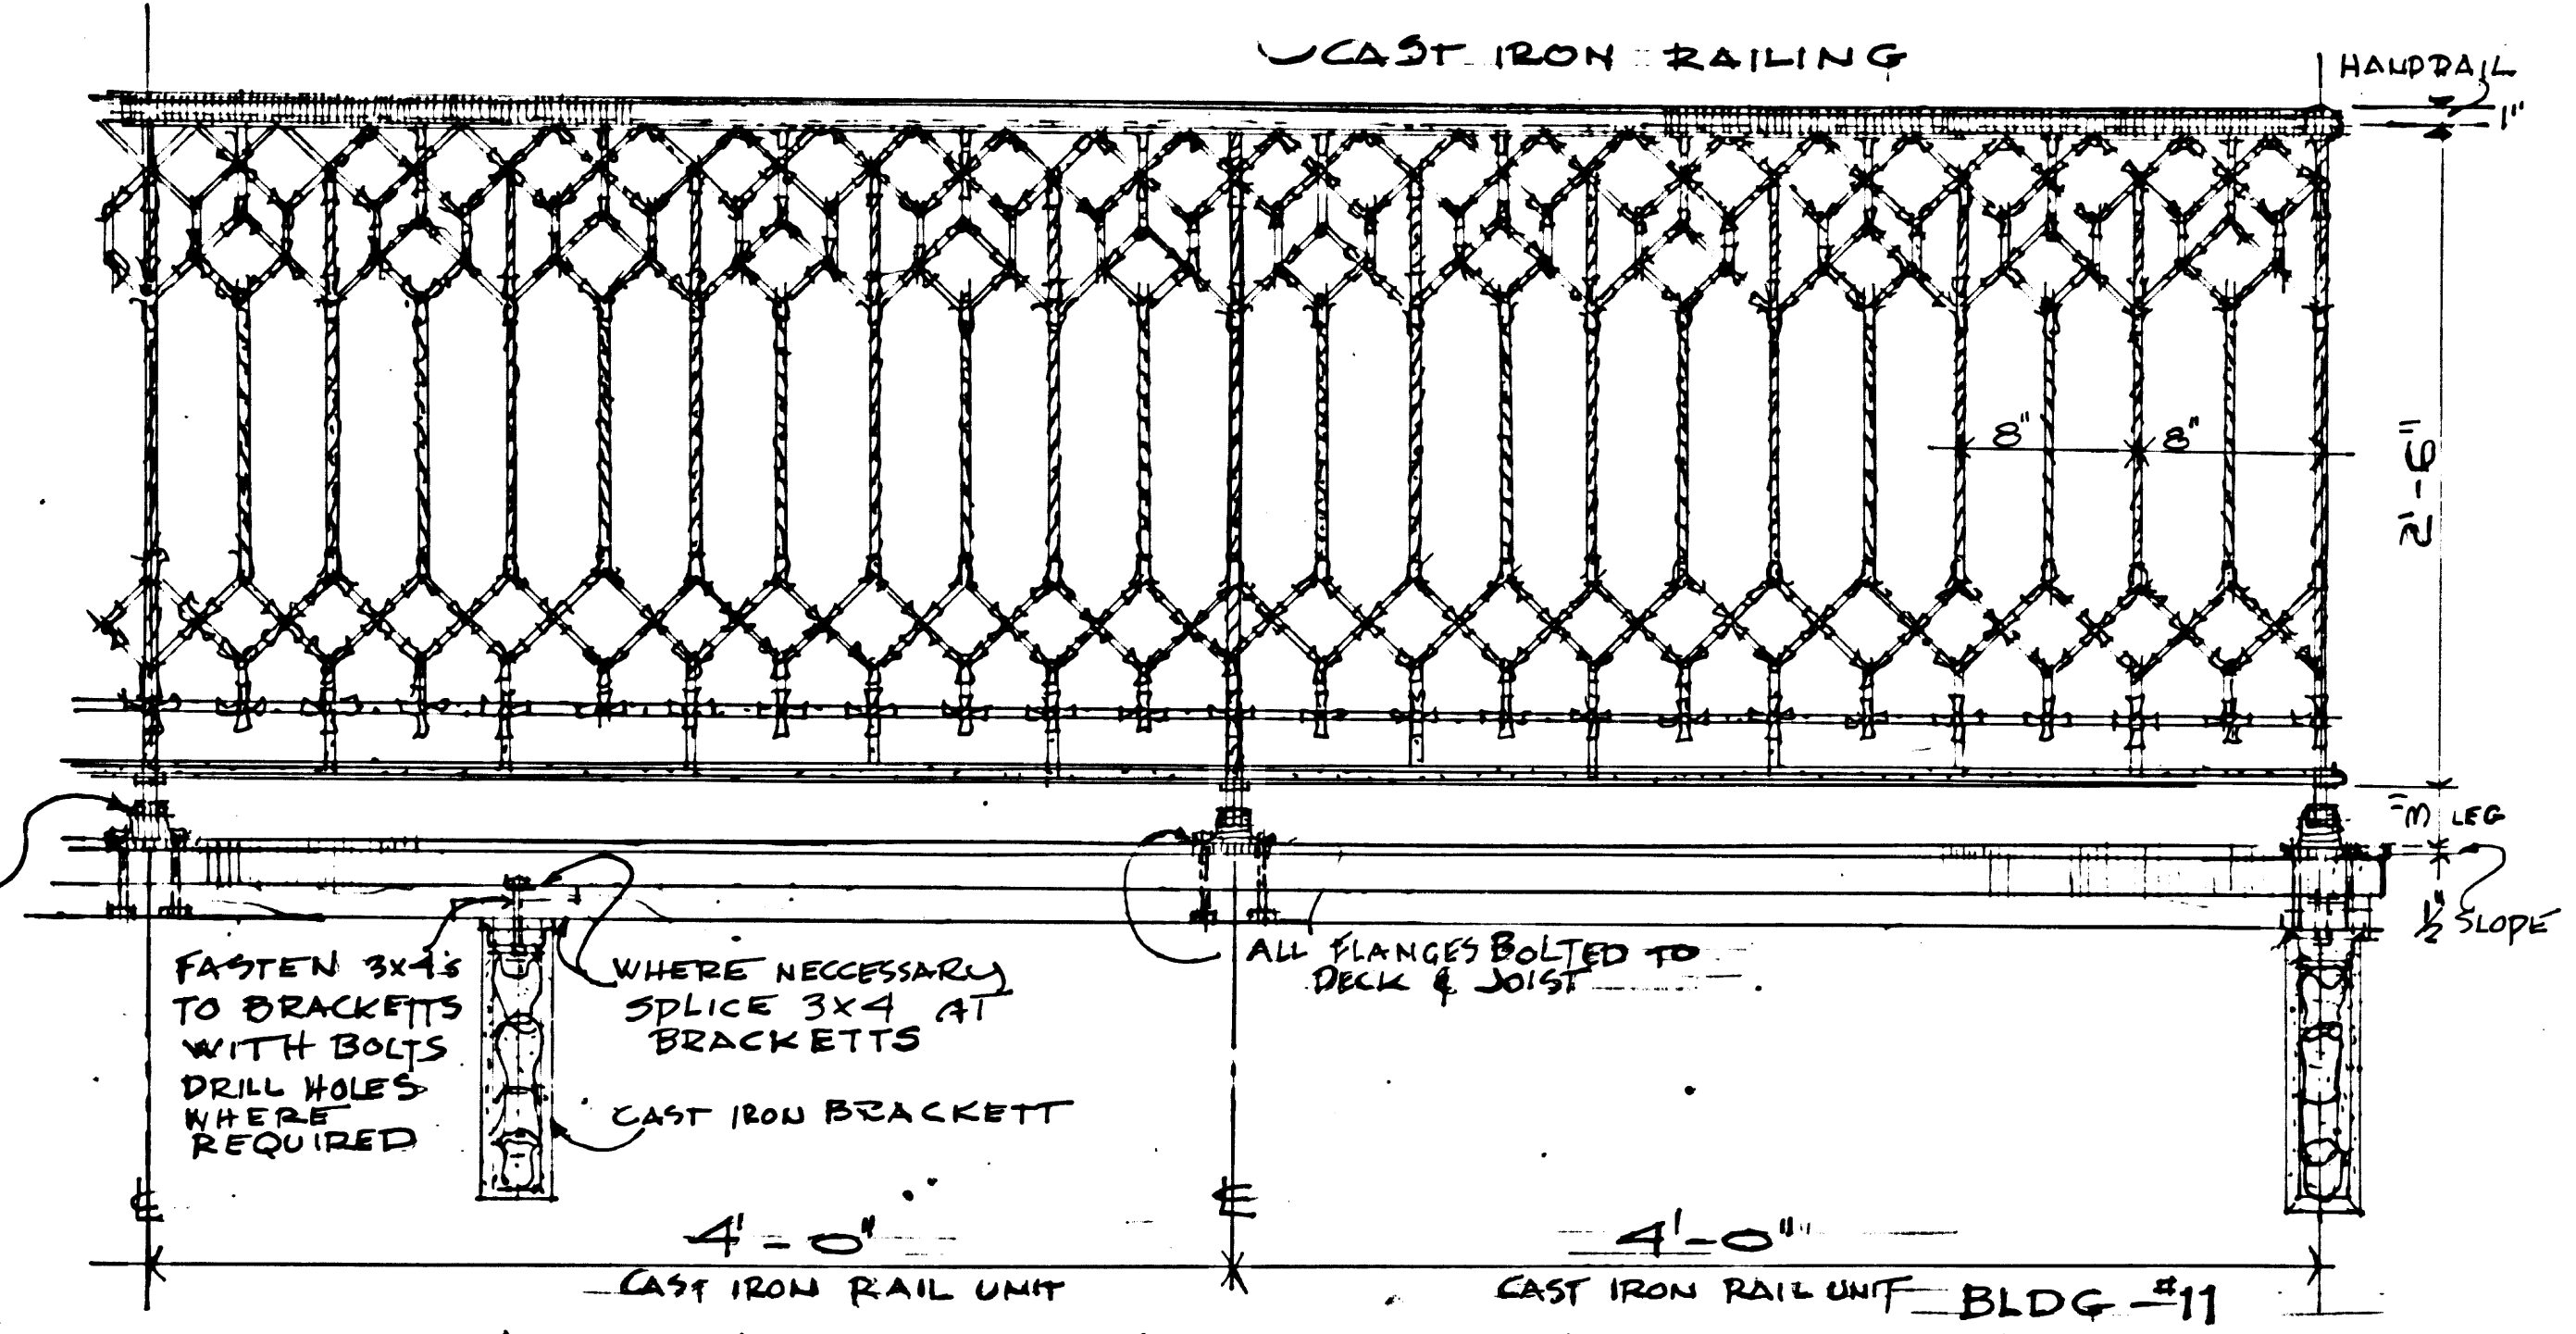


4 4 FOOT SECTIONS OF BALCONY ELEVATION.
7-4 FOOT SECTIONS LIKE THIS
SCALE 1" = 1'-0"


NOTE: SUBMIT SHOP DRAWINGS TO SHOW METHOD OF ASSEMBLY

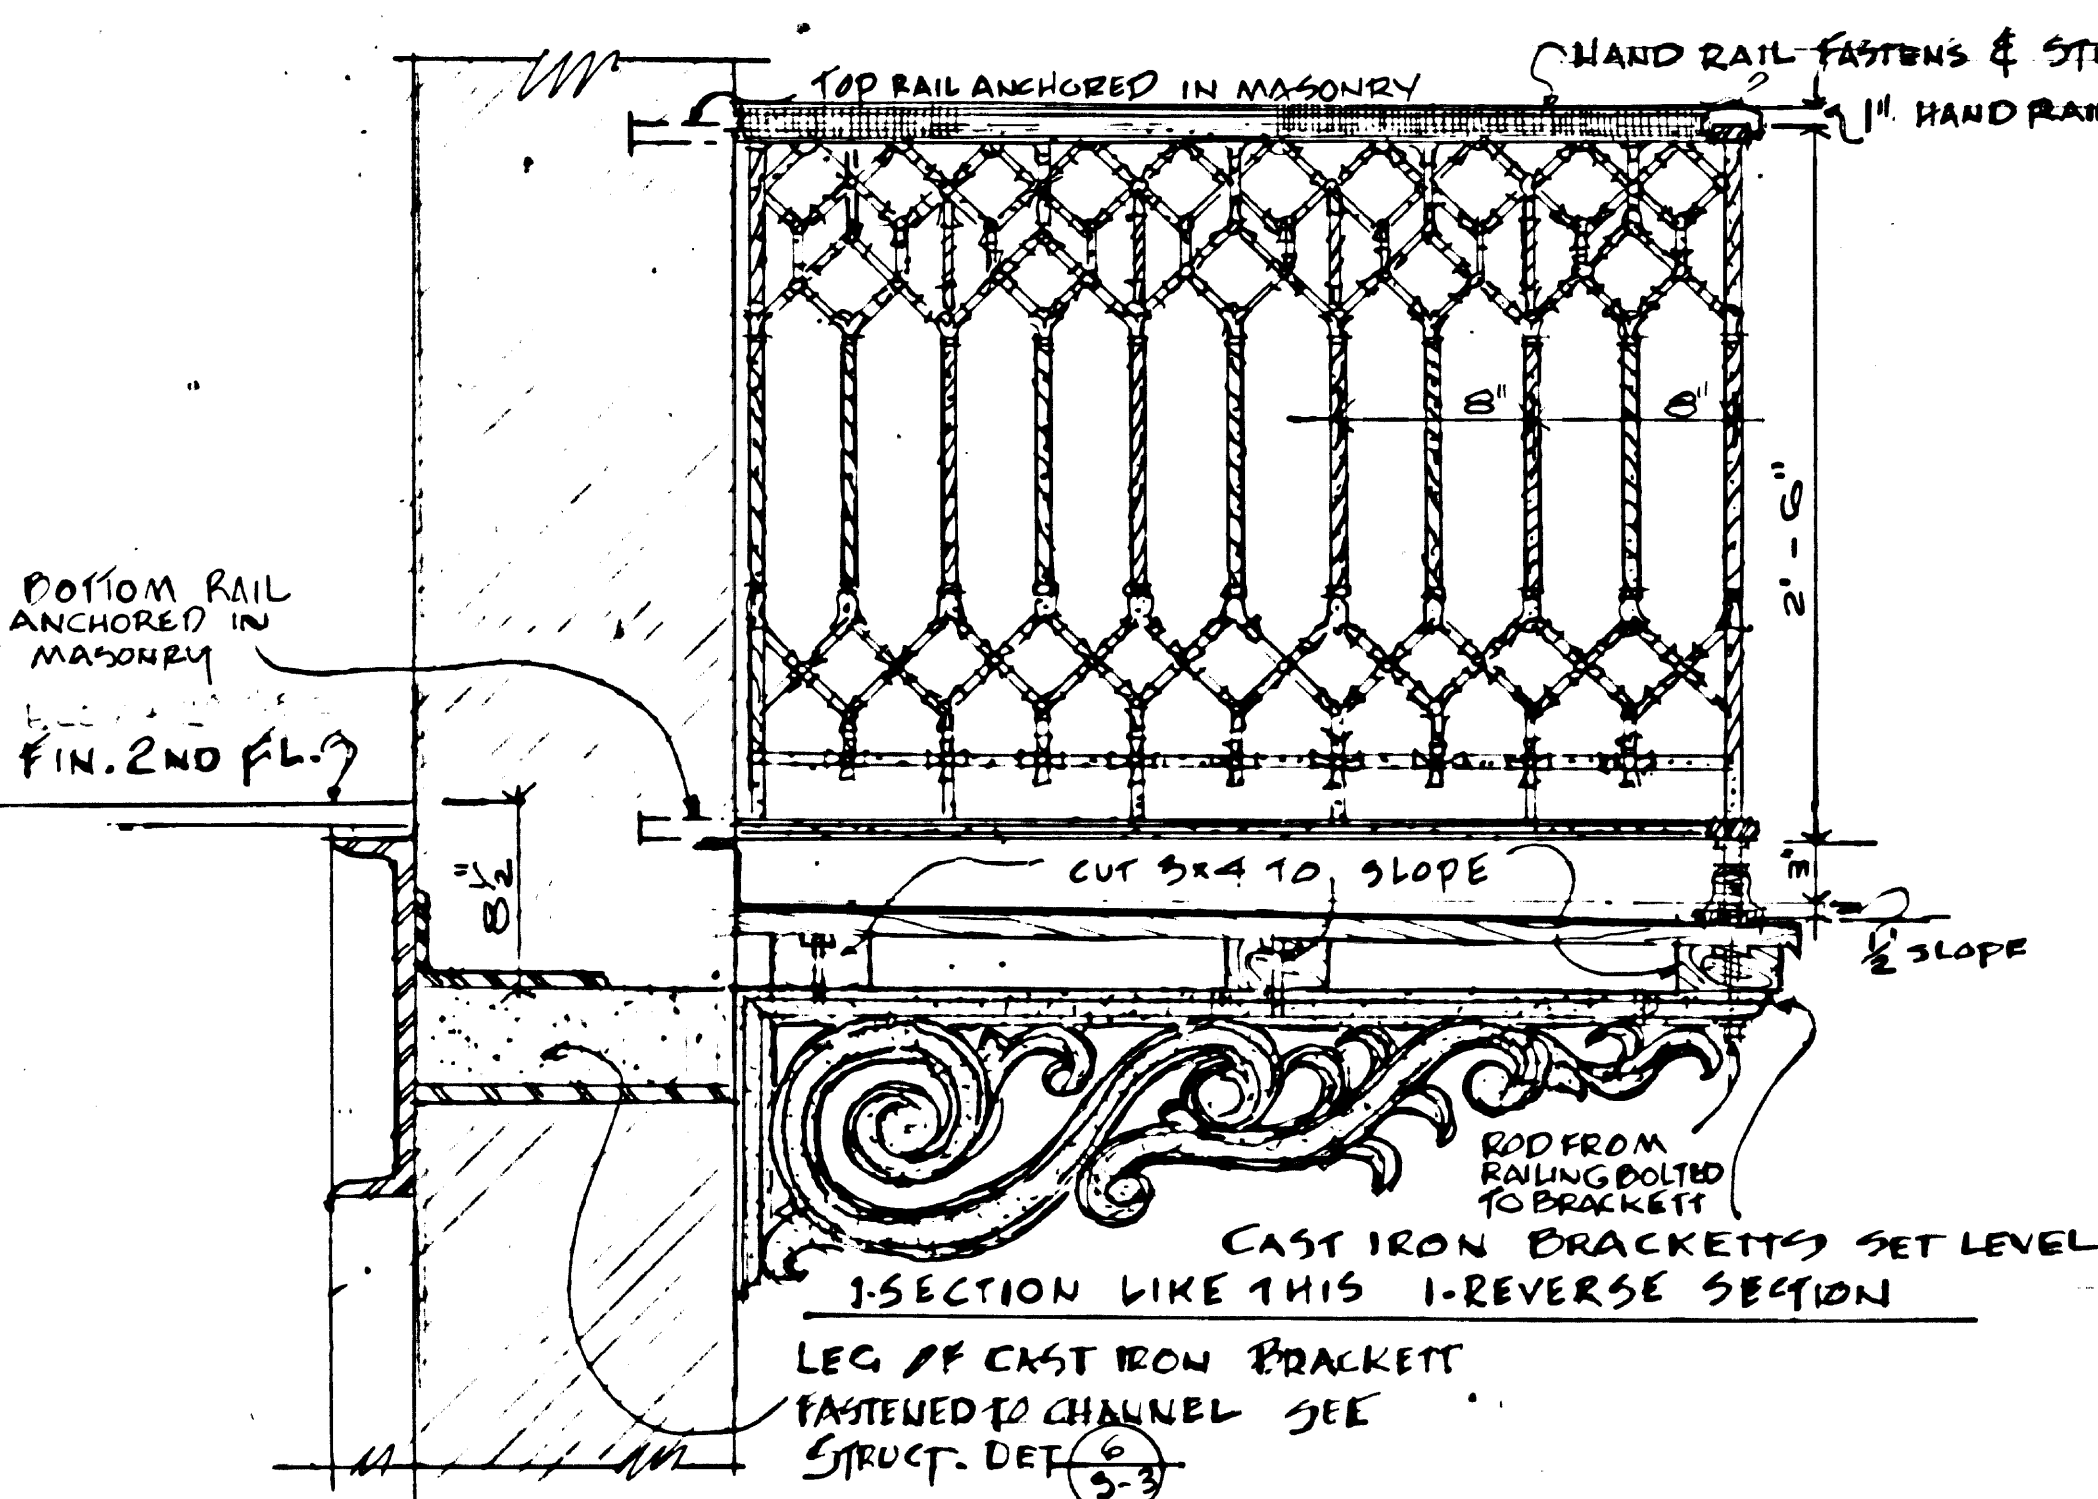

5 SECTION THRU BALCONY
SHOWING BRACKETT AND END RAILING
SCALE = 1/2" = 1'-0"

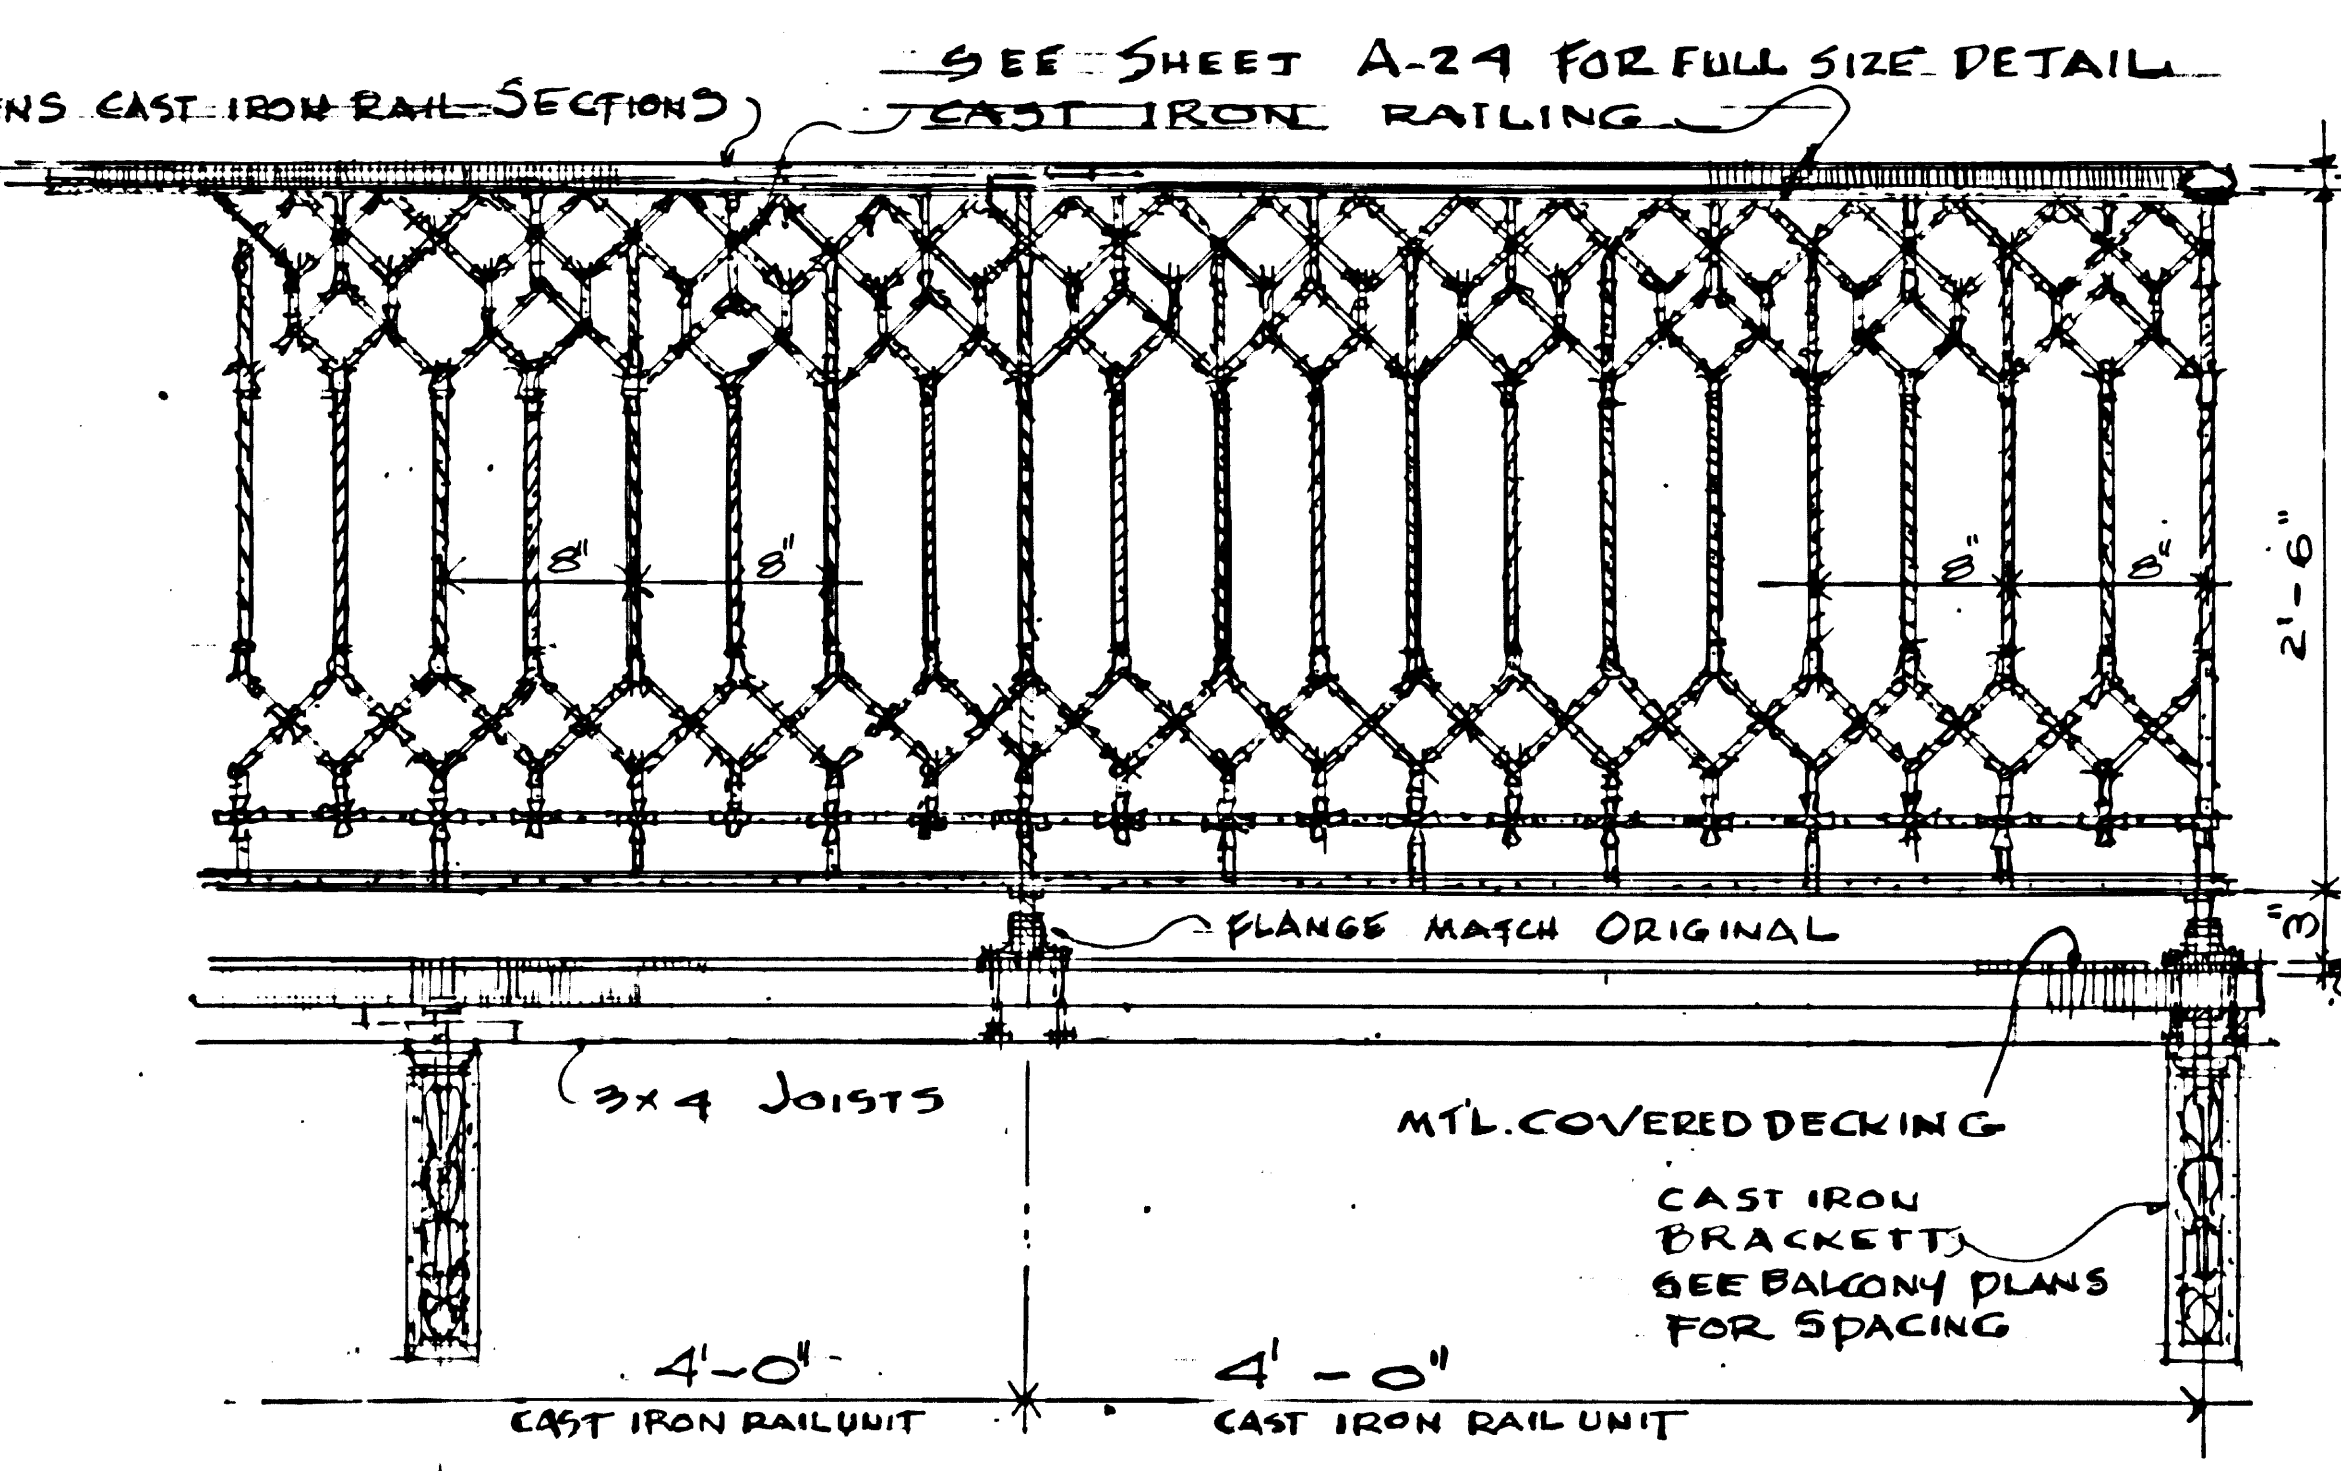

6 4 FOOT SECTIONS OF BALCONY ELEVATION
6-4 FOOT SECTIONS LIKE THIS
SCALE = 1/2" = 1'-0"

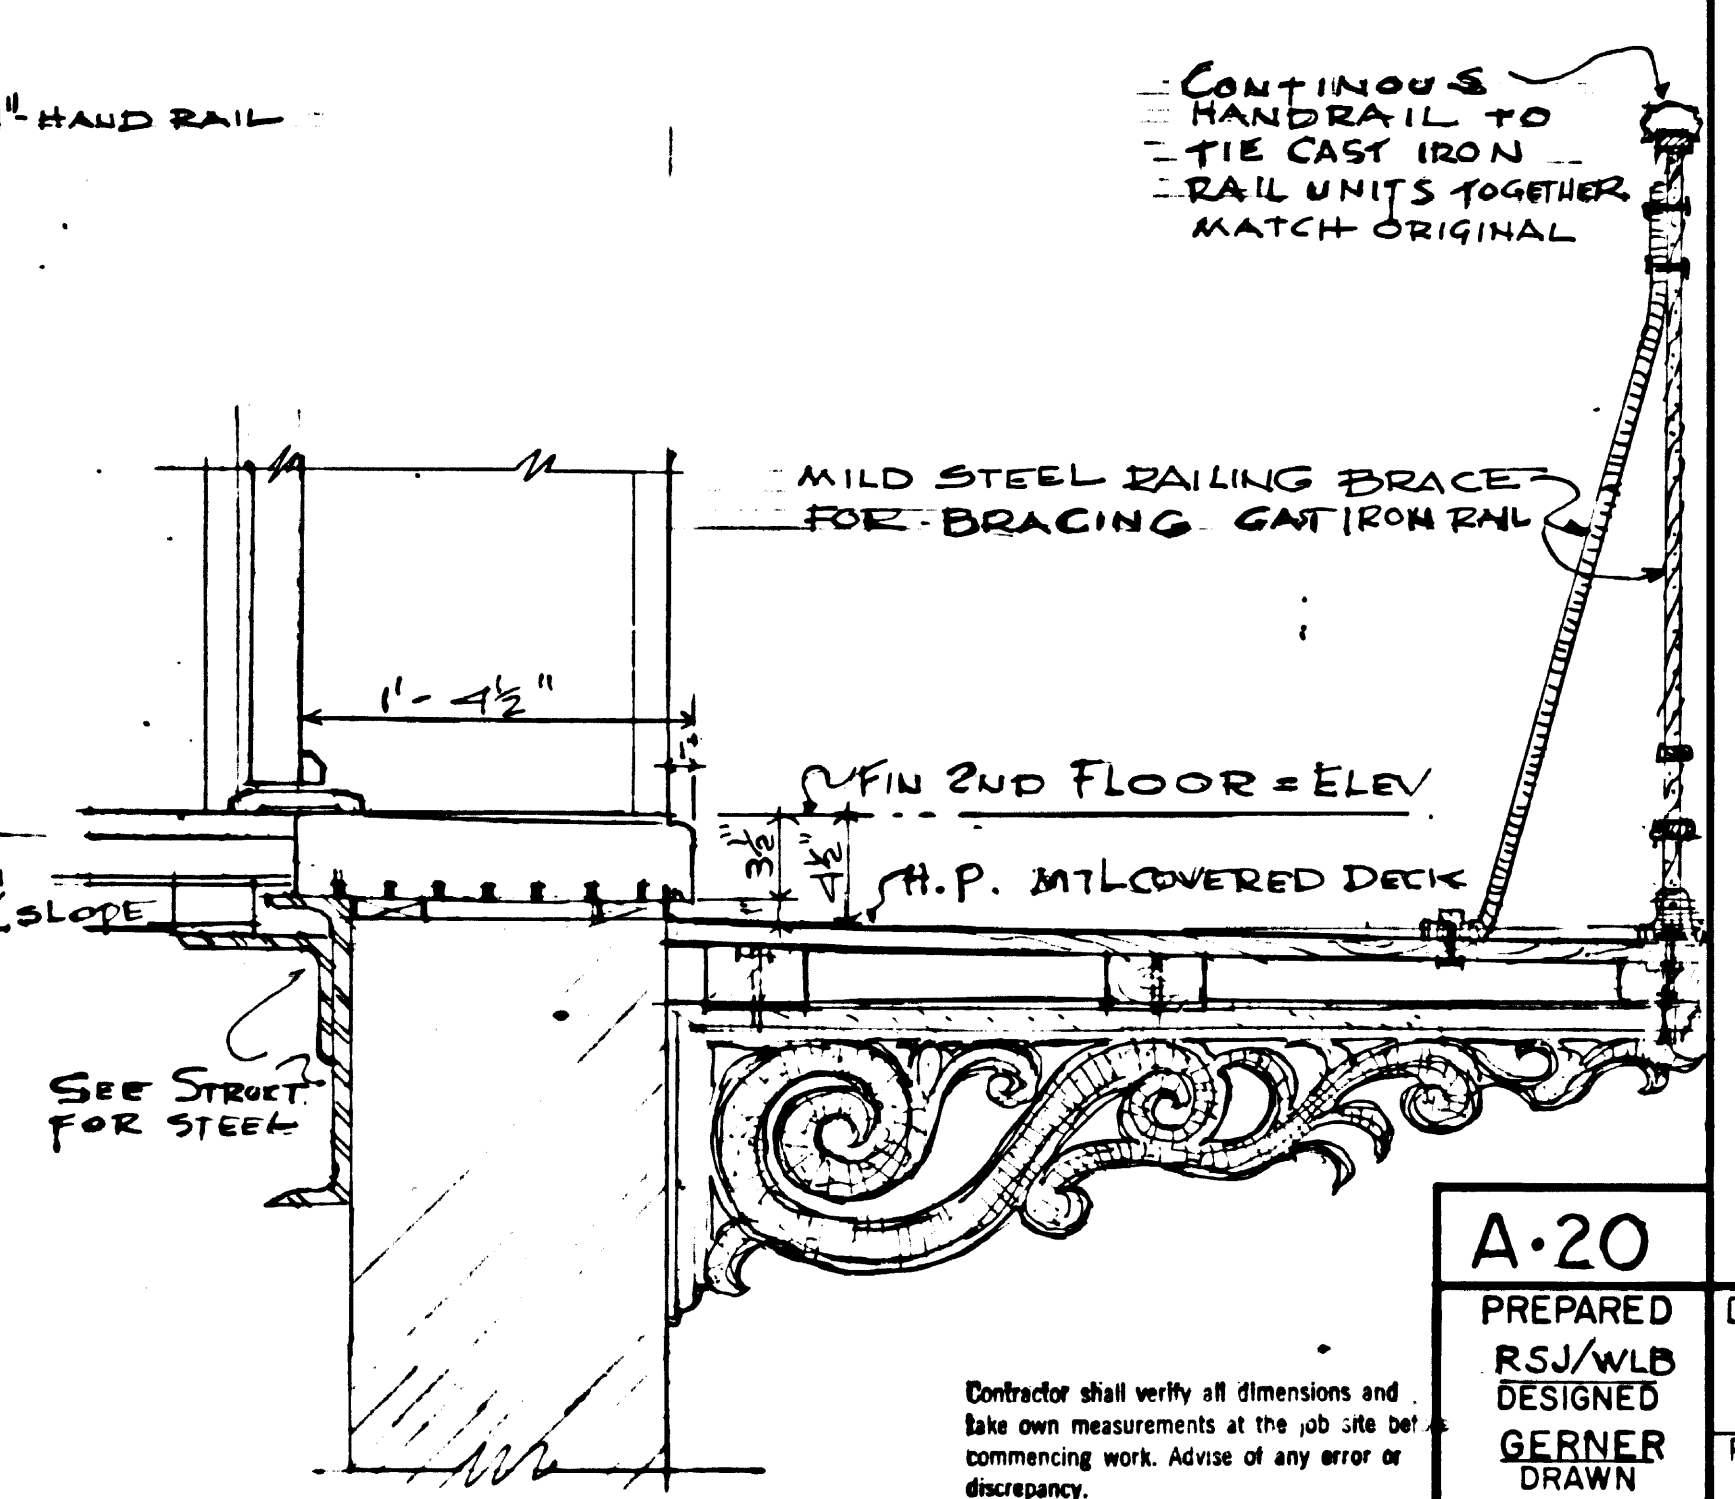


7 SECT THRU DOOR SILL AT BALCONY
SCALE = 1/2" = 1'-0"

PHASE II-A
EXTERIOR RESTORATION

CAST IRON BALCONY RAILING DETAILS — BLDG. 11

SCALE: 1/2" = 1'-0"

A-20		DRAWING NO.
PREPARED	RSJ/WLB	385
DESIGNED		25,006A
DRAWN	GERNER	
CHECKED	BARLOW	
DATE	6/78	
SHEET		20
OF 65		

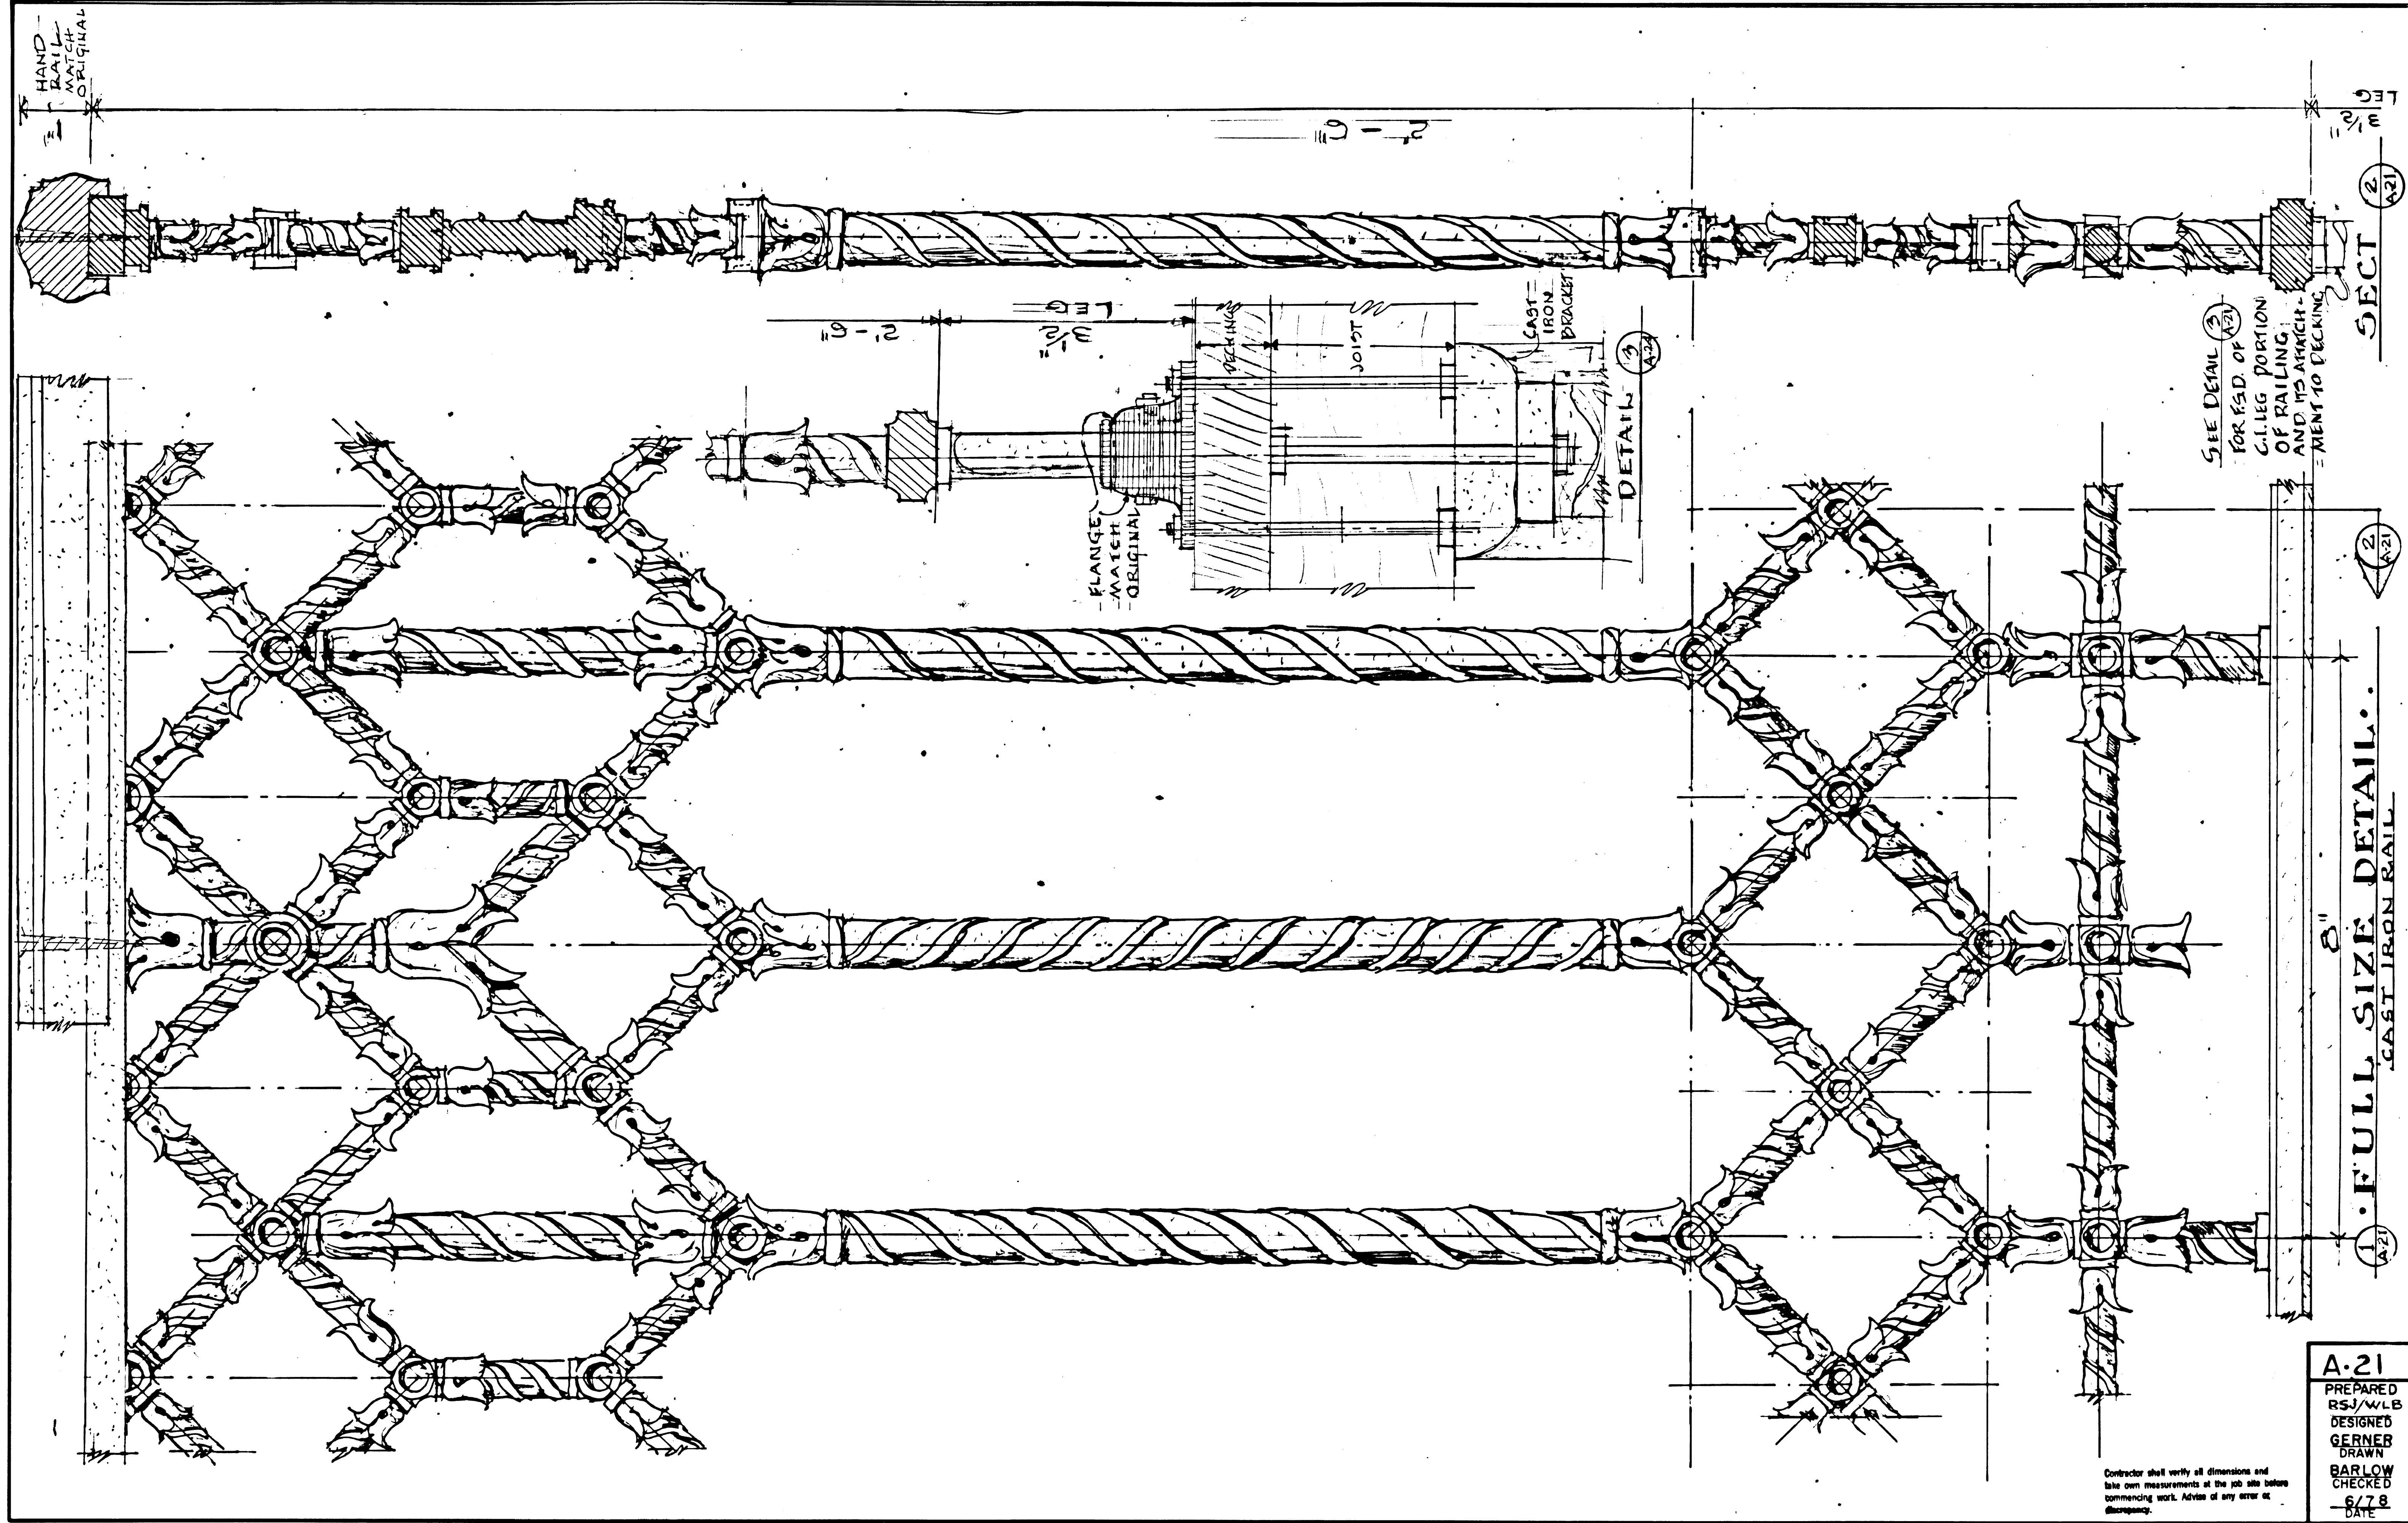

PHASE II-B RESTORATION	
BALCONY DETAILS — BUILDING 12	
SCALE : 0 2' FULL SIZE	
A-21	
PREPARED RSJ/WLB	DRAWING NO. 385
DESIGNED GERNER	25.006A
DRAWN BARLOW	PCIP PKG 110
CHECKED 6/78	SHEET 21
DATE	OF 65


Contractor shall verify all dimensions and take own measurements at the job site before commencing work. Advise of any error at discrepancy.

ROOM FINISH SCHEDULE														
BLDG	ROOM NO.	FLOOR			BASEBOARD			WALLS			CEILING			REMARKS
		MAT.	FIN.	COL.	MAT.	FIN.	COL.	MAT.	FIN.	COL.	MAT.	FIN.	COL.	
12	1	BRICK	NAT.	↑ SEE SPECIFICATIONS ↓	NONE	N/A	↑ SEE SPECIFICATIONS ↓	PLAS.	WHITE-WASH	↑ SEE SPECIFICATIONS ↓	PLAS.	WHITE WASH	↑ SEE SPECIFICATIONS ↓	THE BRICK BEARING WALL IS TO RECEIVE AN APPLICATION OF WHITE WASH ONLY
12	2	BRICK	NAT.		NONE	N/A		STONE	WHITE-WASH		PLAS.	WHITE WASH		
12	101	1 1/2" T&G WD.	OIL		WD.	PAINT		PLAS.	PAINT		PLAS.	PAINT		
12	102	1 1/2" T&G WD.	OIL		WD.	PAINT		PLAS.	PAINT		PLAS.	PAINT		
12	103	1 1/2" T&G WD.	OIL		WD.	PAINT		PLAS.	PAINT		PLAS.	PAINT		
12	104	1 1/2" T&G WD.	OIL		WD.	PAINT		PLAS.	PAINT		PLAS.	PAINT		
12	105	1 1/2" T&G WD.	OIL		WD.	PAINT		PLAS.	PAINT		PLAS.	PAINT		
12	201	EXIST. 1" T&G	PAINT		WD.	PAINT		PLAS.	PAINT		PLAS.	PAINT		
12	202	EXIST. 1" T&G	PAINT		WD.	PAINT		PLAS.	PAINT		PLAS.	PAINT		
12	203	EXIST. 1" T&G	PAINT		WD.	PAINT		PLAS.	PAINT		PLAS.	PAINT		
12	204	EXIST. 1" T&G	PAINT		WD.	PAINT		PLAS.	PAINT		PLAS.	PAINT		
12	301	EXIST. 1" T&G	PAINT		WD.	PAINT		PLAS.	PAINT		PLAS.	PAINT		
12	302	EXIST. 1" T&G	PAINT		WD.	PAINT		PLAS.	PAINT		PLAS.	PAINT		
12	303	EXIST. 1" T&G	PAINT		WD.	PAINT		PLAS.	PAINT		PLAS.	PAINT		
12	304	EXIST. 1" T&G	PAINT		WD.	PAINT		PLAS.	PAINT		PLAS.	PAINT		
12	305	EXIST. 1" T&G	PAINT	WD.	PAINT	PLAS.	PAINT	PLAS.	PAINT					
12	401	EXIST. 1" T&G	PAINT	WD.	PAINT	PLAS.	PAINT	PLAS.	PAINT					
12	402	EXIST. 1" T&G	PAINT	WD.	PAINT	PLAS.	PAINT	PLAS.	PAINT					
12	403	EXIST. 1" T&G	PAINT	WD.	PAINT	PLAS.	PAINT	PLAS.	PAINT					
12	404	EXIST. 1" T&G	PAINT	WD.	PAINT	PLAS.	PAINT	PLAS.	PAINT					
12	405	EXIST. 1" T&G	PAINT	WD.	PAINT	PLAS.	PAINT	PLAS.	PAINT					
12A	1	BRICK	NAT.		NONE	N/A		STONE	WHITE-WASH		EXPOSED FRAME	WHITE WASH	THE NEW PARTITION WILL BE PLASTER WITH WHITEWASH	
12A	2	BRICK	NAT.		NONE	N/A		PLASTER	WHITE-WASH		EXPOSED FRAME	WHITE WASH	THE NEW PARTITION WILL BE PLASTER WITH WHITEWASH	
12A	3	BRICK	NAT.		NONE	N/A		STONE	WHITE-WASH		EXPOSED FRAME	WHITE WASH		
12A	101	EXIST. 1" T&G	PAINT		WD.	PAINT		PLAS.	PAINT		PLAS.	PAINT		
12A	102	EXIST. 1" T&G	PAINT		WD.	PAINT		PLAS.	PAINT		PLAS.	PAINT		
12A	103	EXIST. 1" T&G	PAINT		WD.	PAINT		PLAS.	PAINT		PLAS.	PAINT		
12A	201	EXIST. 1" T&G	PAINT		WD.	PAINT		PLAS.	PAINT		PLAS.	PAINT		
12A	202	EXIST. 1" T&G	PAINT		WD.	PAINT		PLAS.	PAINT		PLAS.	PAINT		
12A	203	EXIST. 1" T&G	PAINT		WD.	PAINT		PLAS.	PAINT		PLAS.	PAINT		


WINDOW & DOOR FINISH SCHEDULE															
WINDOWS								DOORS							
NO.	SASH		FRAME		SHUTTERS		REMARKS	NO.	FRAME		PANELS		RAILS & STILES		REMARKS
	FIN.	COL.	FIN.	COL.	FIN.	COL.			FIN.	COL.	F	C	F	C	
1	PAINT	↑	PAINT	↑	PAINT	↑		1	PAINT	↑	P	↑	P	↑	
2	↑		↑		↑		↑	2	↑						
3								3							
4								4							
5								5							
6								6							
7								101							
101		SEE SPECIFICATIONS		SEE SPECIFICATIONS		SEE SPECIFICATIONS		101		SEE SPECIFICATIONS		SEE SPECIFICATIONS		SEE SPECIFICATIONS	
102							102								
103							103								
104							104								
105							105								
106							107								
107							108								
108							109								
109							110								
110							111								
111		SEE SPECIFICATIONS		SEE SPECIFICATIONS		SEE SPECIFICATIONS		201		SEE SPECIFICATIONS		SEE SPECIFICATIONS		SEE SPECIFICATIONS	
112							202								
201							203								
202							204								
203							205								
204							206								
205							207								
206							208								
207							209								
208							210								
209		SEE SPECIFICATIONS		SEE SPECIFICATIONS		SEE SPECIFICATIONS		301		SEE SPECIFICATIONS		SEE SPECIFICATIONS		SEE SPECIFICATIONS	
210							302								
211							303								
212							304								
213							305								
301		SEE SPECIFICATIONS		SEE SPECIFICATIONS		SEE SPECIFICATIONS		401		SEE SPECIFICATIONS		SEE SPECIFICATIONS		SEE SPECIFICATIONS	
302							402								
303							403								
304							404	PAINT	↓						
305															
306		SEE SPECIFICATIONS		SEE SPECIFICATIONS		SEE SPECIFICATIONS				SEE SPECIFICATIONS		SEE SPECIFICATIONS		SEE SPECIFICATIONS	
307															
308															
309															
401															
402		SEE SPECIFICATIONS		SEE SPECIFICATIONS		SEE SPECIFICATIONS				SEE SPECIFICATIONS		SEE SPECIFICATIONS		SEE SPECIFICATIONS	
403															
404															
405	PAINT		↓		PAINT		↓	PAINT	↓						

© 2011 The McGraw-Hill Companies, Inc. All rights reserved. No part of this publication may be reproduced, stored in a retrieval system, or transmitted, in any form or by any means, electronic, mechanical, photocopying, recording, or by any information storage and retrieval system, without prior written permission from The McGraw-Hill Companies, Inc.


A22		PHASE II-B	
		RESTORATION	
FINISH SCHEDULES		BLDG 12 & 12A	
PREPARED GEISER DESIGNED GEISER DRAWN BARLOW CHECKED 6/78 DATE	DRAWING NO. 385 25008A PCIP PKG. SHEET 110 22 OF 65		

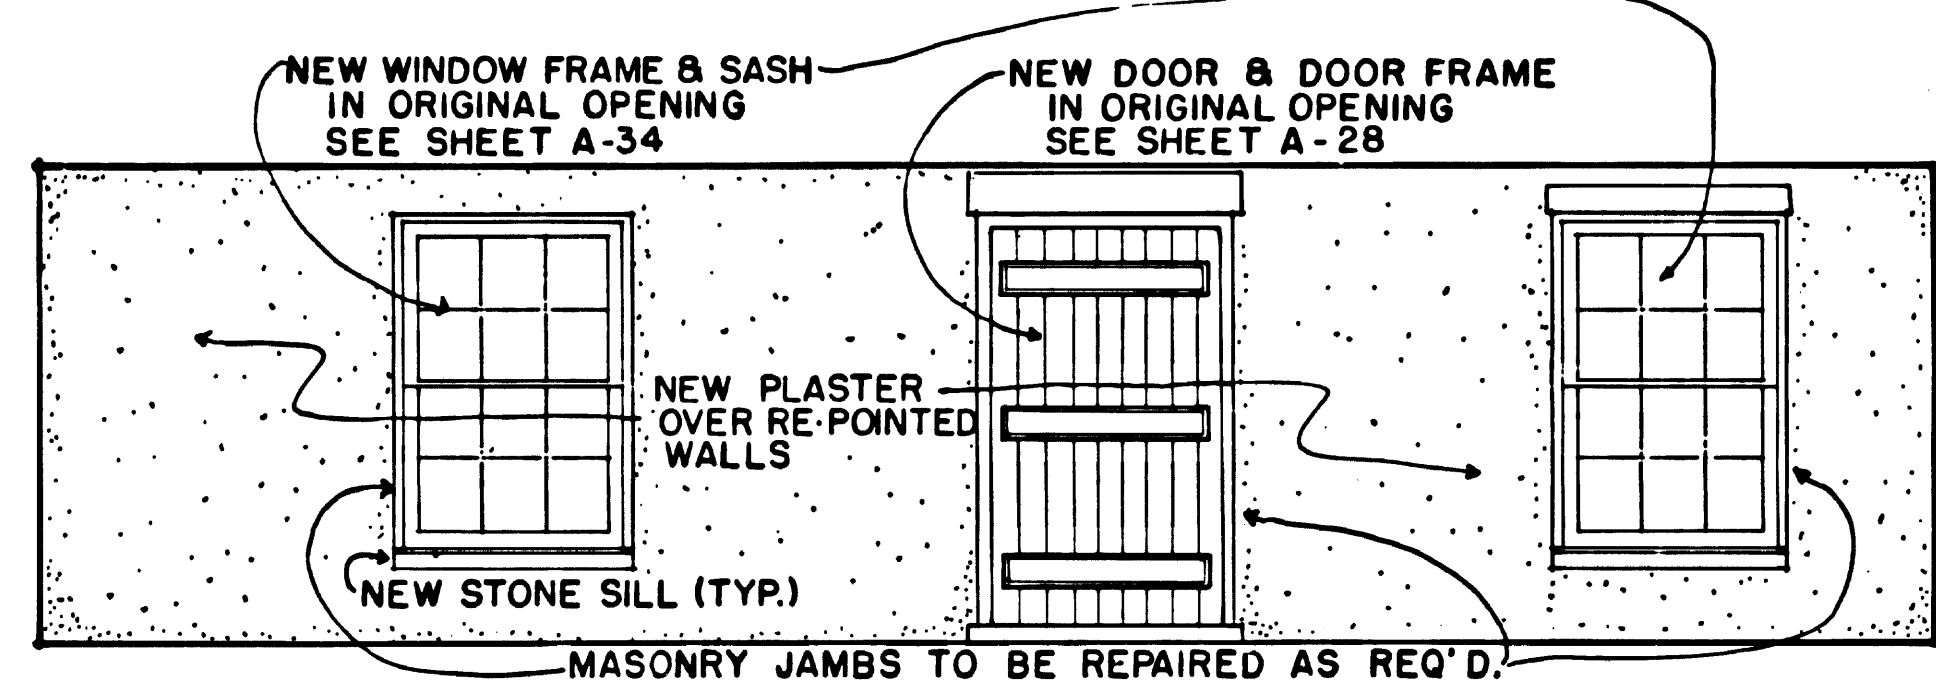


EAST 12/RM 1

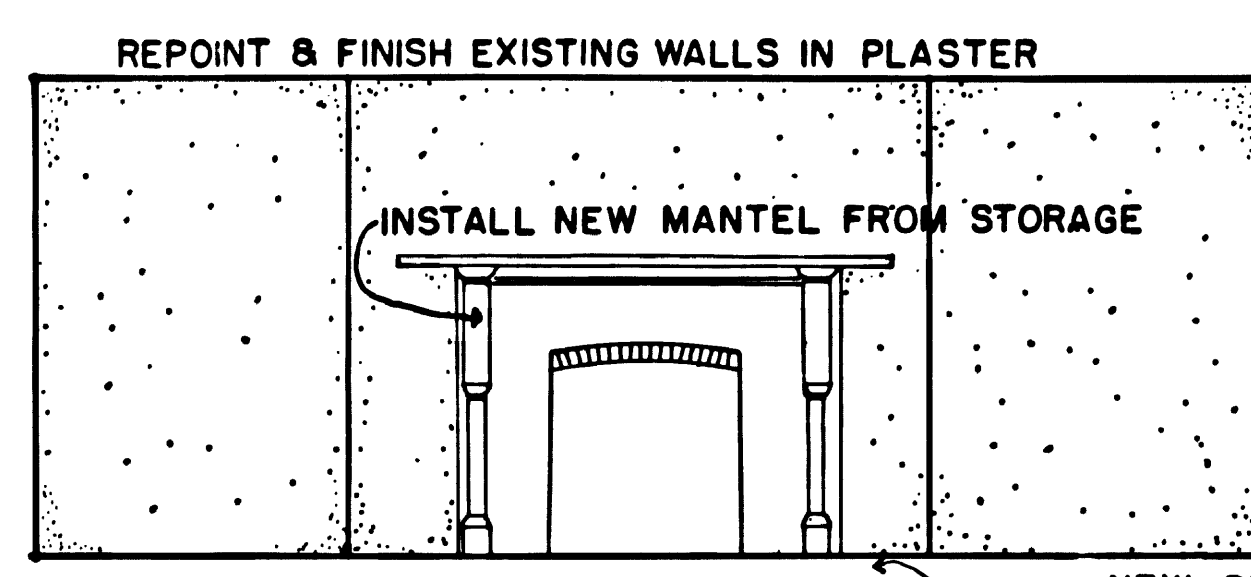


SOUTH 12/RM 1

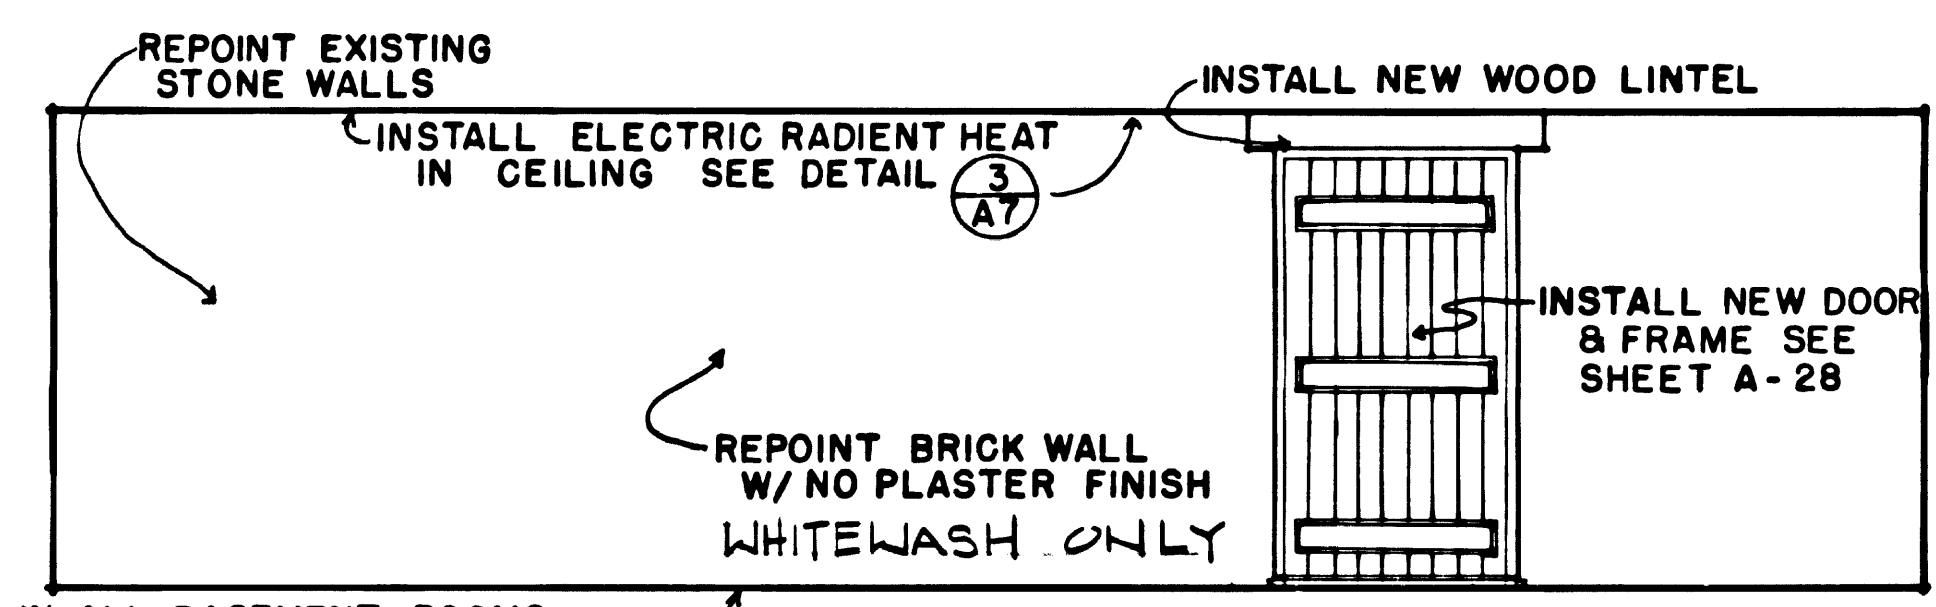


EAST 12/RM 2

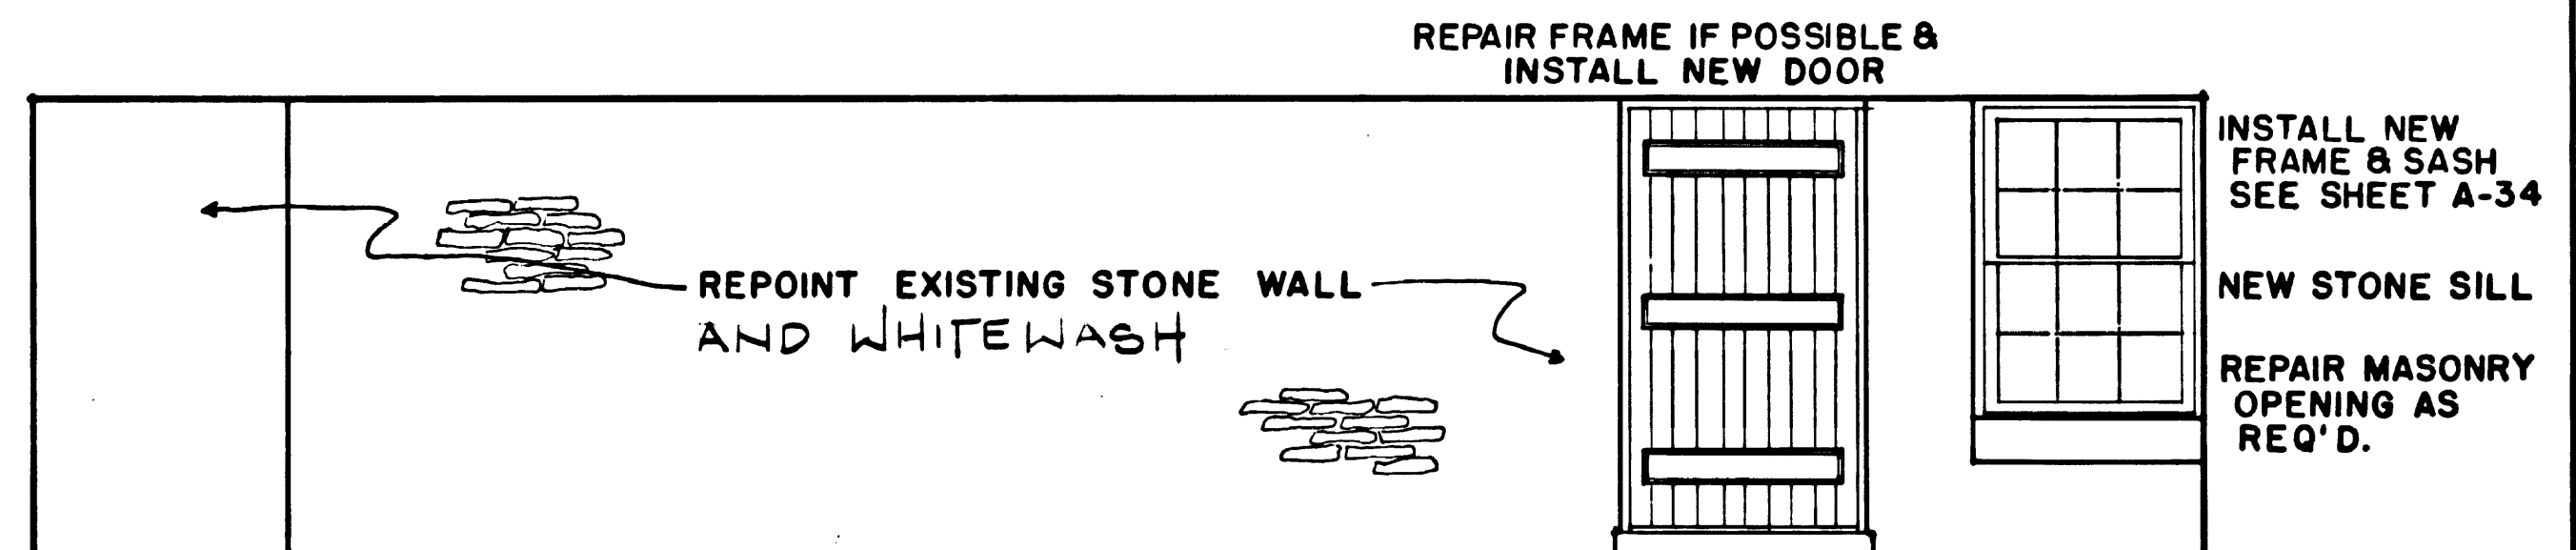


WEST 12/RM 2

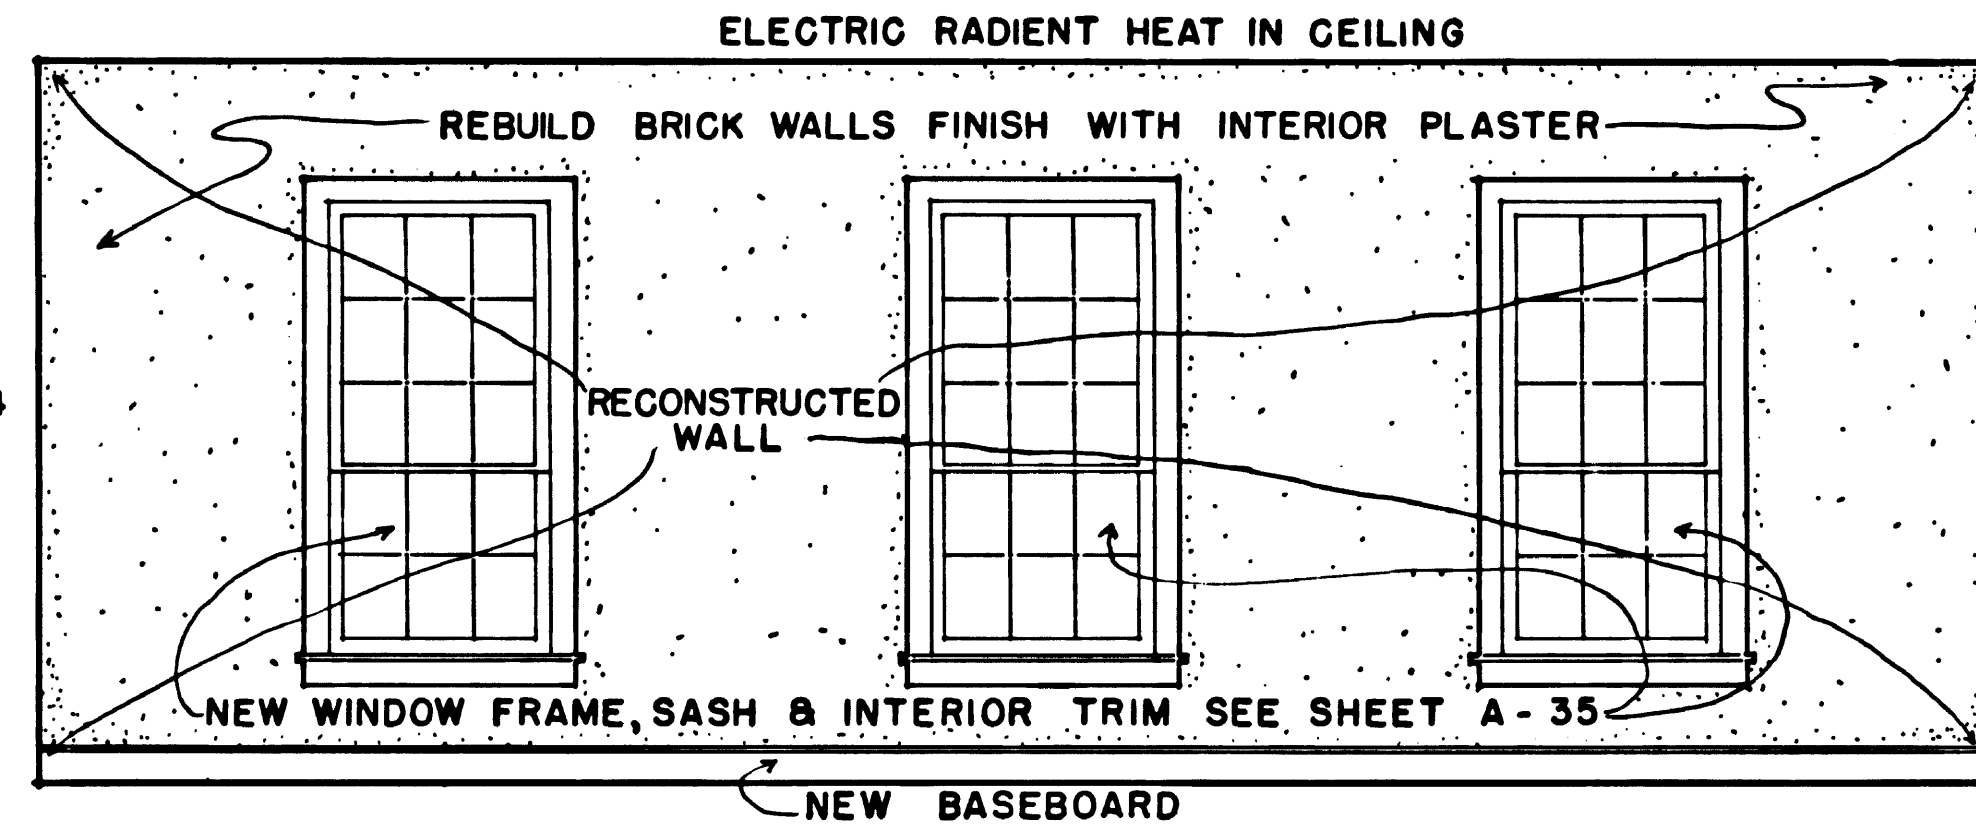


EAST 12/RM 104

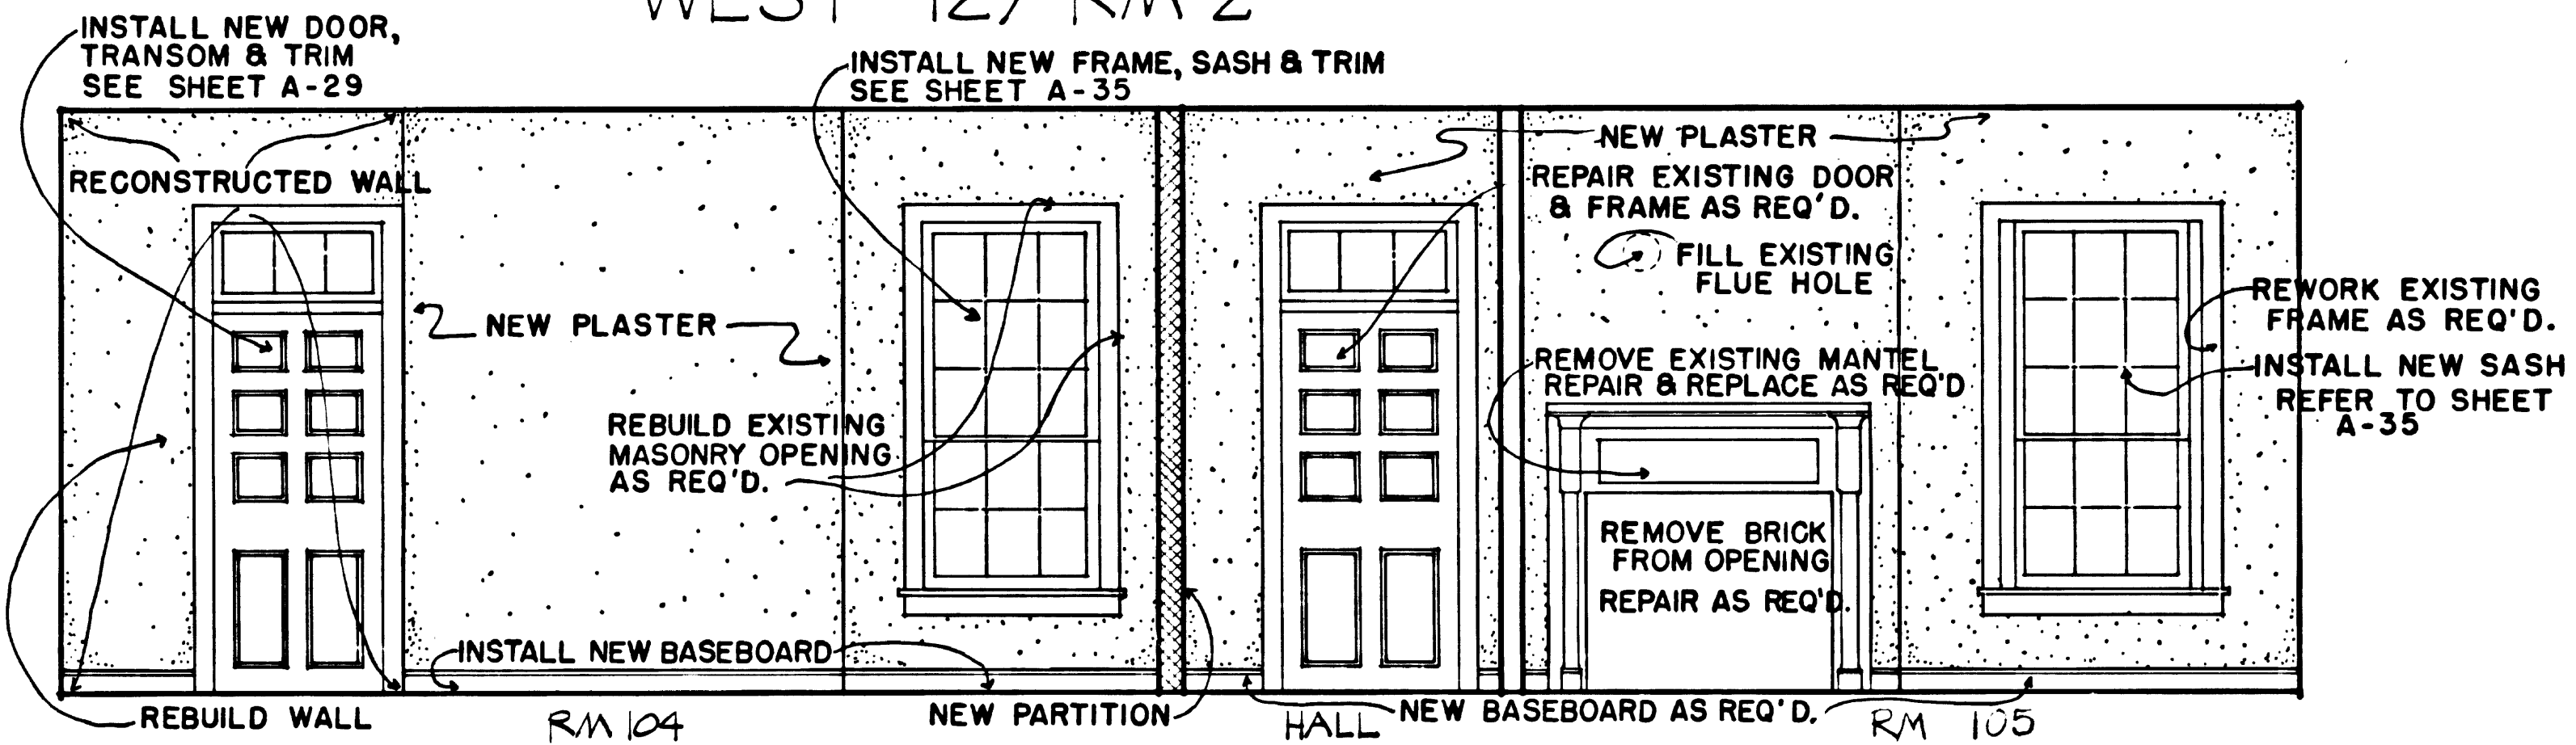


SOUTH 12/RM 104, 105

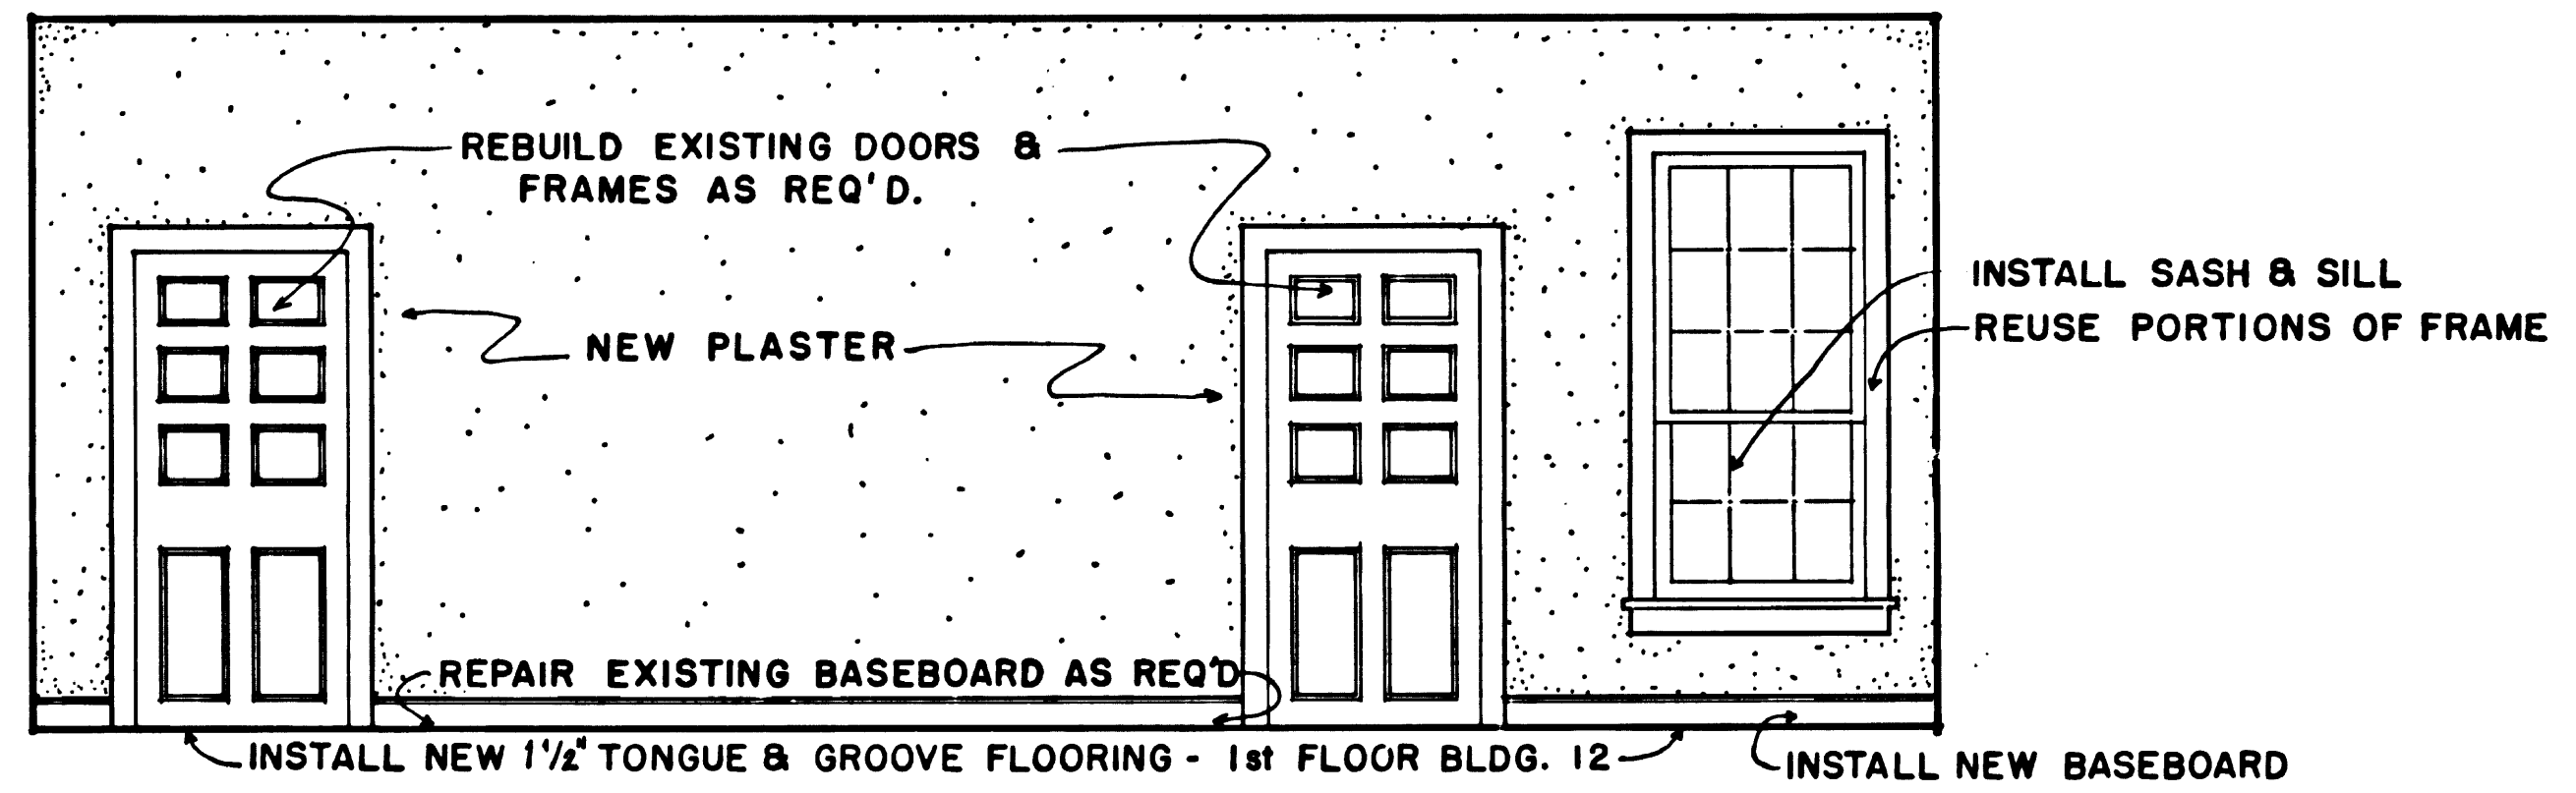


WEST 12/RM 105

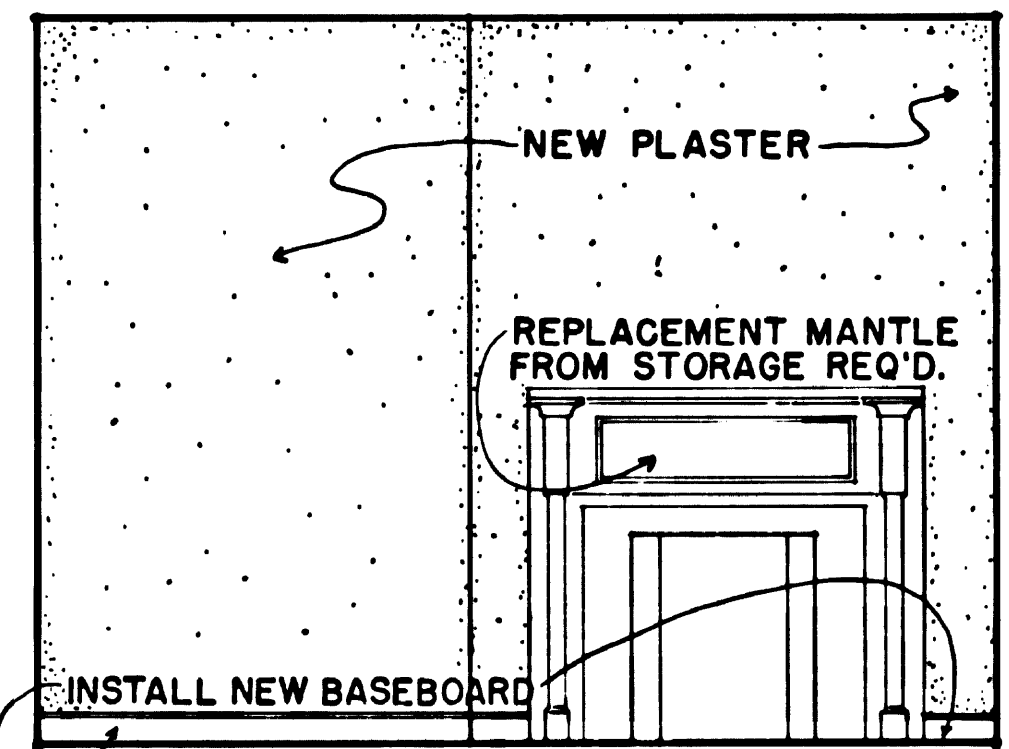

NORTH 12/RM 105

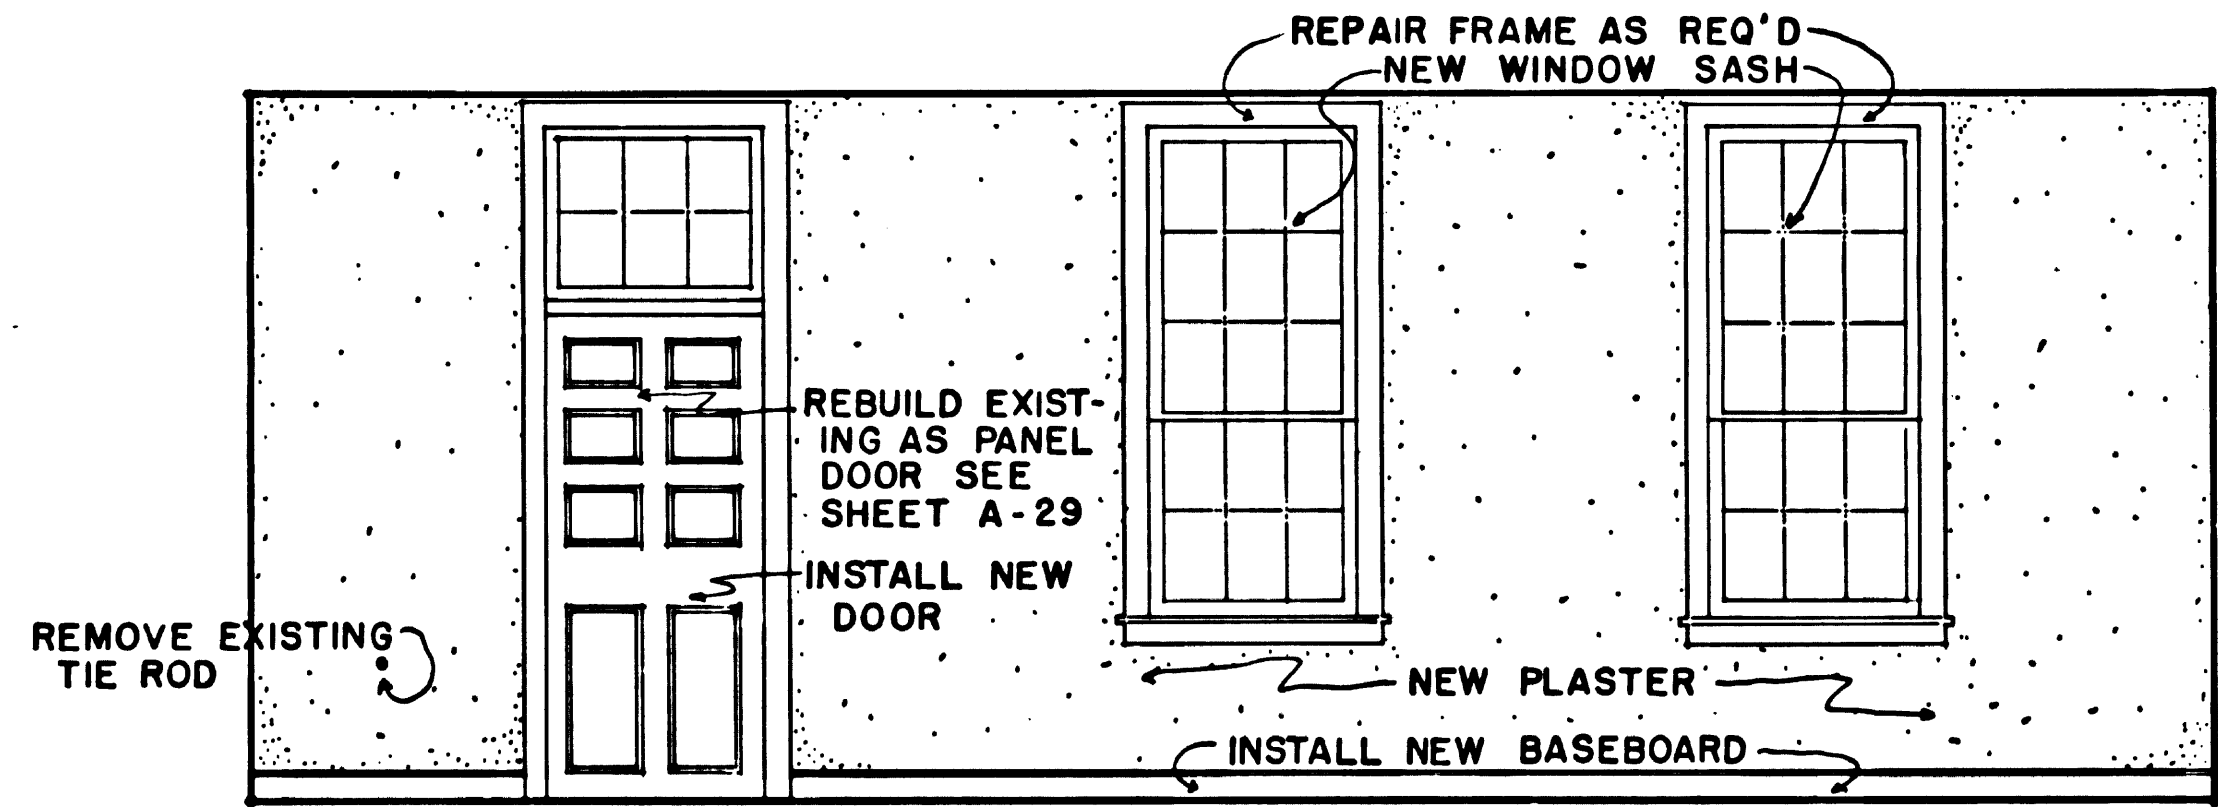

EAST 12/RM 204

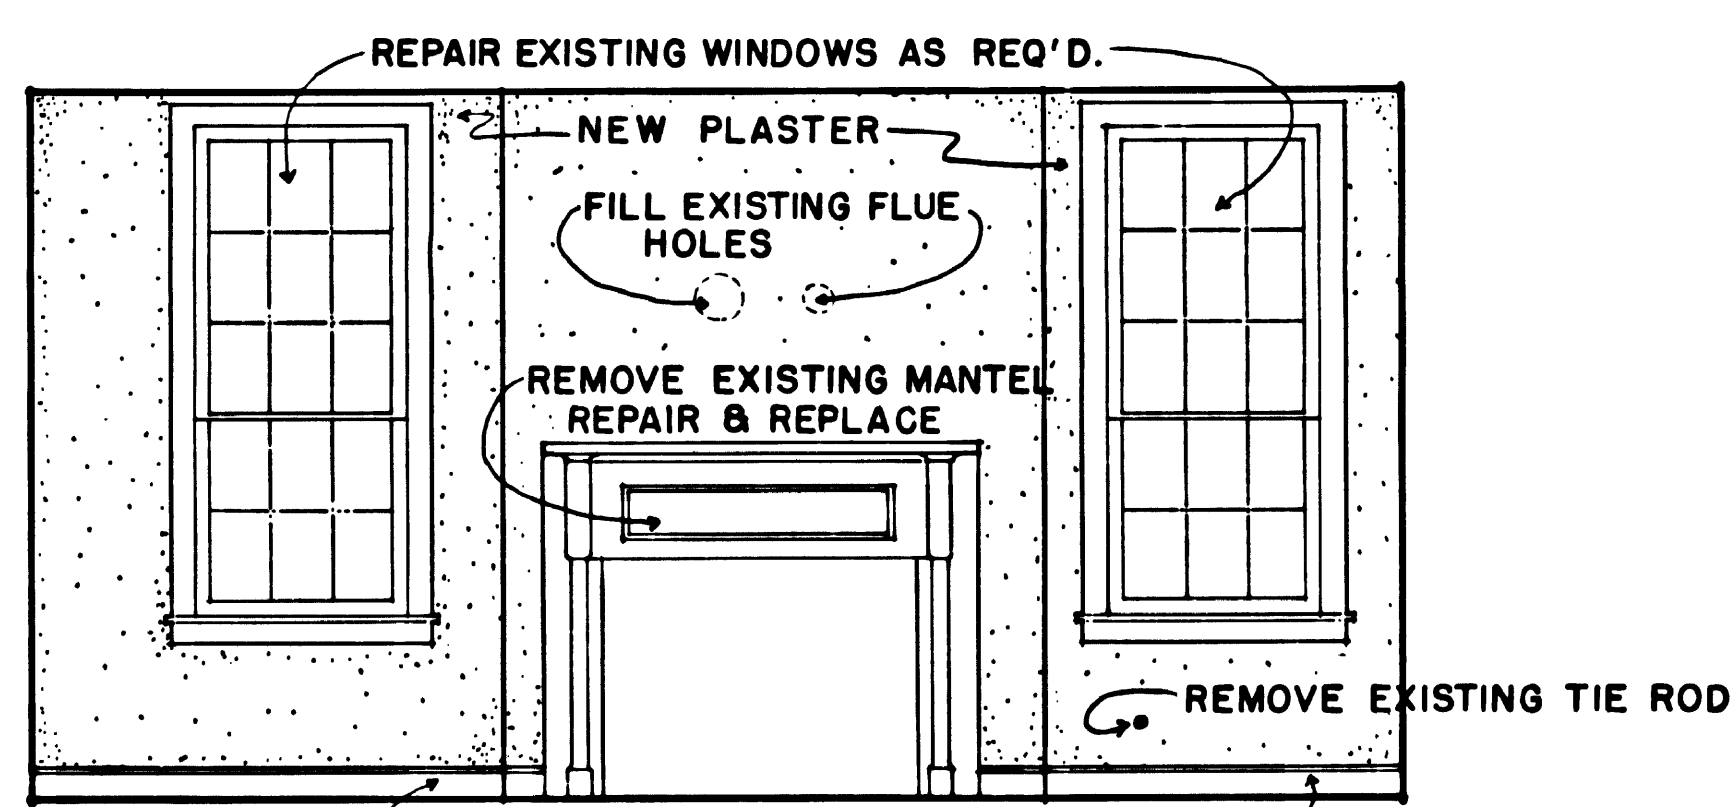

SOUTH 12/RM 204


PHASE II-B
RESTORATION

INTERIOR ELEVATIONS BLDG 12


SCALE 3/8" = 1'-0"

A23		DRAWING NO. 385	
PREPARED RSJ/WLB		DESIGNED 25006A	
DESIGNED GEISER		PCIP PKG	
DRAWN BARLOW		SHEET 23	
CHECKED 6/78		OF 65	
DATE			


Contractor shall verify all dimensions and take field measurements at the job site before commencing work. Advise of any discrepancies.

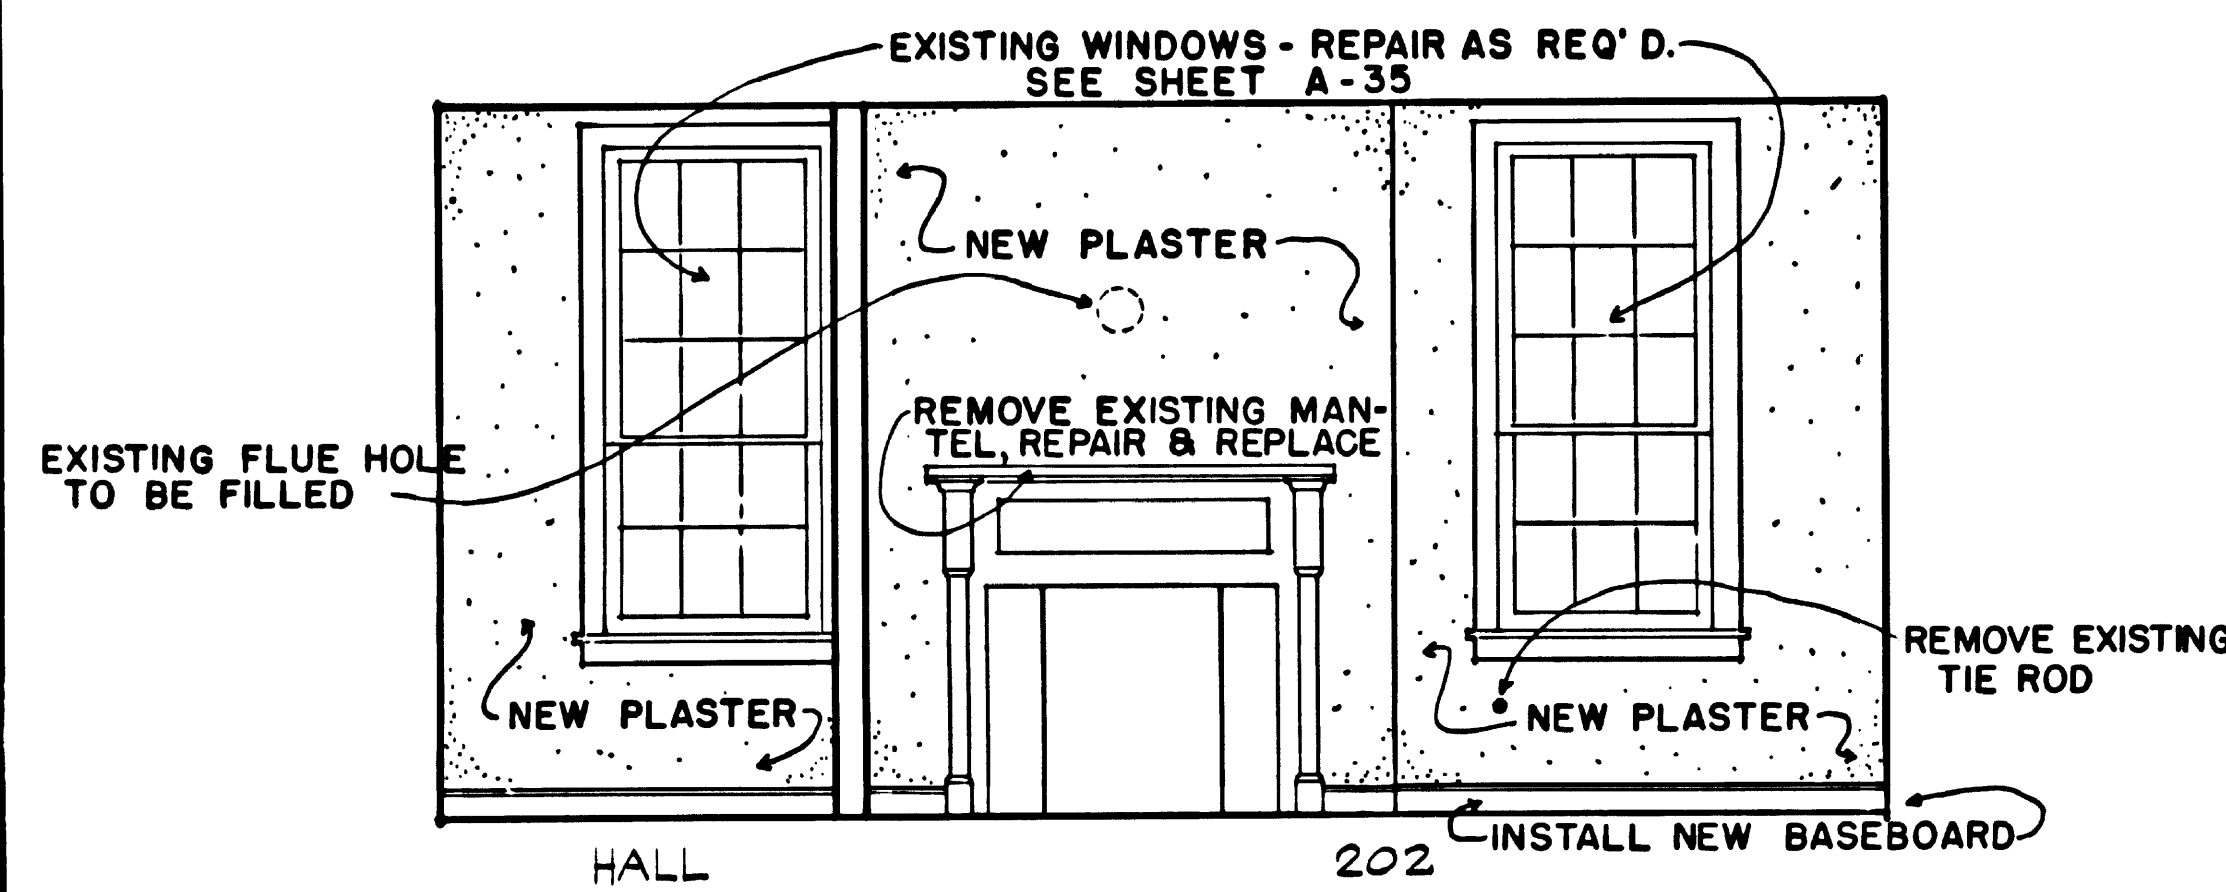


SOUTH 12/RM 201, 202

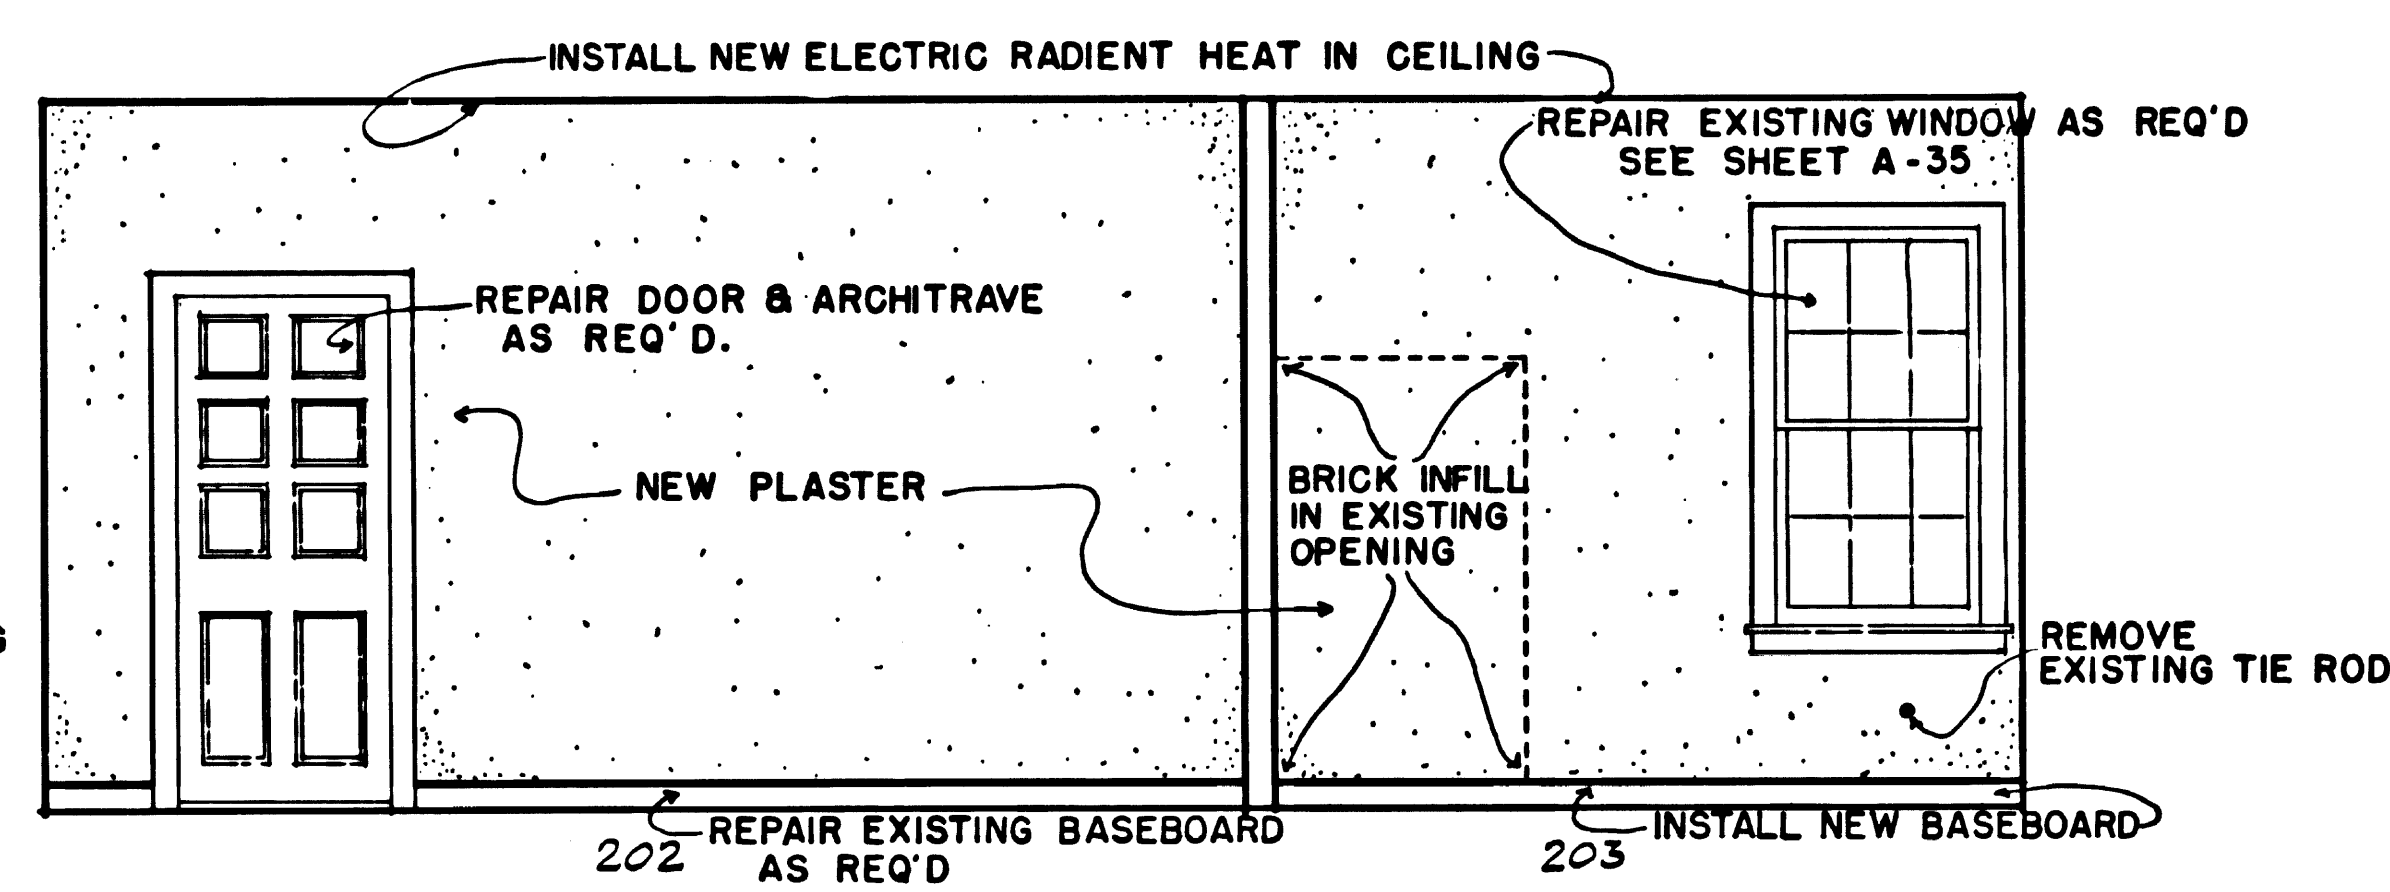


WEST 12/RM 202, 203

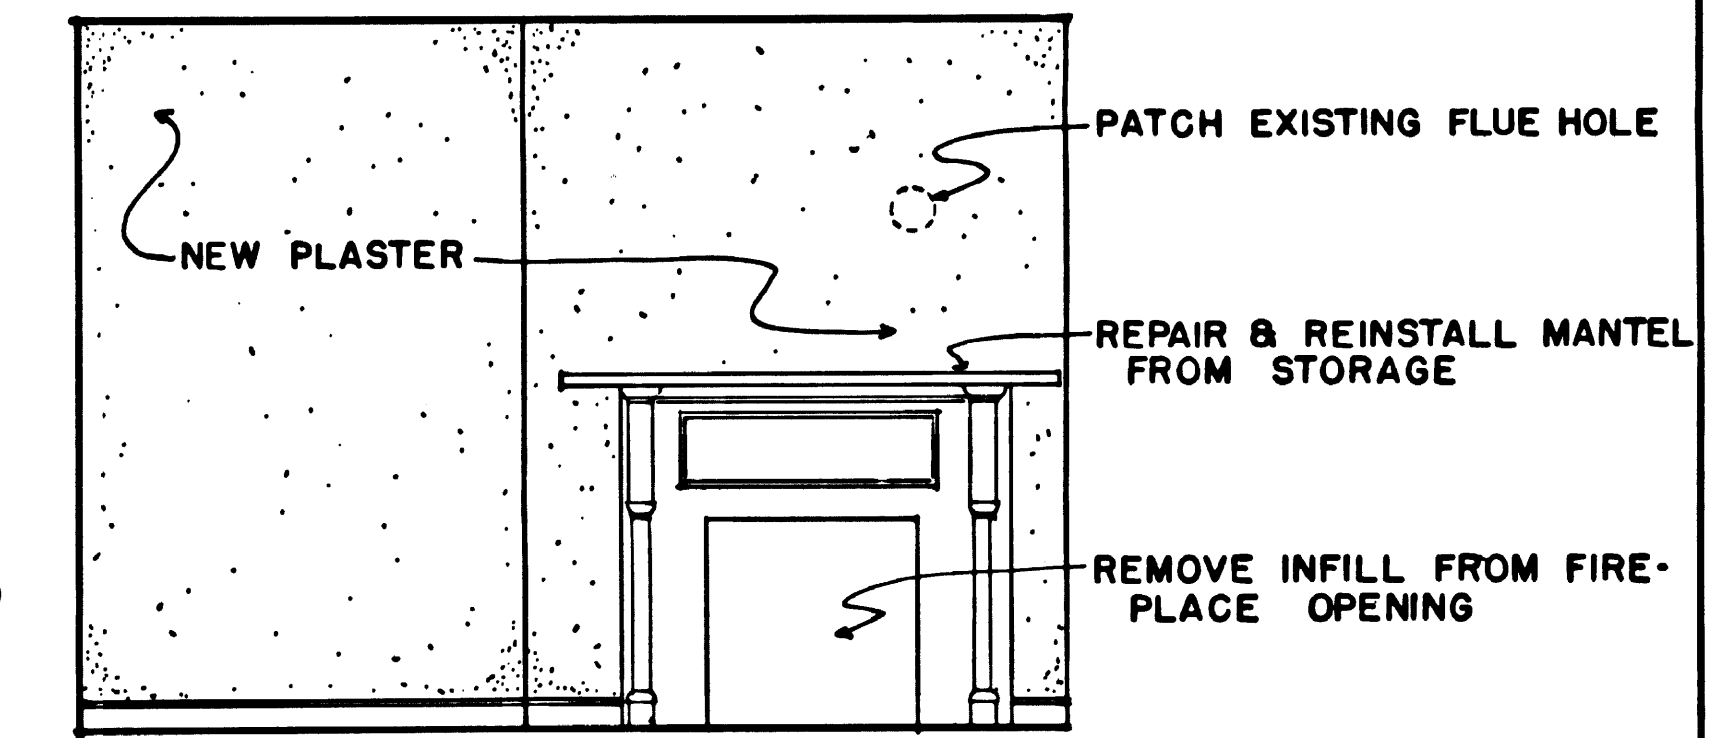


NORTH 12/RM 203

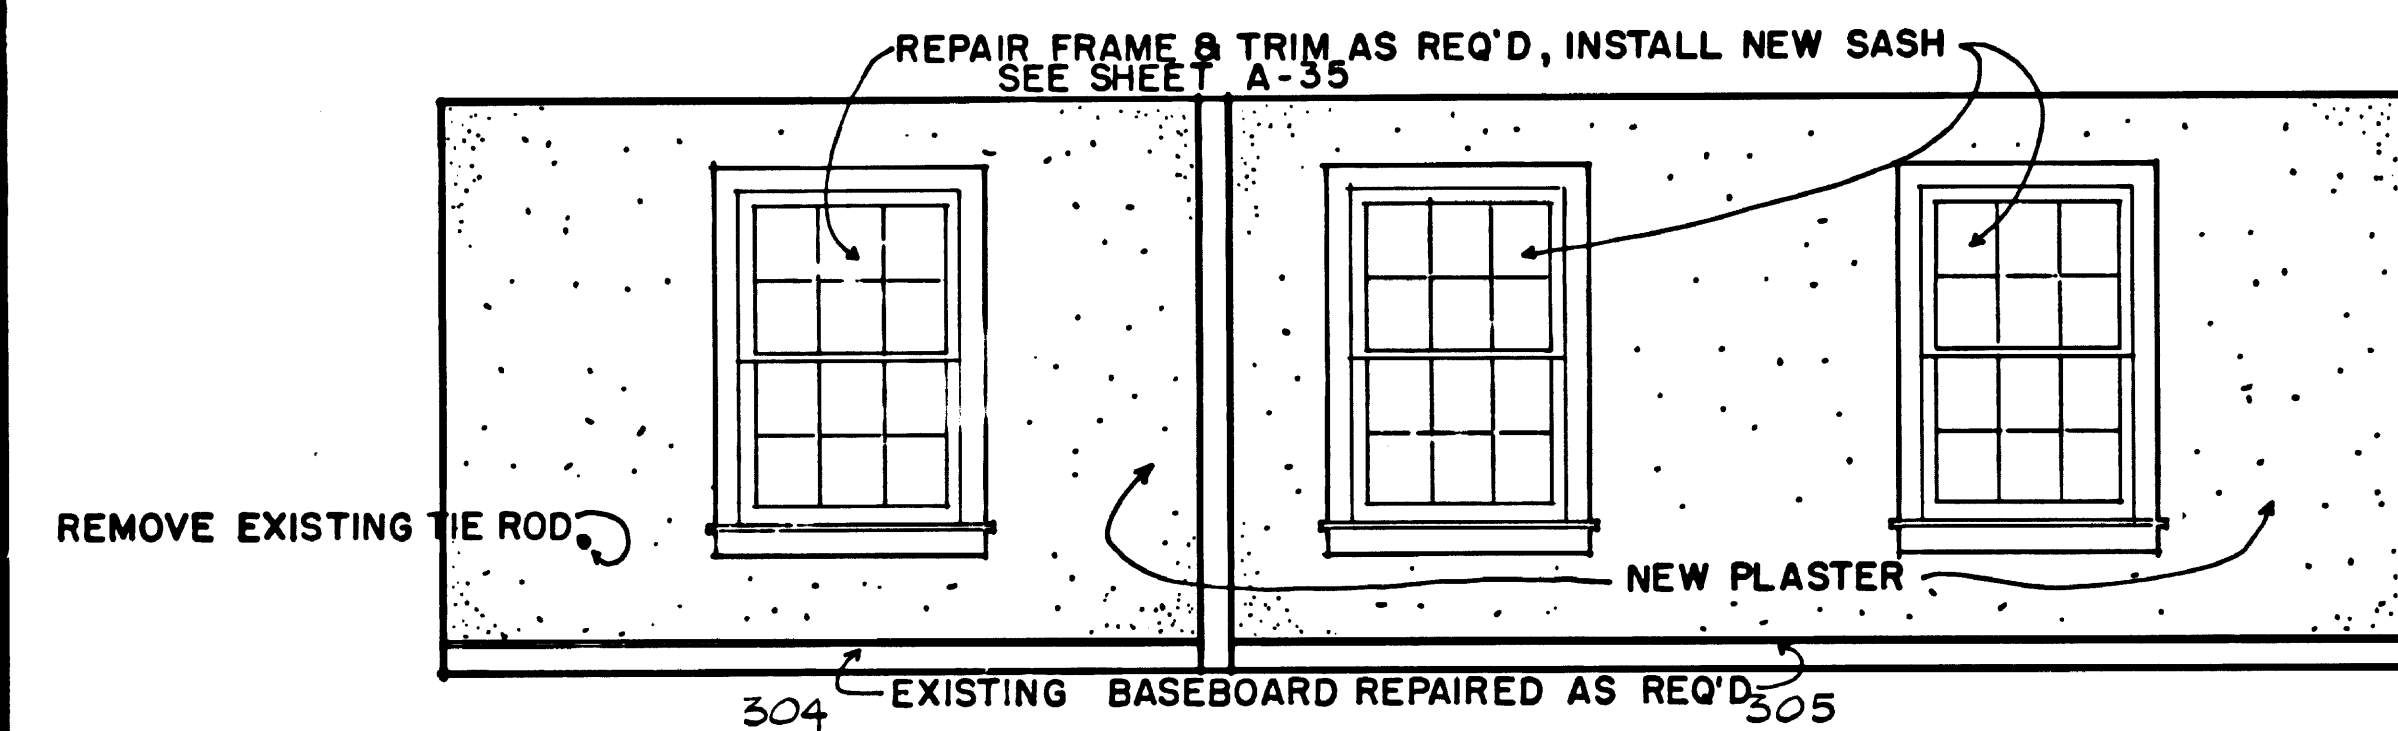


EAST 12/RM 304, 305

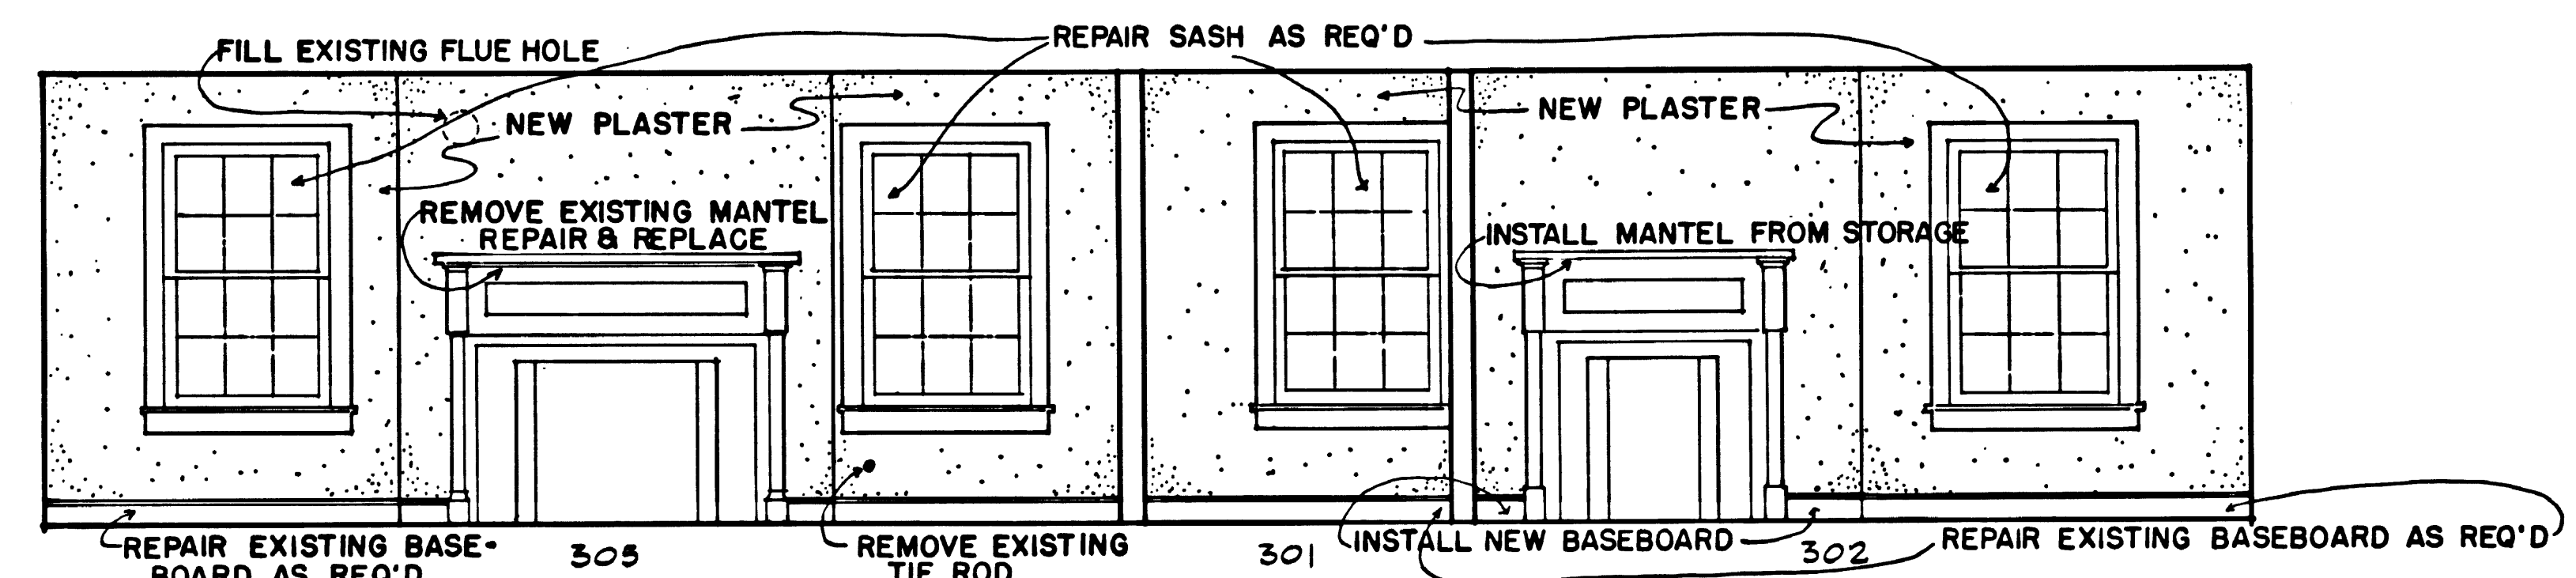


SOUTH 12/305, 301, 302

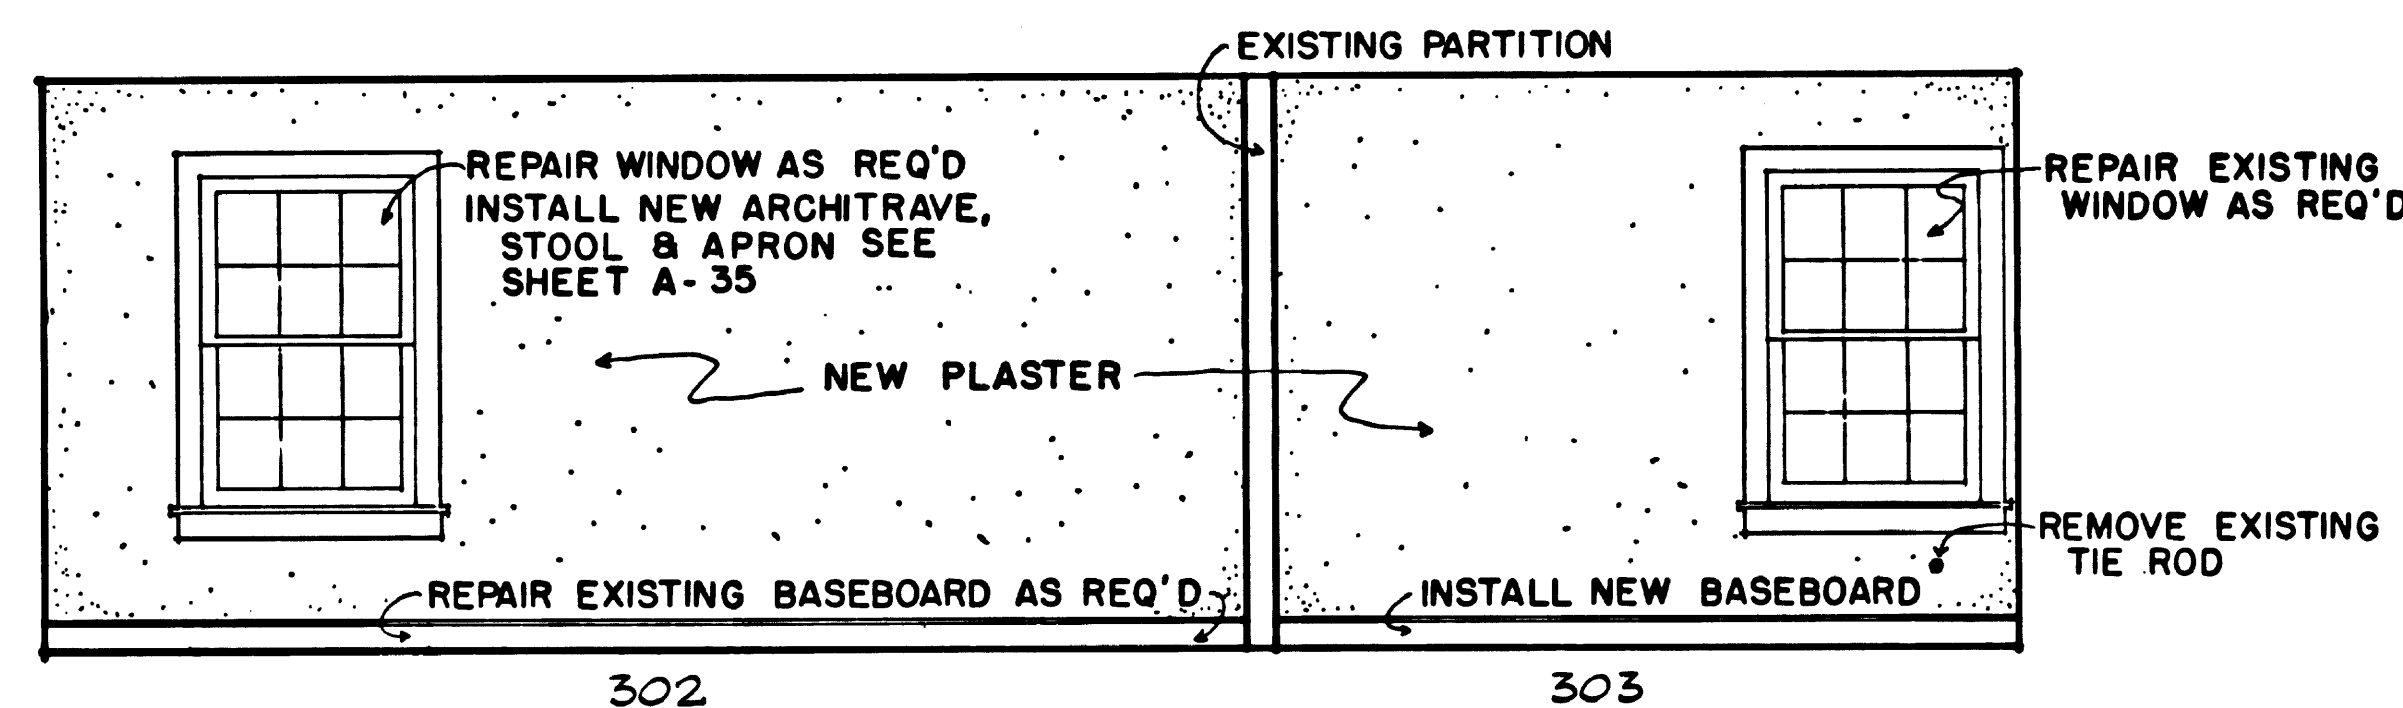

WEST 12/RM 302, 303

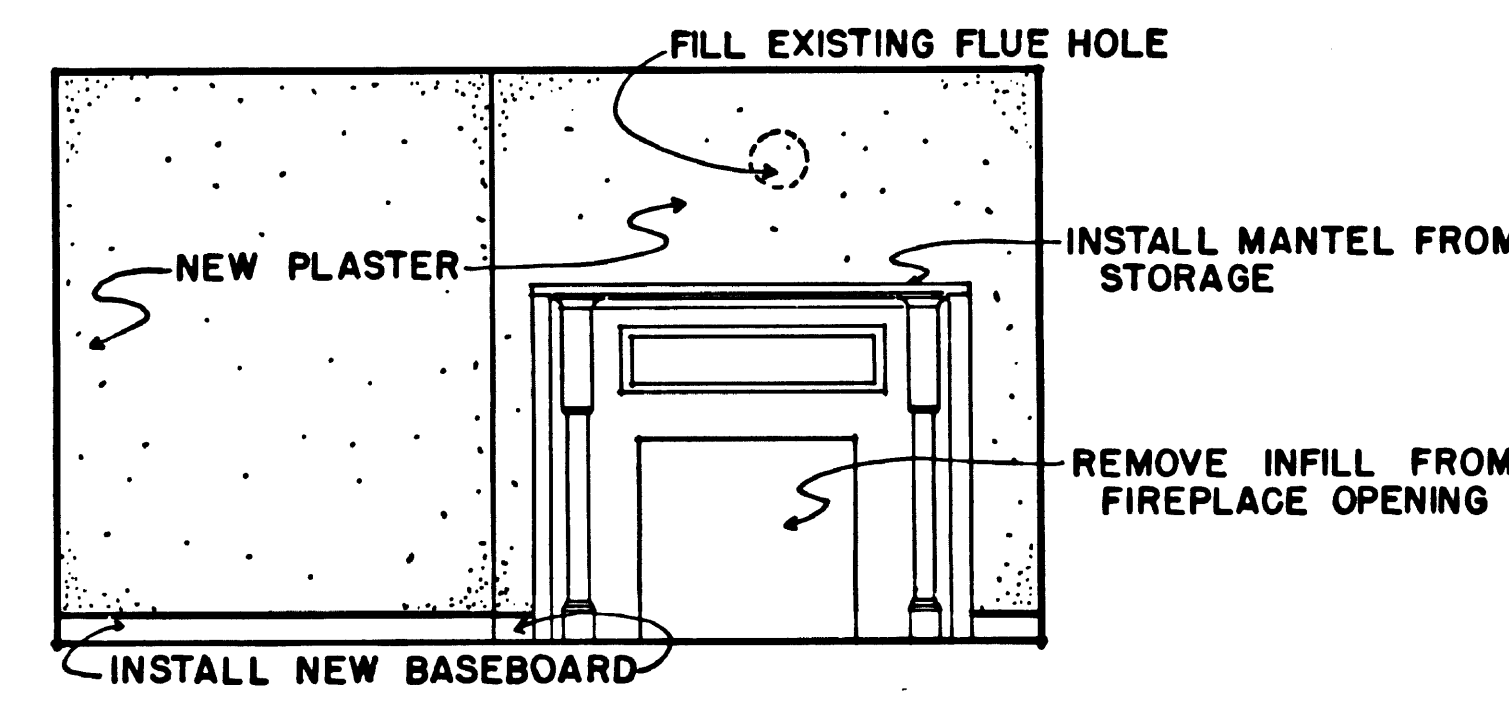

NORTH 12/RM 303

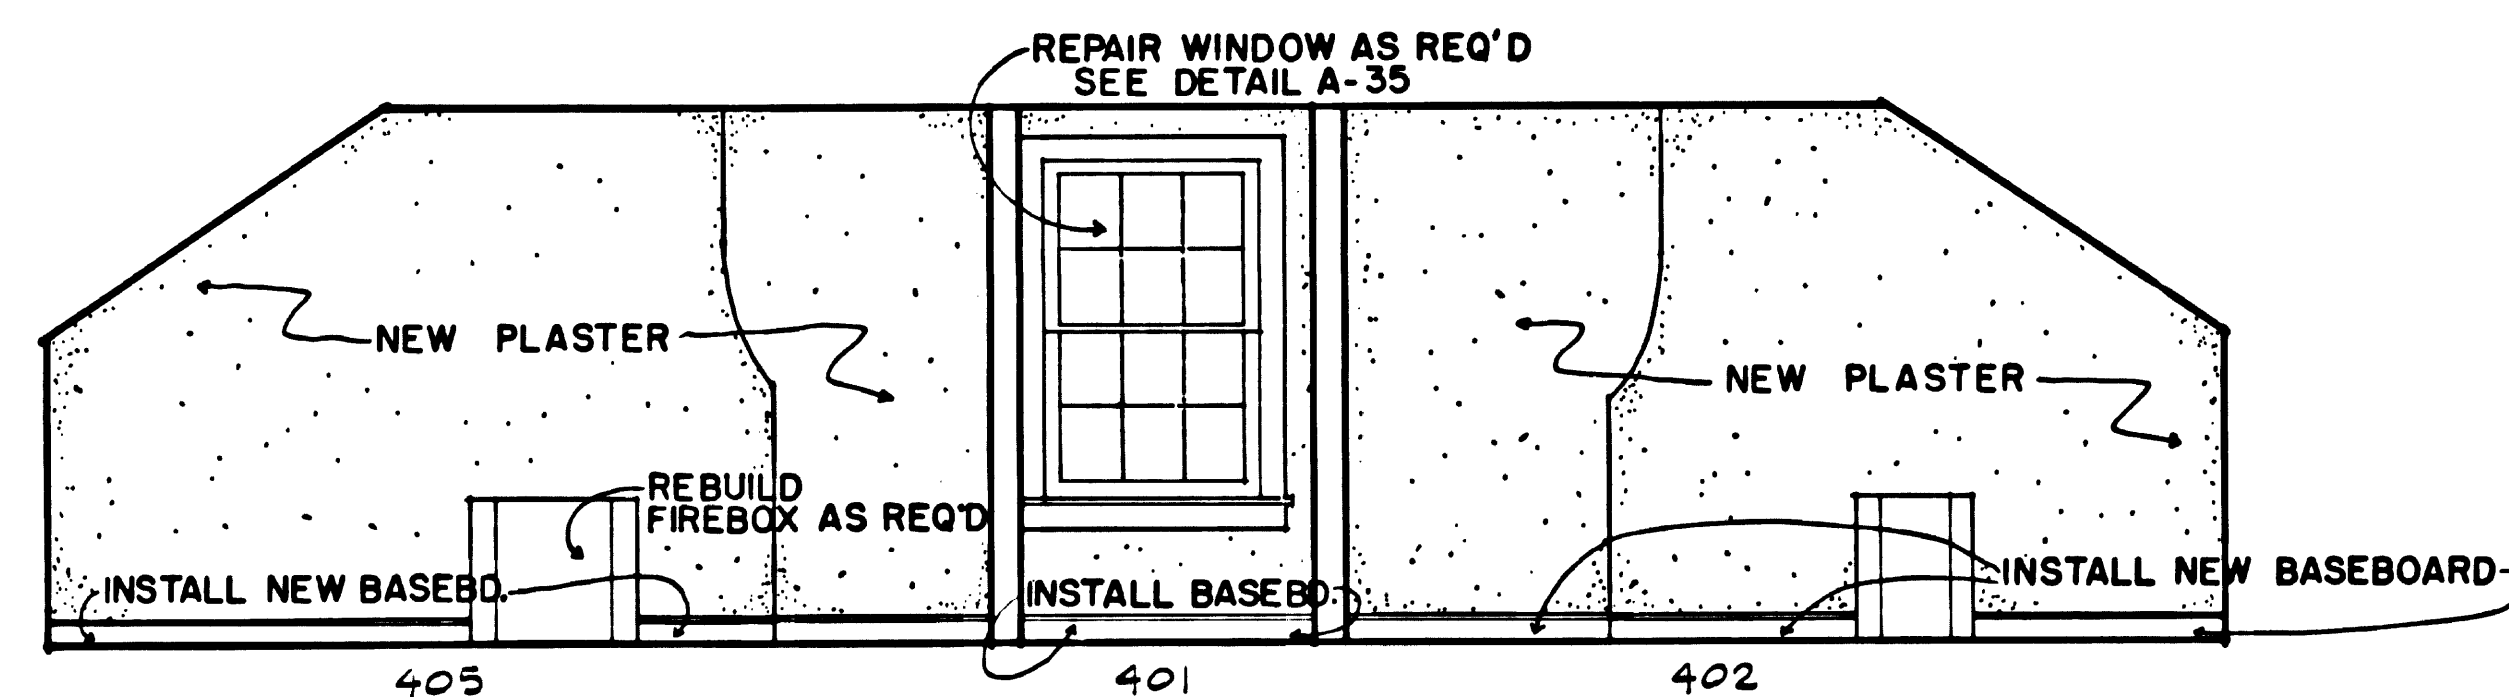

SOUTH 12/RM 405, 401, 402

NOTE: ALL INTERIOR FIREPLACES TO BE OPERABLE - REBUILD AS REQUIRED. SEE GENERAL NOTES AND FIREPLACE DETAILS: (2) (3) (4) (5) (6)

PHASE II-B
RESTORATION

INTERIOR ELEVATIONS BLDG 12


SCALE 1" = 3'-0"

A24


PREPARED
RSJ/WLB
DESIGNED
GEISER
DRAWN
BARLOW
CHECKED
6/78
DATE

DRAWING NO.
385
25006A
PCIP
PKG.
SHEET
24
OF 65


Contractor shall verify all dimensions and take own measurements at the job site before commencing work. Advise of any error or discrepancy.

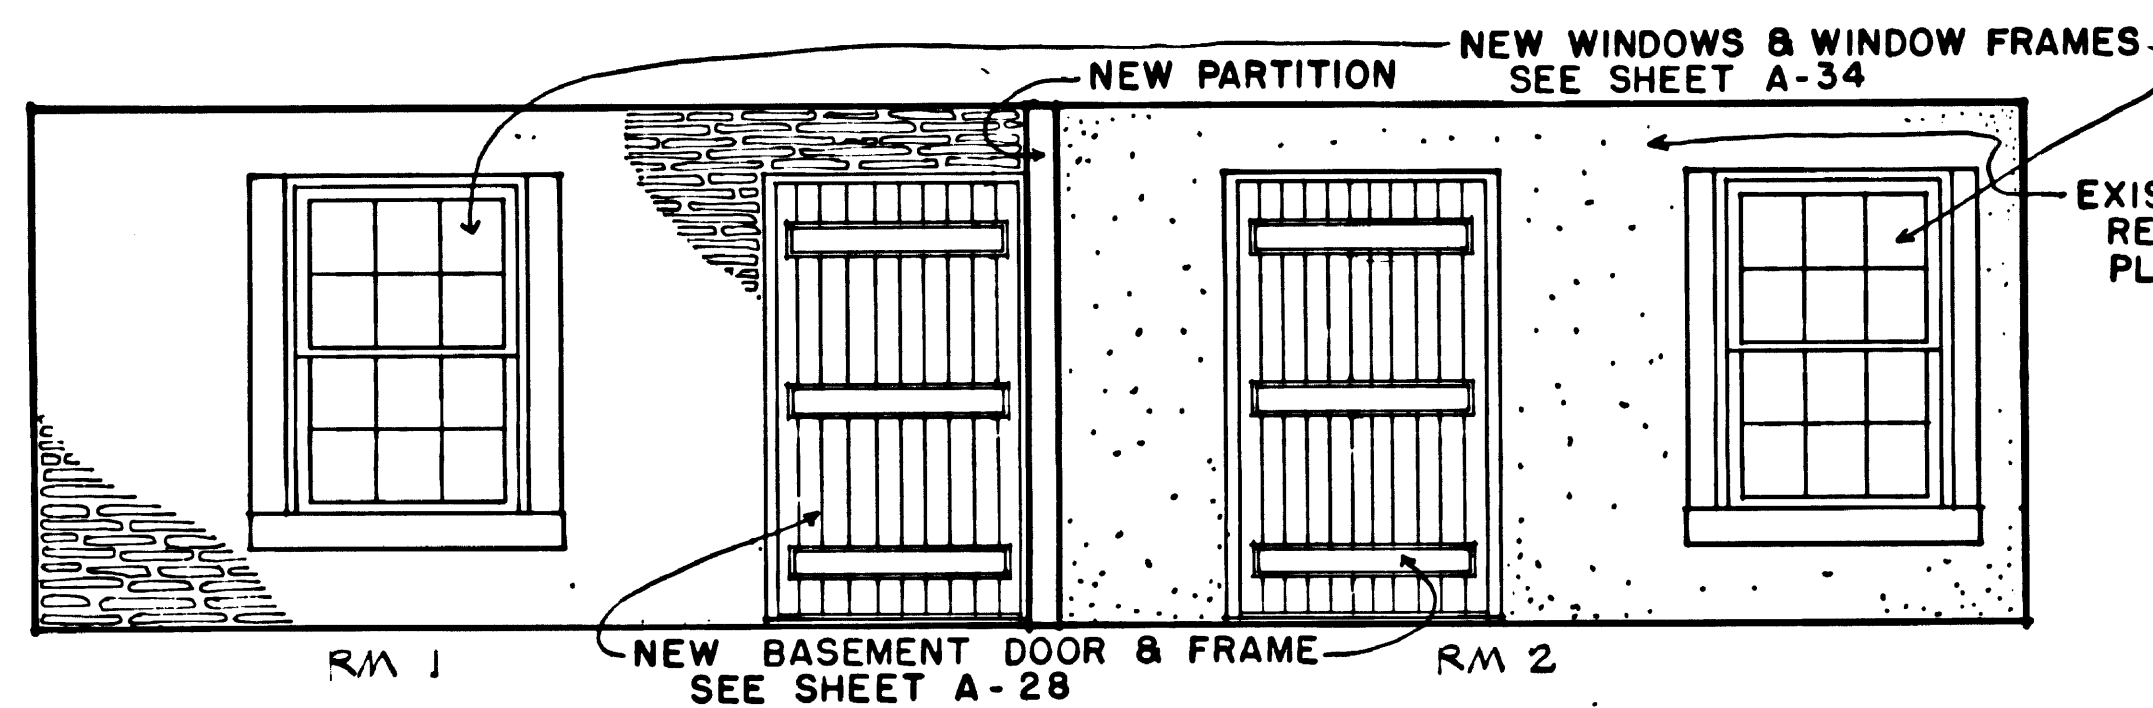


SOUTH 12A/RM 1,2

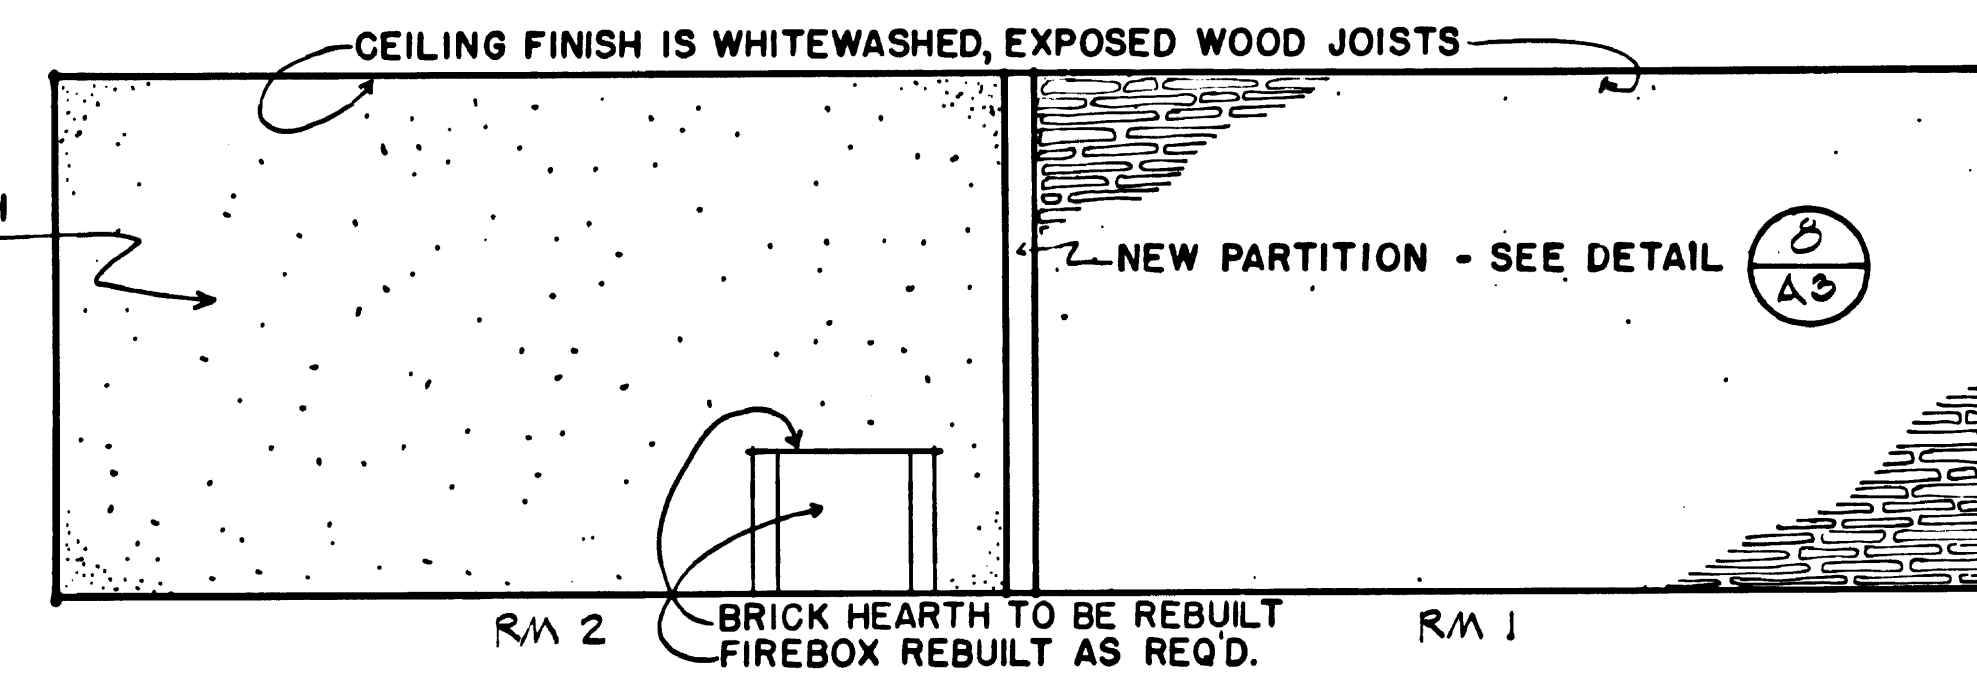


NORTH 12A/ RM 2,1

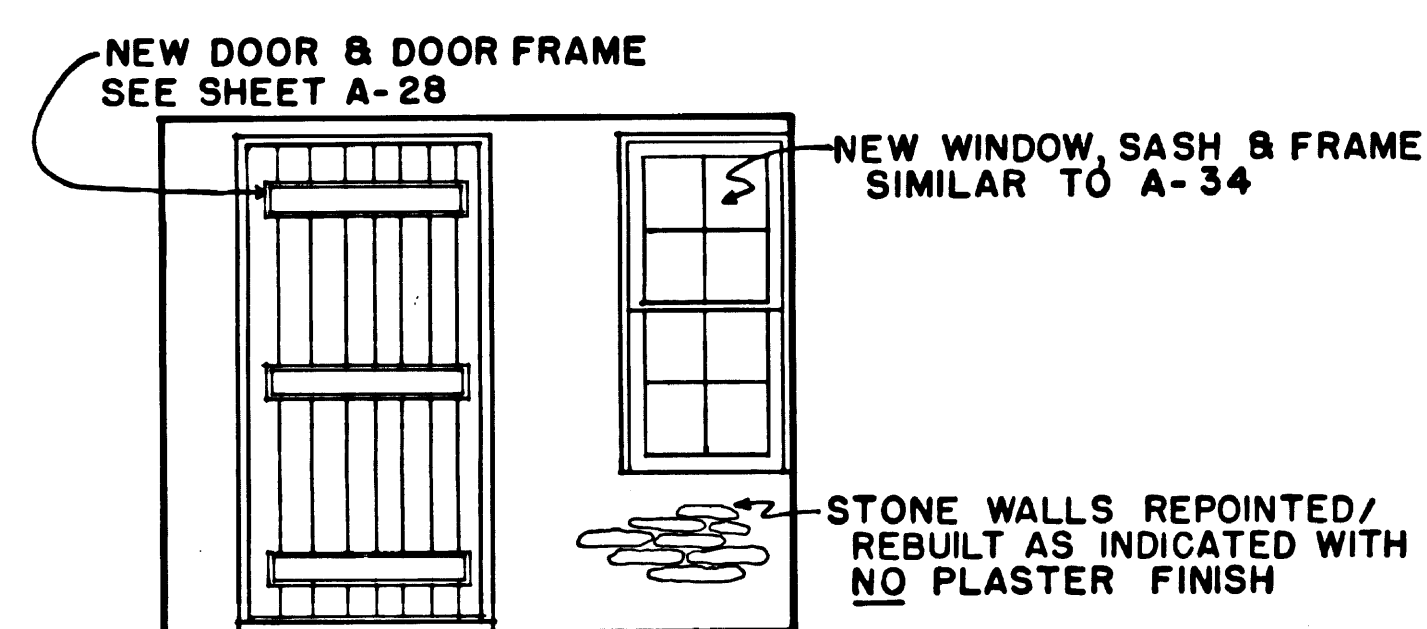


WEST 12A/RM 3

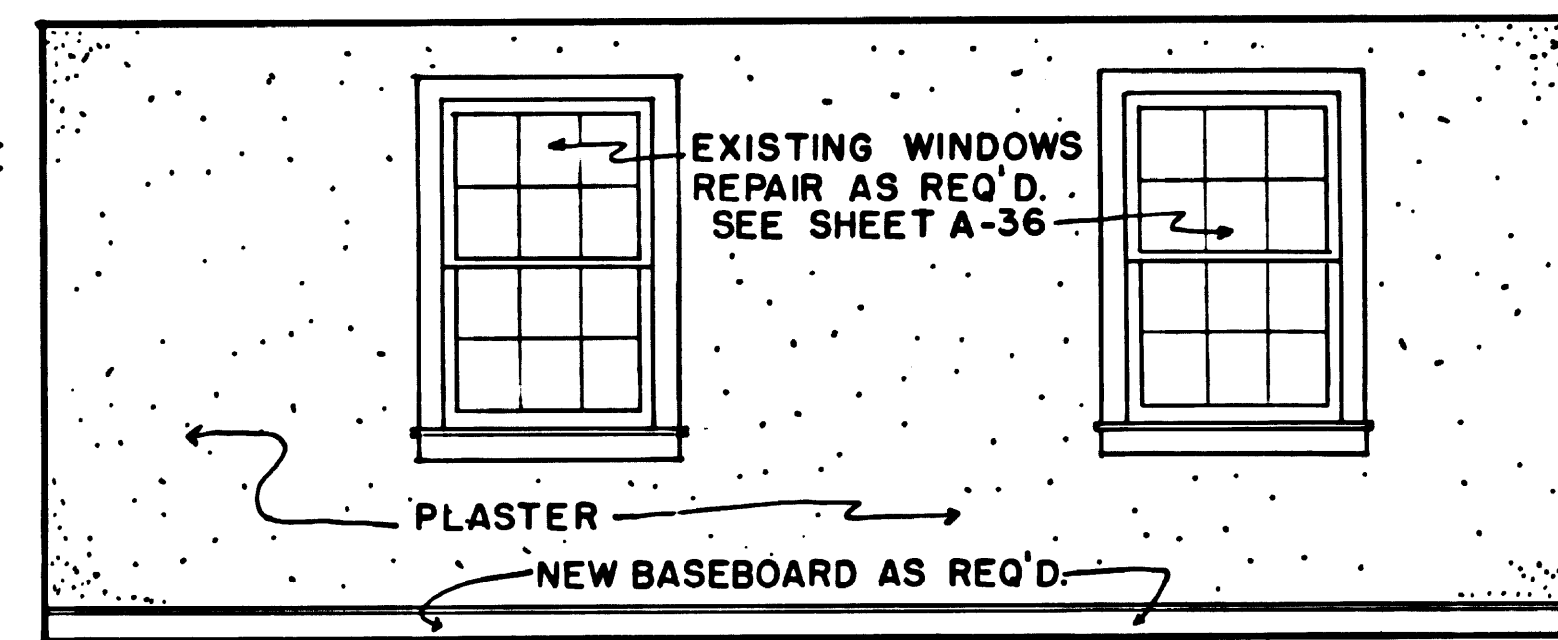


NORTH 12A/ RM 103

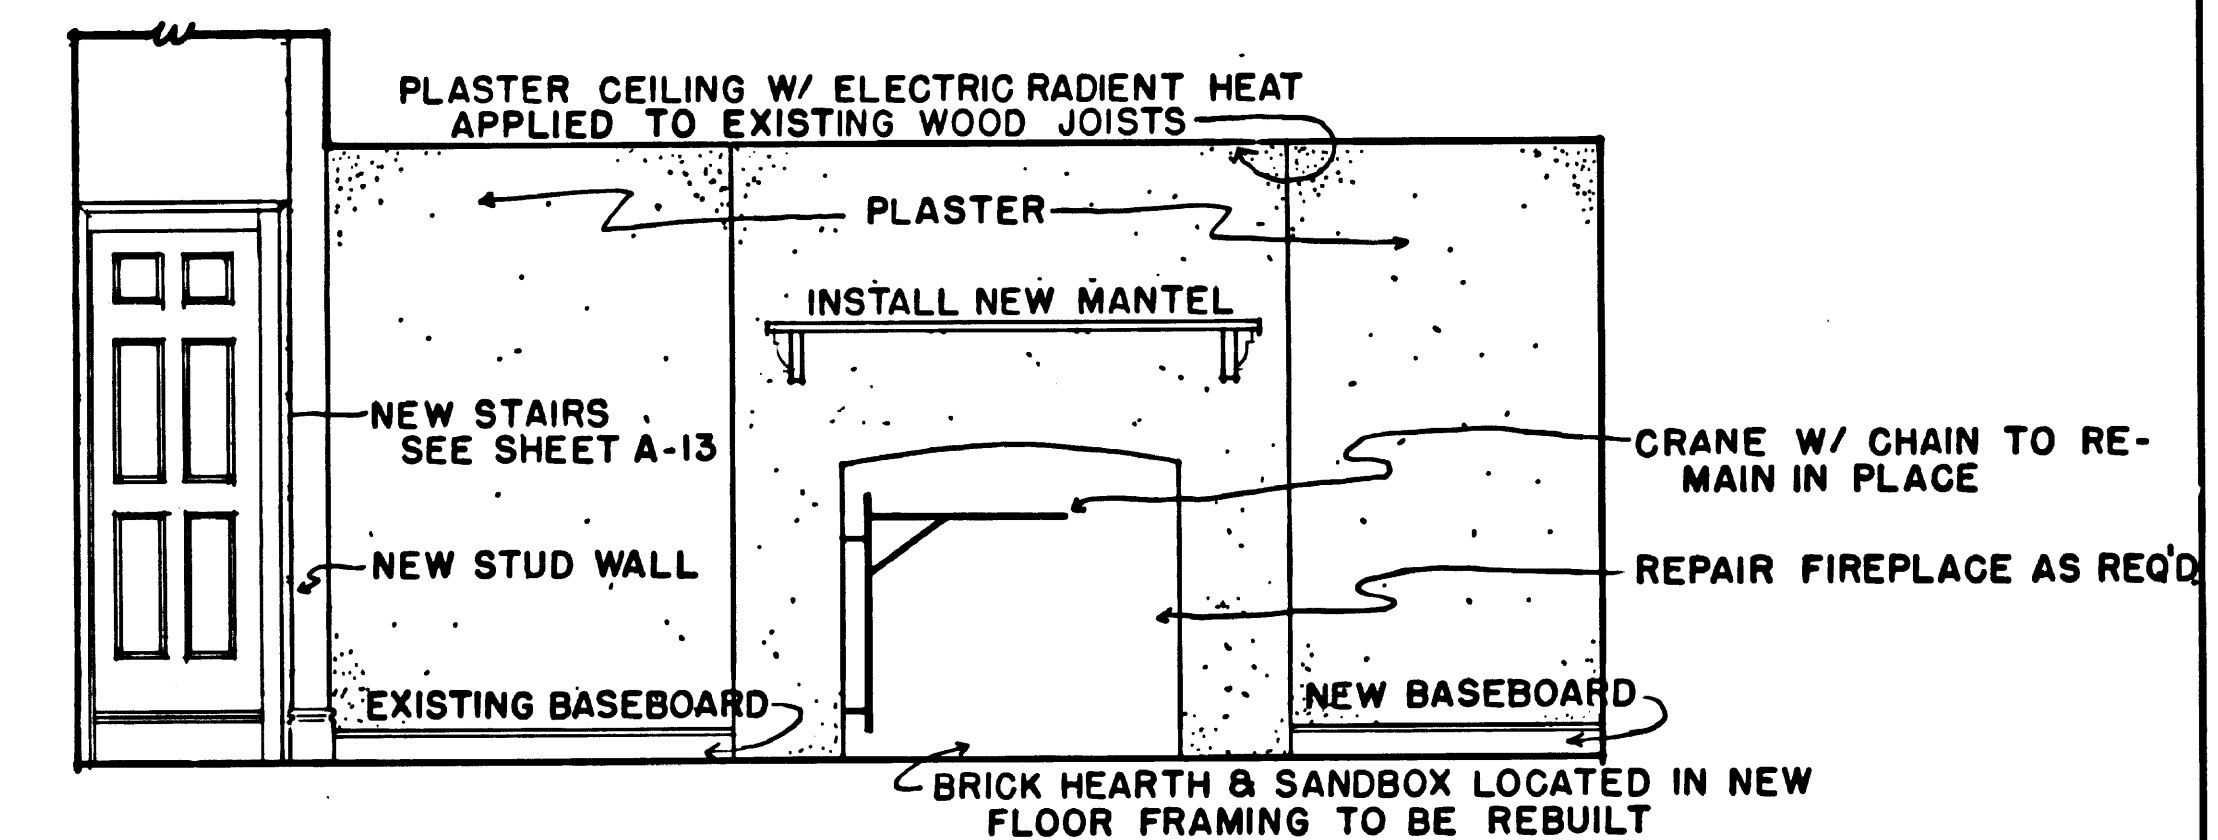


SOUTH 12A/RM 103

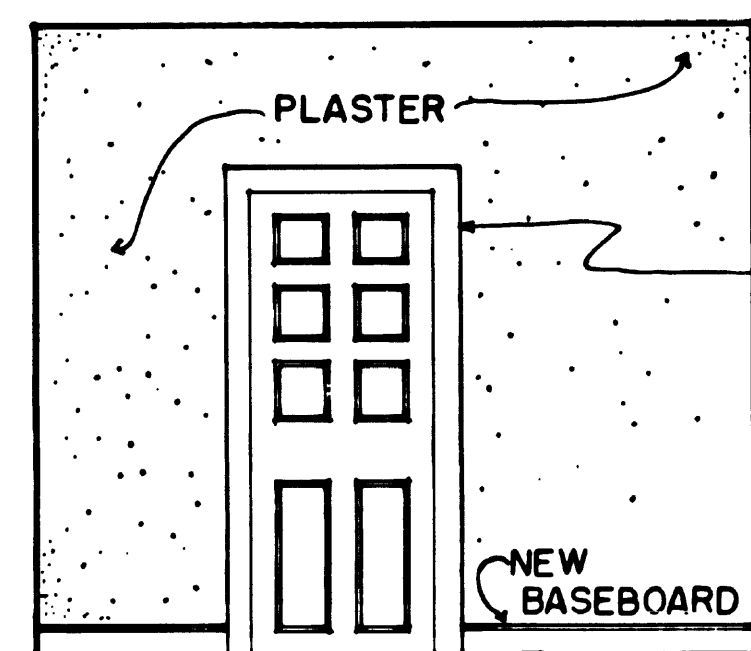


WEST 12A/RM 201

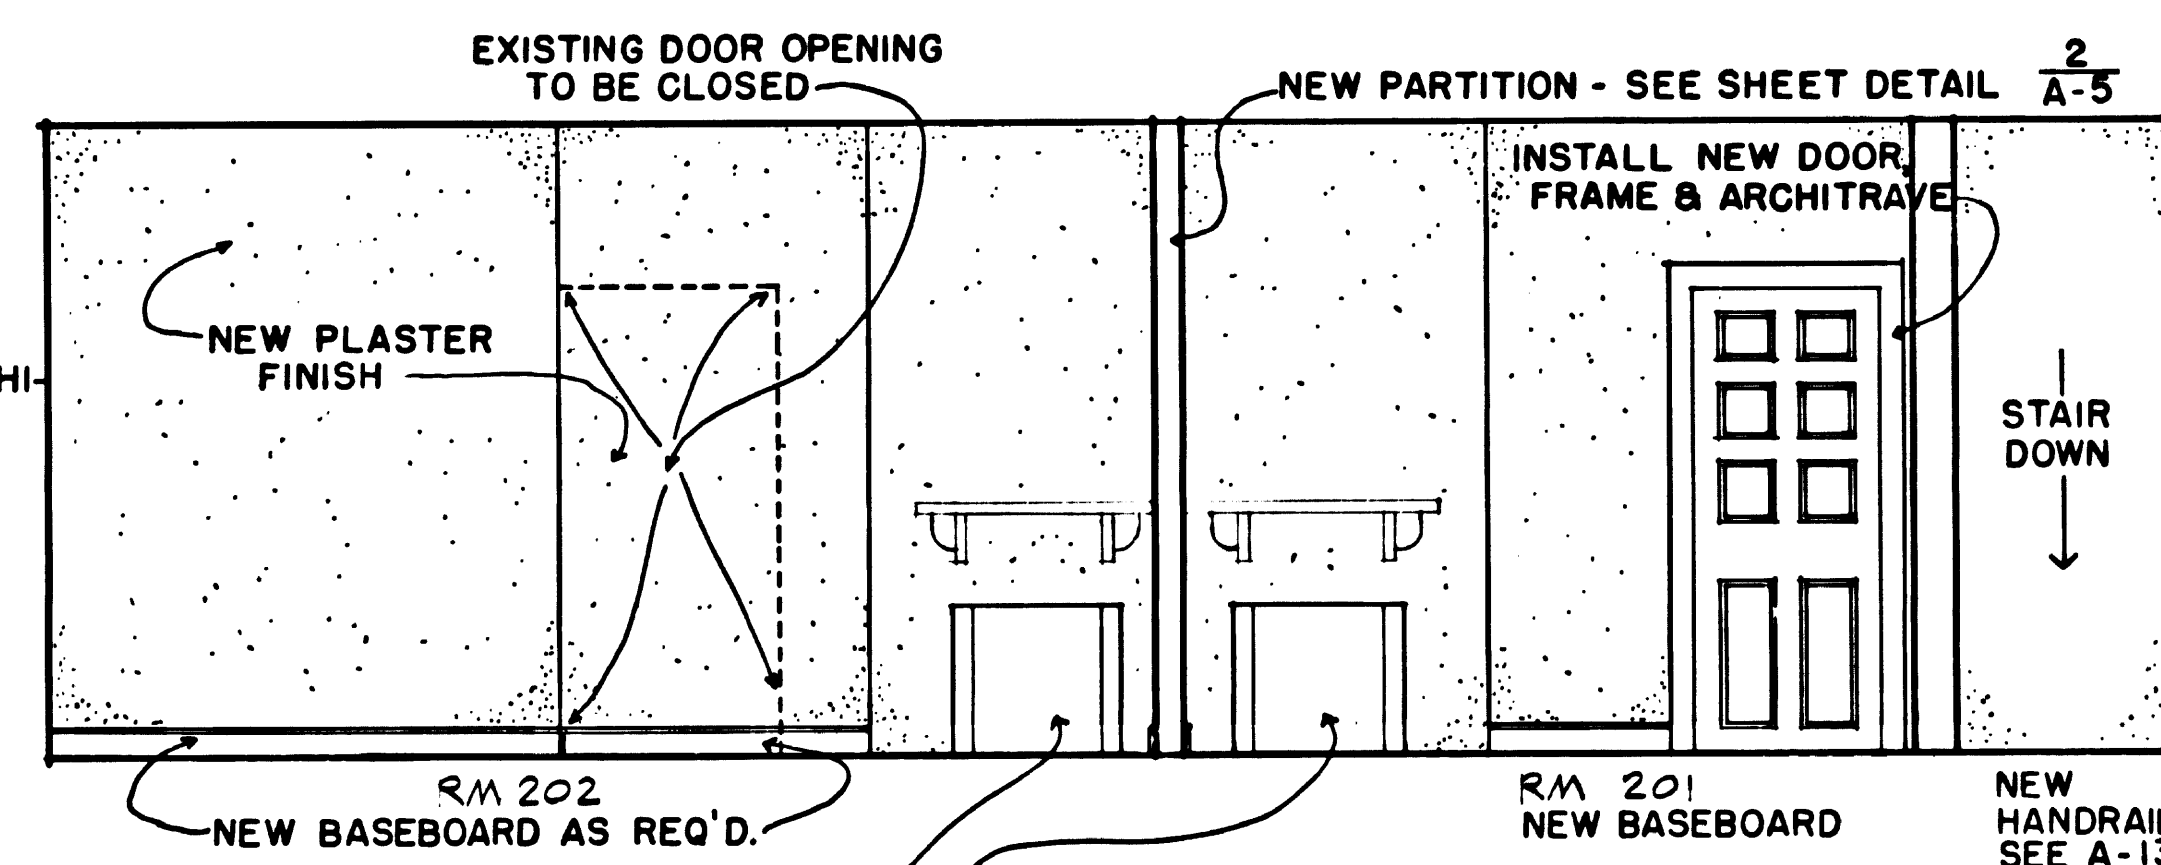

NORTH 12A/RM 202, 201

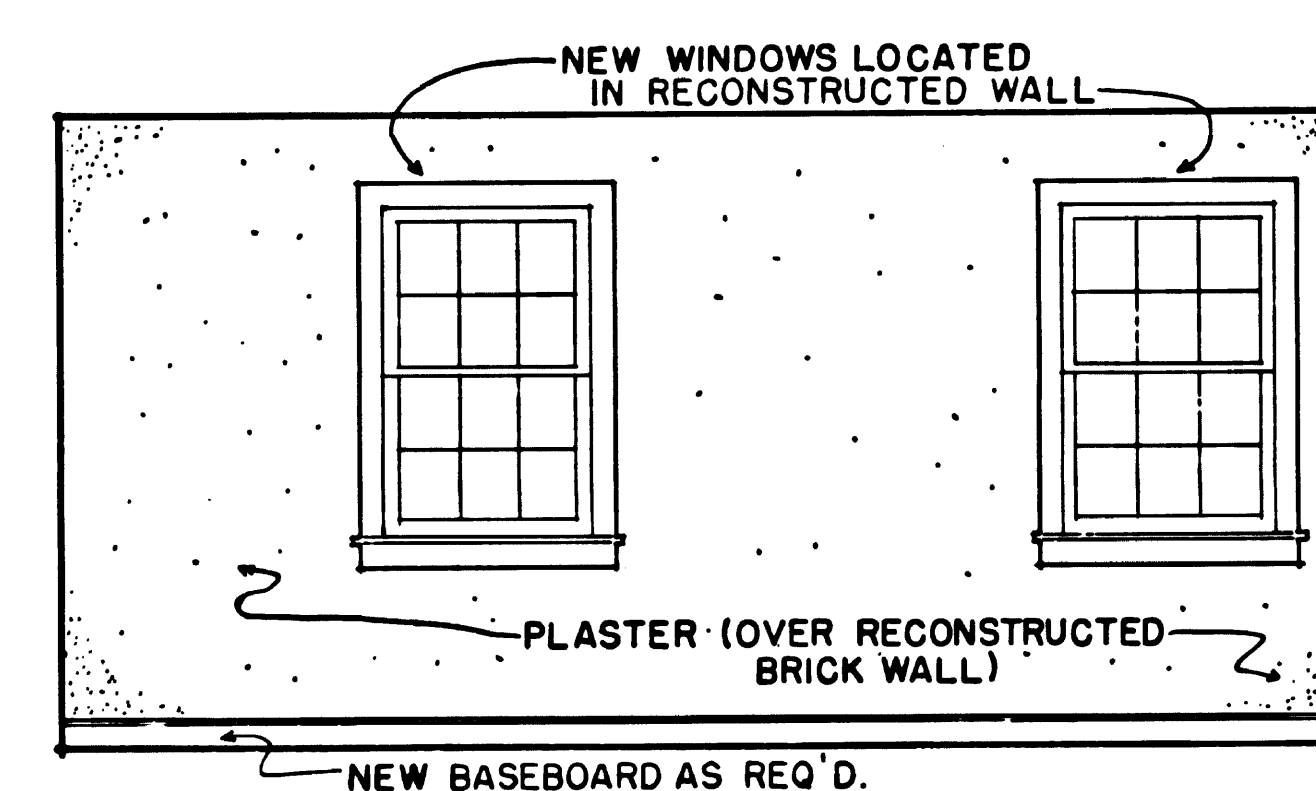

NORTH 12A/RM 203

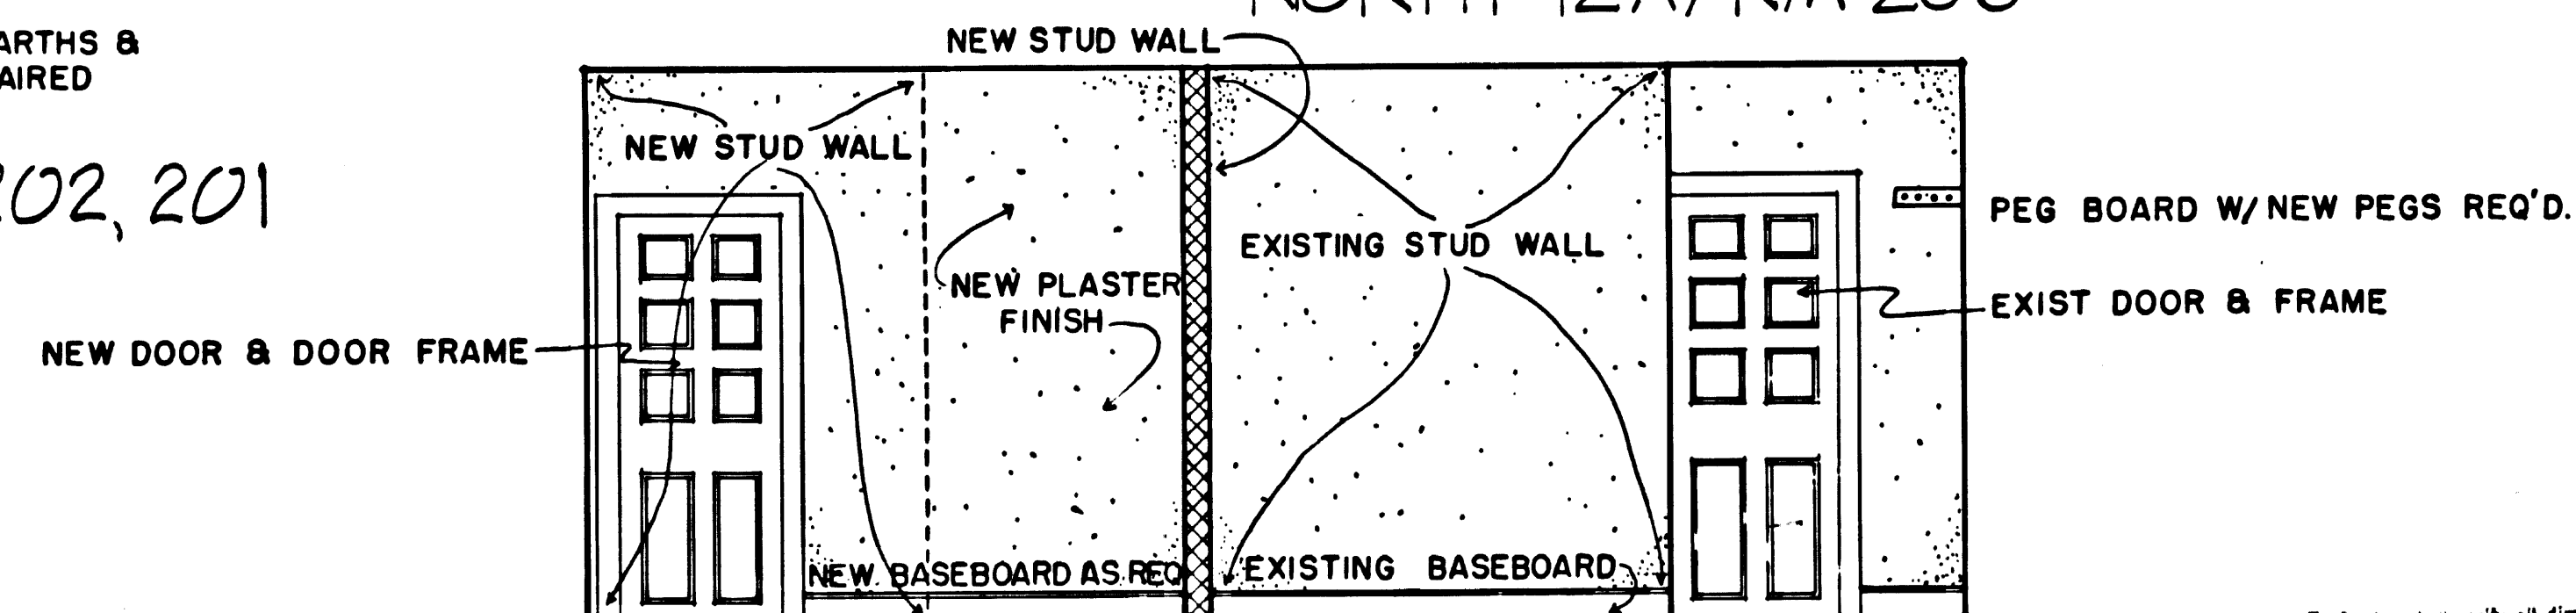

EAST 12A/ RM 203, 201

PHASE II-B
RESTORATION

BLDG 12A

INTERIOR ELEVATIONS

3/8" = 1'-0"



SCALE


A 25		DRAWING NO.	
PREPARED	RSJ/WLB	DESIGNED	385
DRAWN	GEISER	PKG.	25006A
CHECKED	BARLOW	SHEET	110
DATE	6/78	OF 65	25

Contractor shall verify all dimensions and take own measurements at the site before commencing work. Advice of any structural deficiencies.


1 ROOM 102 - BLDG 12
A-26 SOUTH WALL

2 ROOM 202 - BLDG 12
A-26


3 ROOM 203 - BLDG 12
A-26

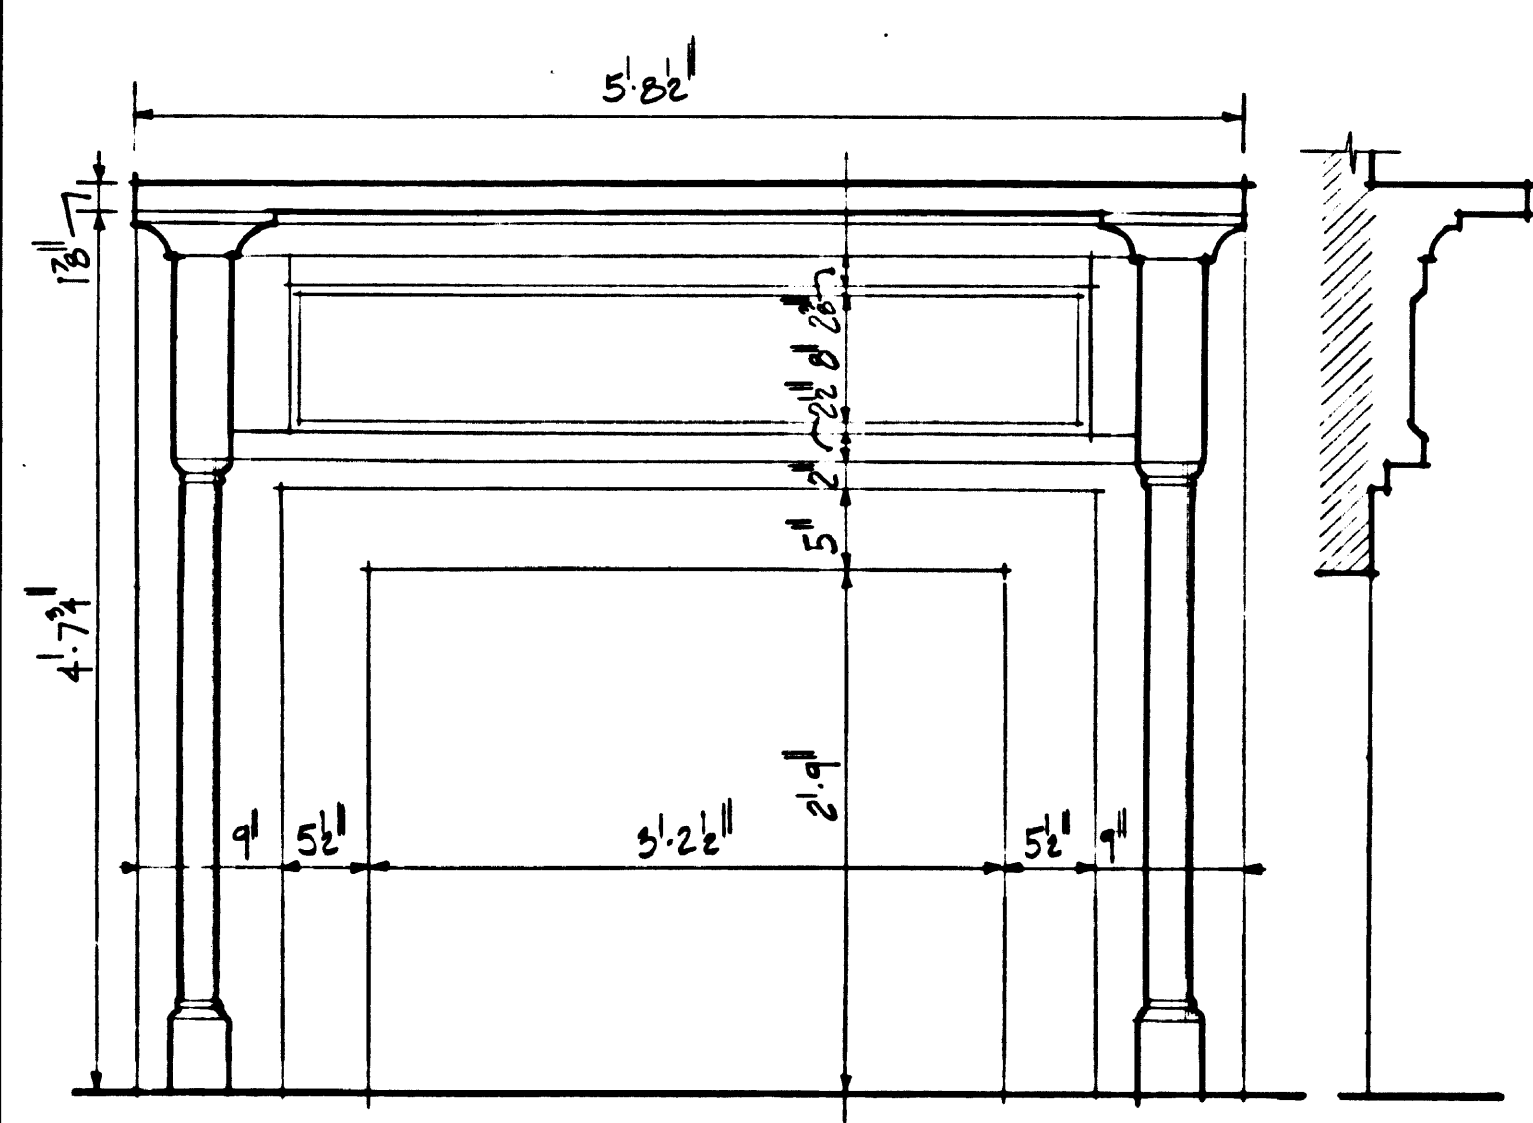


4 ROOM 205 - BLDG 12
A-26

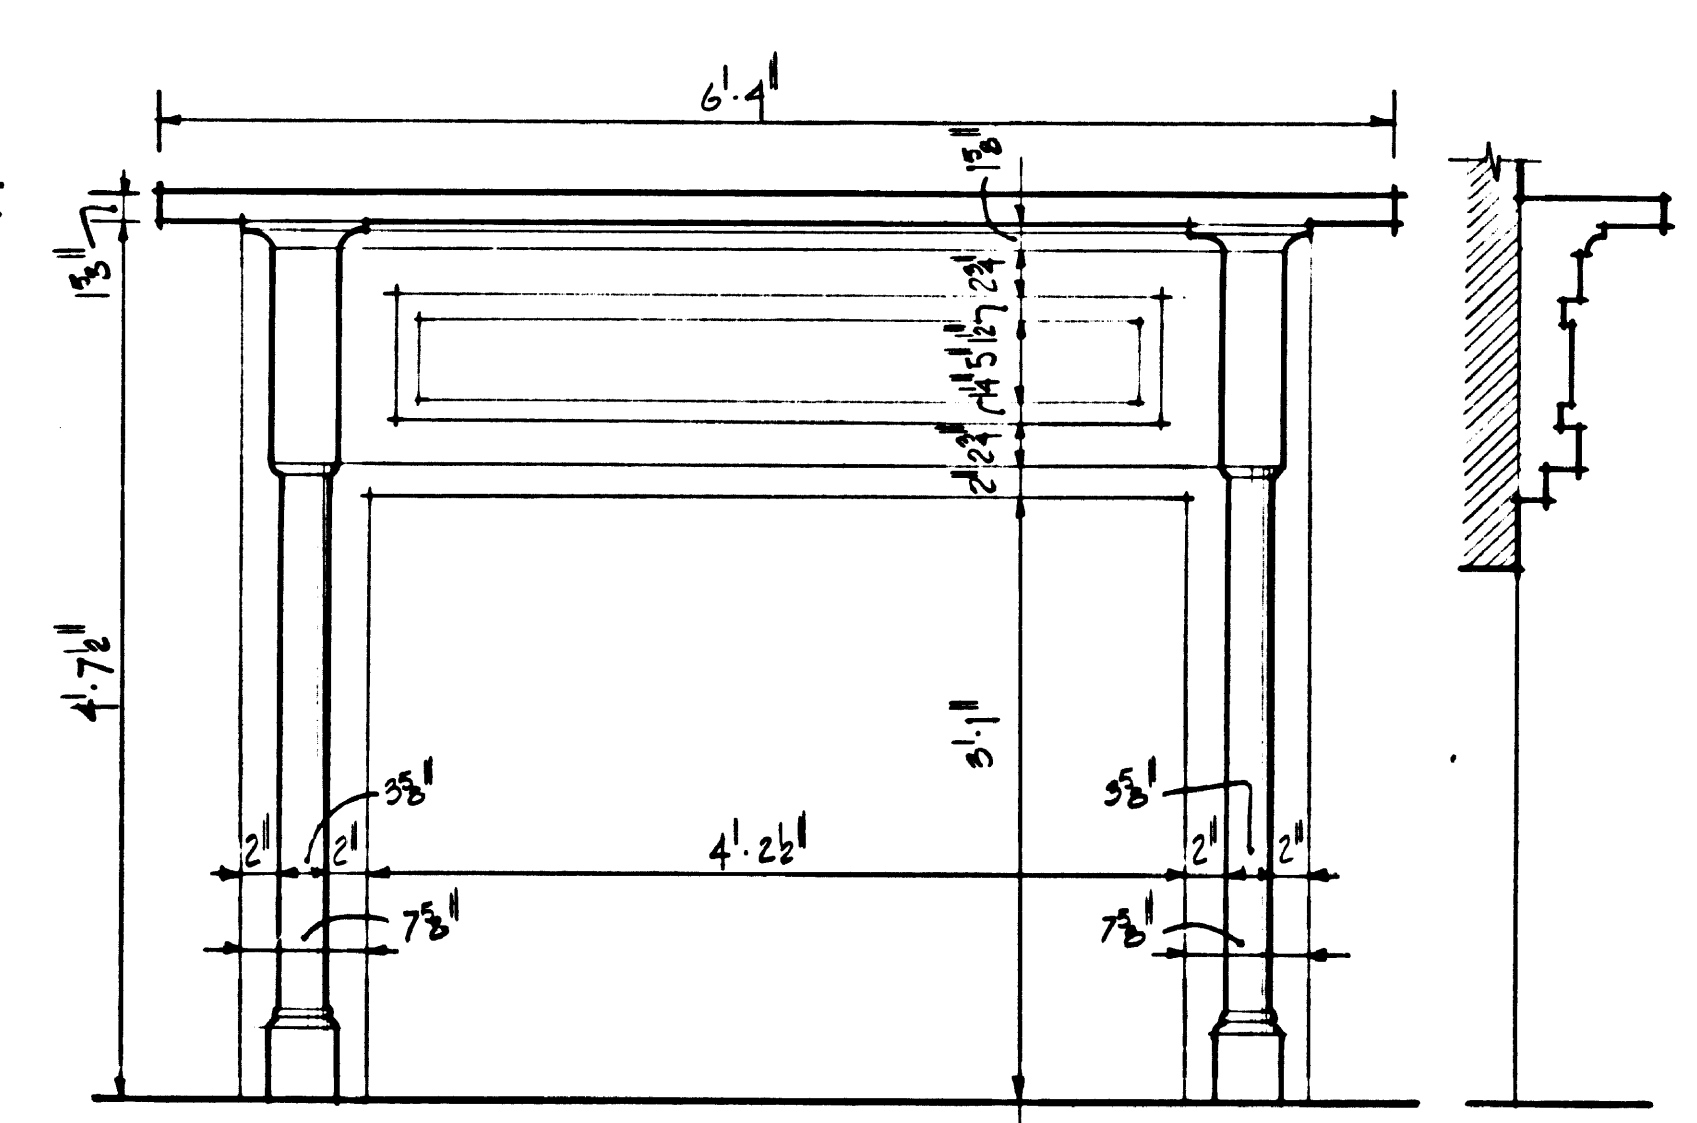



5 ROOM 303 - BLDG 12
A-26

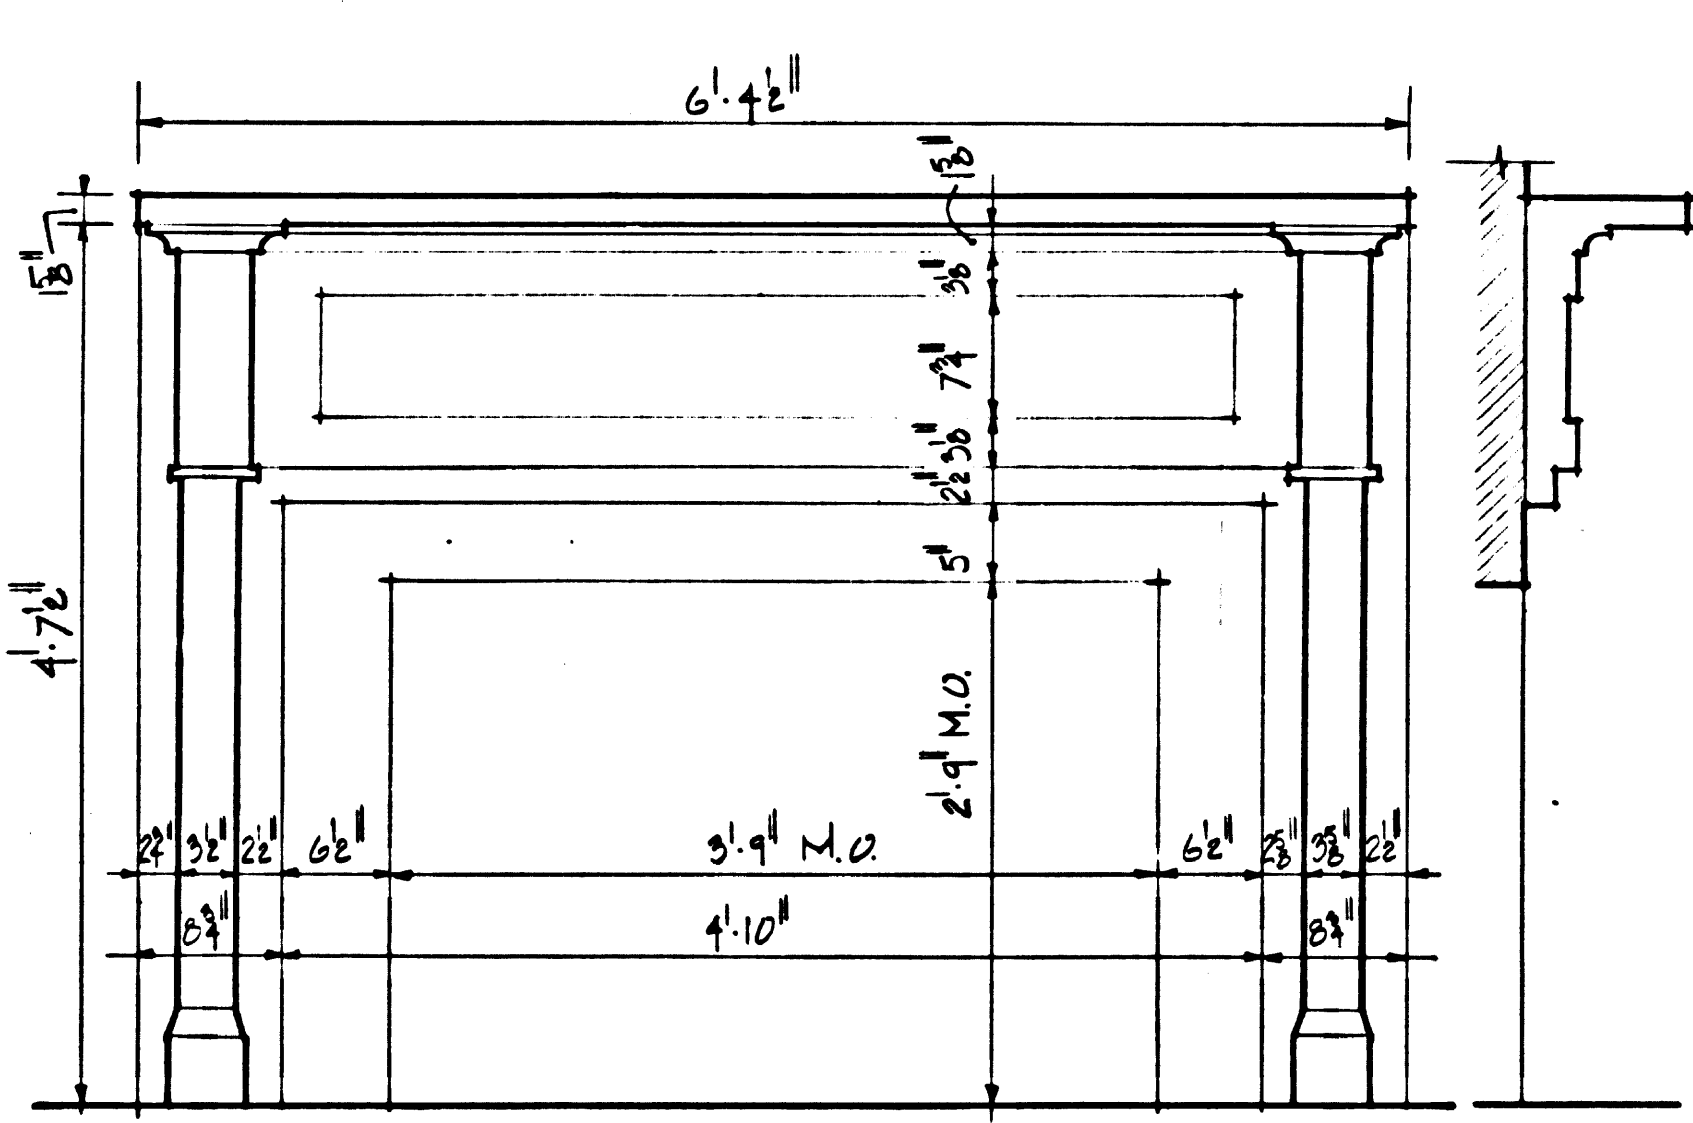

6 ROOM 305 - BLDG 12
A-26

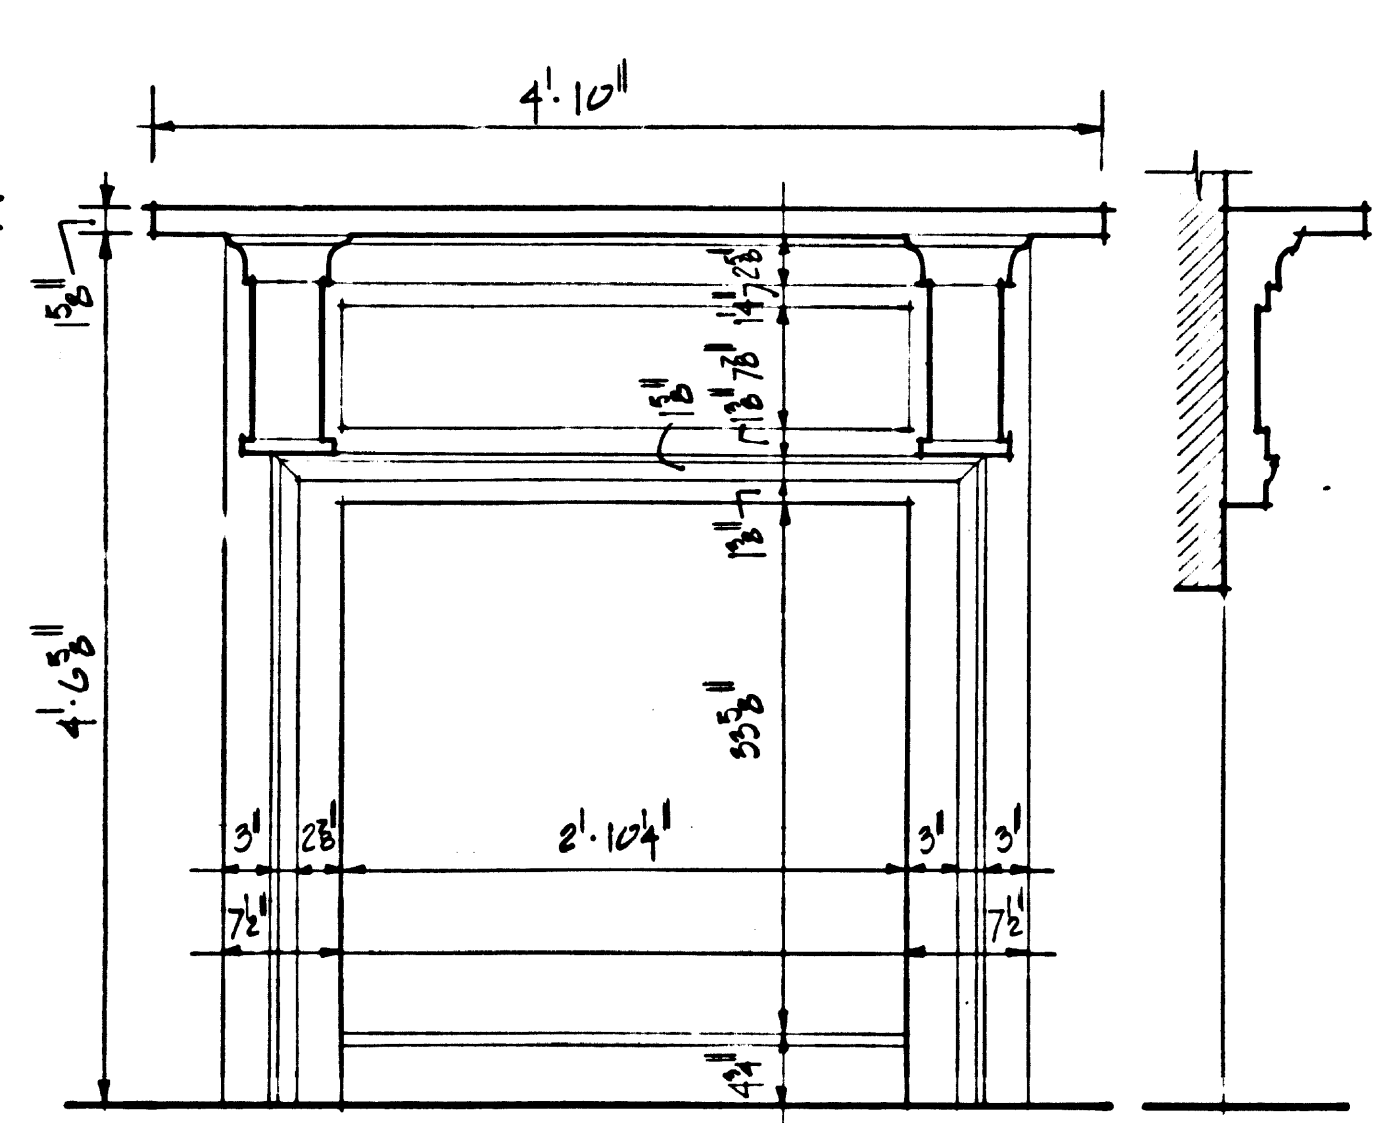

7 ROOM 202 - BLDG 12A
A-26

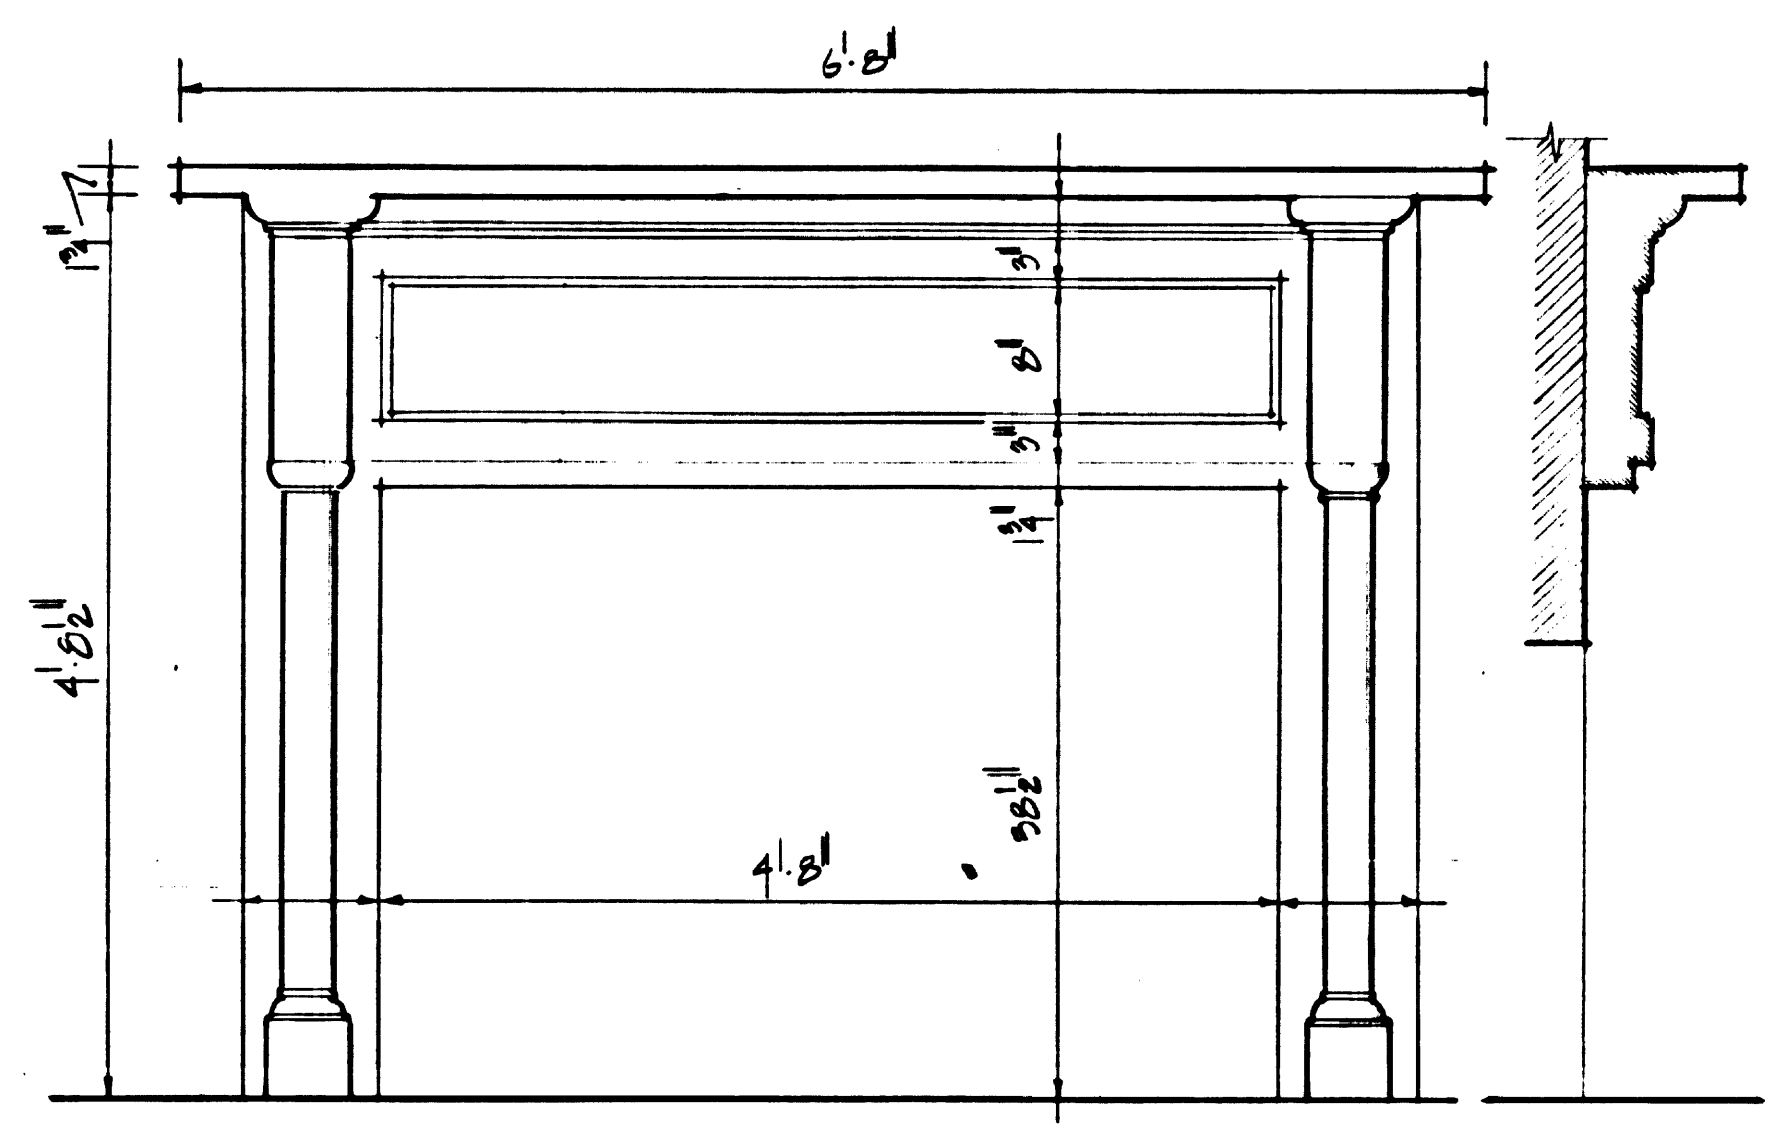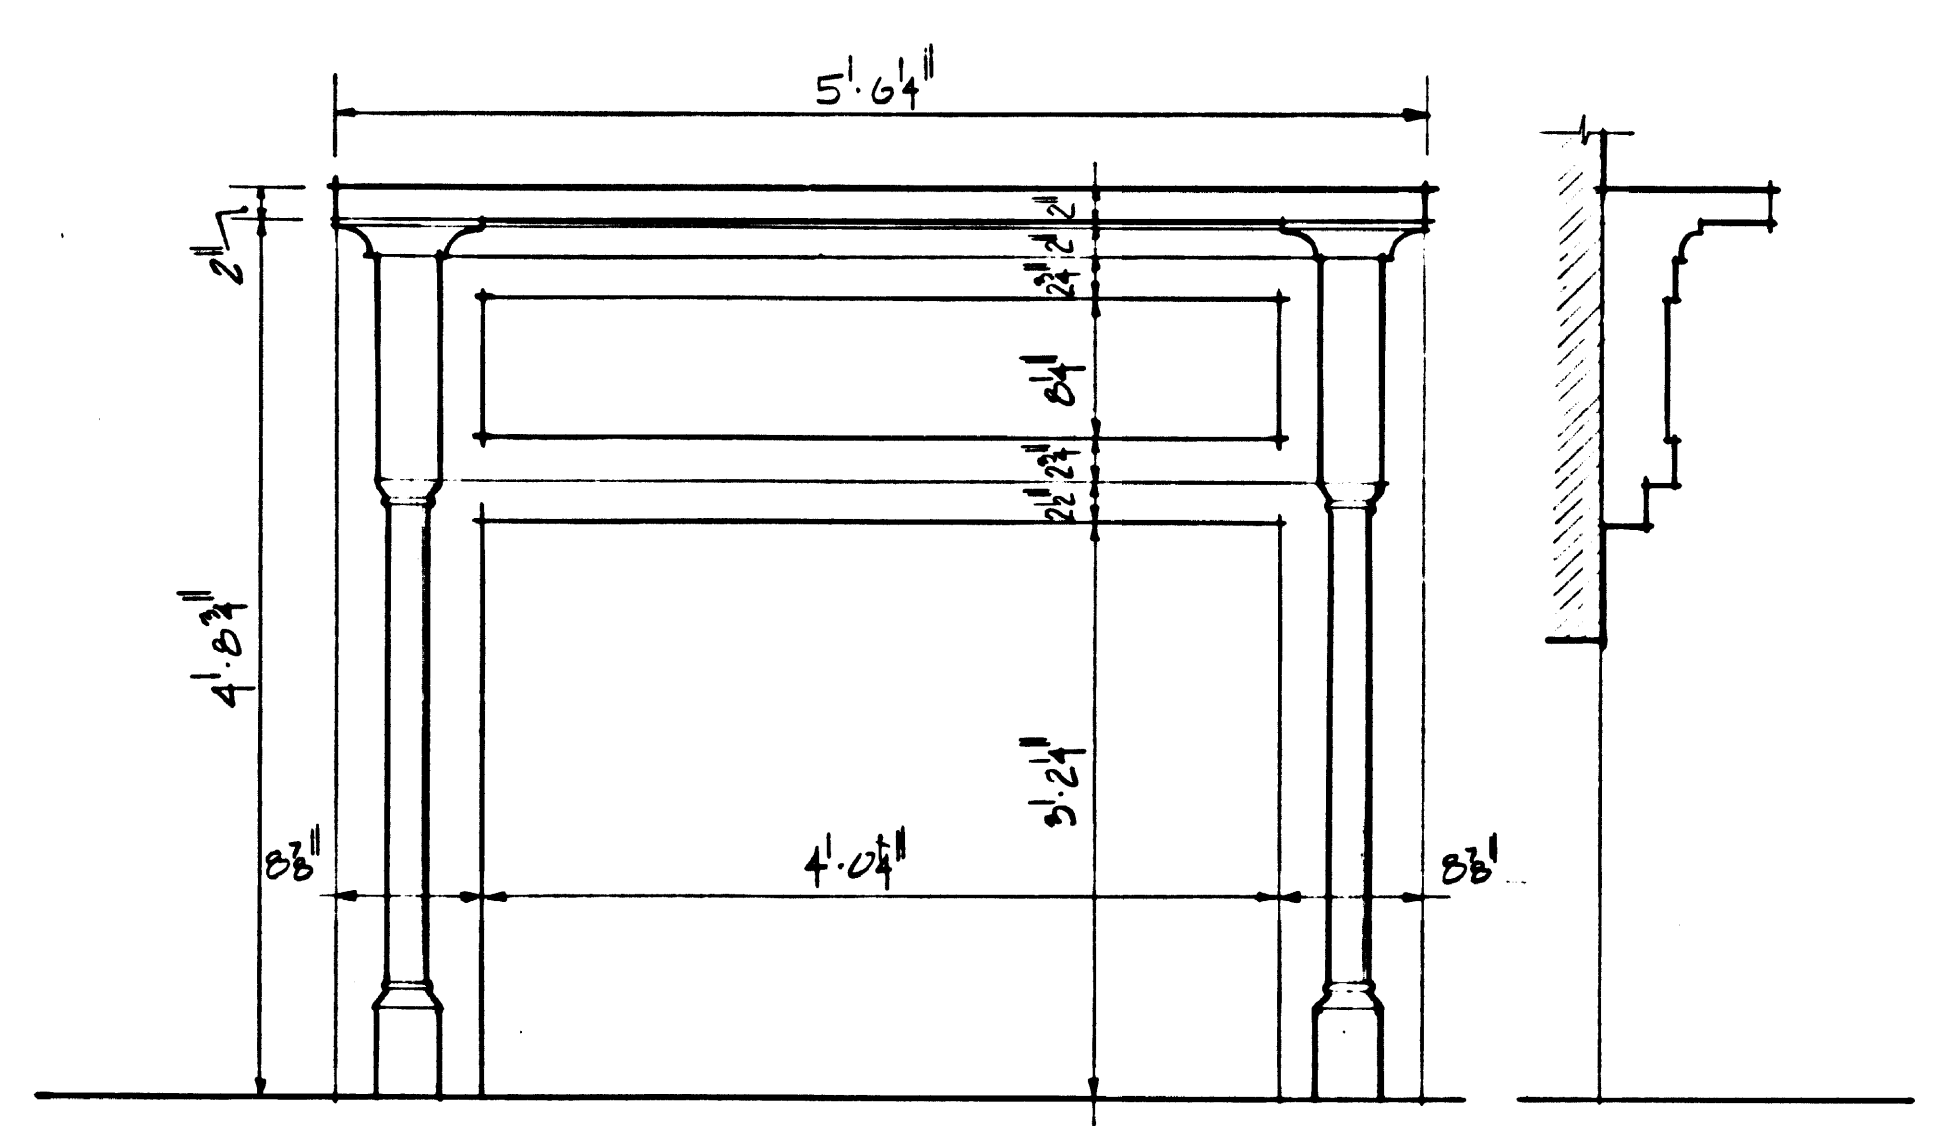

PHASE II-B
RESTORATION

EXISTING FIREPLACE MANTELS - BLDG 12&12A
SCALE : 0' 6" 1' 2' 3' 1" = 1' - 0"

Contractor shall verify all dimensions and take own measurements at the job site before commencing work. Advise of any error or discrepancy.

PREPARED RSJ/WLB DESIGNED JACOBS	DRAWING NO. 385 25.006A
DRAWN BARLOW CHECKED 6/78 DATE	POB PKG SHEET 110 26 OF 65

A - 26

WINDOW SCHEDULE												
FLR	BLDG	SYMB	FRAME	SASH	REMARKS	FLR	BLDG	SYMB	FRAME	SASH	REMARKS	
BASEMENT	I2	W 1	NEW	NEW	SEE SHT. A 34 . USE EXIST. STONE SILLS IF PRESENT. - JAMBS ARE TO BE SPLAYED	3rd FLOOR	I2	W 213	EXIST.	EXIST.	SEE SHT. A 35 . INSTALL NEW SUB-SILL REPAIR AS REQ'D.	
	I2	W 2	NEW	NEW	SEE SHT. A 34 . USE EXIST. STONE SILLS IF PRESENT. - JAMBS ARE TO BE SPLAYED		I2	W 201	EXIST.	NEW	SEE SHT. A 35 . REPAIR AS REQ'D.	
	I2A	W 3	NEW	NEW	SEE SHT. A 34 . USE EXIST. STONE SILLS JAMBS ARE TO BE SPLAYED		I2	W 202	EXIST.	NEW	SEE SHT. A 35 . REPAIR AS REQ'D.	
	I2A	W 4	NEW	NEW	SEE SHT. A 34 . USE EXIST. STONE SILLS JAMBS ARE TO BE SPLAYED		I2	W 203	EXIST.	NEW	SEE SHT. A 35 . REPAIR AS REQ'D.	
	I2A	W 5	NEW	NEW	SEE SHT. A 34 . USE EXIST. STONE SILLS IF PRESENT. - JAMBS ARE TO BE SPLAYED		I2	W 204	EXIST.	EXIST.	SEE SHT. A 35 . REPAIR AS REQ'D.	
	I2A	W 6	NEW	NEW	SEE SHT. A 34 . USE EXIST. STONE SILLS IF PRESENT.		I2	W 205	EXIST.	EXIST.	SEE SHT. A 35 . REPAIR AS REQ'D.	
	I2A	W 7	NEW	NEW	SEE SHT. A 34 . USE EXIST. STONE SILLS IF PRESENT.		I2	W 206	EXIST.	EXIST.	SEE SHT. A 35 . REPAIR AS REQ'D.	
1st FLOOR	I2	W 101	NEW	NEW	SEE SHT. A 35 . LOCATED IN RECONSTRUCTED WALL. - JAMBS ARE TO BE SPLAYED	4th FLOOR	I2	W 207	EXIST.	EXIST.	SEE SHT. A 35 . REPAIR AS REQ'D.	
	I2	W 102	NEW	NEW	SEE SHT. A 35 . LOCATED IN RECONSTRUCTED WALL. - JAMBS ARE TO BE SPLAYED		I2	W 208	REUSE PORTION OF EXIST.	EXIST.	SEE SHT. A 35 . REPAIR AS REQ'D.	
	I2	W 103	NEW	NEW	SEE SHT. A 35 . LOCATED IN RECONSTRUCTED WALL. - JAMBS ARE TO BE SPLAYED		I2	W 209	EXIST.	EXIST.	SEE SHT. A 35 . REPAIR AS REQ'D.	
	I2	W 104	NEW	NEW	SEE SHT. A 35 . LOCATED IN RECONSTRUCTED WALL. - JAMBS ARE TO BE SPLAYED		I2	W 210	EXIST.	EXIST.	EXIST. DORMER . REPAIR AS REQ'D.	
	I2	W 105	EXIST.	NEW	SEE SHT. A 35 . NEW SUB-SILL REQ'D.		I2	W 211	EXIST.	EXIST.	EXIST. DORMER . REPAIR AS REQ'D.	
	I2A	W 106	EXIST. REPAIR AS REQ'D.	NEW	SEE SHT. A 36		I2	W 212	EXIST.	EXIST.	SEE SHT. 35 . REPAIR AS REQ'D.	
	I2A	W 107	EXIST.	NEW	SEE SHT. A 36 . REPAIR AS REQ'D		I2	W 213	EXIST.	EXIST.	EXIST. DORMER . REPAIR AS REQ'D.	
	I2A	W 108	EXIST.	EXIST.	SEE SHT. A 36 . REPAIR AS REQ'D		I2	W 214	EXIST.	EXIST.	EXIST. DORMER . REPAIR AS REQ'D.	
	I2A	W 109	EXIST.	NEW	SEE SHT. A 36 . REPAIR AS REQ'D		I2	W 215	EXIST.	EXIST.	EXIST. DORMER . REPAIR AS REQ'D.	
	I2A	W 110	REUSE PART OF EXIST.	NEW	SEE SHT. A 36 . REPAIR AS REQ'D		1st FLOOR	I2	W 112	NEW	NEW	SEE SHT. A 36
	I2	W 111	REUSE PORTION OF EXIST.	NEW	SEE SHT. A 35 . REPAIR AS REQ'D. INSTALL NEW SILL & SUB-SILL .							
	I2	W 201	EXIST.	NEW	SEE SHT. A 35 . REPAIR AS REQ'D. INSTALL NEW SUB-SILL .							
I2	W 202	EXIST.	NEW	SEE SHT. A 35 . REPAIR AS REQ'D. INSTALL NEW SUB-SILL .								
I2	W 203	EXIST.	EXIST.	SEE SHT. A 35 . REPAIR AS REQ'D. INSTALL NEW SUB-SILL .								
I2	W 204	EXIST.	EXIST.	SEE SHT. A 35 . REPAIR AS REQ'D. INSTALL NEW SUB-SILL .								
I2	W 205	EXIST.	EXIST.	SEE SHT. A 35 . REPAIR AS REQ'D. INSTALL NEW SUB-SILL .								
I2	W 206	EXIST.	EXIST.	SEE SHT. A 35 . REPAIR AS REQ'D. INSTALL NEW SUB-SILL .								
I2A	W 207	EXIST.	EXIST.	SEE SHT. A 37 . REPAIR AS REQ'D. PATCH EXIST. SPLAYED JAMBS .								
I2A	W 208	EXIST.	EXIST.	SEE SHT. A 37 . REPAIR AS REQ'D. PATCH EXIST. SPLAYED JAMBS .								
I2A	W 209	EXIST.	EXIST.	SEE SHT. A 37 . REPAIR AS REQ'D. PATCH EXIST. SPLAYED JAMBS .								
2nd FLOOR	I2A	W 210	EXIST.	EXIST.	SEE SHT. A 38 . REPAIR AS REQ'D.							
	I2A	W 211	REUSE PORTION OF EXIST.	NEW	SEE SHT. A 38 . LOCATED IN RECONSTRUCTED WALL. REPAIR AS REQ'D.							
	I2A	W 212	NEW	NEW	SEE SHT. A 38 . LOCATED IN RECONSTRUCTED WALL. REPAIR AS REQ'D.							

GENERAL NOTES:

THRESHOLDS, SASHES, SASH STOPS AND PARTING STRIPS, BACK BANDS, STOOLS, APRONS, SILLS AND SUB-SILLS ALL REQUIRE CAREFUL ON SIGHT EVALUATION. DUE TO THE SPECIAL NATURE OF THIS PROJECT, EVERY EFFORT SHOULD BE MADE TO RETAIN AS MUCH HISTORIC FABRIC POSSIBLE AS DIRECTED BY THE PROJECT SUPERVISOR.


DOOR SCHEDULE							
FLR	BLD	SYMB.	TYP.	FRAME	DOOR	HDWR	REMARKS
BASEMENT	12	(D 1)	1	NEW	NEW		SEE SHT. A 28
	12A	(D 2)	1	NEW	NEW		SEE SHT. A 28. REUSE EXIST. STONE SILL. REPAIR JACK ARCH AS REQ'D.
	12A	(D 3)	1	NEW	NEW		SEE SHT. A 28. REUSE EXIST. STONE SILL. REPAIR JACK ARCH AS REQ'D.
	12A	(D 4)	1	NEW	NEW		SEE SHT. A 28
	12 / 12A	(D 5)	1	NEW	NEW		SEE SHT. A 28
	12	(D 6)	1	NEW	NEW		SEE SHT. A 28
1st FLOOR	12	(D 101)	2	NEW	NEW		SEE SHT. A 29. NEW DOOR LOCATED IN RECONSTRUCTED WALL.
	12	(D 102)	2	EXIST. REPAIR AS REQ'D	EXIST. REPAIR AS REQ'D		SEE SHT. A 29. REMOVE EXIST. GLASS & RESTORE PANEL DOOR.
	12A	(D 103)	3	EXIST. REPAIR AS REQ'D	EXIST. REPAIR AS REQ'D		SEE SHT. A 30. REMOVE EXIST. GLASS & RESTORE PANEL DOOR.
	12A	(D 104)	3	EXIST. REPAIR AS REQ'D	EXIST. REPAIR AS REQ'D		SEE SHT. A 30. DOORS & FRAMES ARE TO BE RECONSTRUCTED.
	12A	(D 105)	3	EXIST. REPAIR AS REQ'D	NEW		SEE SHT. A 30.
	12 / 12A	(D 107)	2	EXIST. REPAIR AS REQ'D	EXIST. REPAIR AS REQ'D		SEE SHT. A 29.
	12 / 12A	(D 108)	2	EXIST. REPAIR AS REQ'D	EXIST. REPAIR AS REQ'D		SEE SHT. A 29.
	12A	(D 109)	6	NEW	NEW		SEE SHT. A 33. NEW DOOR LOCATED IN RECONSTRUCTED WALL.
	12	(D 110)	4	NEW	NEW		SEE SHT. A 31.
	12	(D 111)	4	NEW	NEW		SEE SHT. A 31.
	12	(D 231)	2	EXIST. REPAIR AS REQ'D	EXIST. REPAIR AS REQ'D		SIM. SHT. A 30. REMOVE EXIST. GLASS RESTORE EIGHT PANEL DOOR.
	12A	(D 232)	3	EXIST. REPAIR AS REQ'D	EXIST. REPAIR AS REQ'D		SEE SHT. A 30.
	12A	(D 233)	3	EXIST. REPAIR AS REQ'D	NEW		SEE SHT. A 30.
	12A	(D 234)	6	NEW	NEW		SEE SHT. A 33. NEW DOOR LOCATED IN RECONSTRUCTED WALL.
2nd FLOOR	12A	(D 235)	6	NEW	NEW		SEE SHT. A 33. NEW DOOR LOCATED IN RECONSTRUCTED WALL.
	12A	(D 236)	6	NEW	NEW		SEE SHT. A 33. NEW DOOR LOCATED IN RECONSTRUCTED WALL.
	12 / 12A	(D 237)	2	EXIST. REPAIR AS REQ'D	EXIST. REPAIR AS REQ'D		SEE SHT. A 29.
	12	(D 238)	4	EXIST. REPAIR AS REQ'D	NEW		SEE SHT. A 31.
	12	(D 239)	4	EXIST. REPAIR AS REQ'D	EXIST. REPAIR AS REQ'D		SEE SHT. A 31.
	12	(D 240)	4	EXIST. REPAIR AS REQ'D	EXIST. REPAIR AS REQ'D		SEE SHT. A 31.
	12	(D 251)	5	EXIST. REPAIR AS REQ'D	NEW		SEE SHT. A 32.
	12	(D 252)	5	EXIST. REPAIR AS REQ'D	EXIST. REPAIR AS REQ'D		SEE SHT. A 32.
	12	(D 303)	5	EXIST. REPAIR AS REQ'D	EXIST. REPAIR AS REQ'D		SEE SHT. A 32.
	12	(D 304)	5	EXIST. REPAIR AS REQ'D	EXIST. REPAIR AS REQ'D		SEE SHT. A 32.
3rd FLOOR	12	(D 305)	5	EXIST. REPAIR AS REQ'D	EXIST. REPAIR AS REQ'D		SEE SHT. A 32.
	12	(D 401)	5	EXIST. REPAIR AS REQ'D	NEW		SEE SHT. A 32.
	12	(D 402)	5	EXIST. REPAIR AS REQ'D	NEW		SEE SHT. A 32.
	12	(D 403)	5	EXIST. REPAIR AS REQ'D	NEW		SEE SHT. A 32.
	12	(D 404)	5	EXIST. REPAIR AS REQ'D	NEW		SEE SHT. A 32.
4th FLOOR	12A	(P 113)	6	NEW	NEW		SEE SHT. A 33
	12	(P 112)	4	EXIST. REPAIR AS REQ'D	EXIST. REPAIR AS REQ'D		FOUND IN EXIST. PARTITION TO BE REMOVED SEE SHT. A 31.

DOOR & WINDOW SCHEDULES BLDGS 12 & 12A

PREPARED
GEISER
DESIGNED
GEISER
DRAWN
BARLOW
CHECKED
6/78
DATE

DRAWING NO.	
385	
25006A	
PCIP PKG.	SHEET
110	27
	OF 65




THRESHOLDS, SASHES, SASH STOPS AND PARTING STRIPS, BACKBANDS, STOOLS, APRONS, SILLS AND SUB-SILLS ALL REQUIRE CAREFUL ON SIGHT EVALUATION. DUE TO THE SPECIAL NATURE OF THIS PROJECT, EVERY EFFORT SHOULD BE MADE TO RETAIN AS MUCH HISTORIC FABRIC POSSIBLE AS DIRECTED BY THE PROJECT SUPERVISOR.

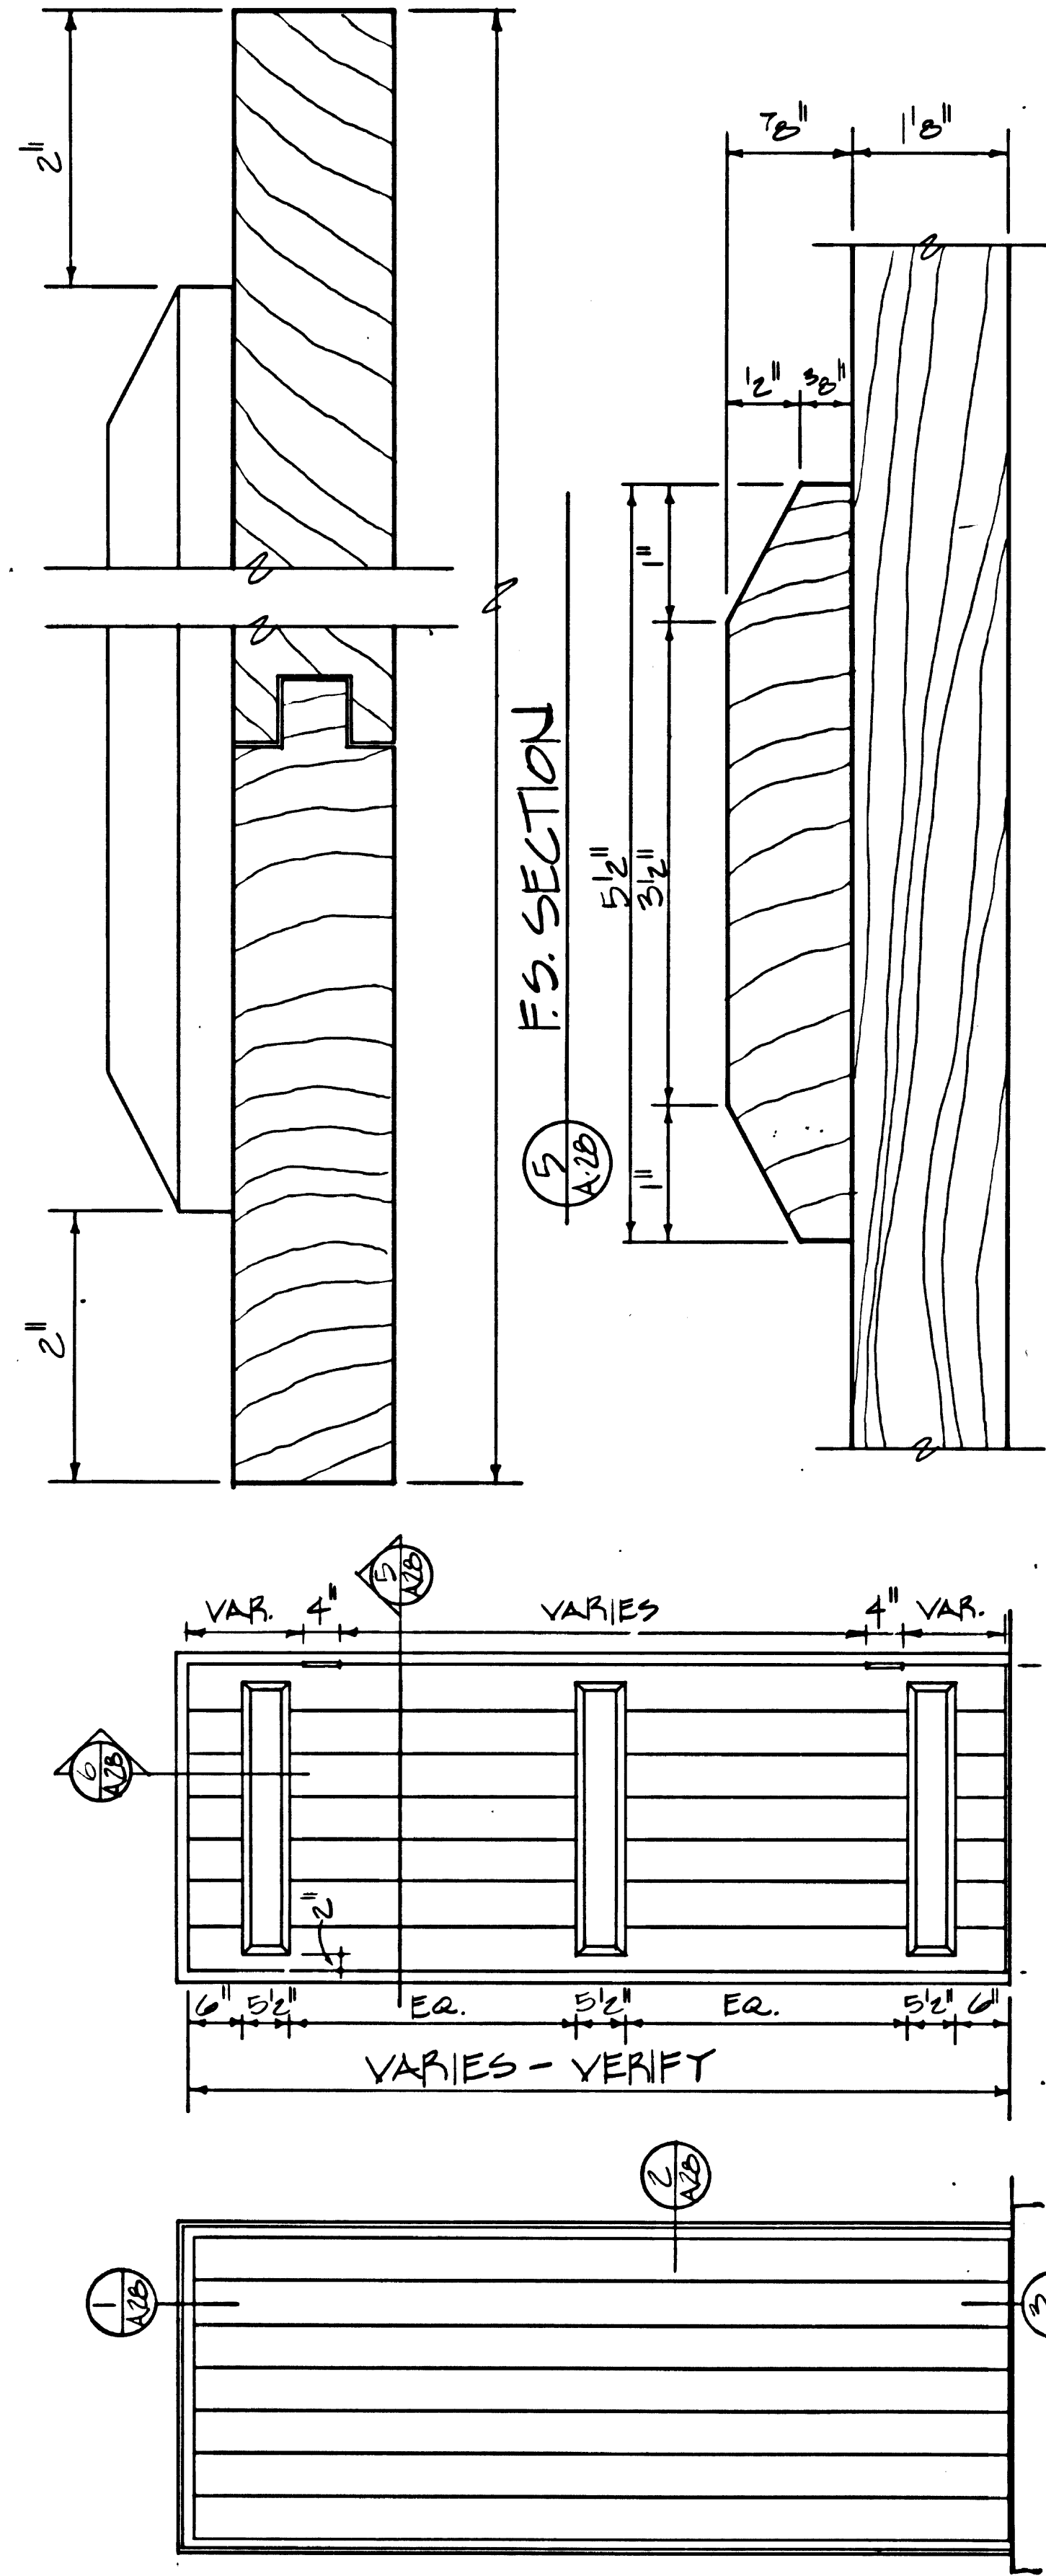

EXTERIOR
ELEVATIONS
SCALE - 3/4" = 1'-0"

BRICK ARCH
REPAIR AS SPEC.


SET IN SEALANT
COPPER CLAD PAPER
(STAPLE TO FRAME)

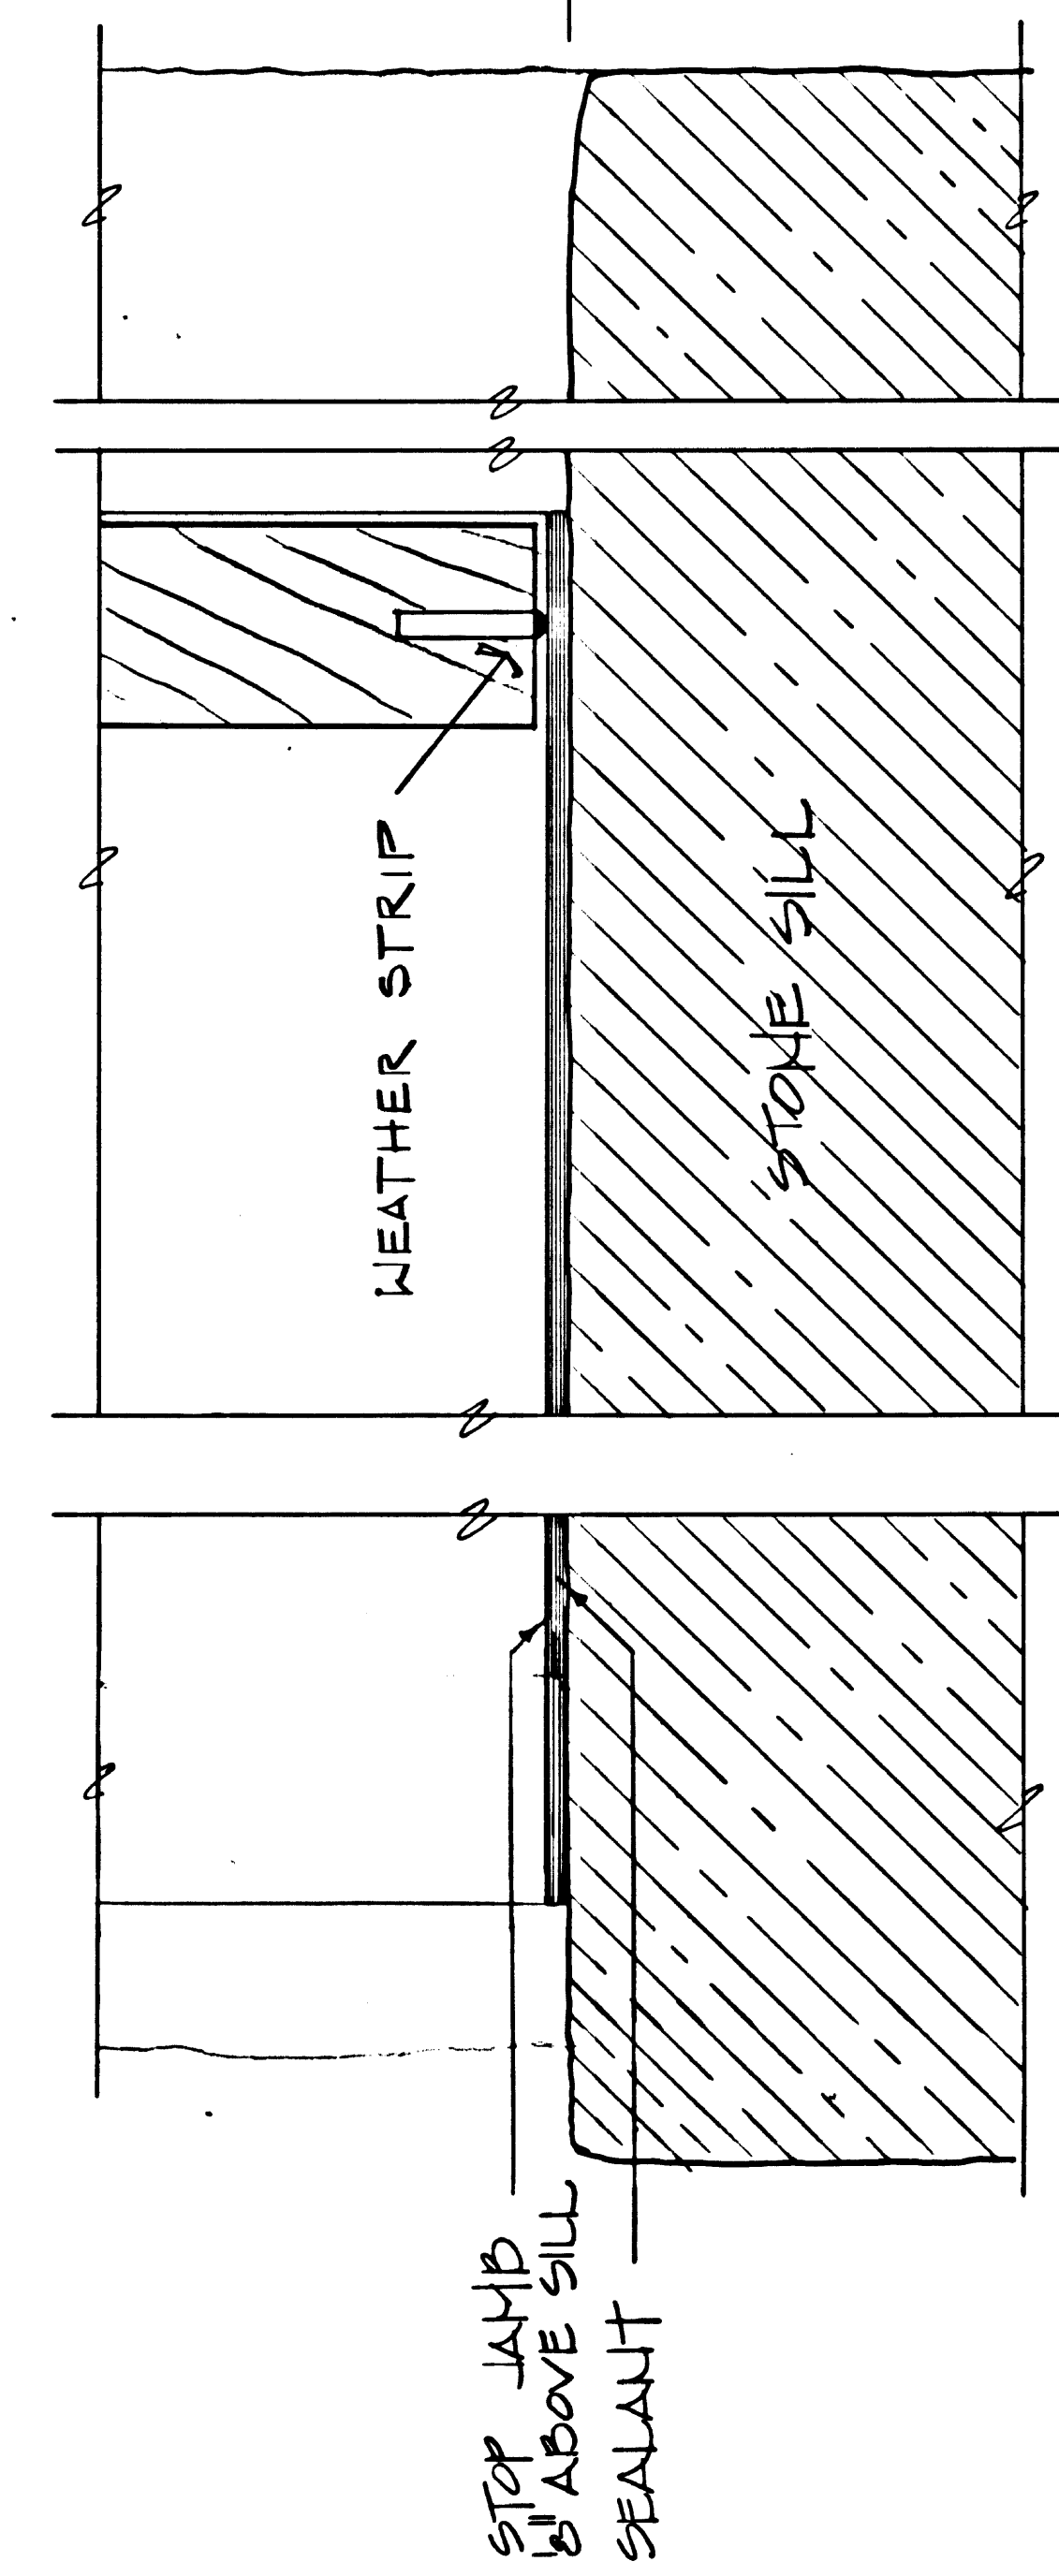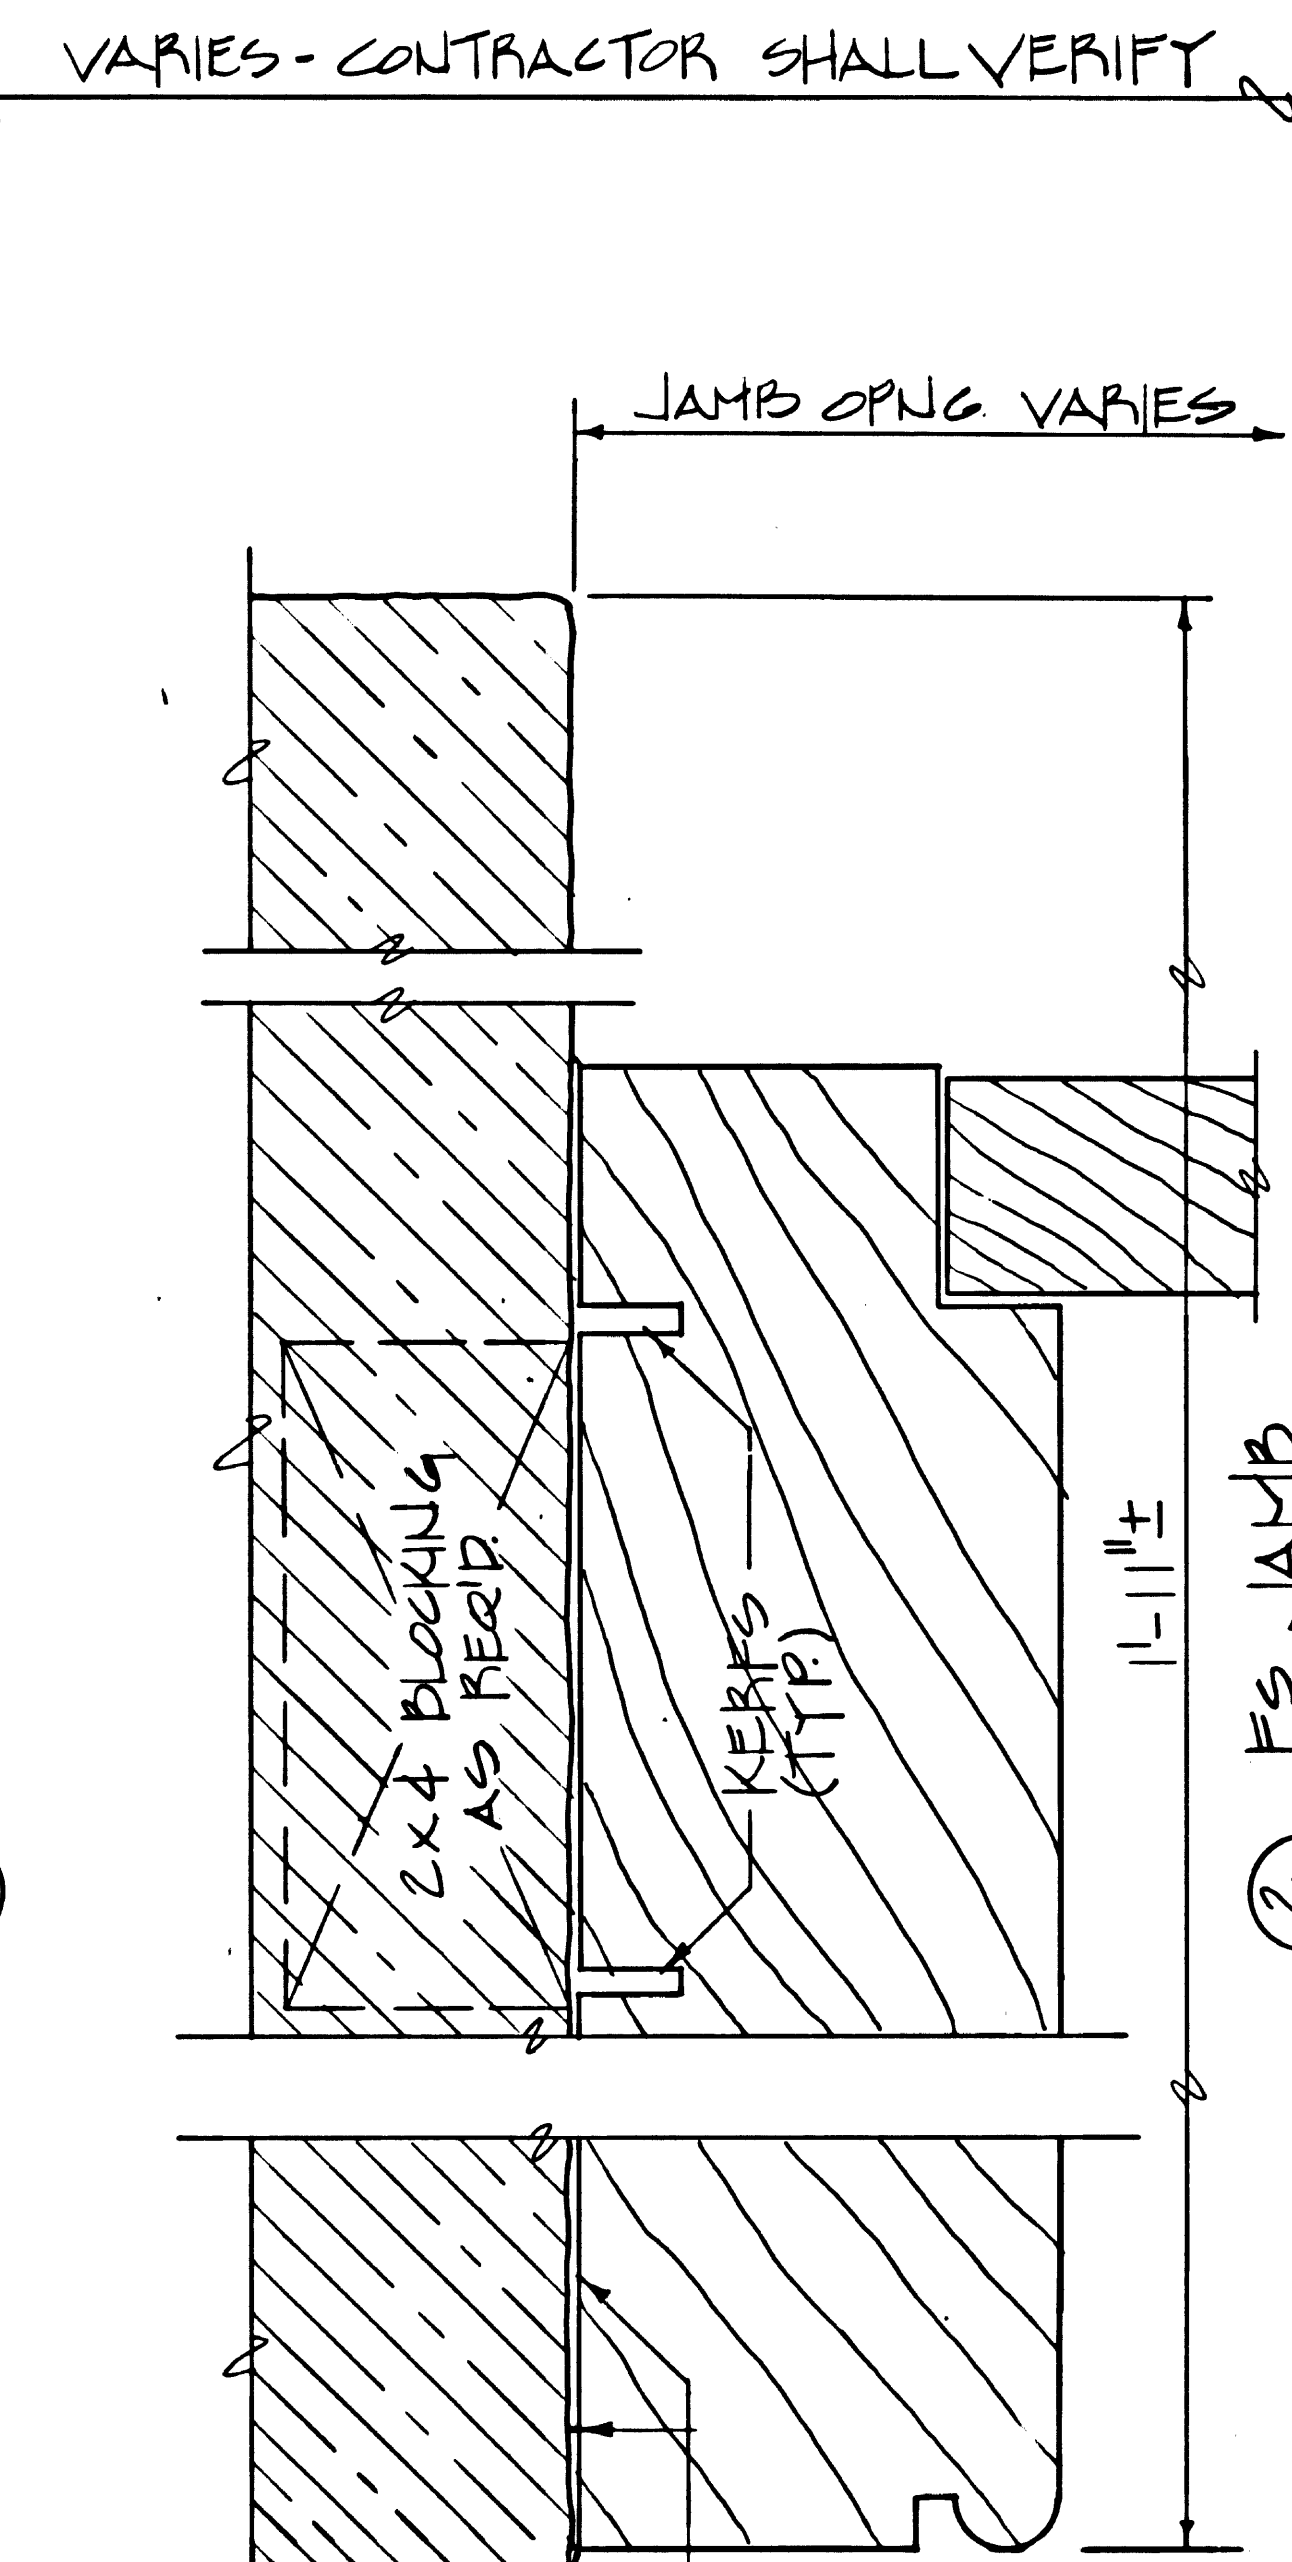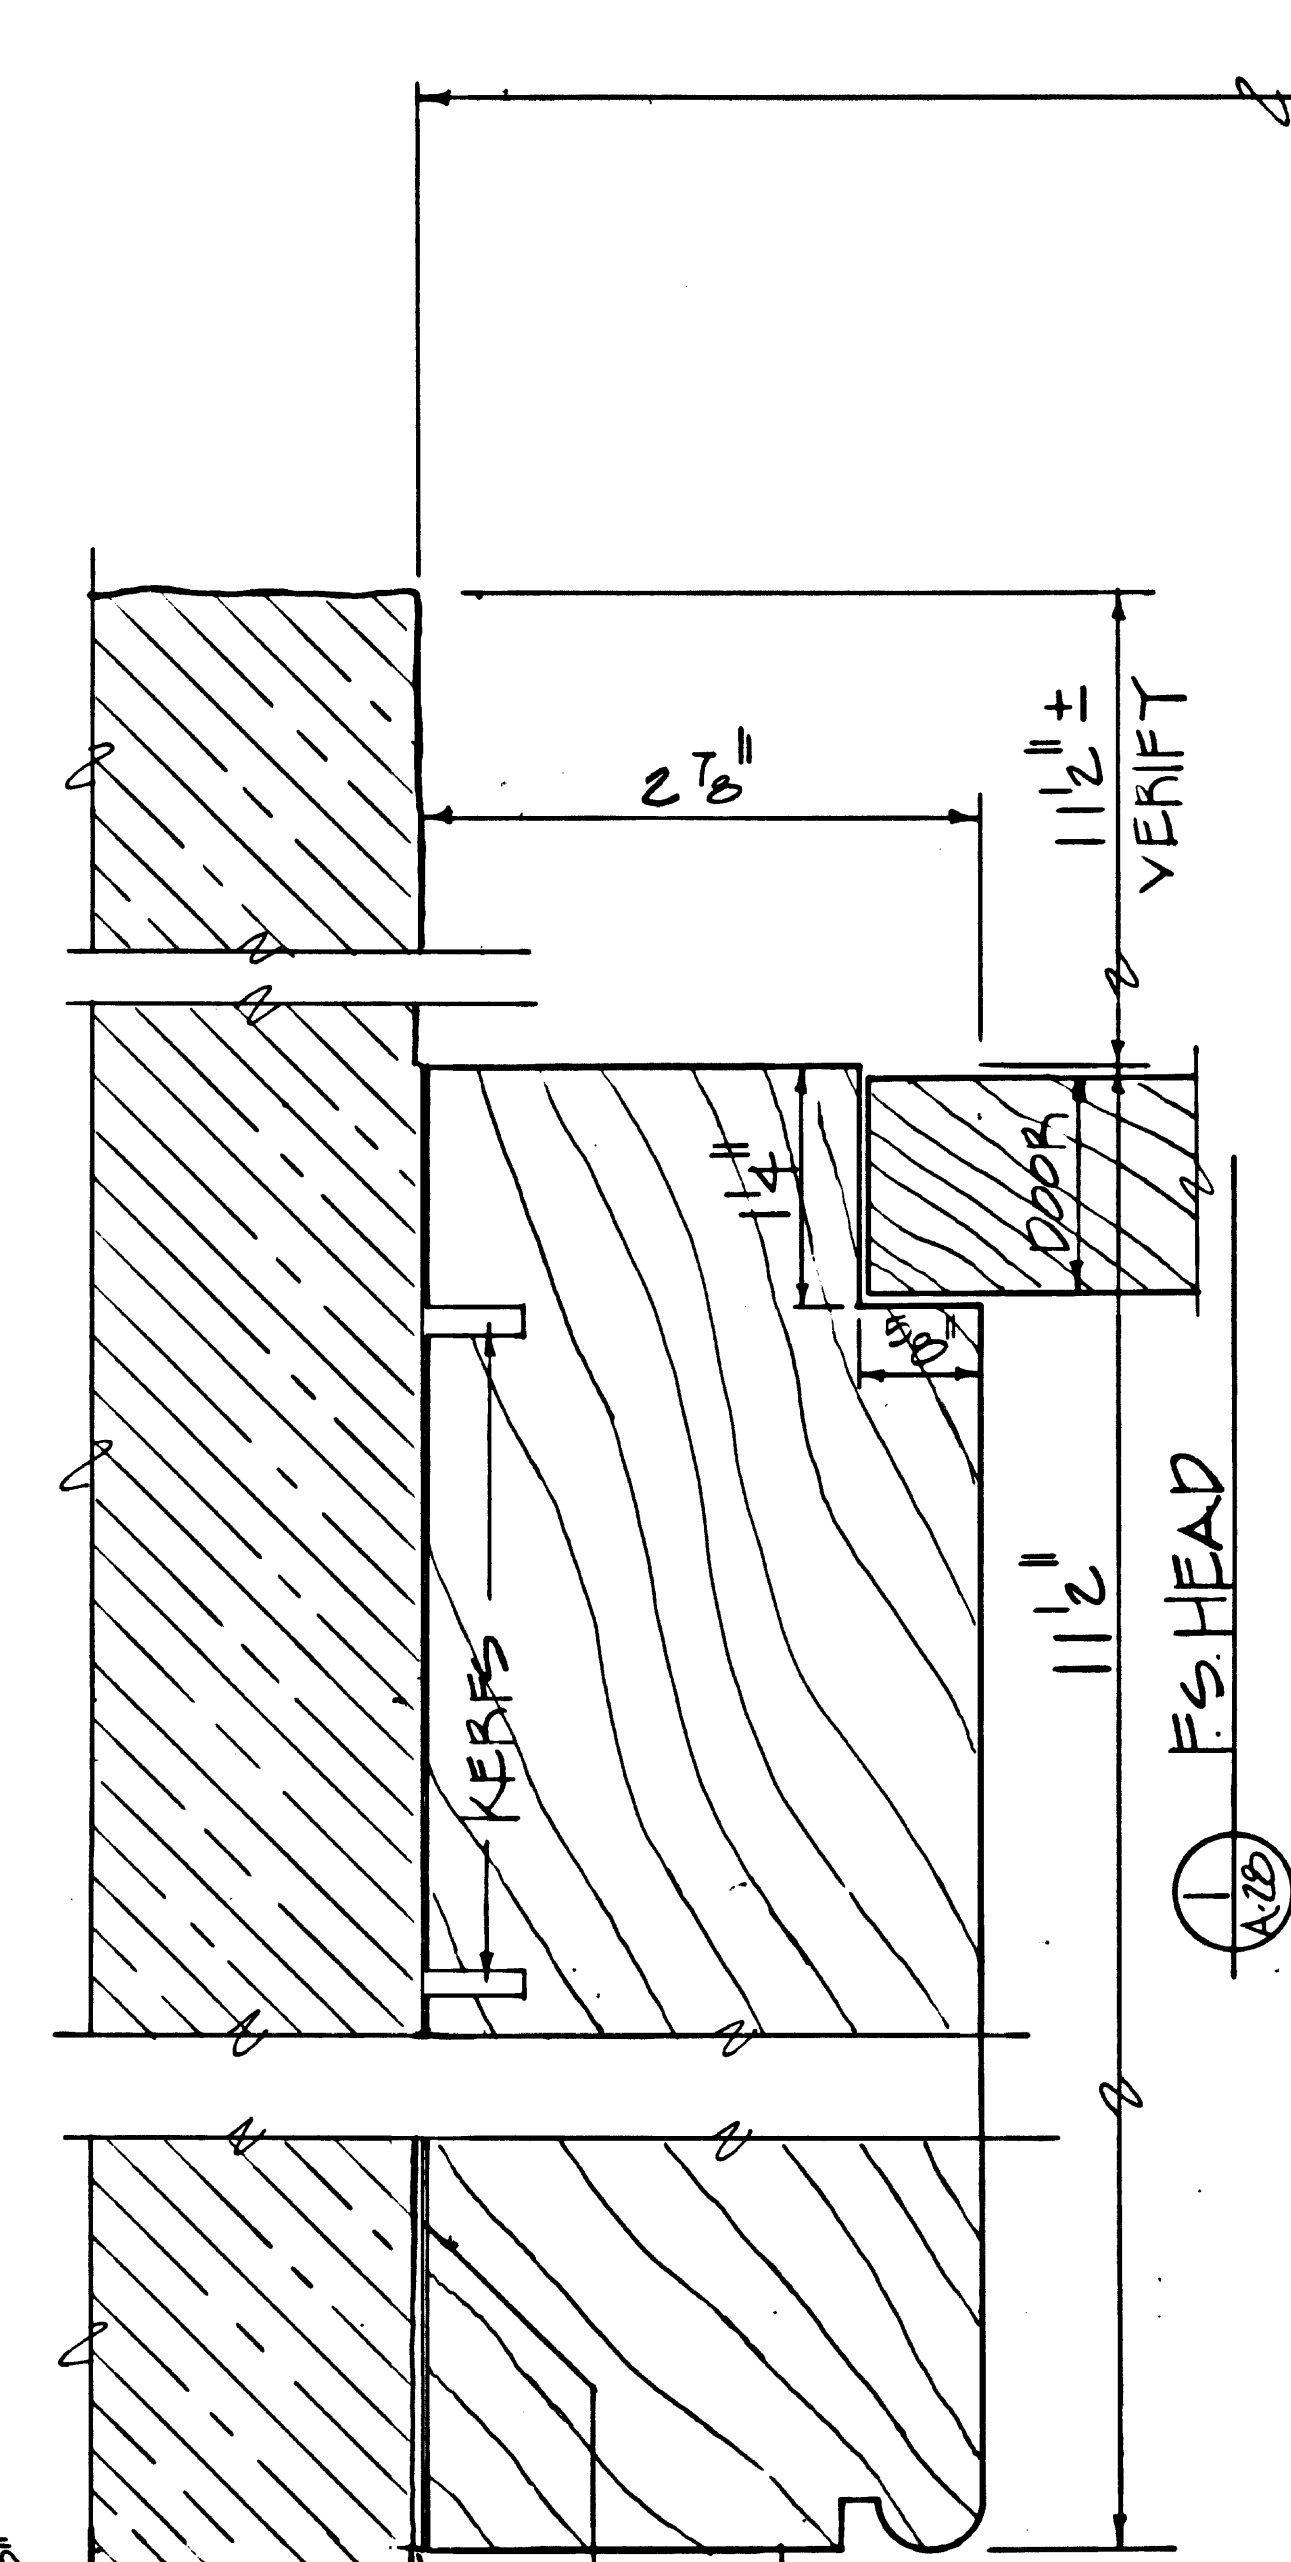



F.S. SILL

A-28		DRAWING NO.	
PREPARED	RSJ/WLB	385	
DESIGNED	COPELAND	25 006A	
DRAWN	BARLOW	110	28
CHECKED	6/78		OF 65
DATE			

Contractor shall verify all dimensions and take own measurements at the job site before commencing work. Advise of any error or discrepancy.

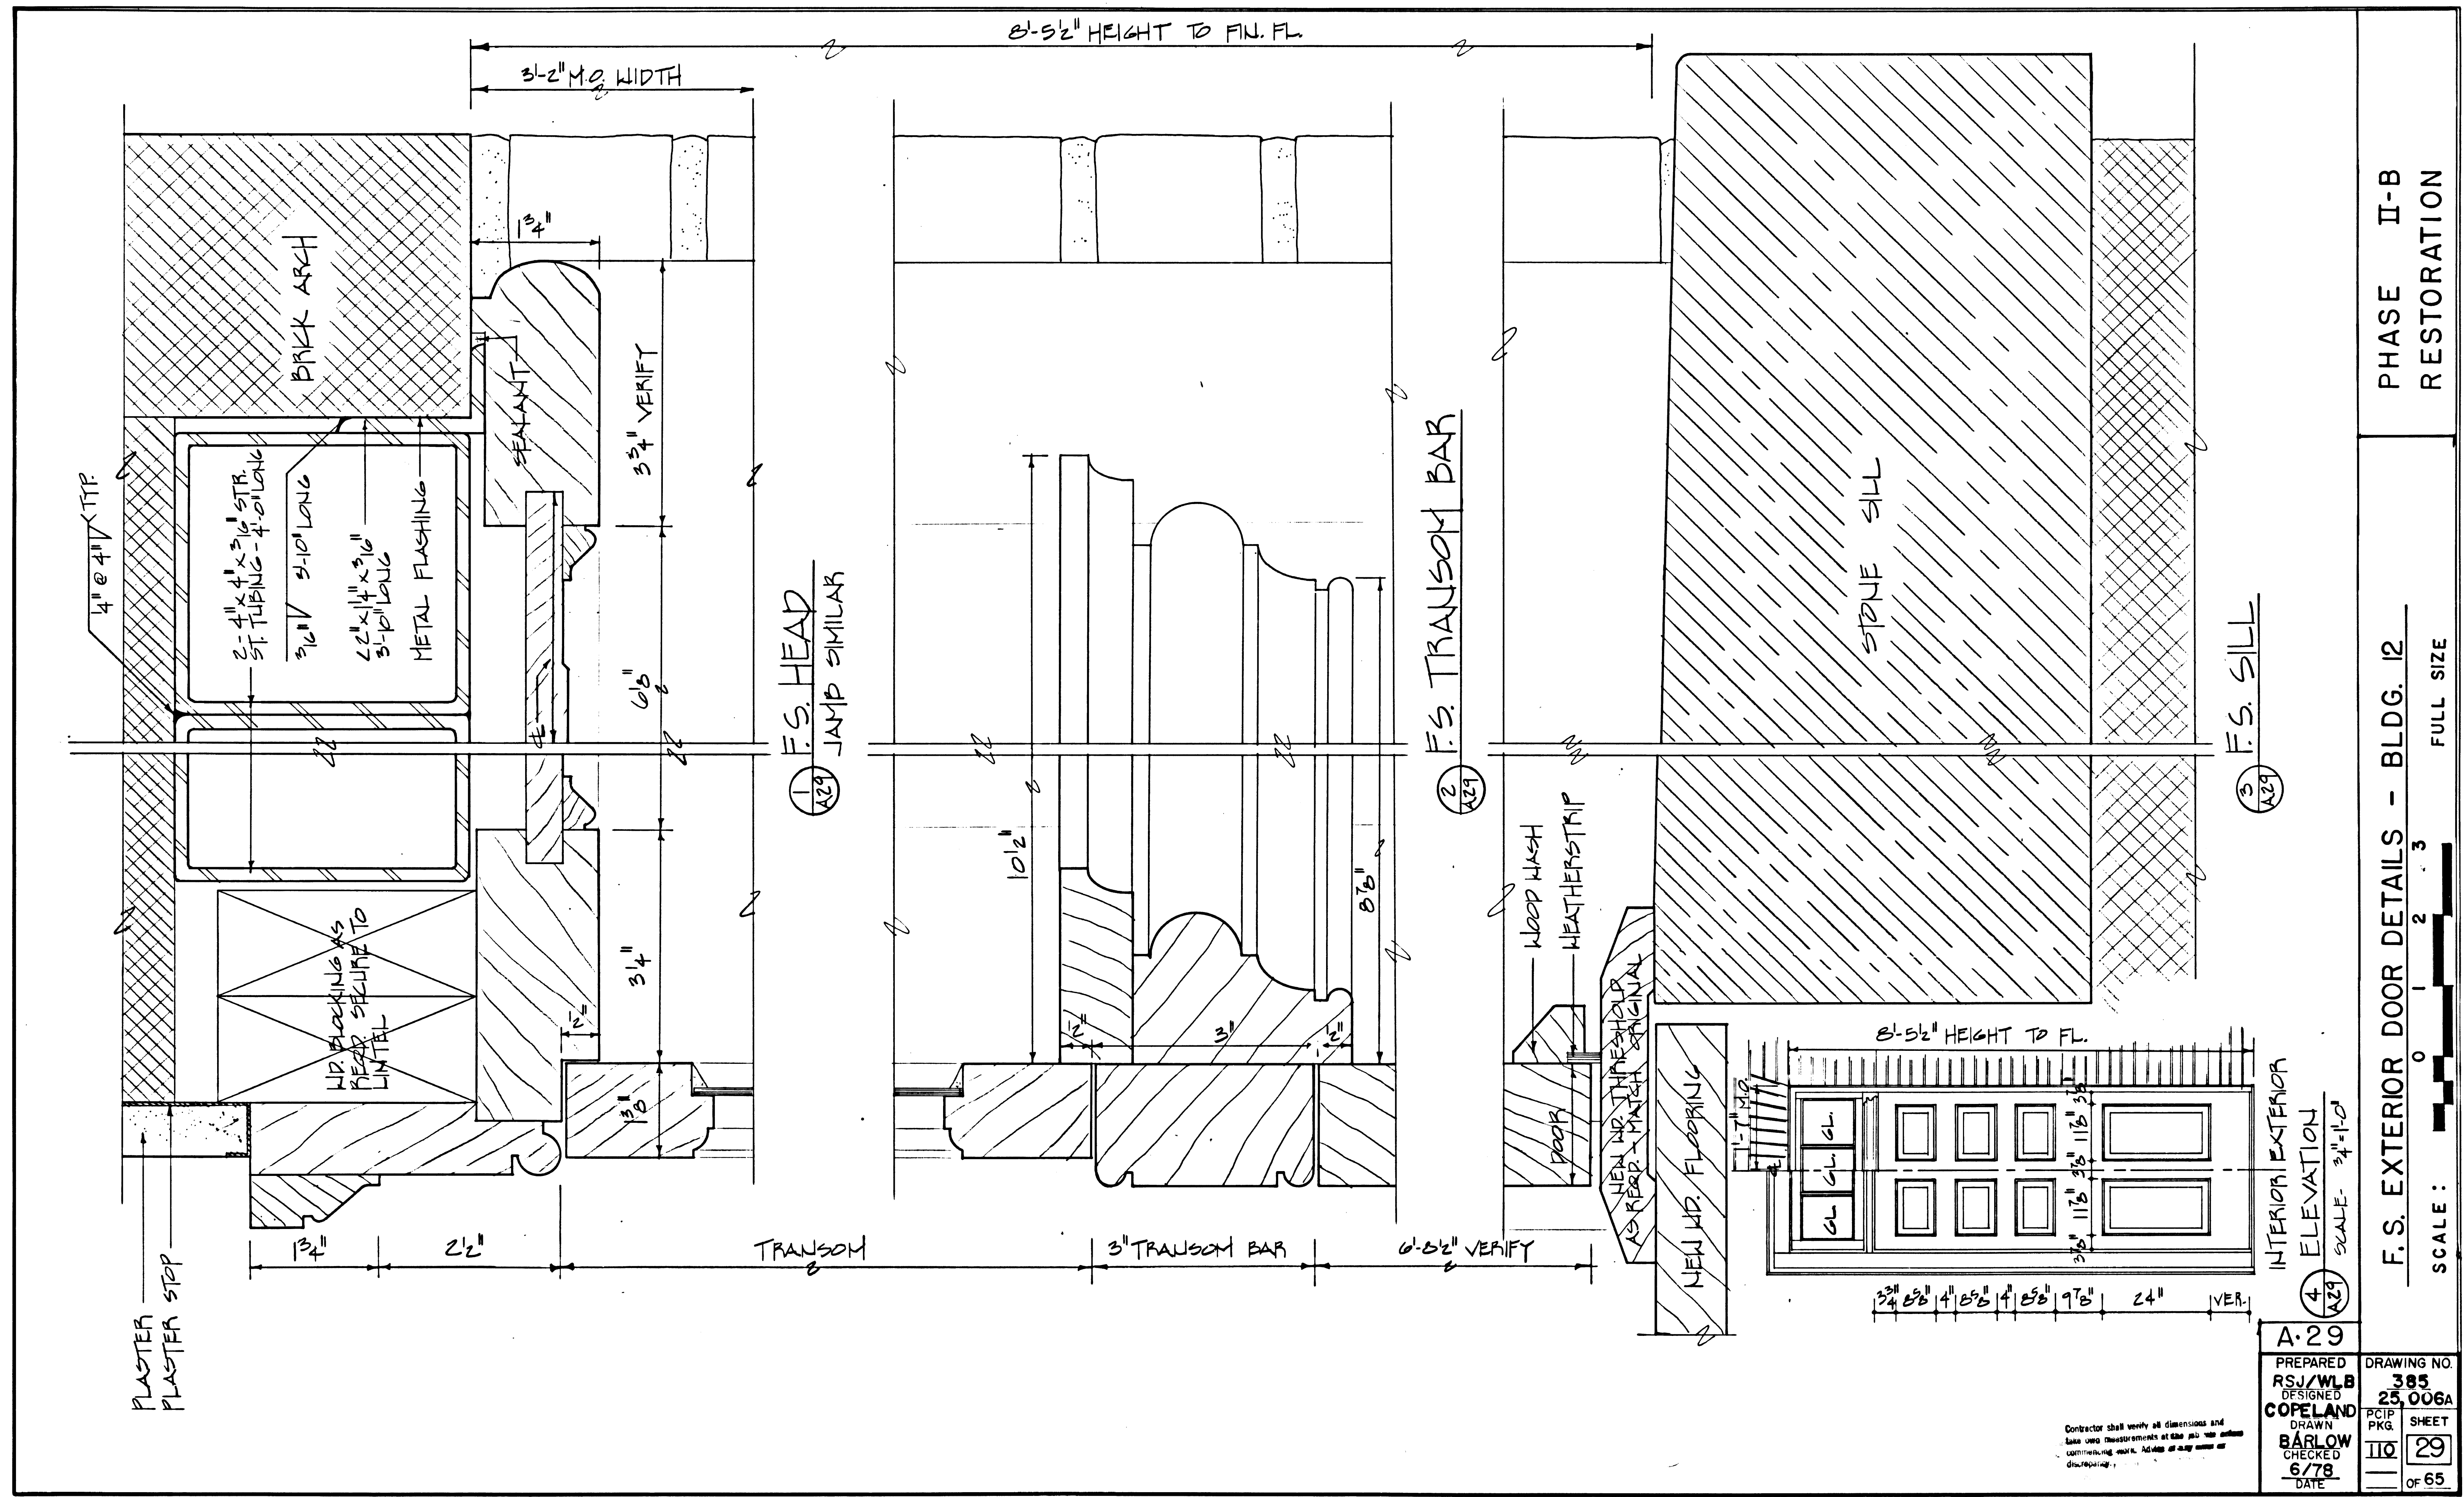

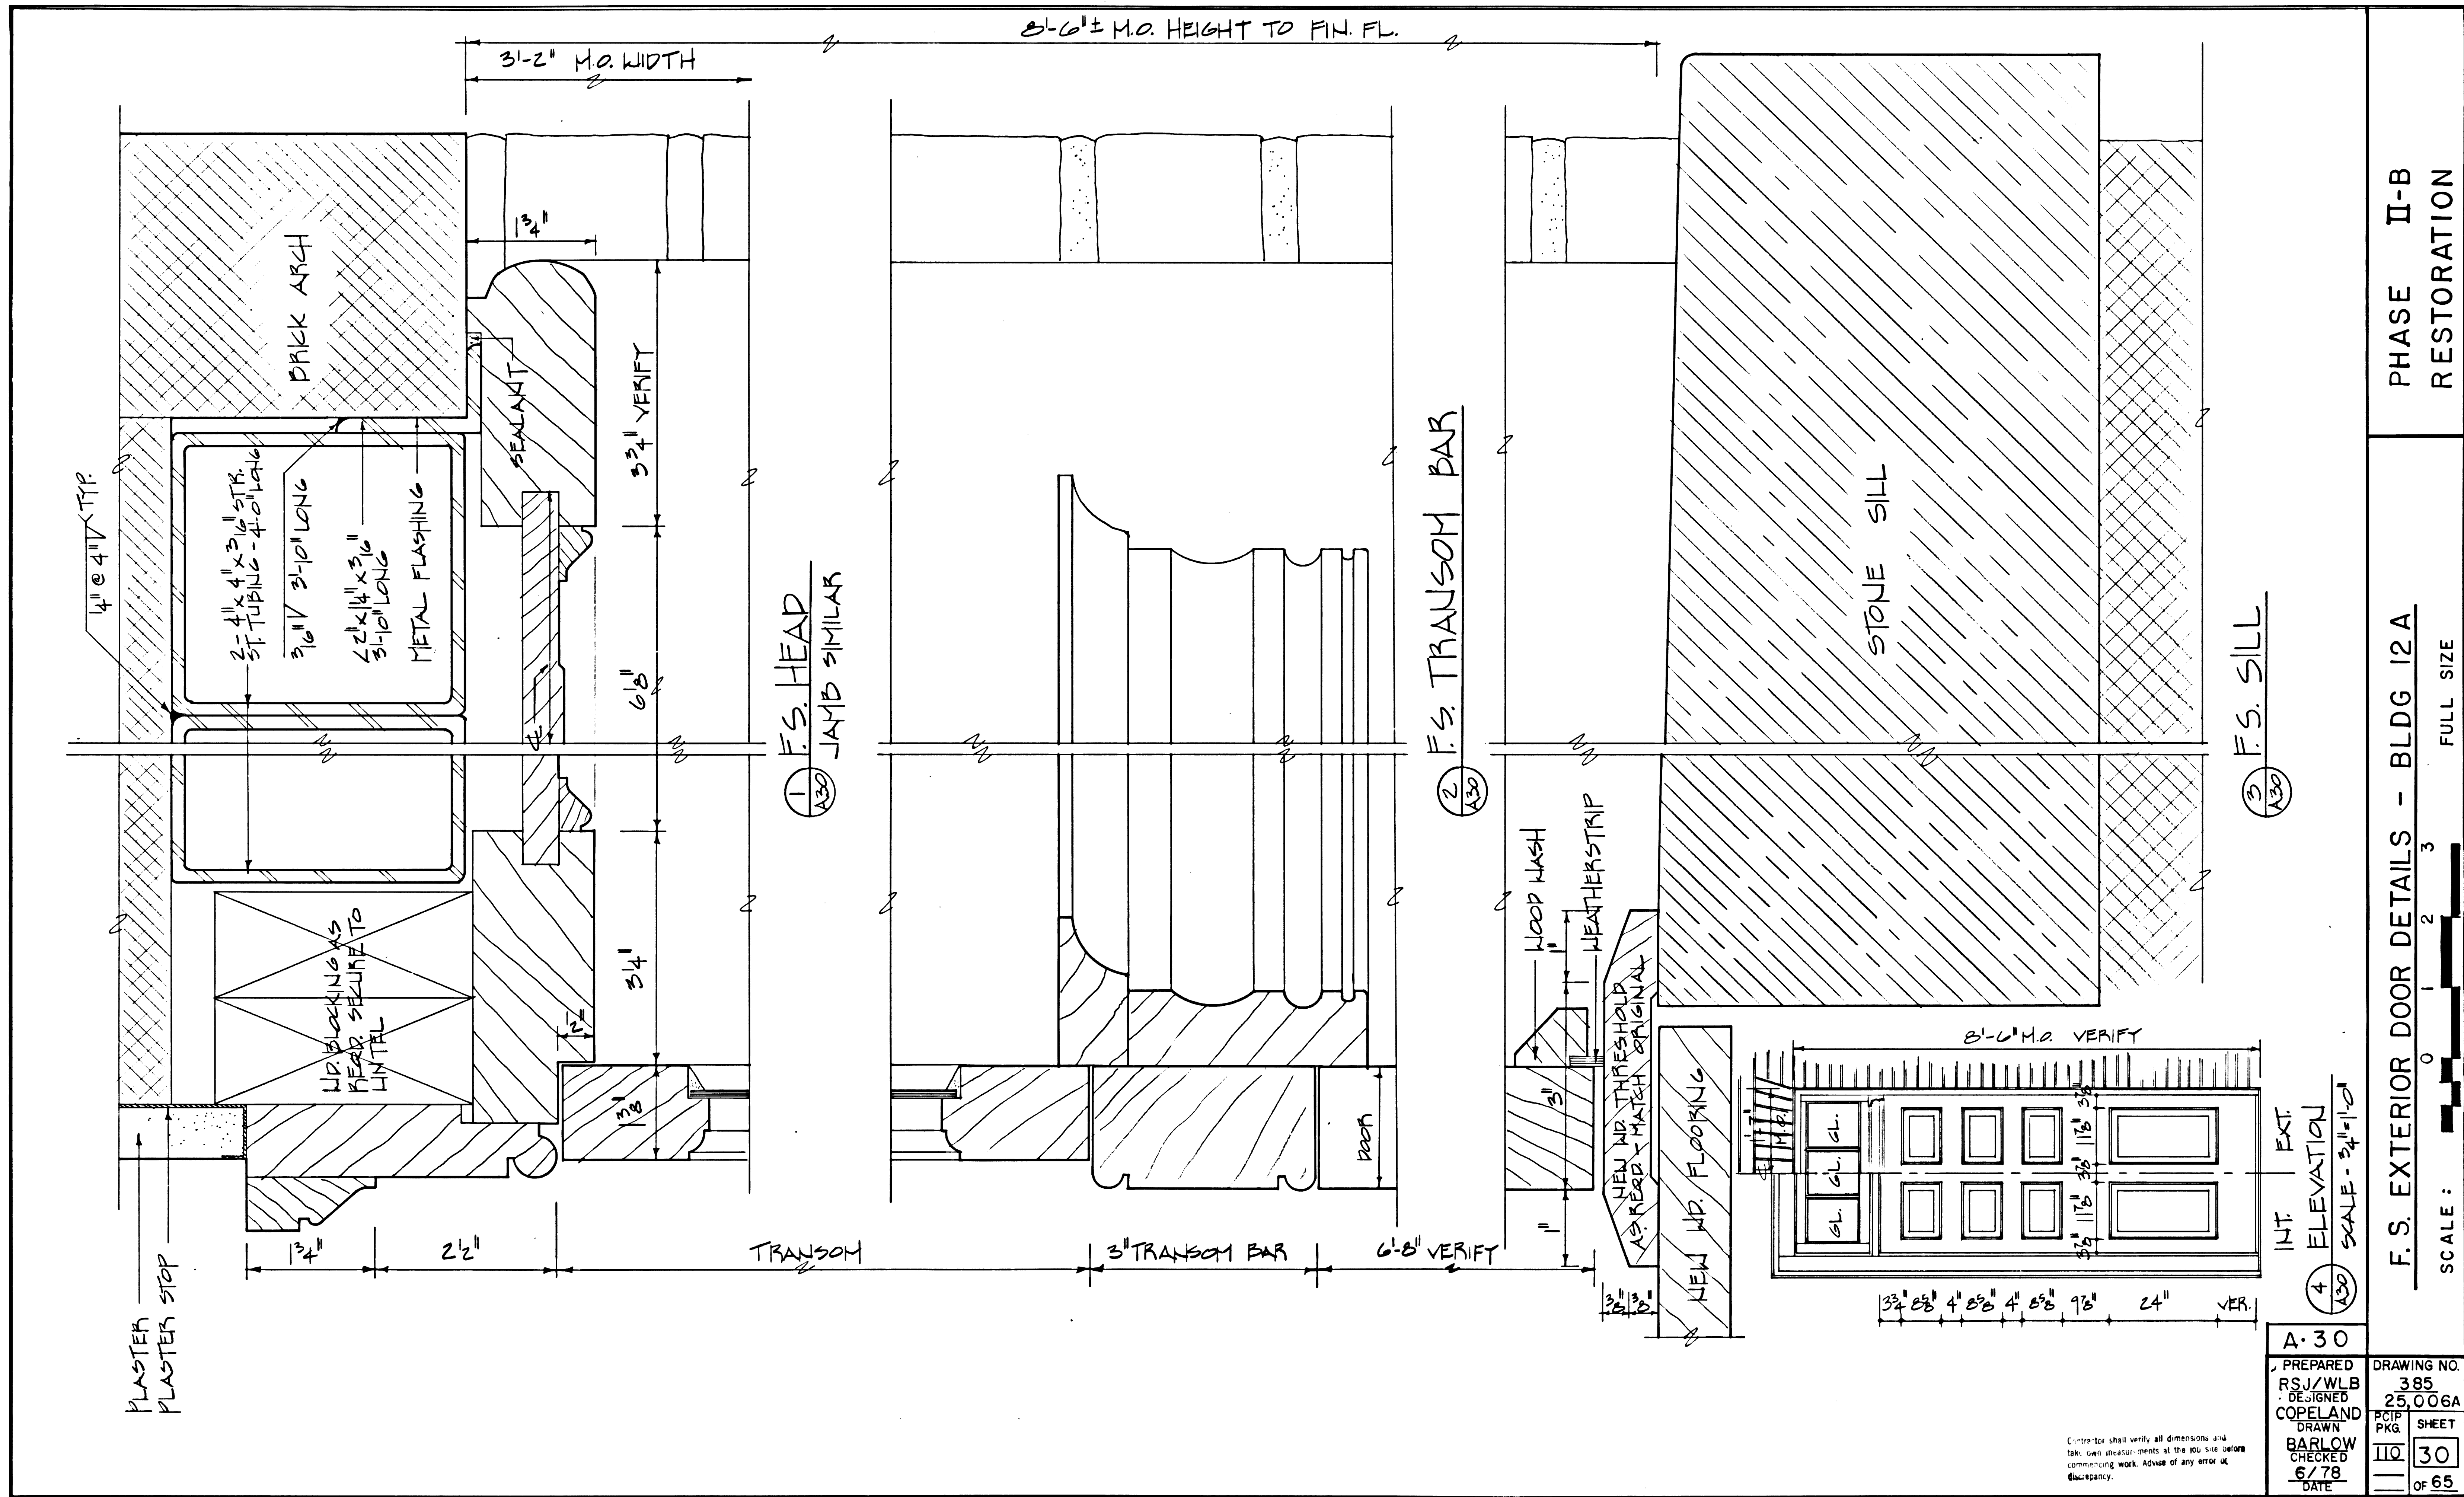

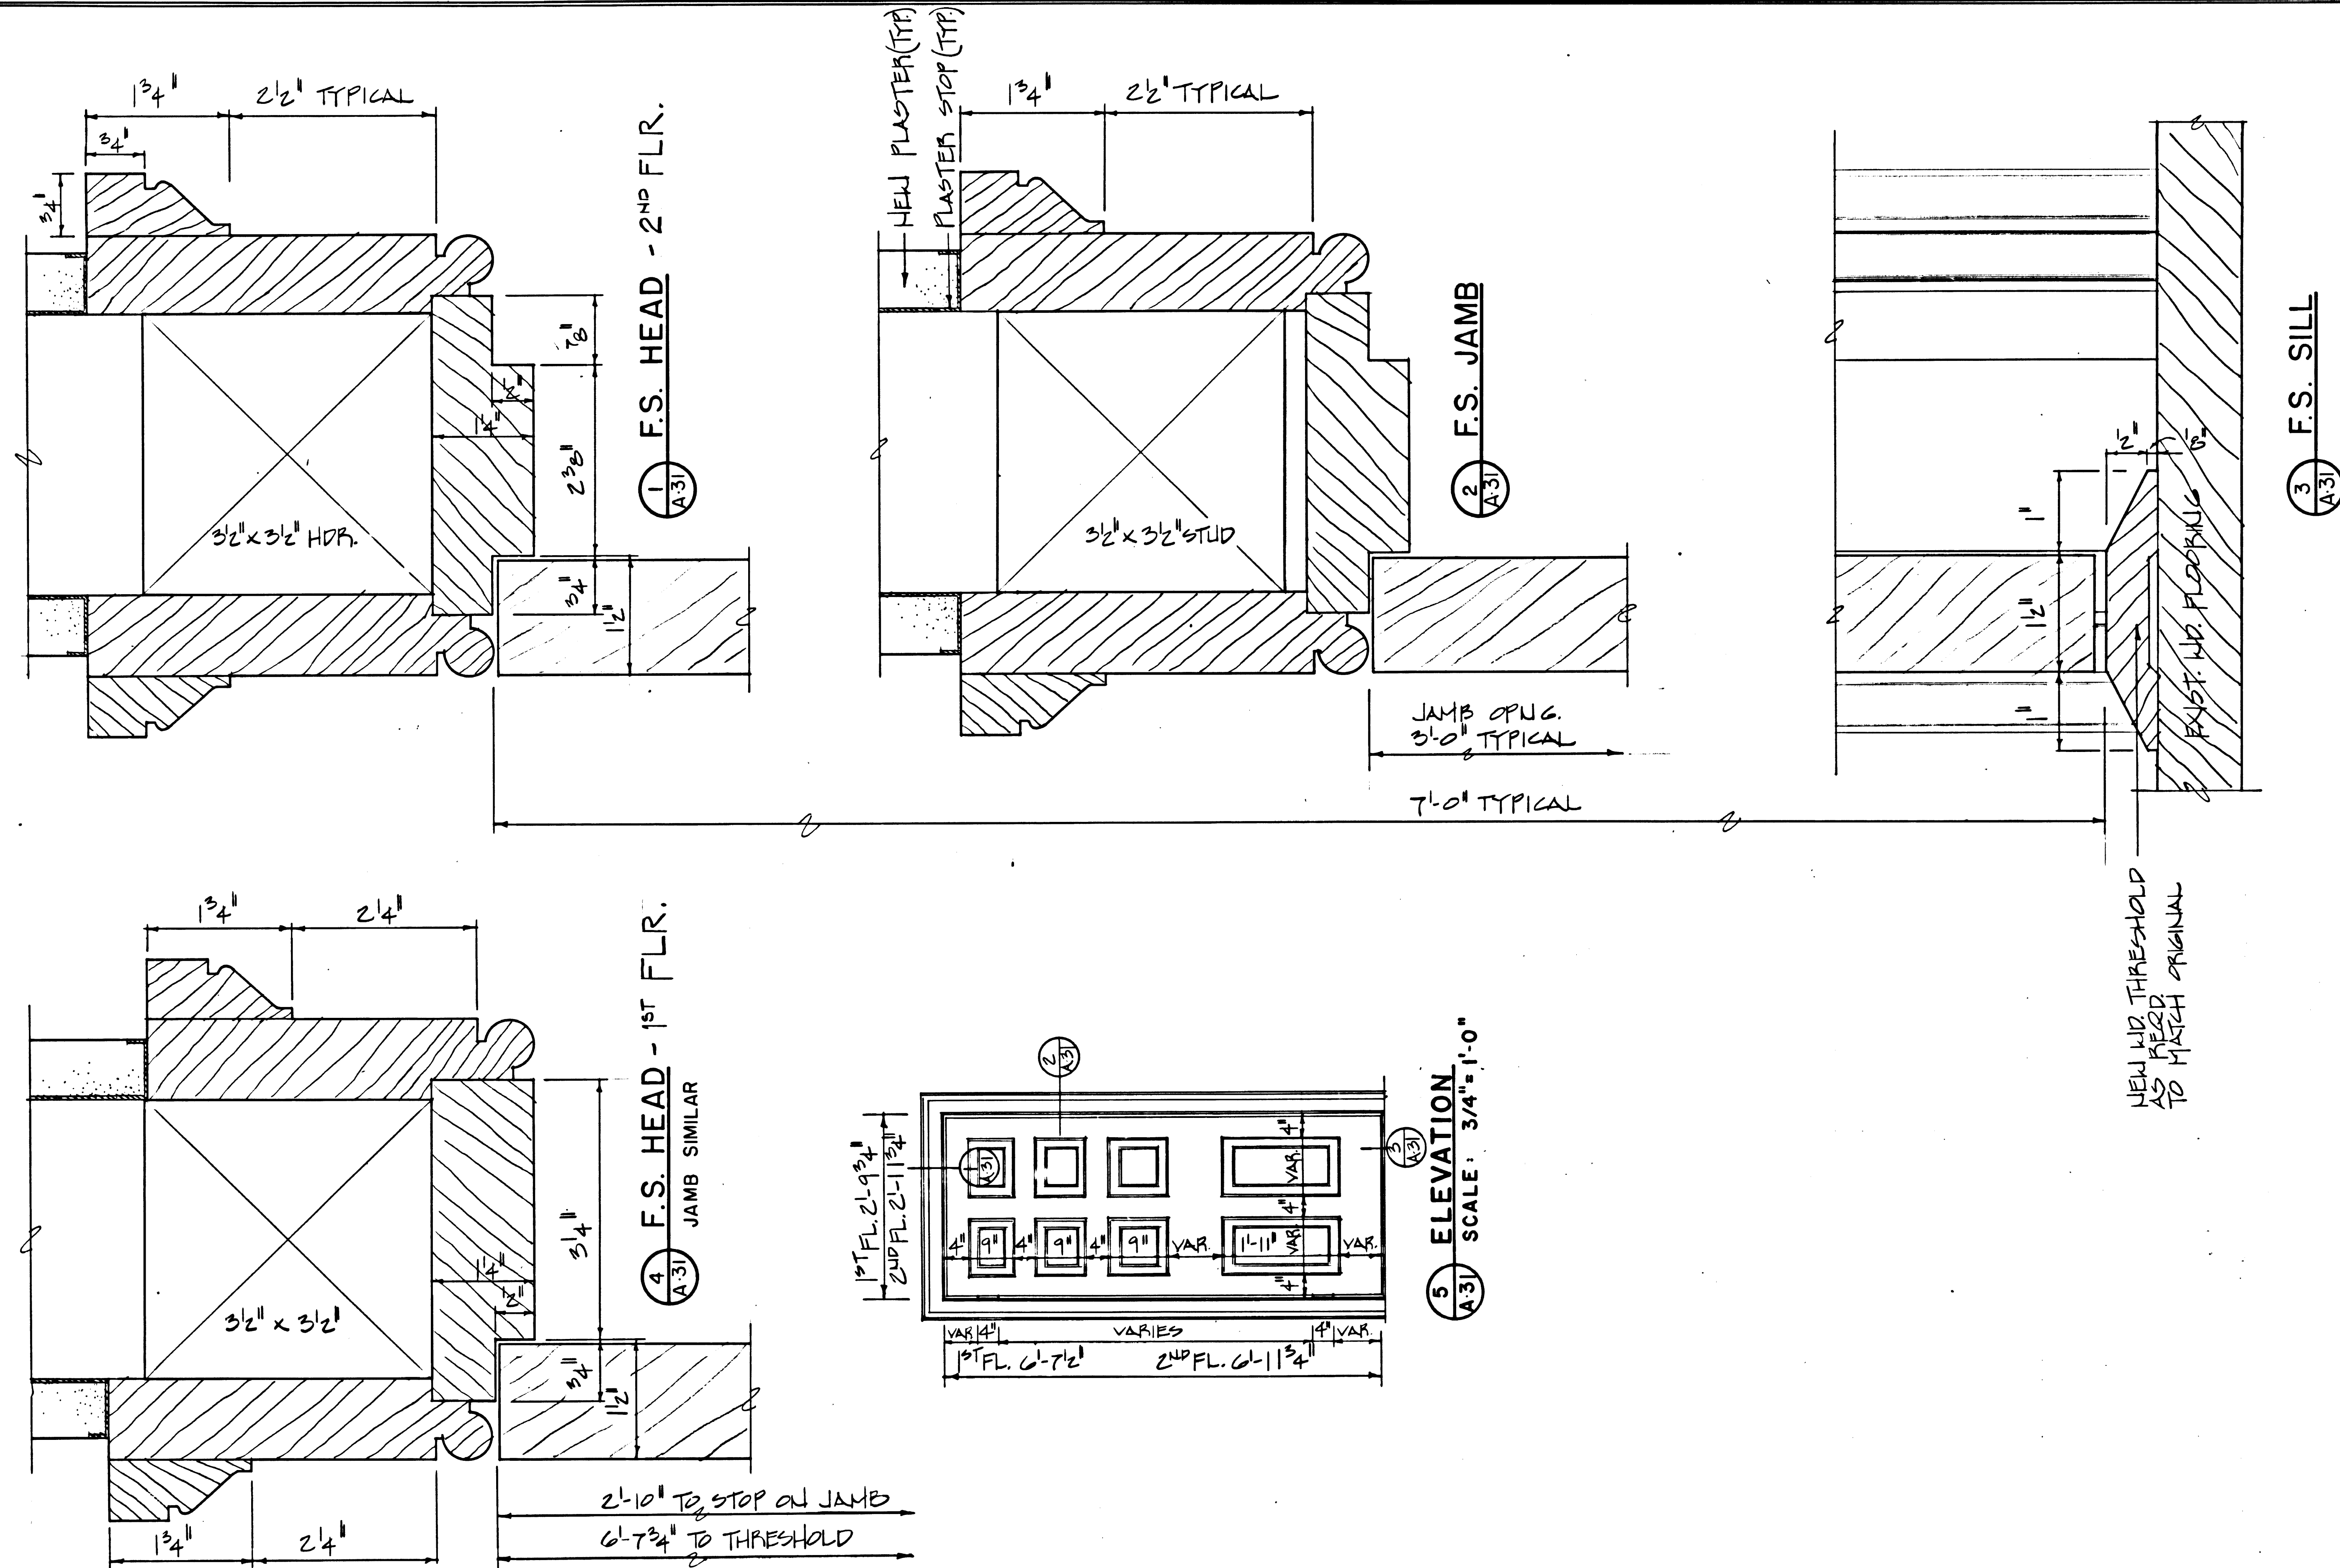



A-31		DRAWING NO.	385
PREPARED	RSJ/WLB	DESIGNED	25.006A
COPELAND	DRAWN	PKG	SHEET
BARLOW	CHECKED	110	31
6/78	DATE	OF 65	

Contractor shall verify all dimensions and take own measurements at the job site before commencing work. Advise of any error or discrepancy.

PHASE II-B
RESTORATION

F.S. INTERIOR DOOR DETAILS - BLDG 12
SCALE 0 1 2 3 FULL SIZE

4 GPO 1977 777-589

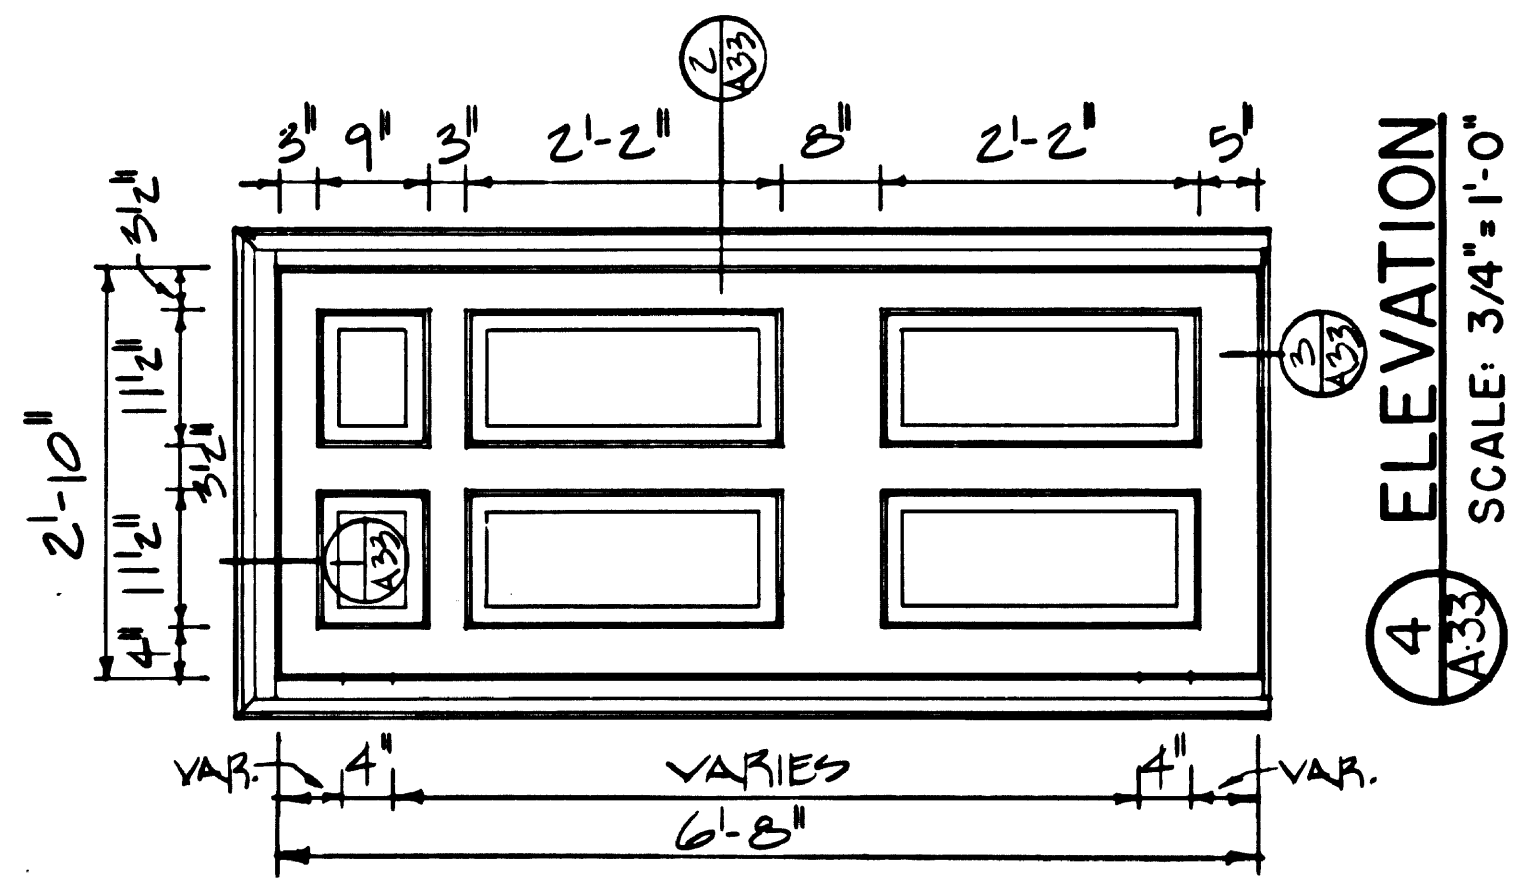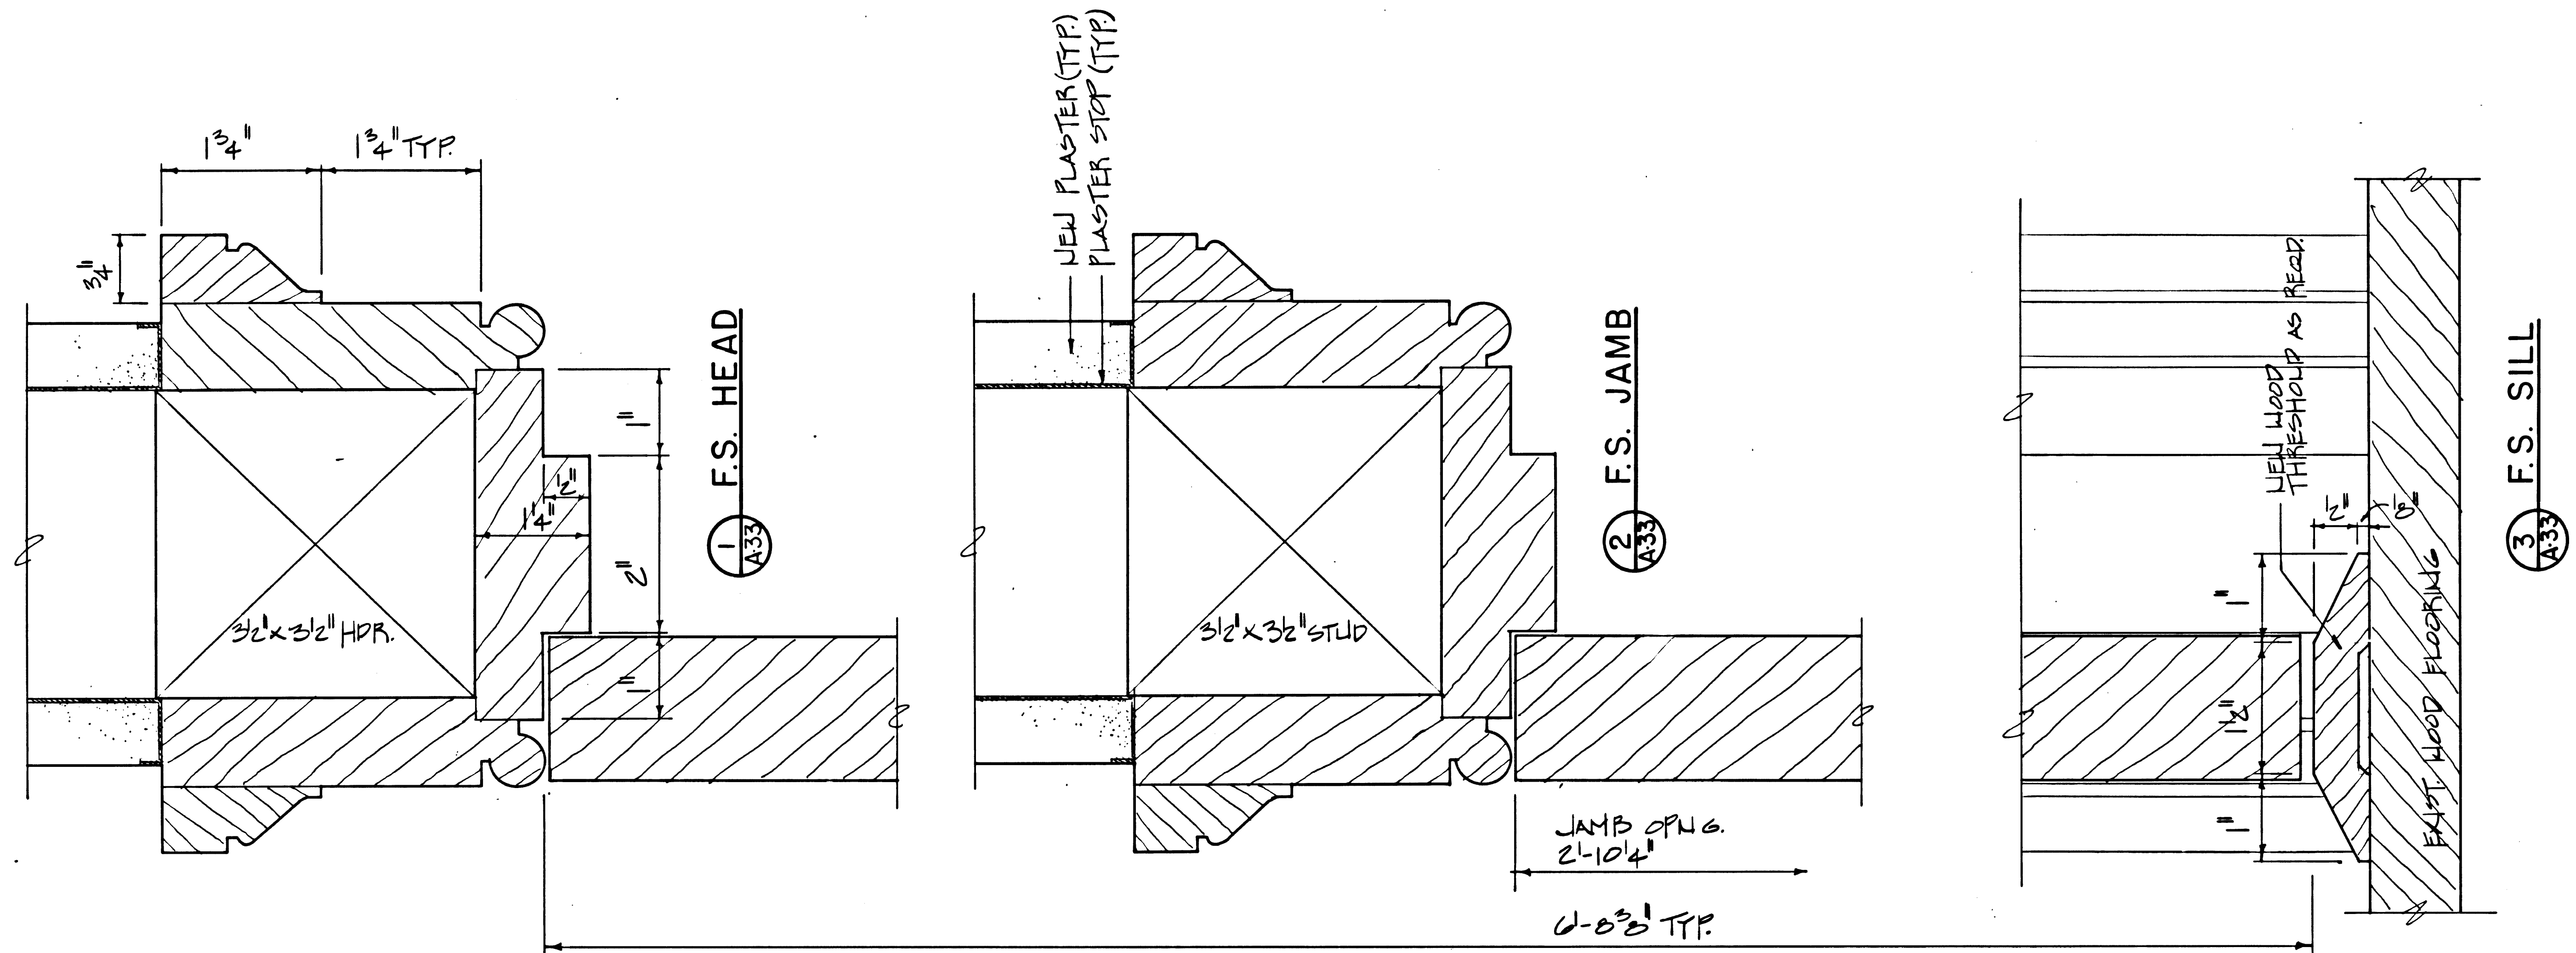



Contractor shall verify all dimensions and take own measurements at the job site before commencing work. Advise of any error or discrepancy.


A-33		DRAWING NO.
PREPARED	RSJ/WLB	385
DESIGNED	COPELAND	25.006A
DRAWN	BARLOW	110
CHECKED	6/78	33
DATE		OF 65




F.S. INTERIOR DOOR DETAILS - BLDG 12A

PHASE II-B
RESTORATION

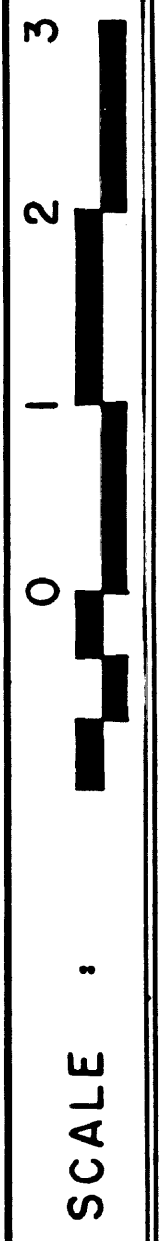

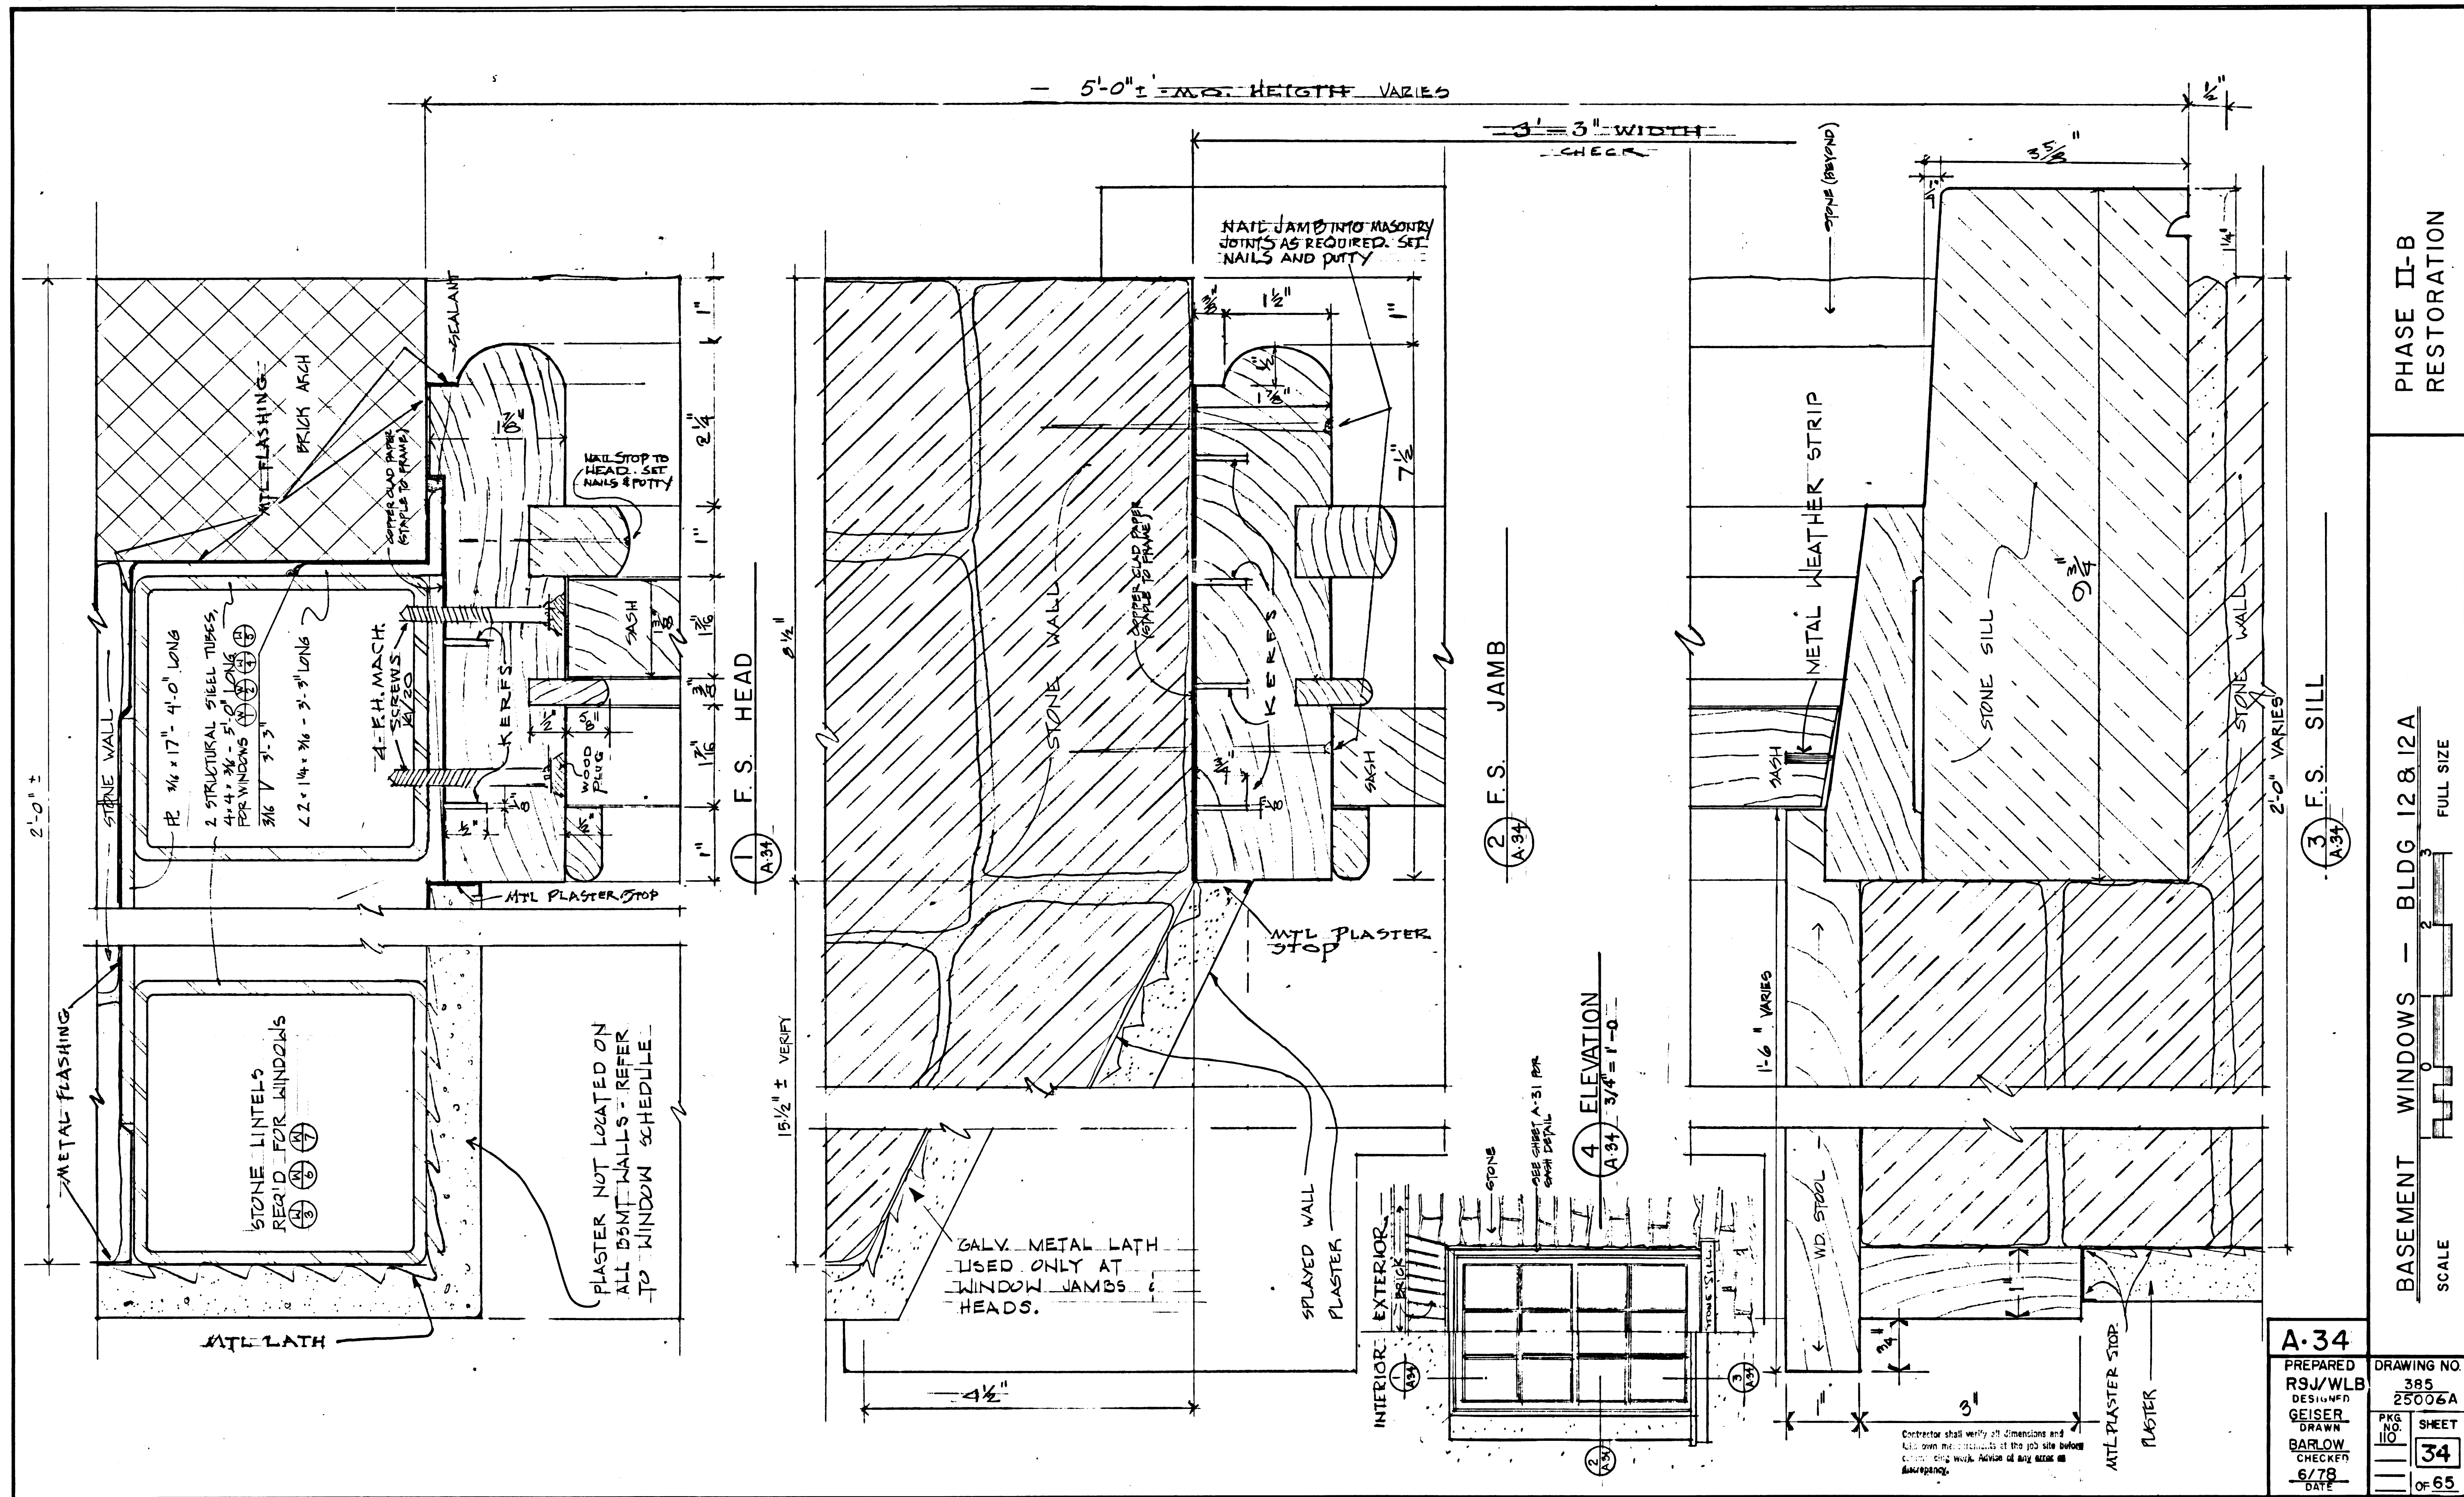

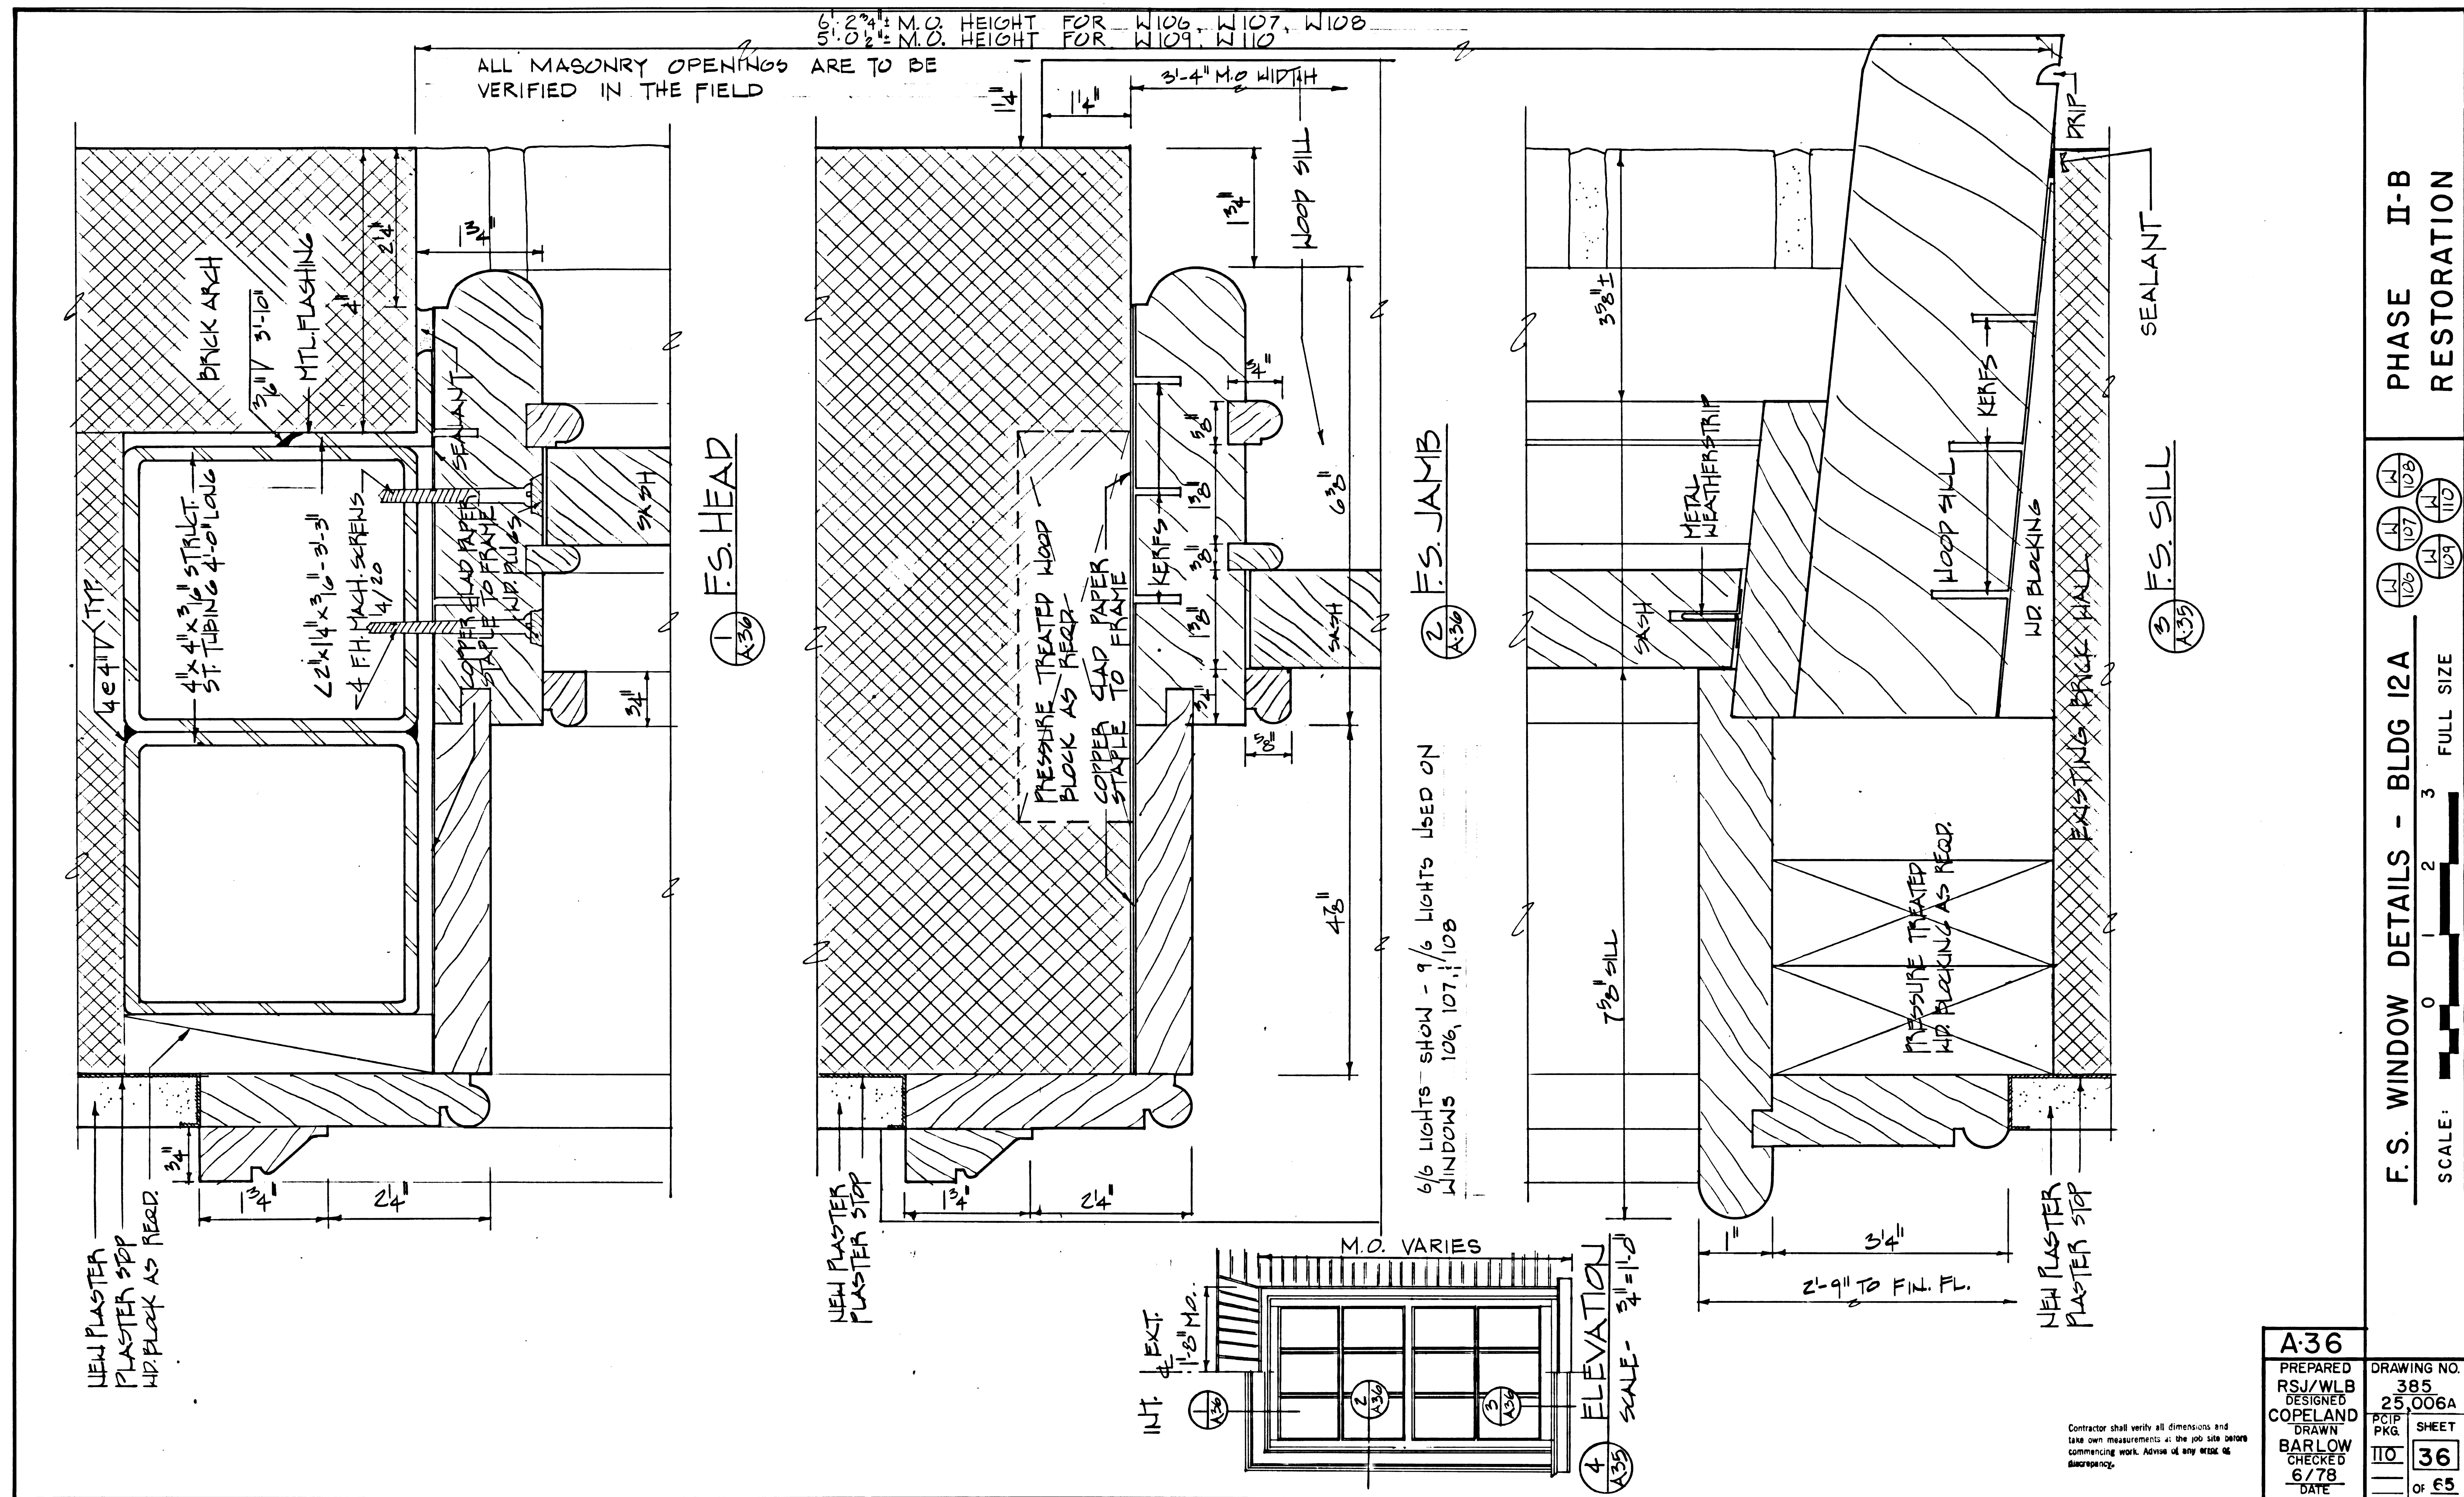

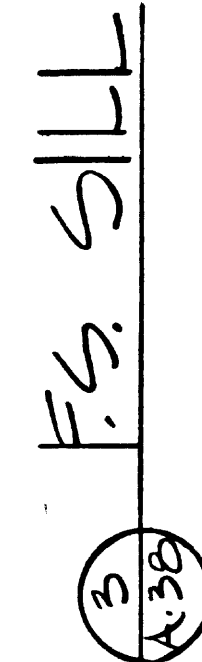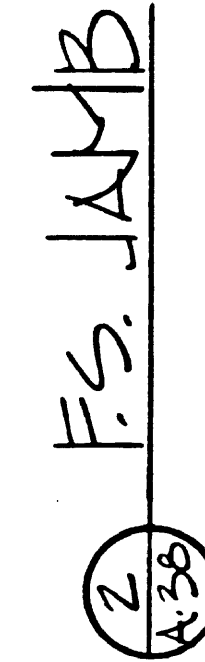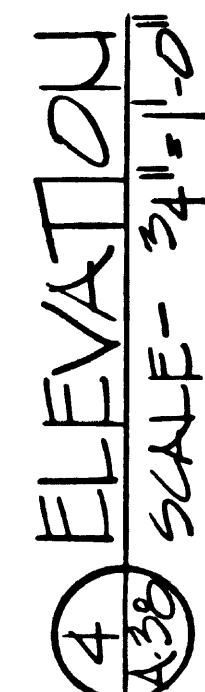

A-38
PREPARED
RSJ/WLB
DESIGNED
COPELAND
DRAWN
BARLOW
CHECKED
6/78
DATE




DRAWING NO.	
385	
25.006A	
PCIP PKG.	SHEET
110	38
	OF 65

PHASE II-B RESTORATION

F.S. WINDOW DETAILS - BLDG 12A

SCALE: 0 1 2 3 FULL SIZE

Contractor shall verify all dimensions and take own measurements at the job site before commencing work. Advice of any error or discrepancy.

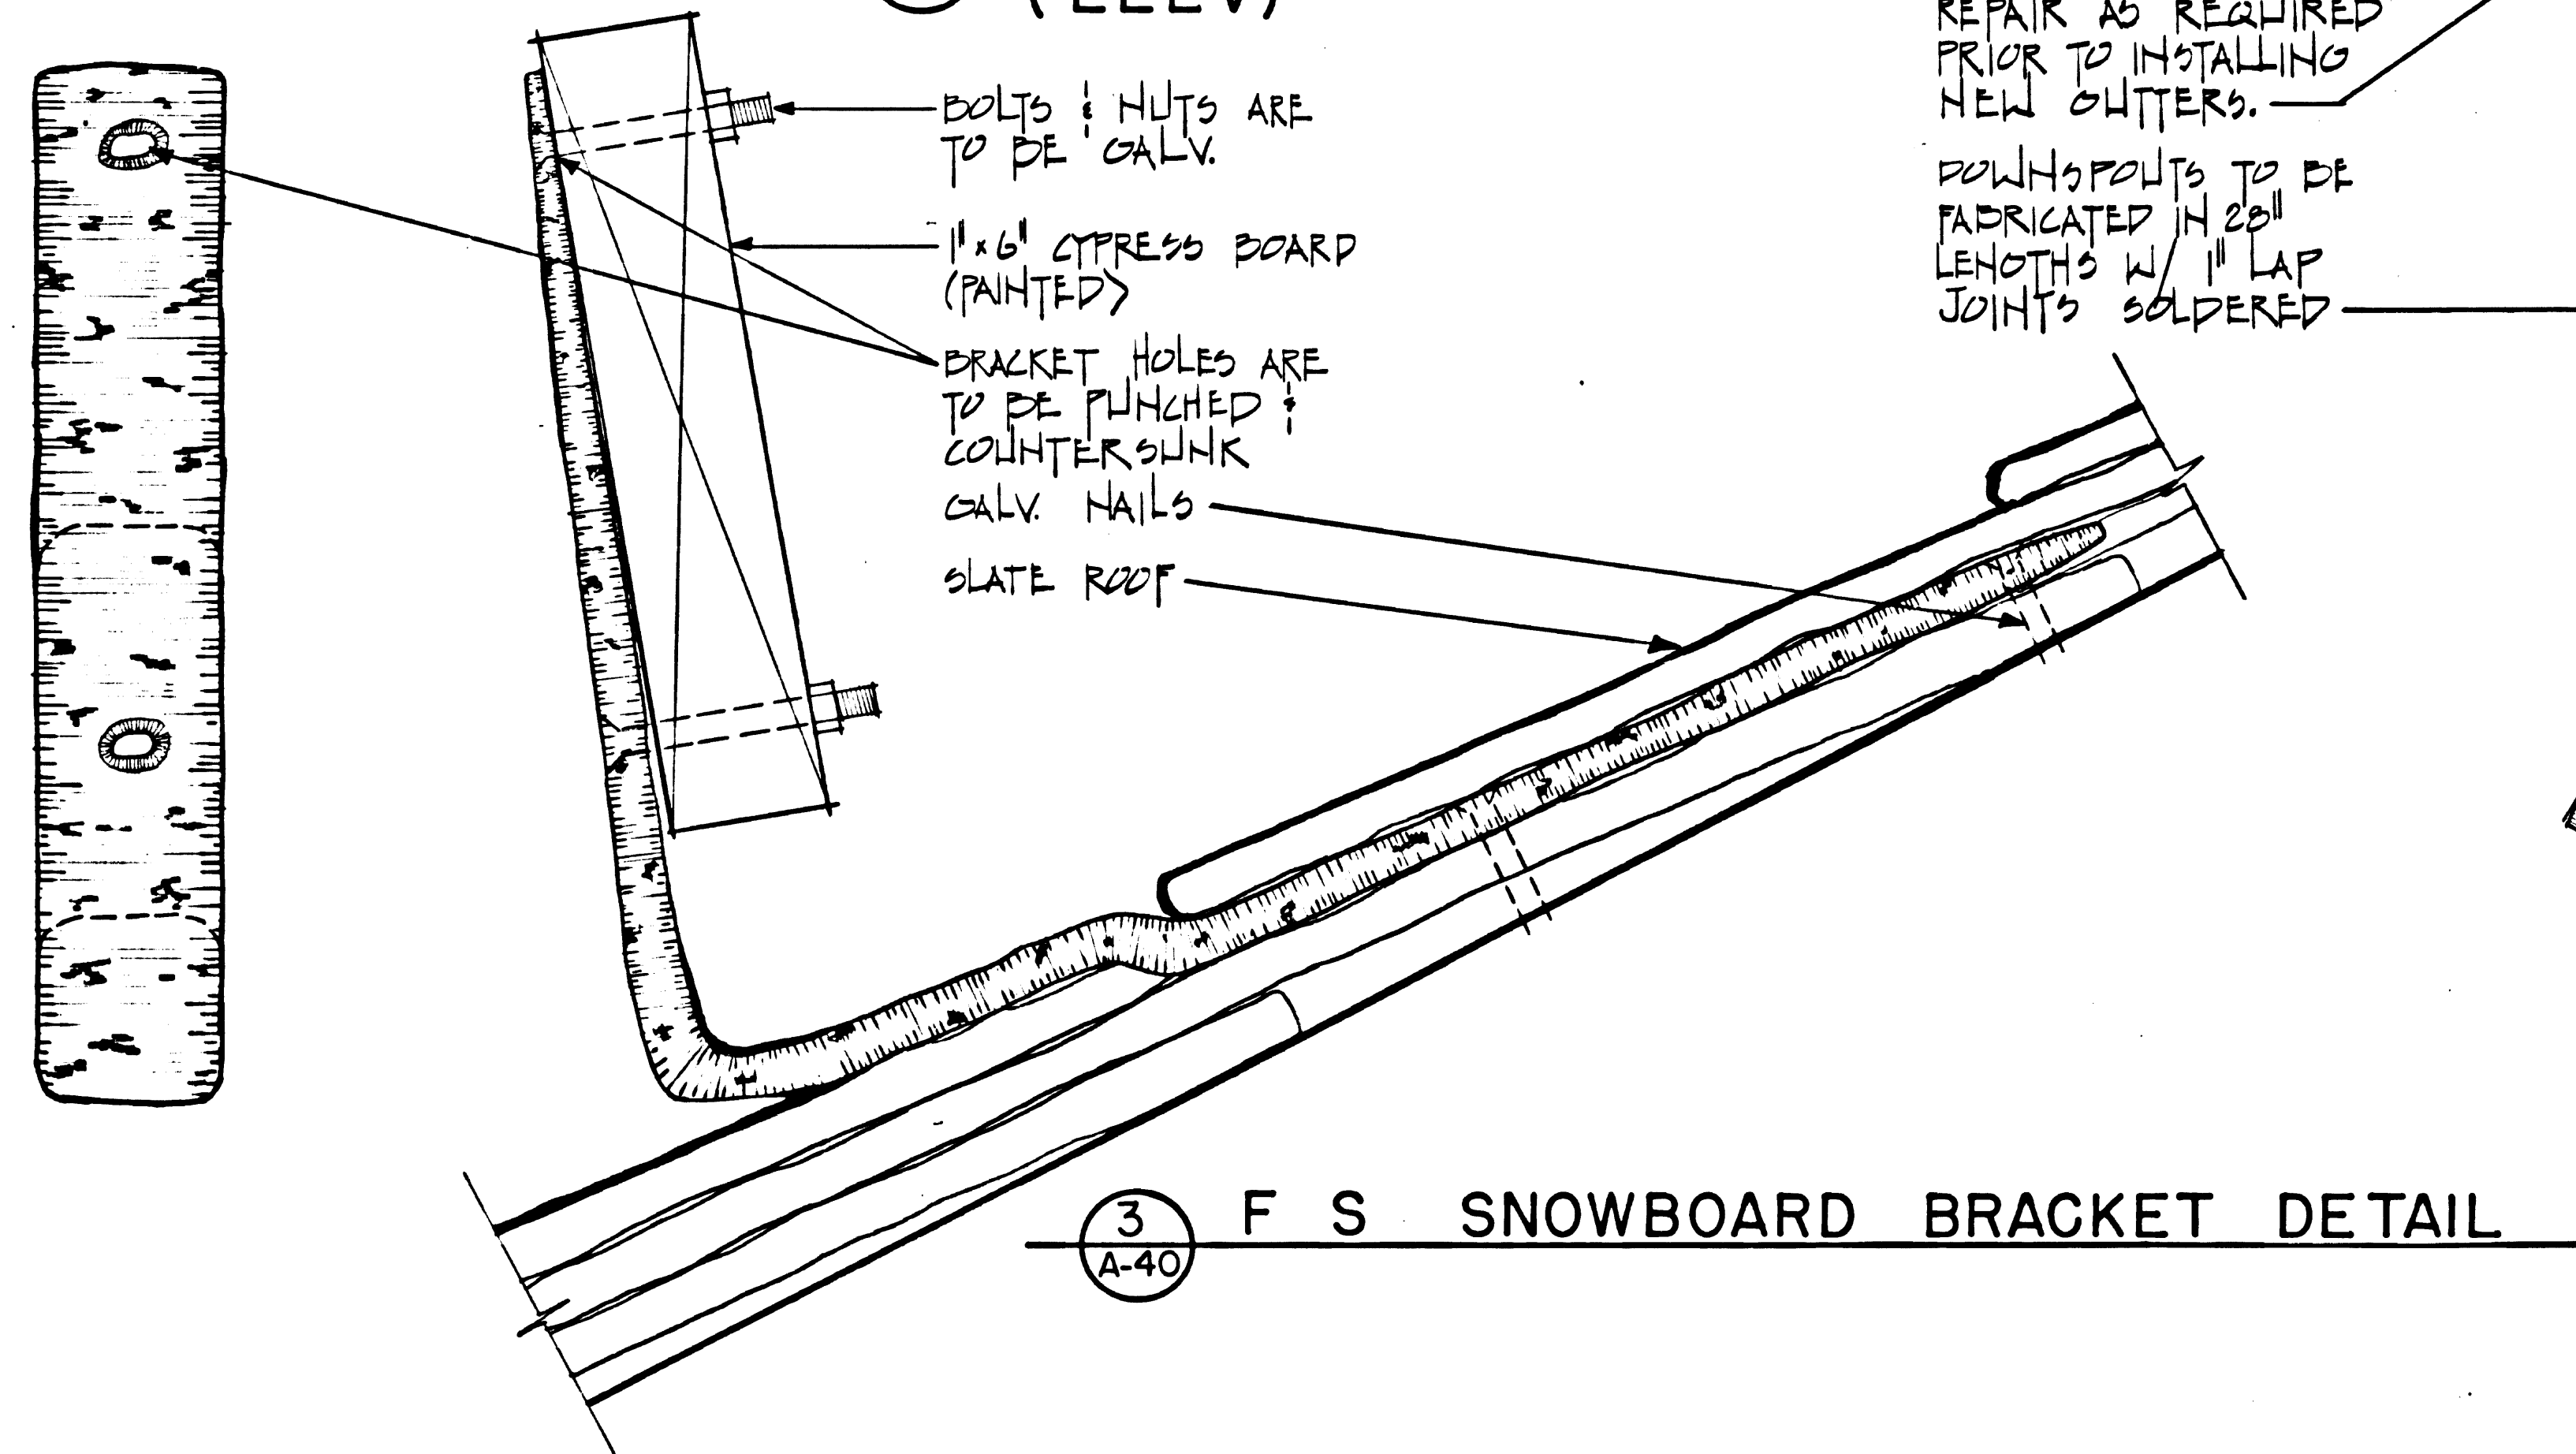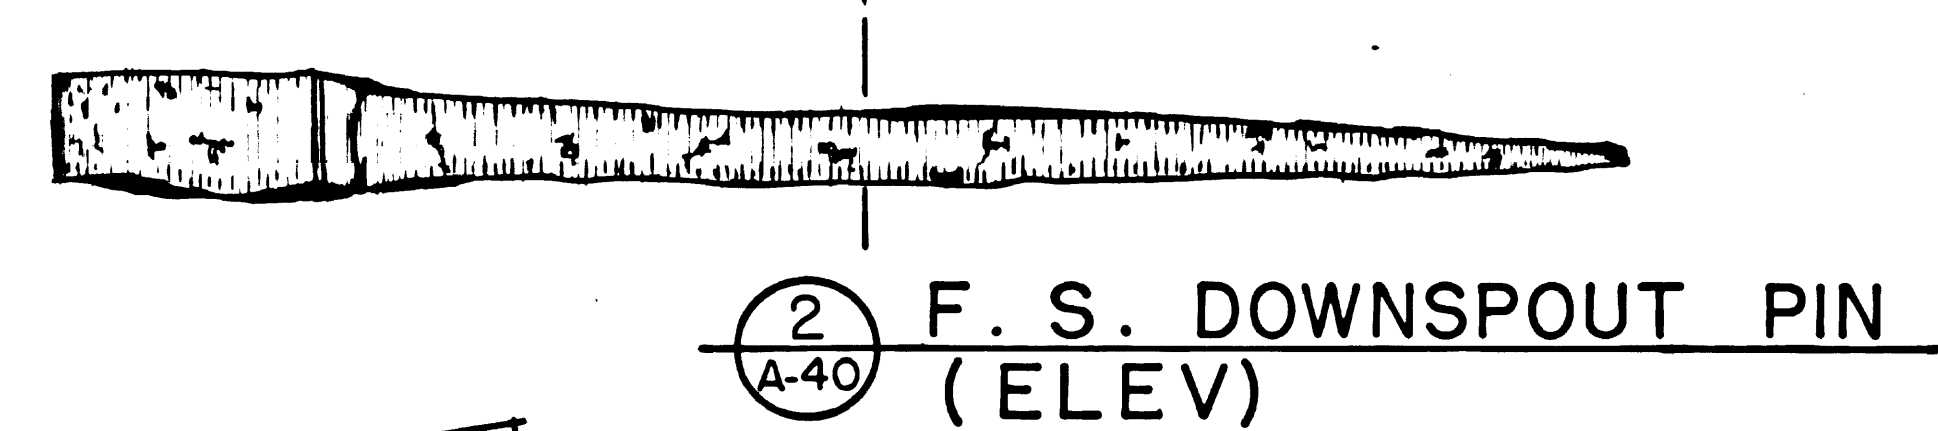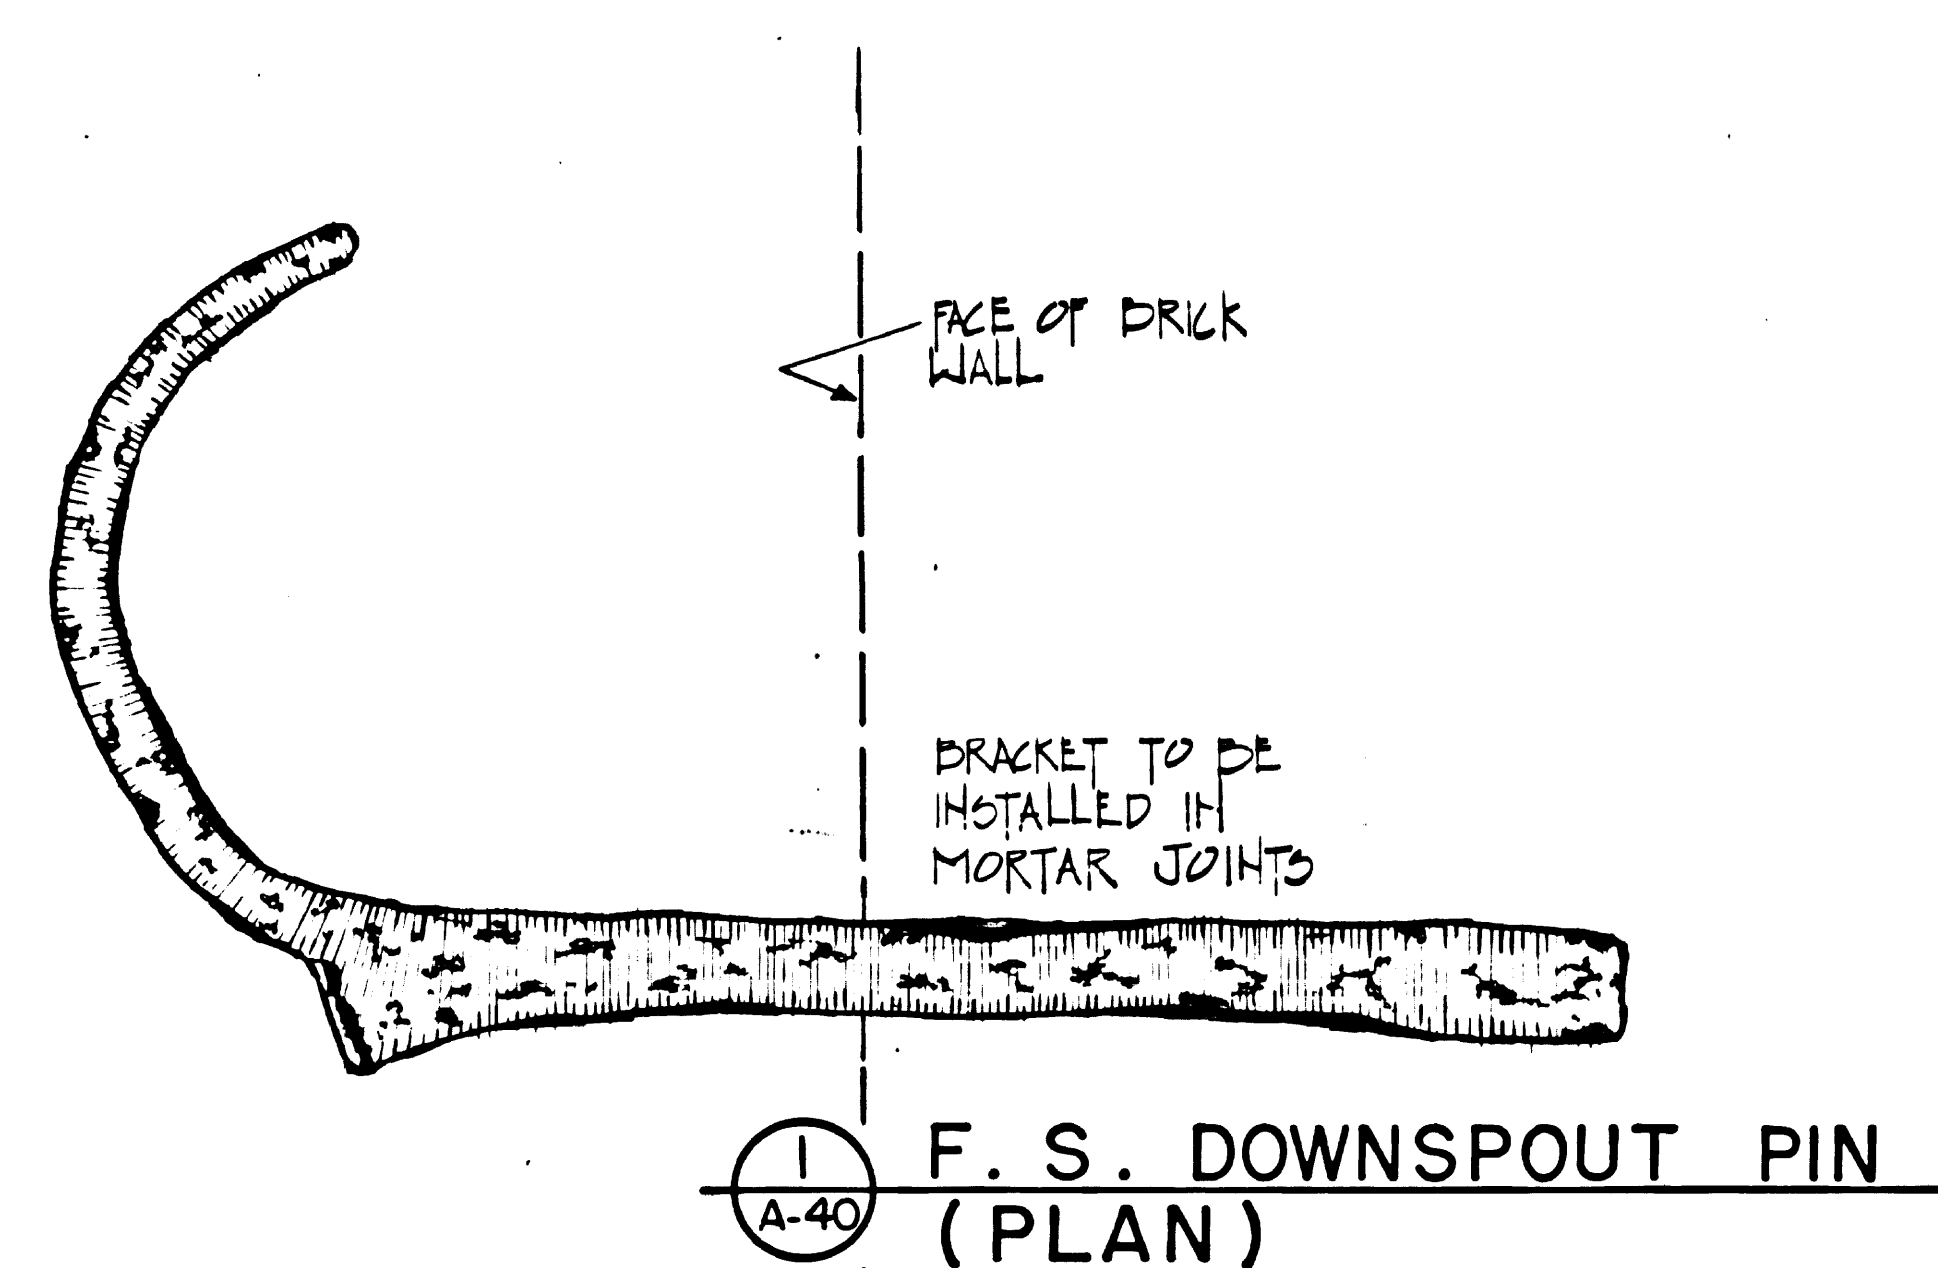

EXISTING SLATE ROOF

ROOF SHEATHING


NUT & BOLT

GUTTER TO BE FABRICATED IN 14' LENGTHS CONNECTED W/ SOLDER INTER-LOCKING JOINTS.

1/2" WIDE L.C.C. STRAP RIVETED TO BRACKET, L.C.C. STRAP TO BE SEPARATED FROM MILD STEEL BRACKET BY NEOPRENE WASHERS.

EXIST GUTTER BRACKETS TO REMAIN IN PLACE, REPAIR AS REQUIRED PRIOR TO INSTALLING NEW GUTTERS.

DOWNSPOUTS TO BE FABRICATED IN 20' LENGTHS W/ 1/2" LAP JOINTS SOLDERED

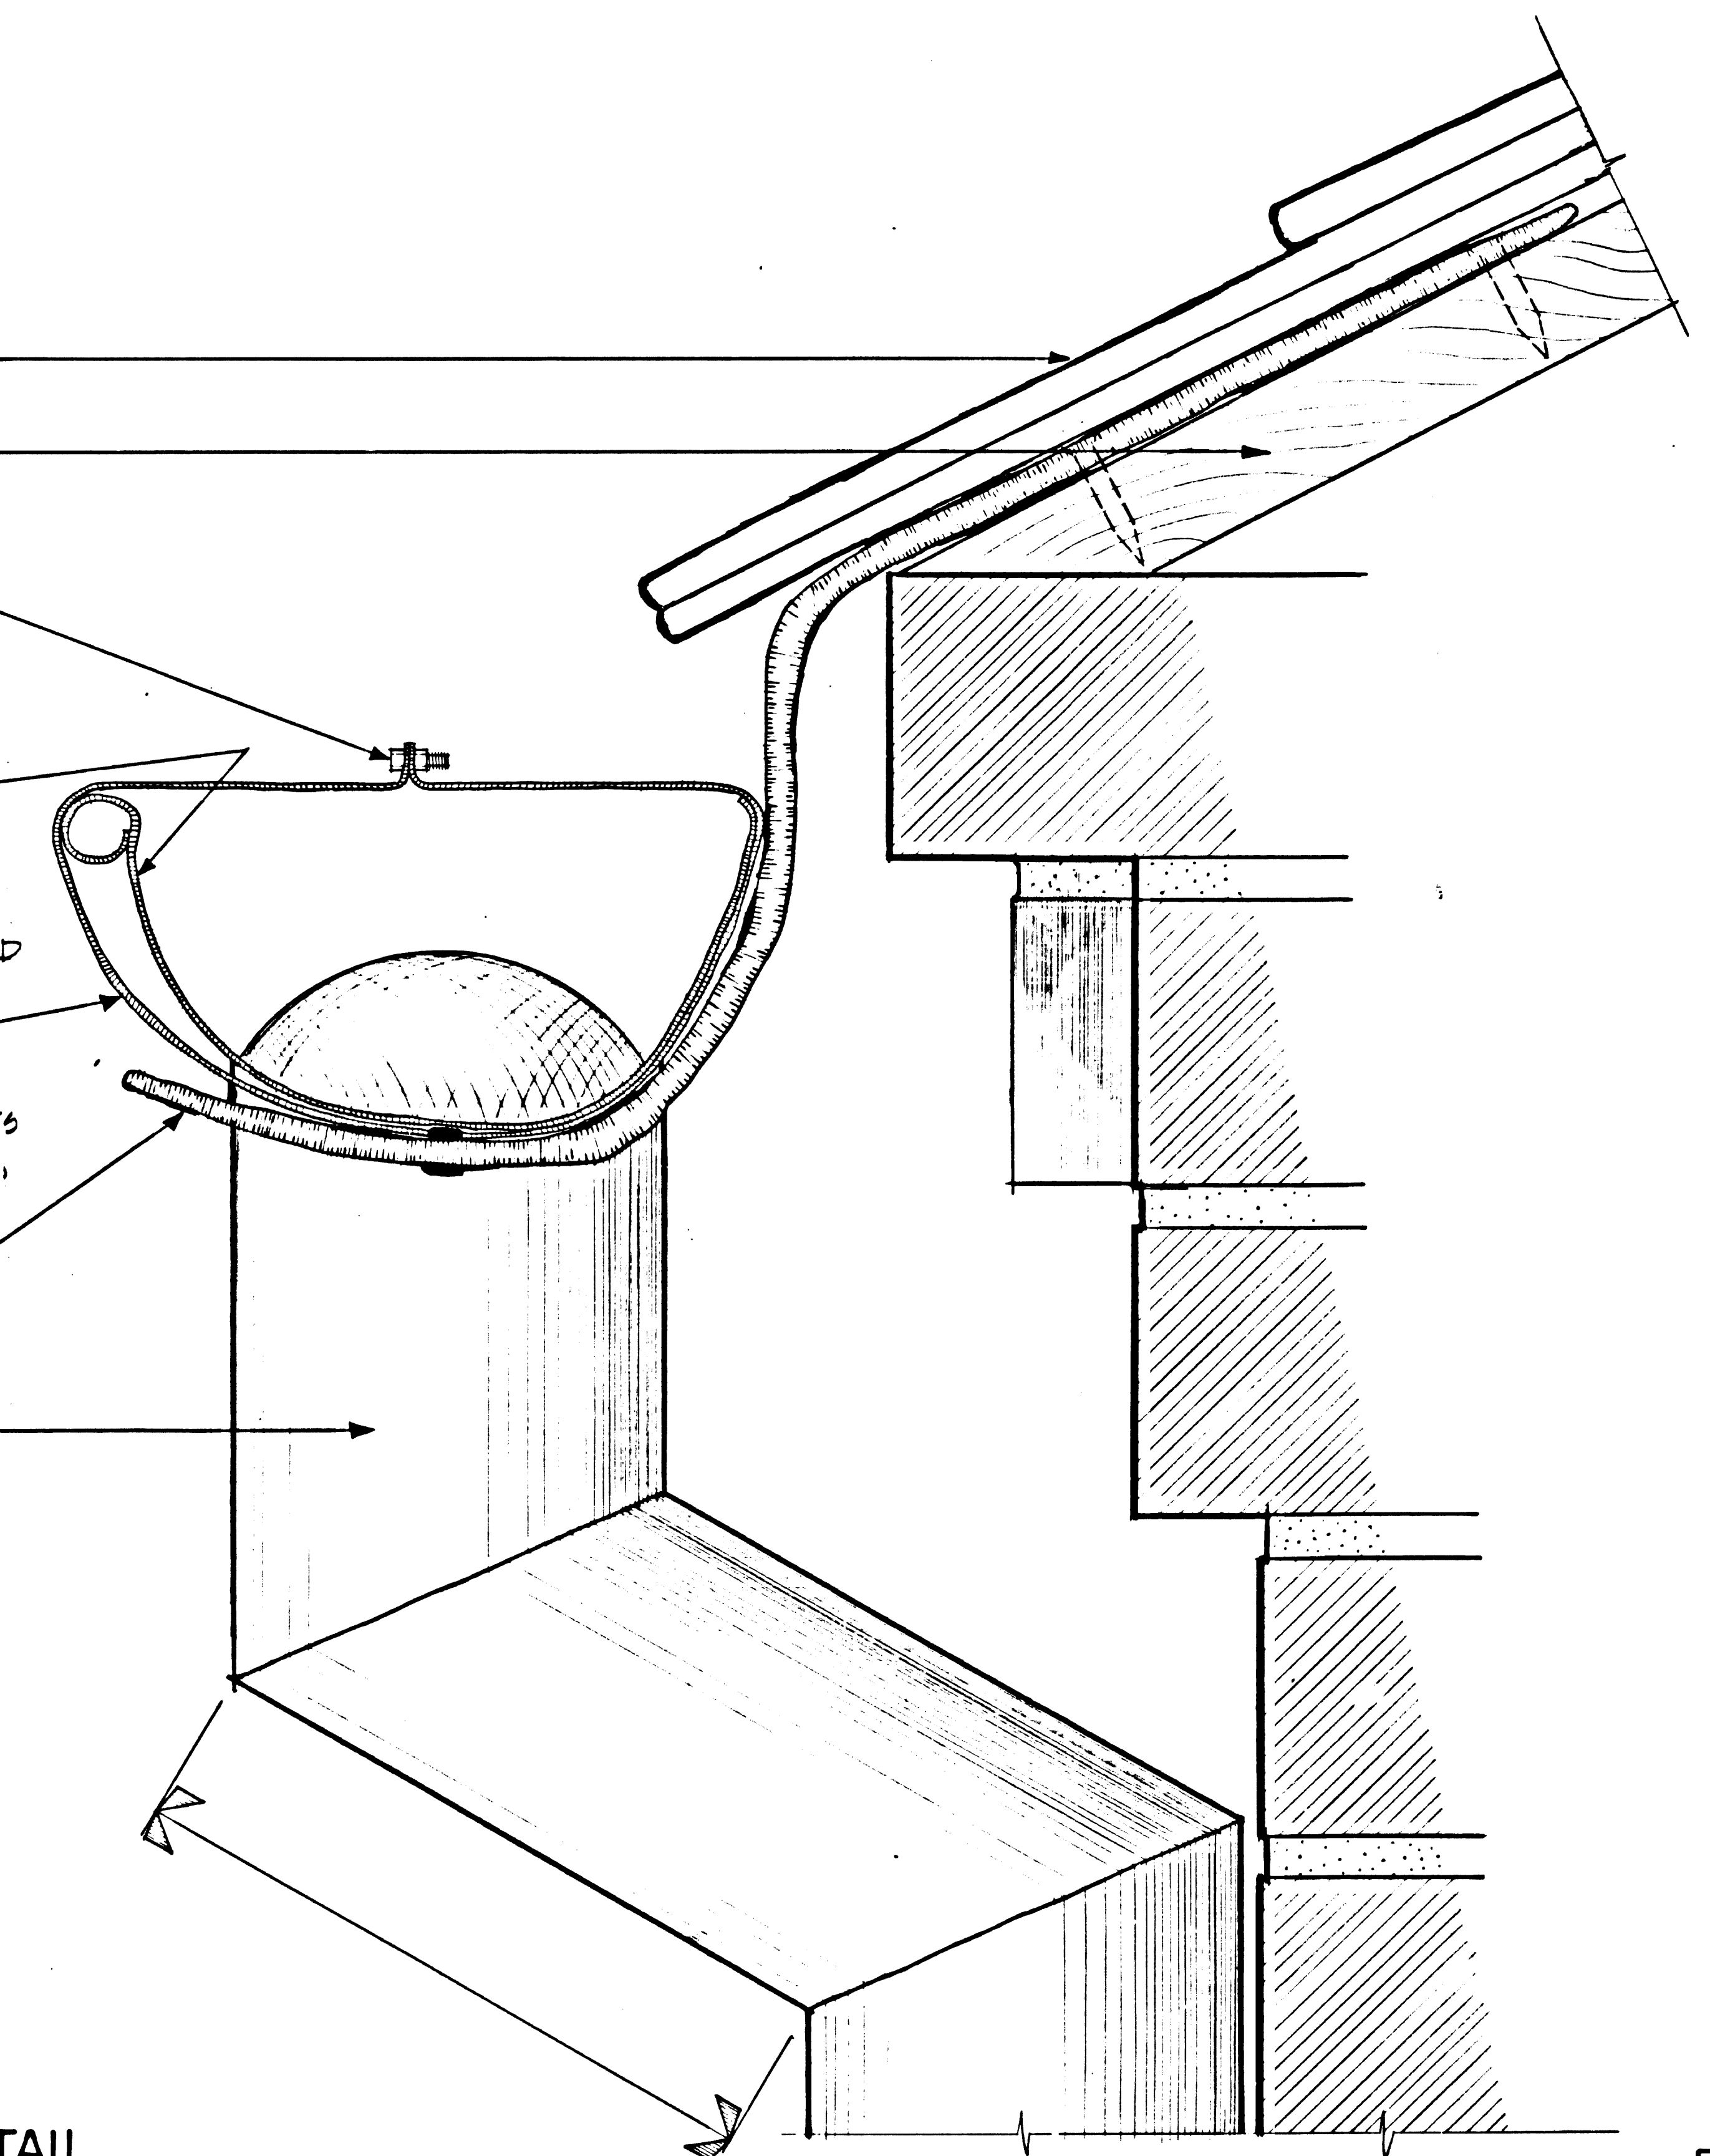


4 F. S. GUTTER DETAIL

PHASE II-B
RESTORATION

F. S. GUTTER & DOWNSPOUT DETAILS BLDG 12 & 12A


FULL SCALE

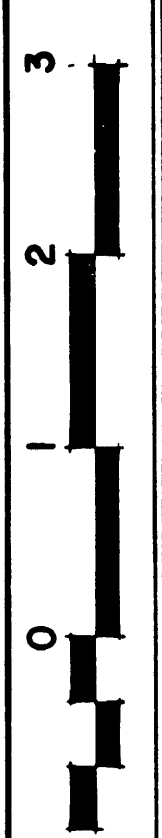

SCALE :

A-40		DRAWING NO	
PREPARED	RSJ/WLB	385	
DESIGNED	JACOBS	25,006A	
DRAWN	BARLOW	PKG.	SHEET
CHECKED	6/78	110	40
DATE			OF 65

1. Contractor shall verify all dimensions & take own measurements at the job site before commencing work. Advise of any error or discrepancy.

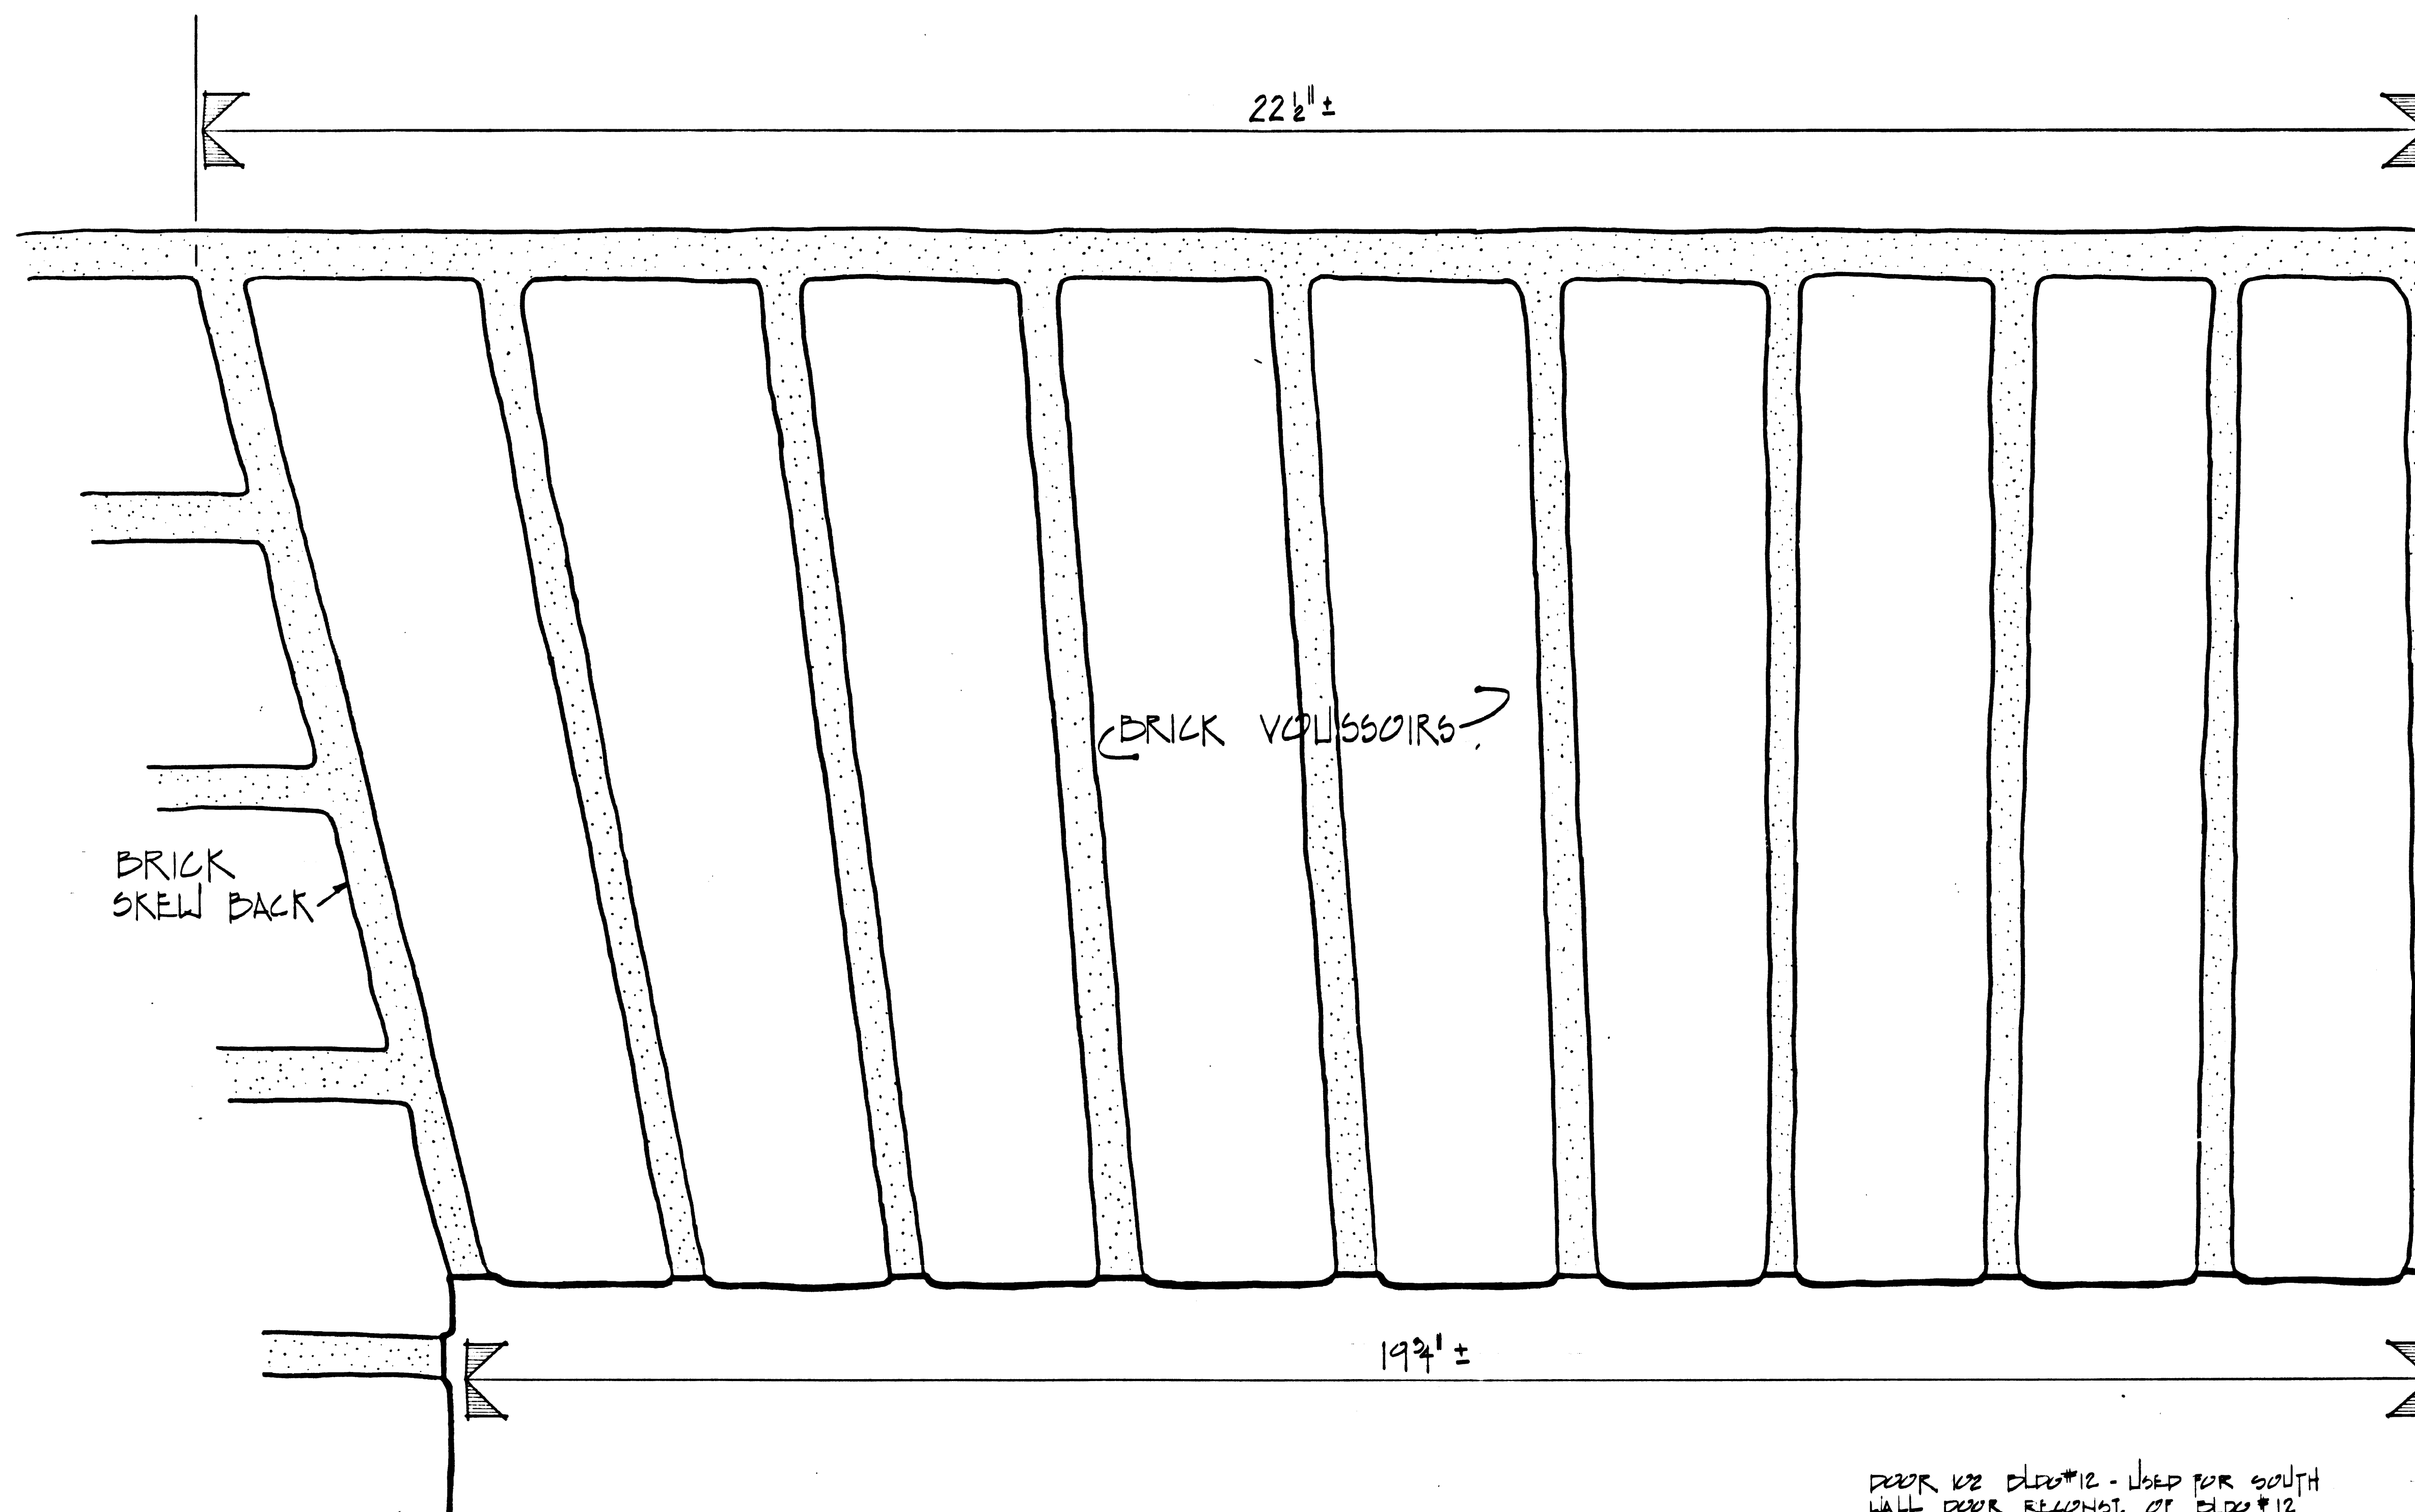

DOOR 101 CLD#12 - USED FOR SOUTH
WALL DOOR RECONSTR. OF CLD#12

CL OF MASONRY OPENING

1
A-41 F. S. BRICK ARCH DETAIL — DOOR 101

PHASE II-B
RESTORATION

F. S. BRICK ARCH DETAIL — BLDG 12
FULL SIZE


SCALE : 0 1 2 3

A-41

PREPARED
RSJ/WLB
DESIGNED
JACOBS
DRAWN
BARLOW
CHECKED
6/78
DATE

DRAWING NO.
385
25,006A
SHEET
41
OF 65

Contractor shall verify all dimensions and
take own measurements at the job site before
commencing work. Advise of any error or
discrepancy.

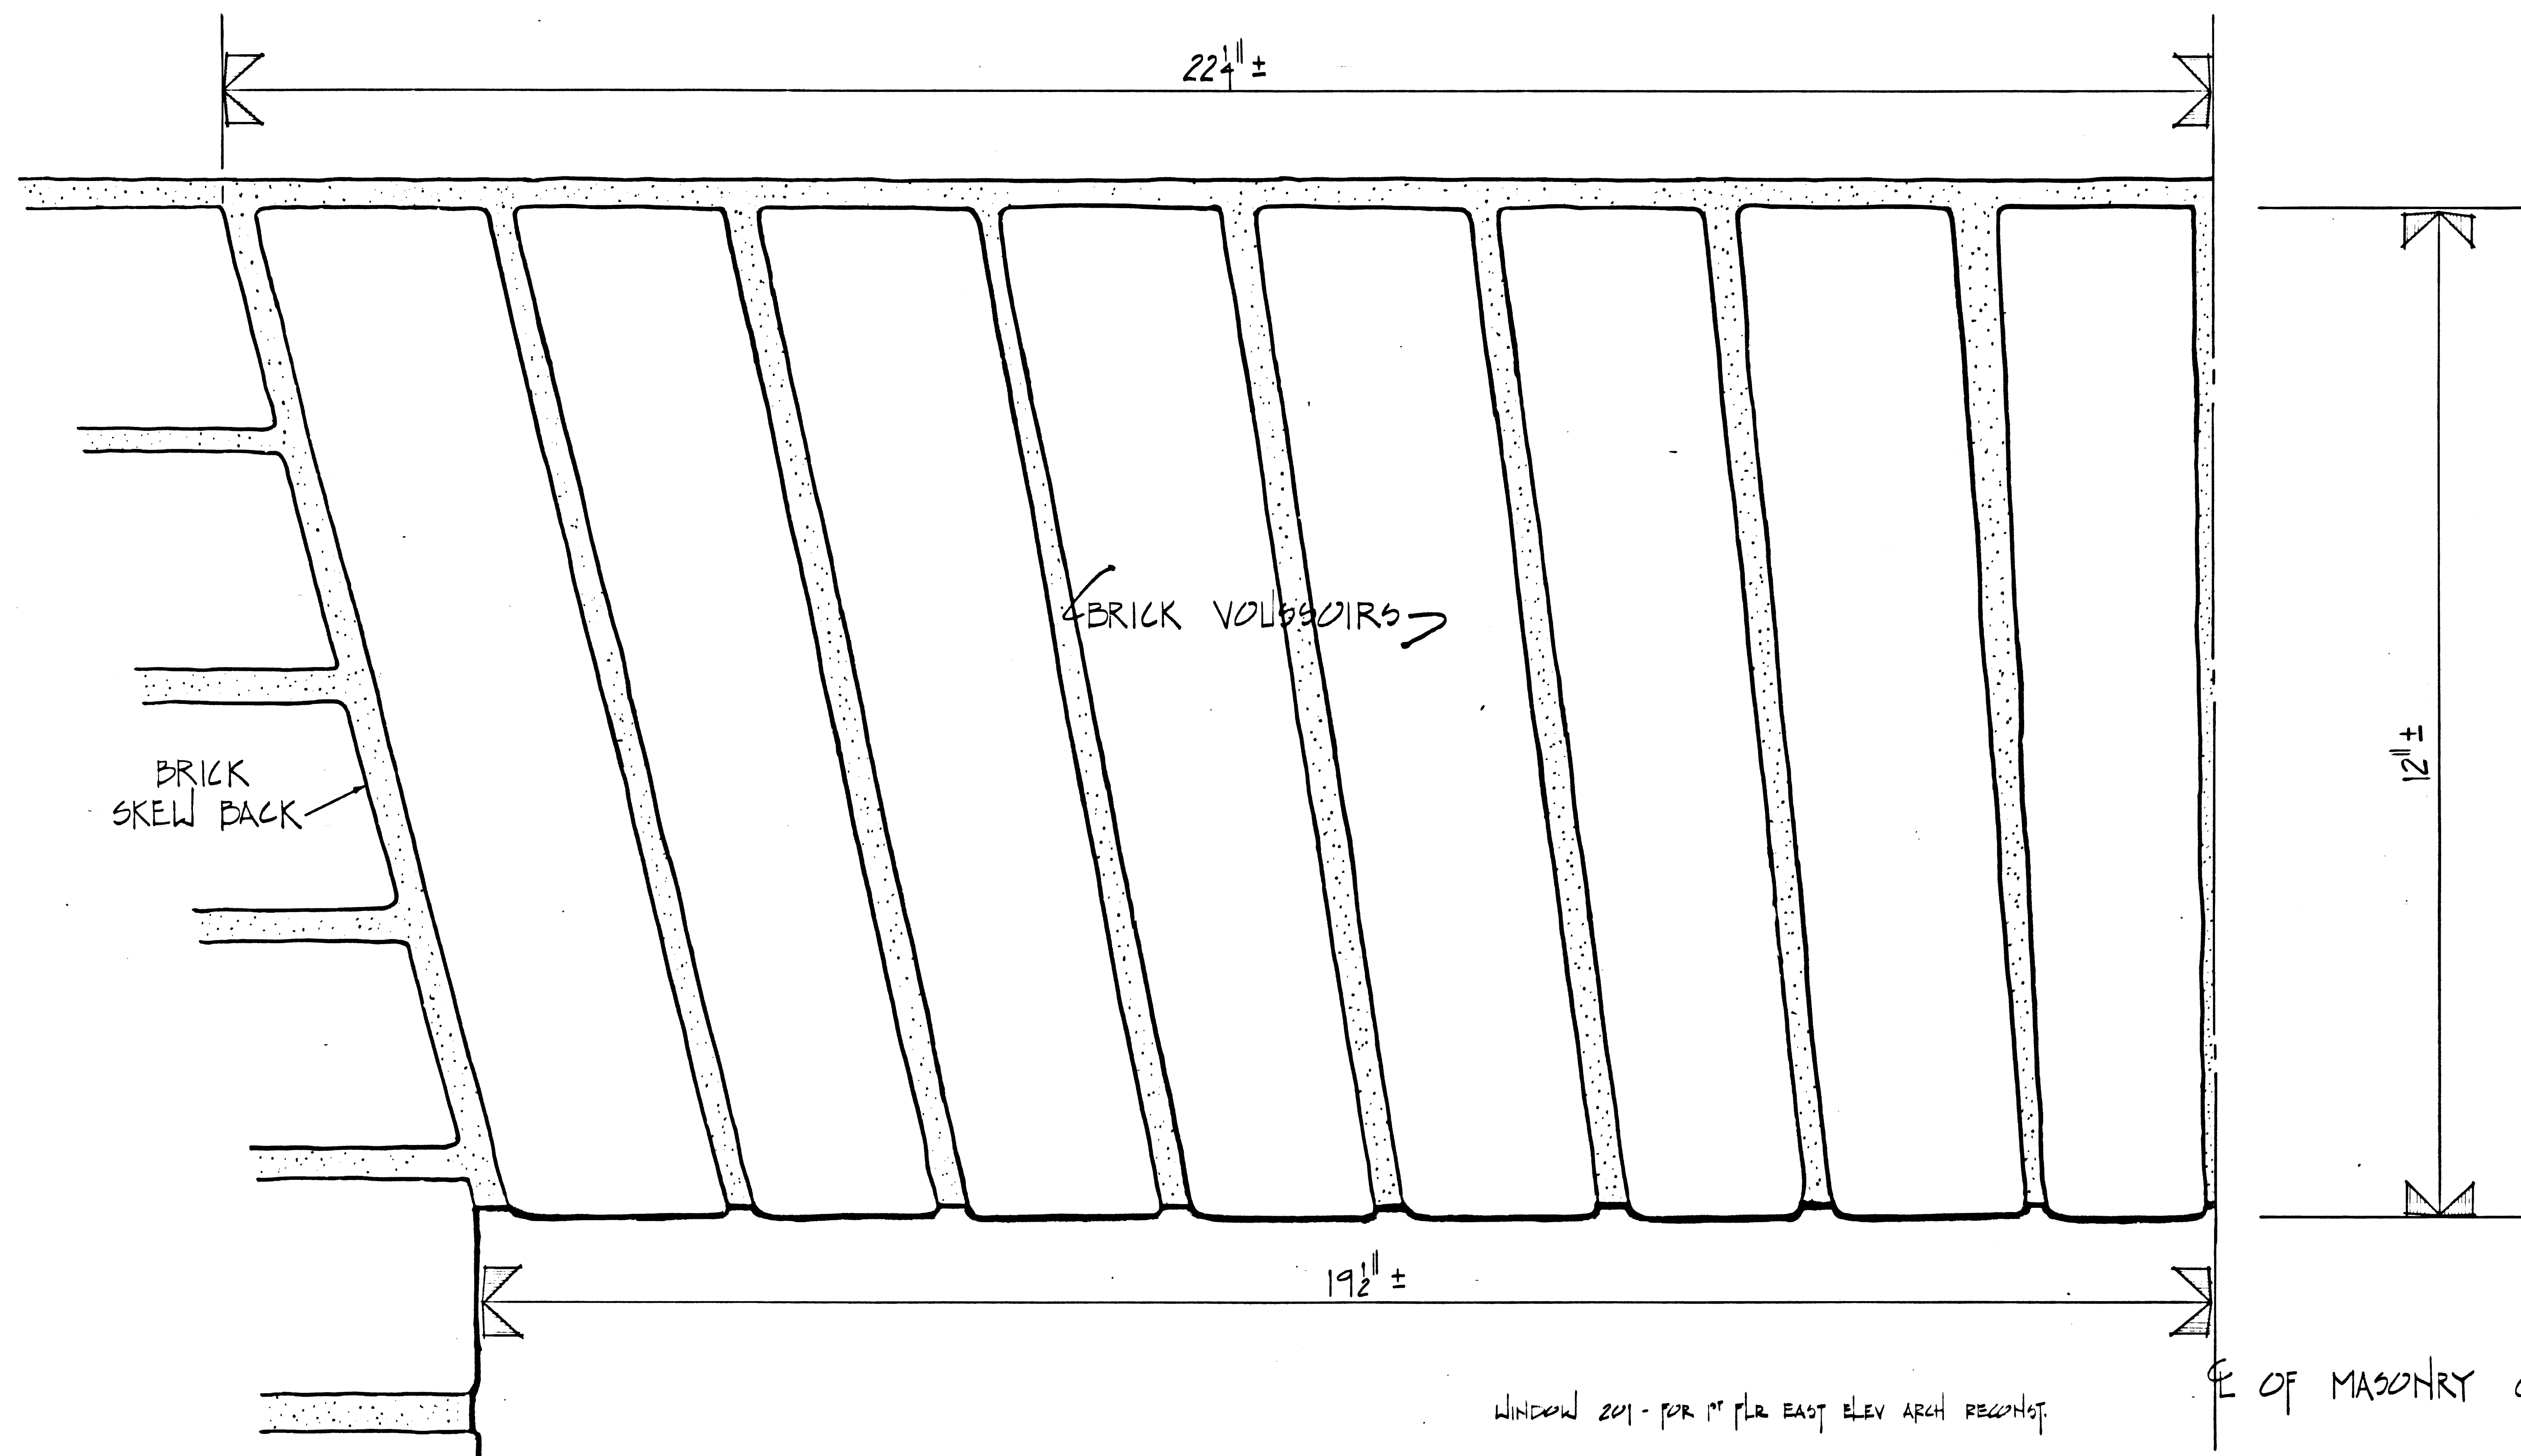

BRICK
SKEW BACK

BRICK VOLUPTUOUS

12" ±

22 1/4" ±

19 1/2" ±

WINDOW 201 - FOR 1ST FLR EAST ELEV ARCH RECONSTRUCT

F. OF MASONRY OPENING


① F S BRICK ARCH DETAIL
A-42 WINDOWS 101, 102, 103

Contractor shall verify all dimensions and
take own measurements at the job site before
commencing work. Advise of any errors or
discrepancies.


A-42		DRAWING NO.	
PREPARED RS J/WLB		385	
DESIGNED		25.006A	
JACOBS		PCIP	
DRAWN		SHEET	
BARLOW		42	
CHECKED		OF 66	
6/78			
DATE			

PHASE II-B
RESTORATION

F.S. BRICK ARCH DETAIL - BLDG 12
FULL SIZE

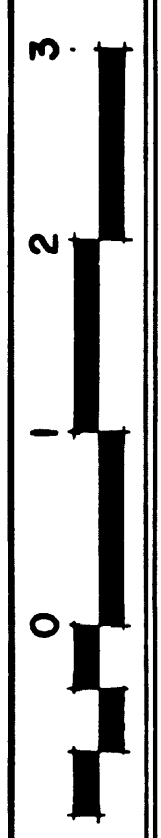

SCALE

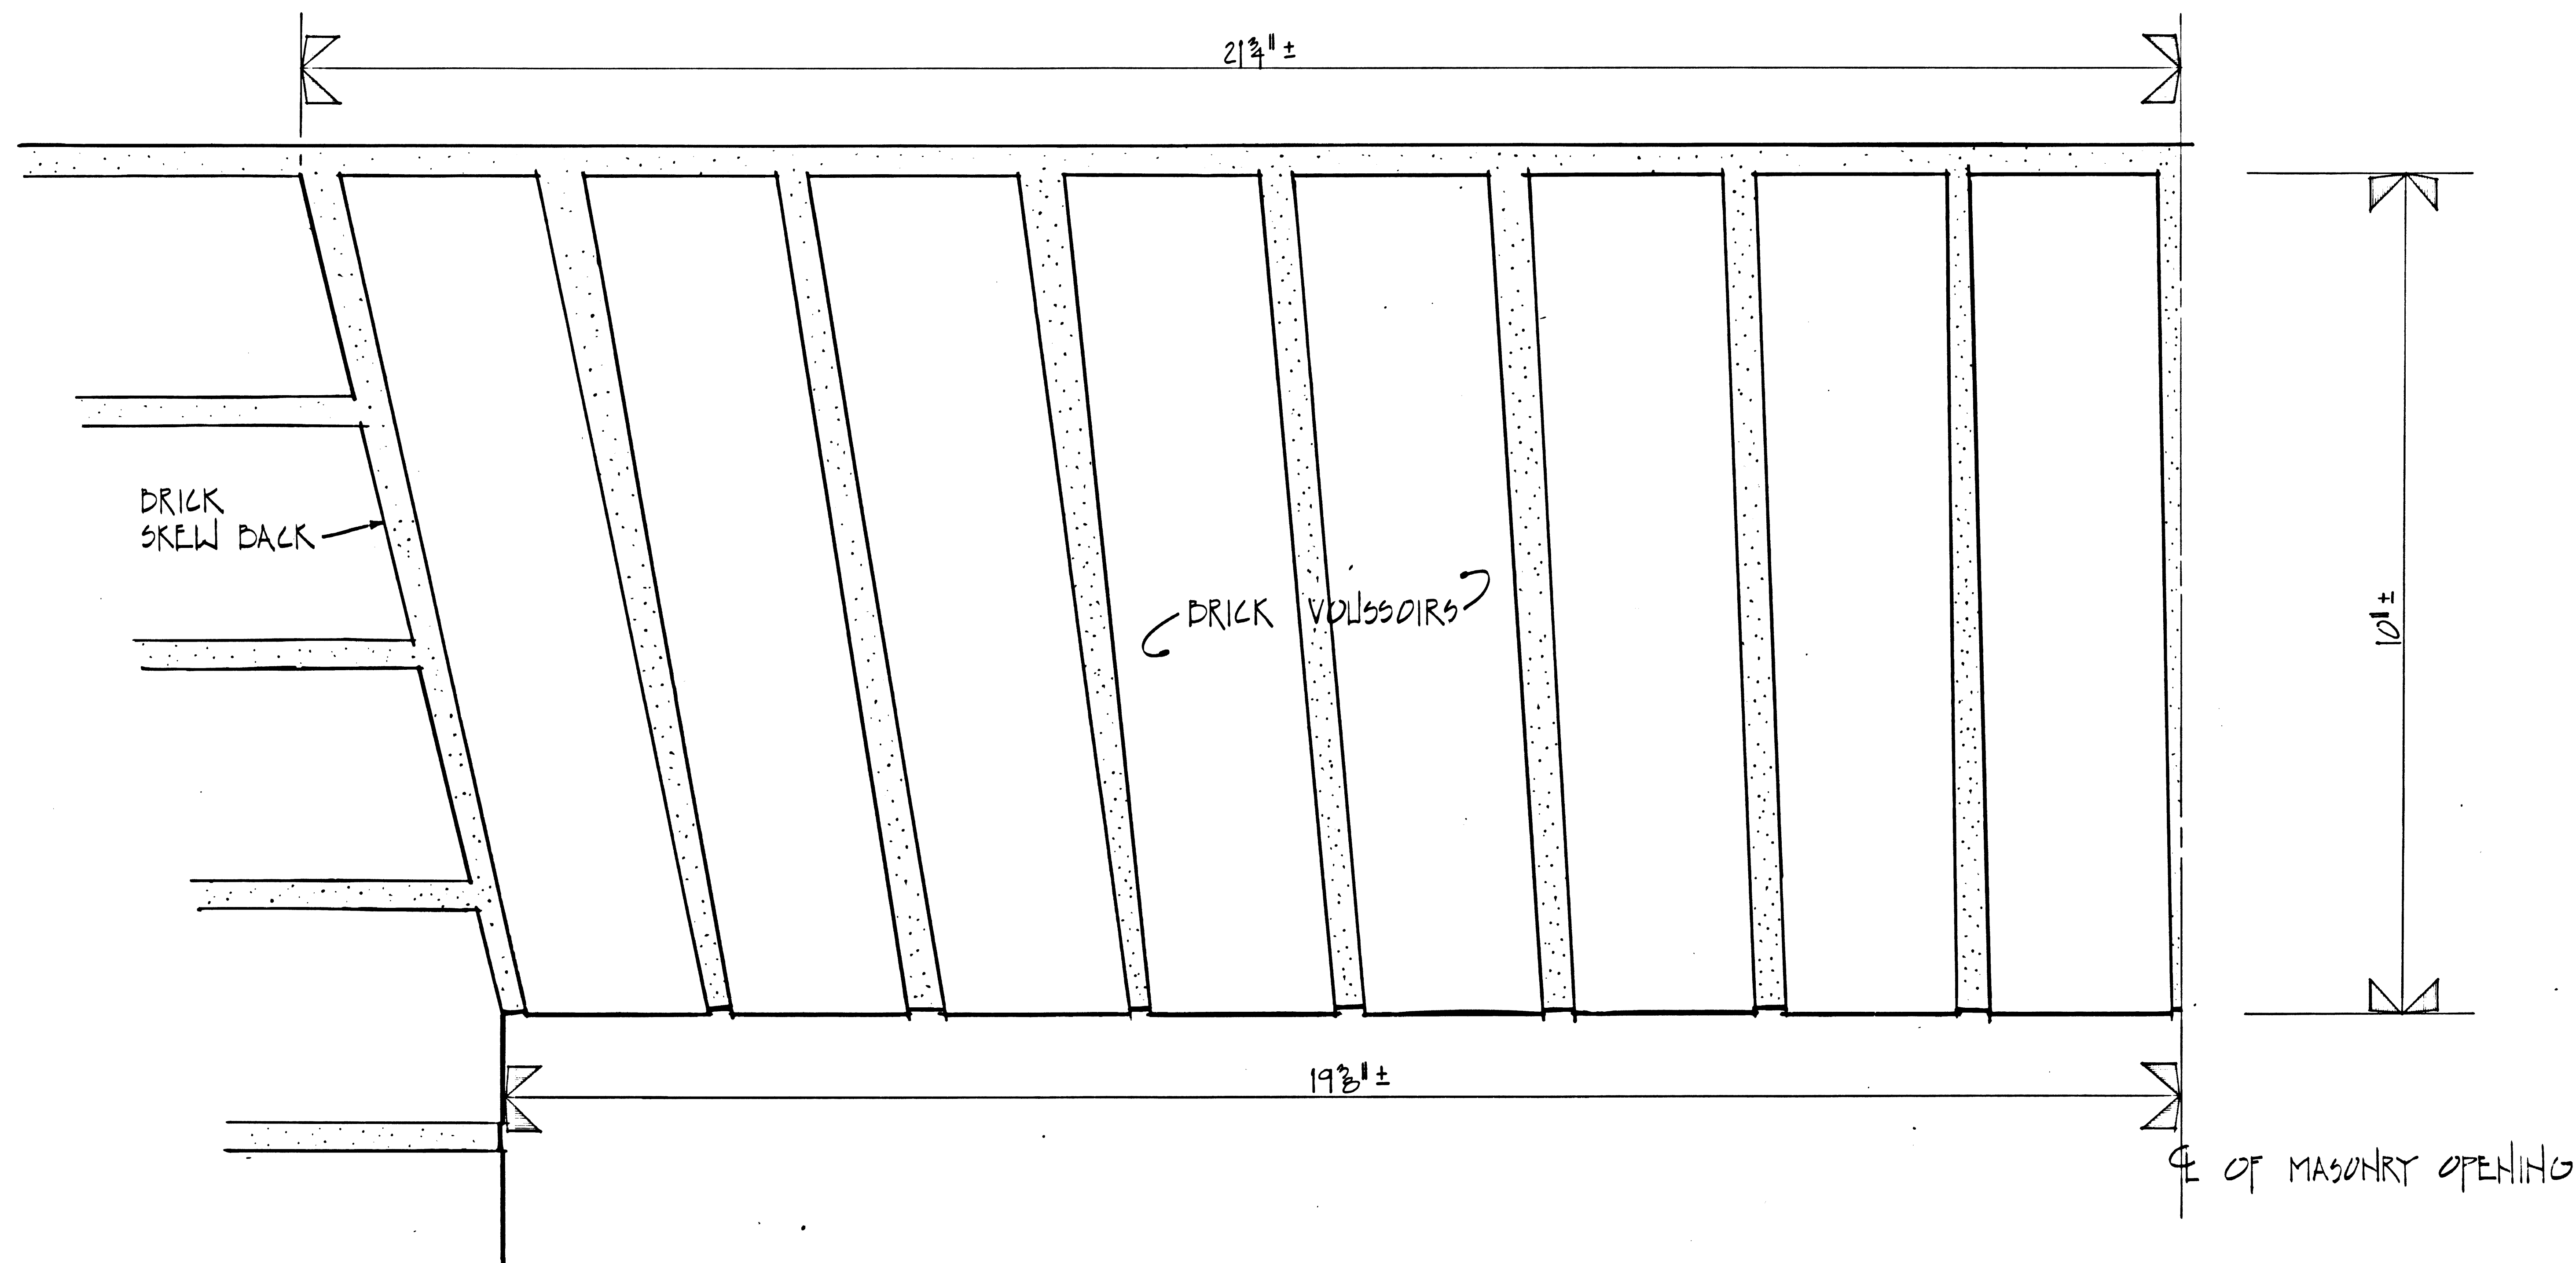

1
A-43

F. S. BRICK ARCH DETAIL
WINDOW 104

EXISTING JACK ARCH WINDOW 105
FOR THE WINDOW #12 - SELEV.

Contractor shall verify all dimensions and
take own measurements at the job site before
commencing work. Advise of any error or
discrepancy.


A-43

PREPARED
RSJ/WLB
DESIGNED
JACOBS
DRAWN
BARLOW
CHECKED
6/78
DATE

DRAWING NO
385
25006A
SHEET
43
OF 66

PHASE II-B
RESTORATION

F. S. BRICK ARCH DETAIL - BLDG 12
SCALE 0 1 2 3
FULL SIZE

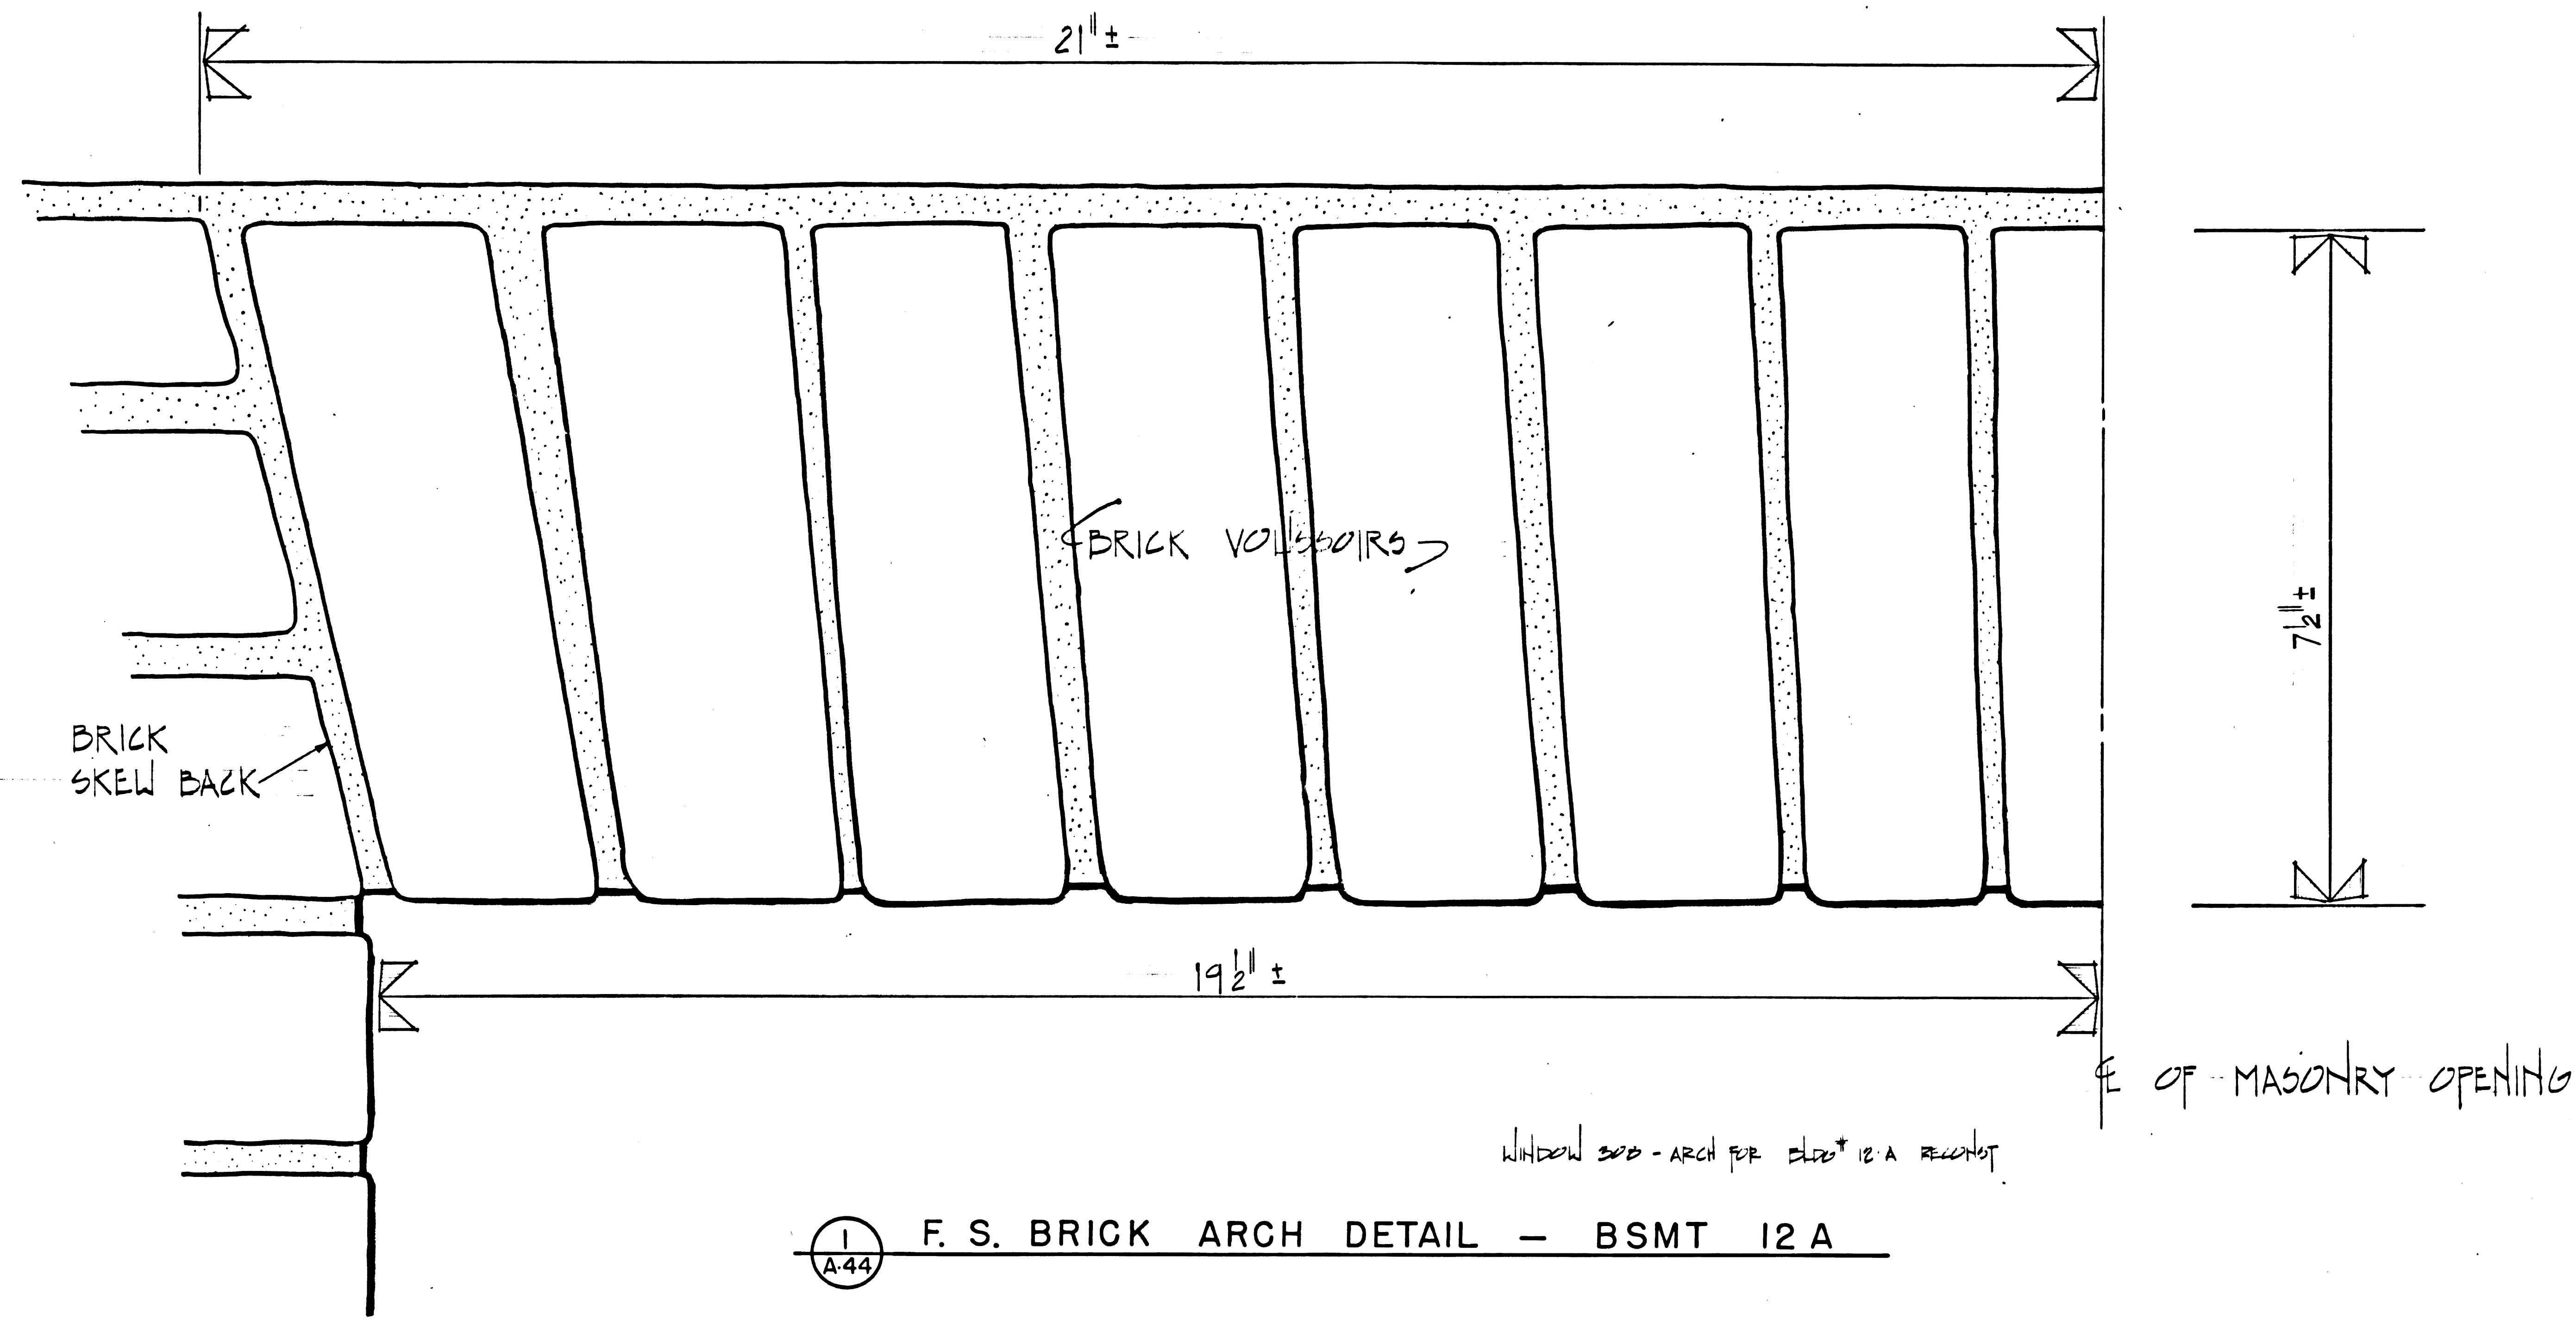

WINDOW 300 - ARCH FOR CLD# 12 A RECHOT


1
A-44
F. S. BRICK ARCH DETAIL — BSMT 12 A

PHASE II-B
RESTORATION

F. S. BRICK ARCH DETAIL — BLDG 12A
SCALE : 1" = 2' 3" FULL SIZE

A-44		DRAWING NO.	
PREPARED	RSJ/WLB	385	
DESIGNED	JACOBS	25,006A	
DRAWN	BARLOW	PKG	SHEET
CHECKED	6/78	110	44
DATE			OF 65

Contractor shall verify all dimensions and take own measurements at the job site before commencing work. Advise of any error or discrepancy.

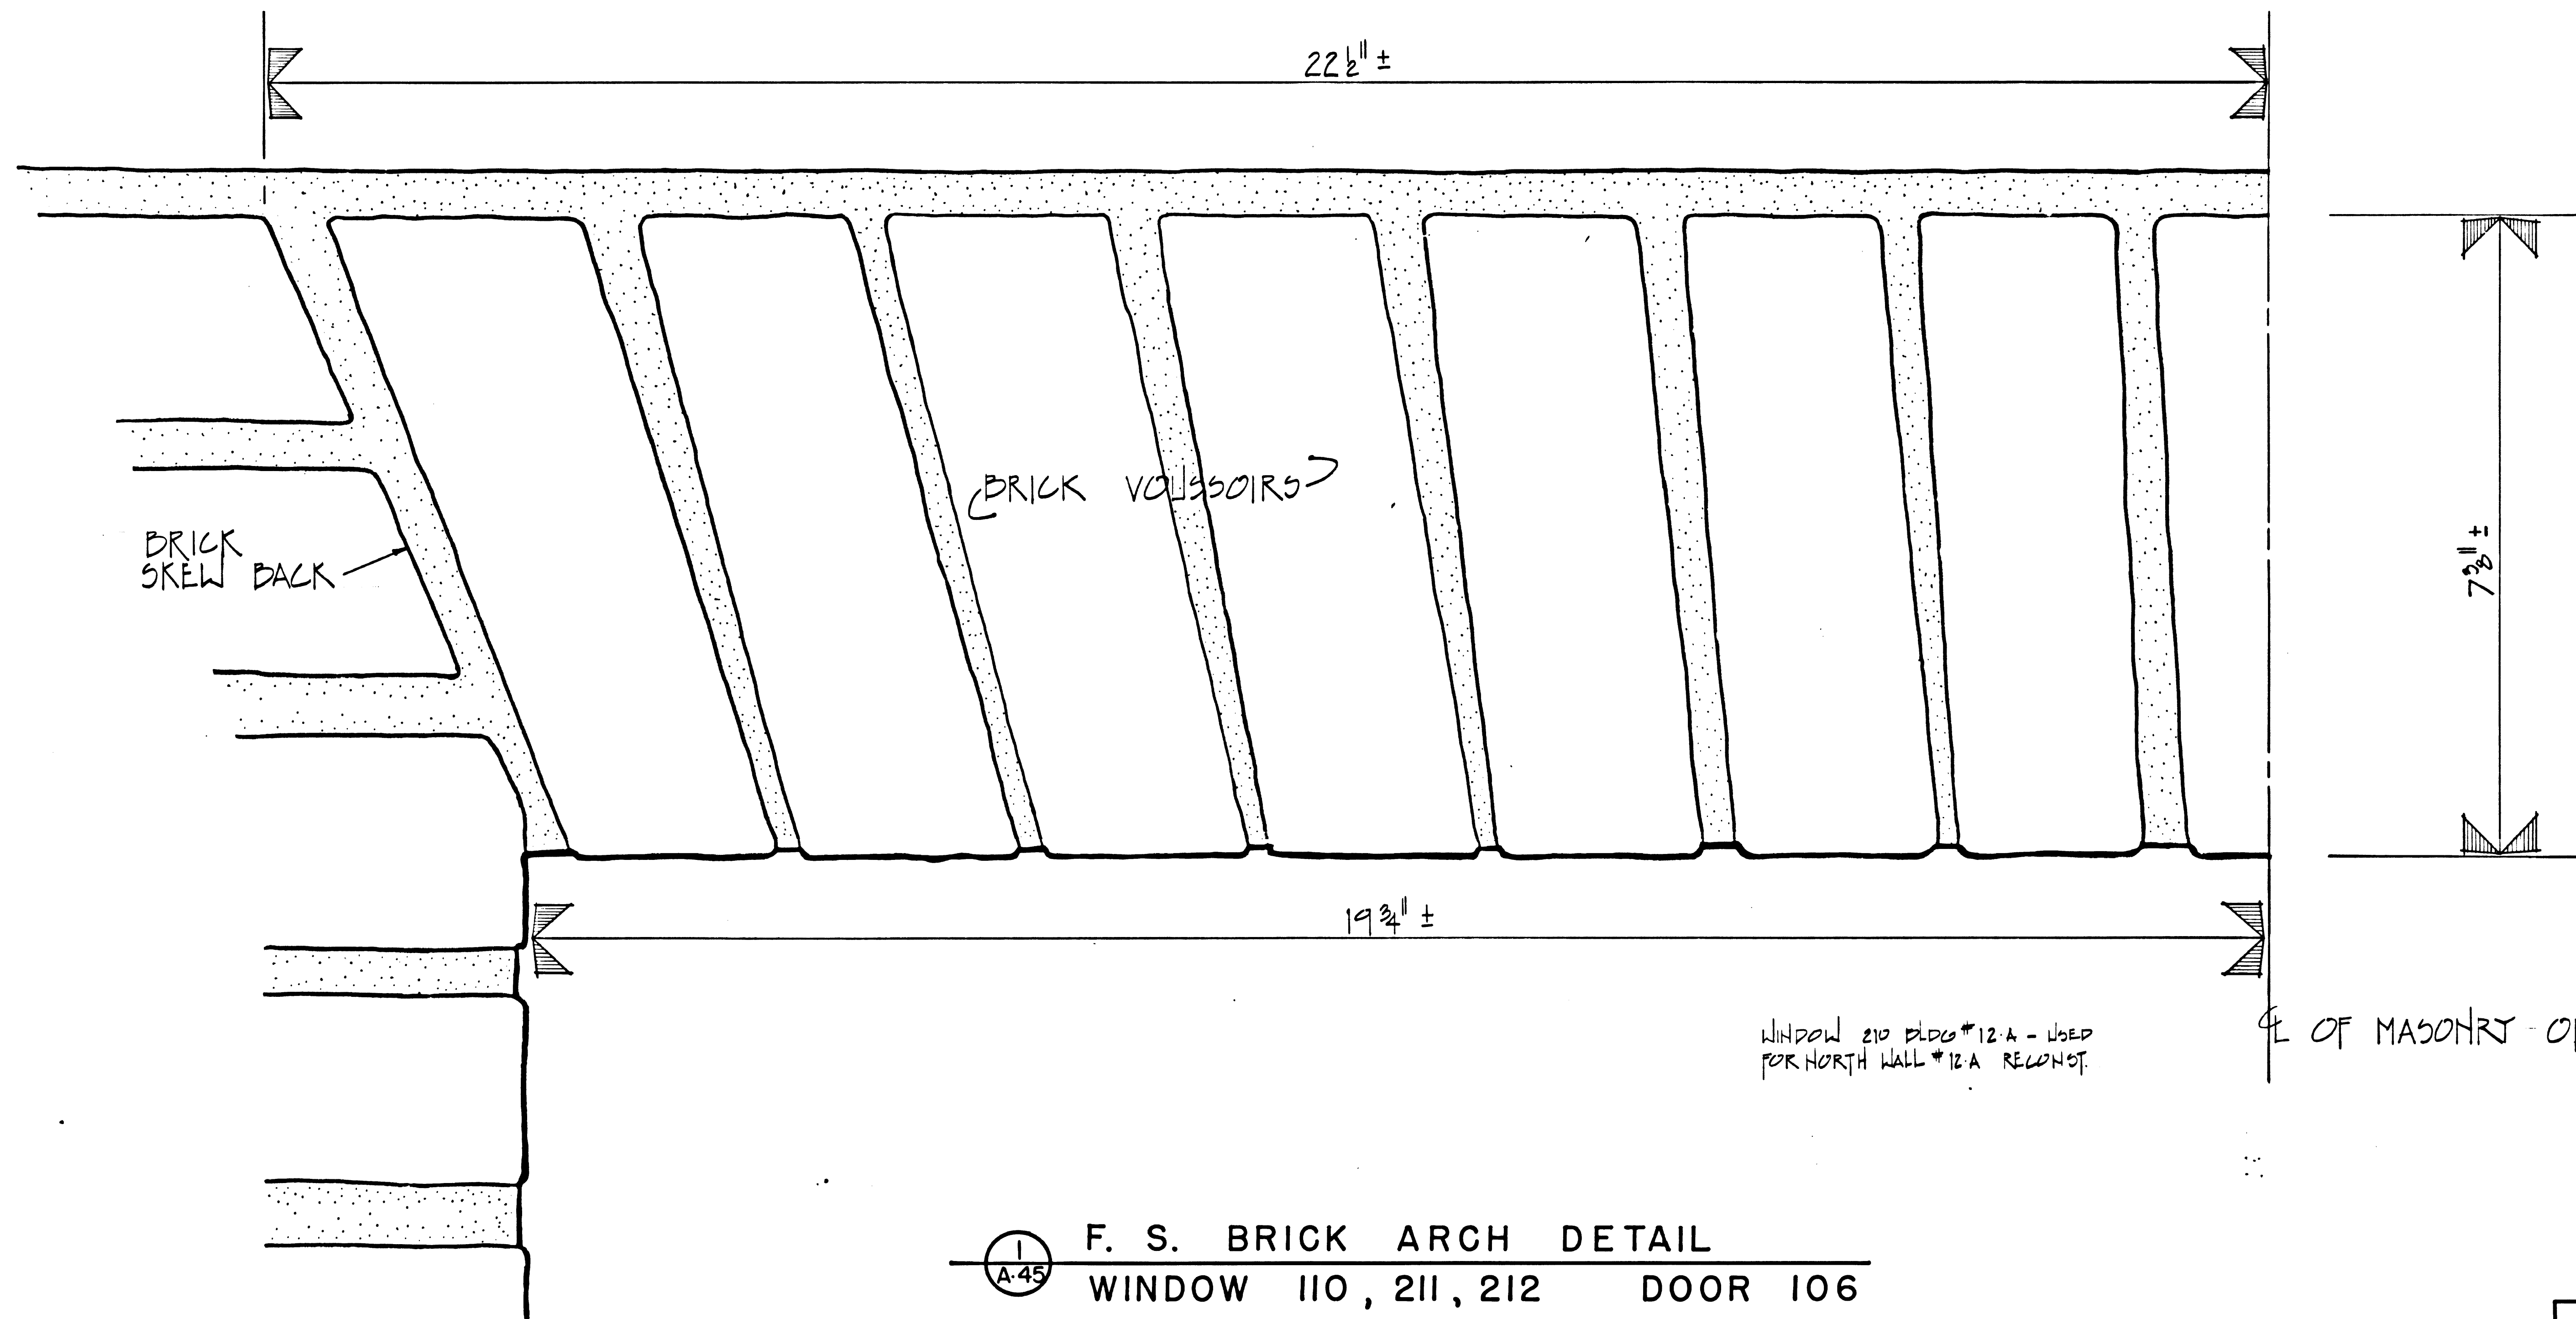



1
 A-45
F. S. BRICK ARCH DETAIL
 WINDOW 110, 211, 212 DOOR 106

PHASE II-B
 RESTORATION

F. S. BRICK ARCH DETAIL — BLDG 12 A
 SCALE : 1" = 3'-0" FULL SIZE


A-45		DRAWING NO.	385
PREPARED	RSJ/WLB	DESIGNED	25 006A
JACOBS	DRAWN	DATE	6/78
BARLOW	CHECKED	DATE	6/78
SHEET		NO.	45
OF 65			

Contractor shall verify all dimensions and take own measurements at the job site before commencing work. Advise of any noted discrepancy.

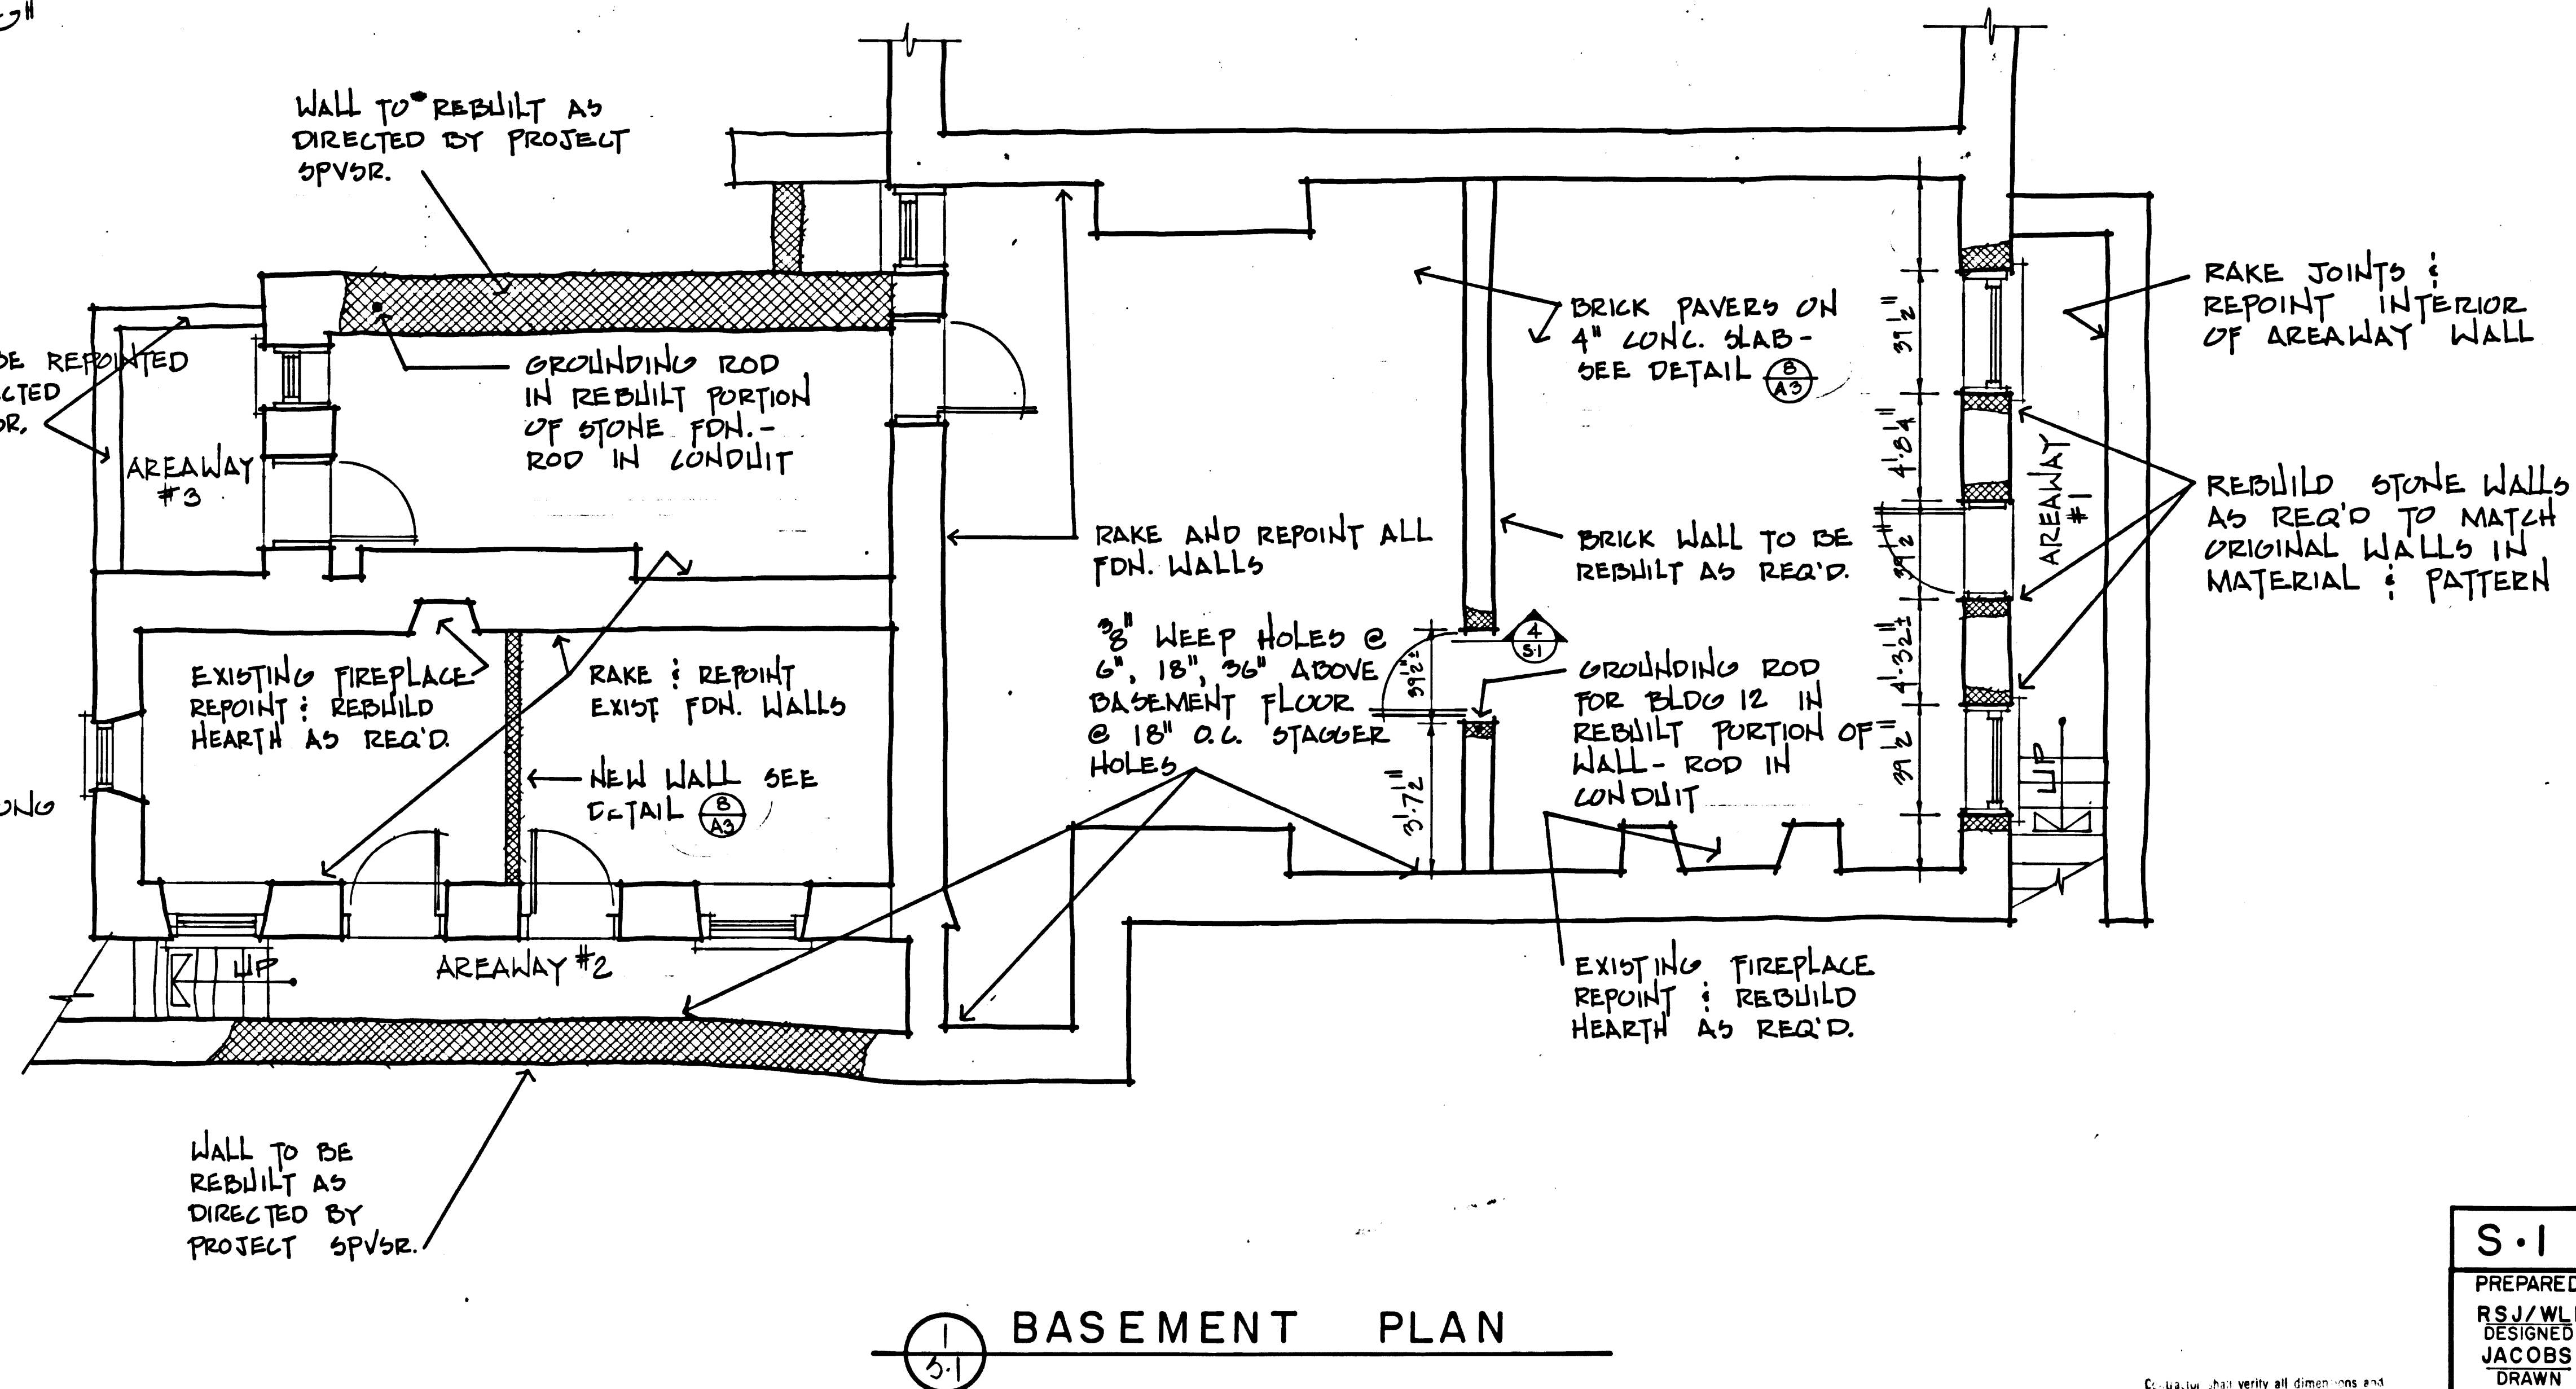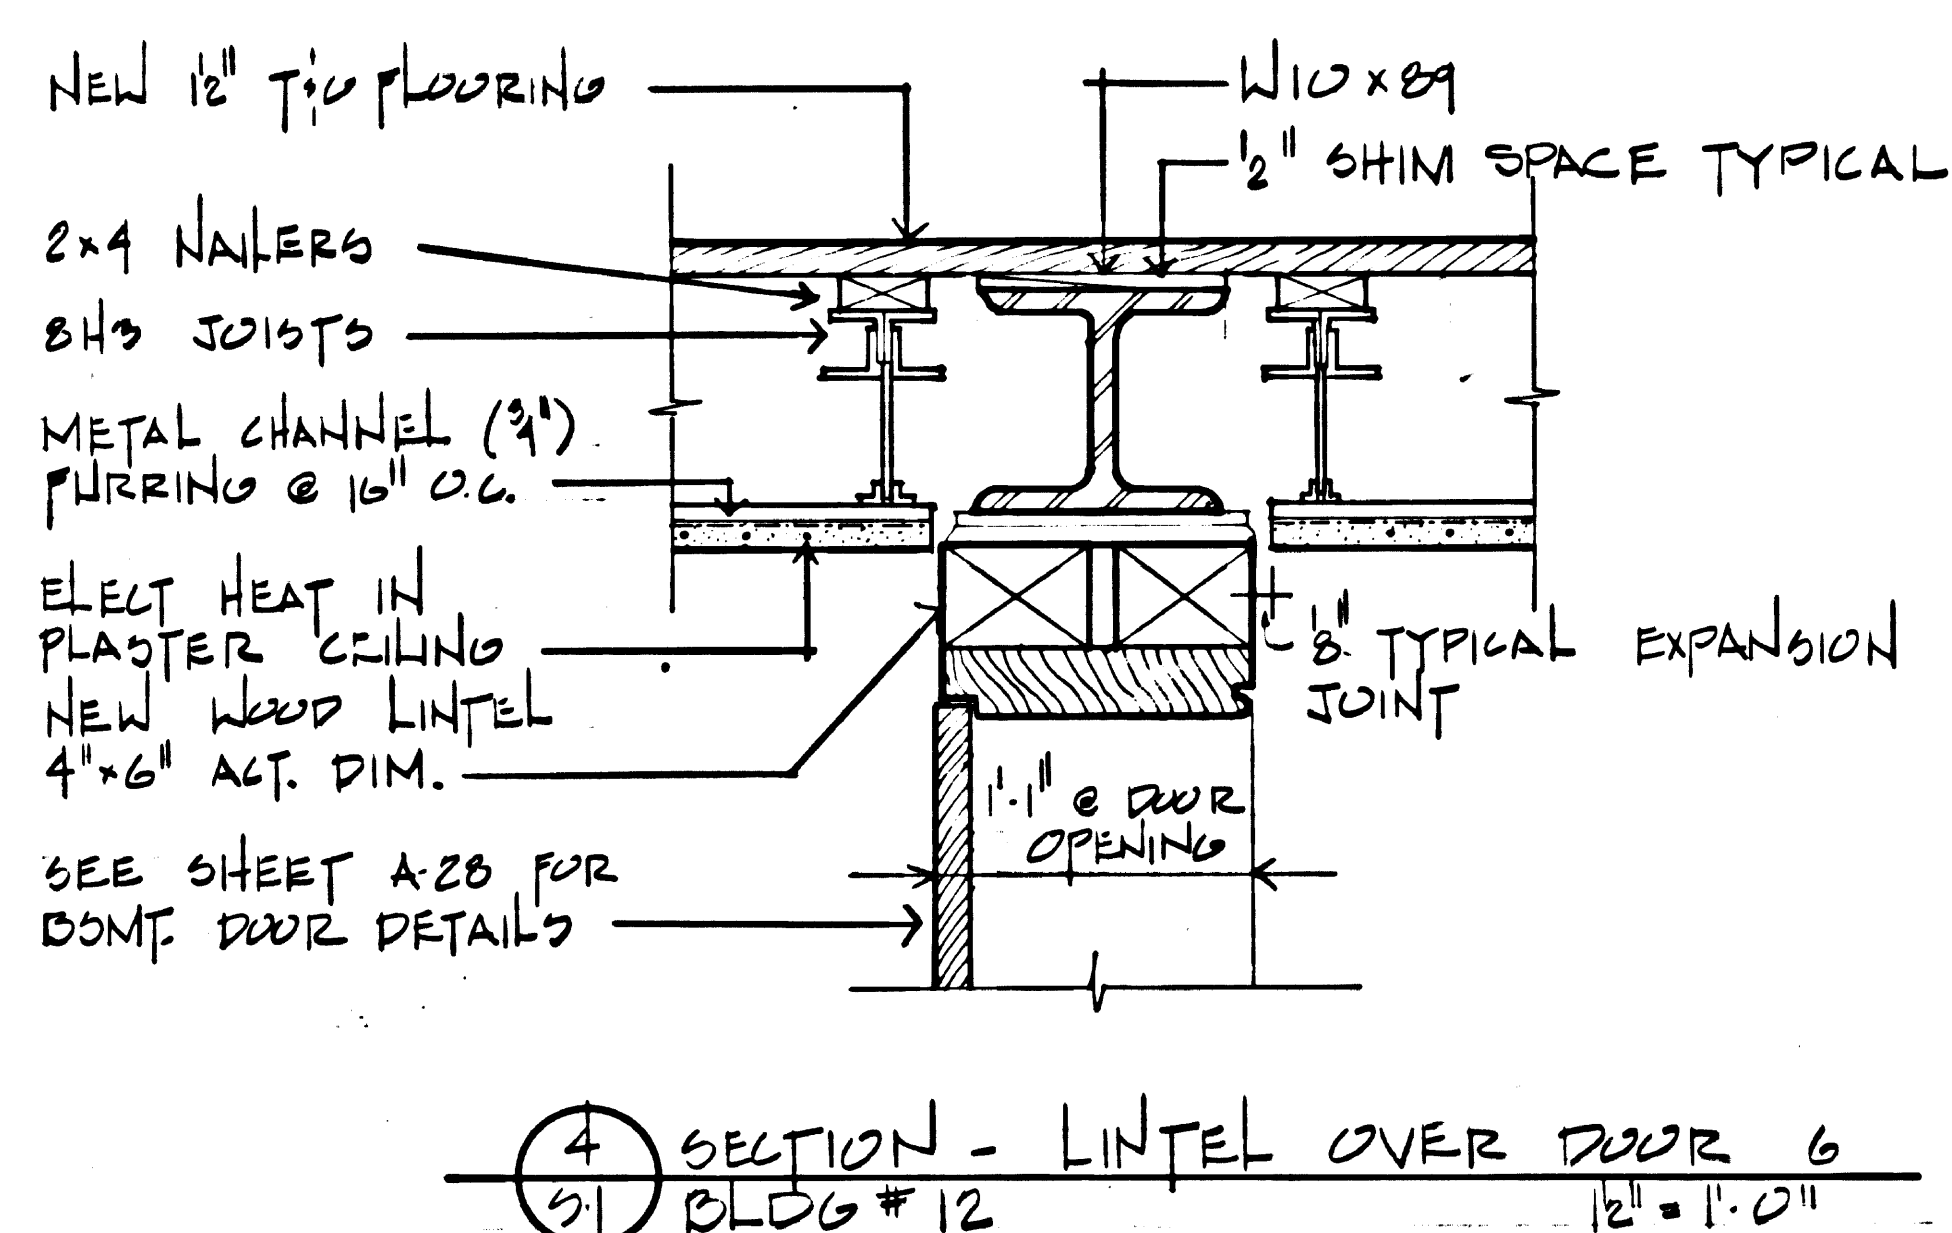

PHASE II - B RESTORATION

BASEMENT FLOOR PLAN BLDG. 12 8 12 A

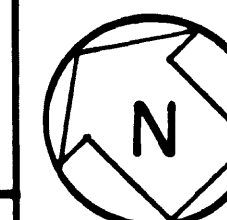

S · I	PREPARED RSJ/WLB DESIGNED JACOBS "DRAWN" BARLOW CHECKED 6/78 DATE	DRAWING NO. 385 25,006
	PCIP PKG 110	SHEET 4 OF 6

Contractor shall verify all dimensions and take own measurements at the job site before commencing work. Advise of any error or discrepancy.

2" SHIM SPACE-TYP

1/2" TIG FLOORING

2x4 NAILER, BOLTED TO BAR JOIST

4x4x1/2x6 @ 24" O.C. W/ PL. 3x3/2x3/2 CLT AT SHOWN - CENTER ON ANGLE

3/4" METAL FURRING 16" O.C.

ELECT. HEAT IN PLASTER CEIL.

W 10x54

1/2" SHIM SPACE - TOP
 NEW 1/2" T&G FINISH FLOORING
 W10 x 89
 L4 x 3 1/2 x 3/8 x 7
 W10 x 54
 PL 1/2" x 12" CONT. SET IN GROUT
 EXISTING BRICK PARTITION TO BE REPAIRED AS DIRECTED BY PROJECT SPVR.

2" x 4" FURRING

2" C.M.U.

PL 10 x 10 x 4

W10 x 54

3/4" BOLT

4 x 3 1/2 x 7

LEVELING GROUT

2x8x2- FRONT WALL ONLY

4x4x6 TO

2" 2x4 EXIST. FDN. WALL BEYOND

5 CONNECTION - STEEL JOIST TO
5.2 BEAM - BLDG # 12 12" x 1' x 0"

6 CONNECTION - BEAM TO
52 PERIMETER CHANNEL - BLDG #12
1 1/2" = 1' 0"

7 CONNECTION - BEAM TO BEAM @
52 BRICK PARTITION - BLDG #12 12" x 16"

SECTION @ OPENING IN
FDN WALL - BLDG #12 - 12" x 1'0"

④ CONNECTION - COLUMN TO PERIMETER
5-2 CHANNEL - FRONT WALL BLDG #12
1/2" = 1'-0"

6x6x1 AT CORNER
LOCATED IN 1"x7"
CHASE - BOTH LEGS
OF ANGLE.

1'-0"

1'-4"

6x6x1 PRE
WELDED TO
PERIMETER PL.
@ 1x6 COLS.
LEVELING
GROUT

3 CONNECTION - COL. TO PERIMETER
5.2 ANGLE - BLDG # 12A 12" = 1'-0"

2 CONNECTION - COL TO PERIMETER
52 ANGLE - BLDG# 12A 12" x 12"

NOTES:
THE EXISTING 1ST FLE FRAMING IN
BLDG #12A IS TO BE REMOVED
REPLACED W/ 2" x 10" (ACT.) JOISTS @
16" O.C. W/ 1/2" T & G FLOORING.

BEARING PLATE 12x1/2
CONF. - SIMILAR TO
DETAIL 6

5-2 FIRST FLOOR FRAMING PLAN
SCALE : 1/4" = 1' - 0"

NOTES:

1. ALL EXISTING 1ST FLR FRAMING IS TO BE REMOVED AND REPLACED W/ STEEL AS INDICATED.
2. TYPED NEW BRICKWORK INTO EXISTING TO MATCH ORIGINAL
3. JL 2"x2"x3' FRAMING BETWEEN T3 8"x2' & C10 x 30 @ SOUTH WALL - SEAT COND. SIMILAR TO

2	5
55	52
4. ALL VERT. L3 6"x6"x1' & P3 6"x1' ARE TO BE RECEIVED IN INTO EXIST BRICK WALLS.

S-2


PREPARED
RSJ / WLB
DESIGNED
JACOBS
DRAWN
BARLOW
CHECKED
6 / 78

DRAWING NO.	
385 25.006A	
PCIP PKG.	SHEET
110	47
	65

Contractor shall verify all dimensions and take own measurements at the job site before commencing work. Advise of any error on

PHASE II-B RESTORATION

FIRST FLOOR PLAN	BLDG 12 & 12A
1 0	5
10	10

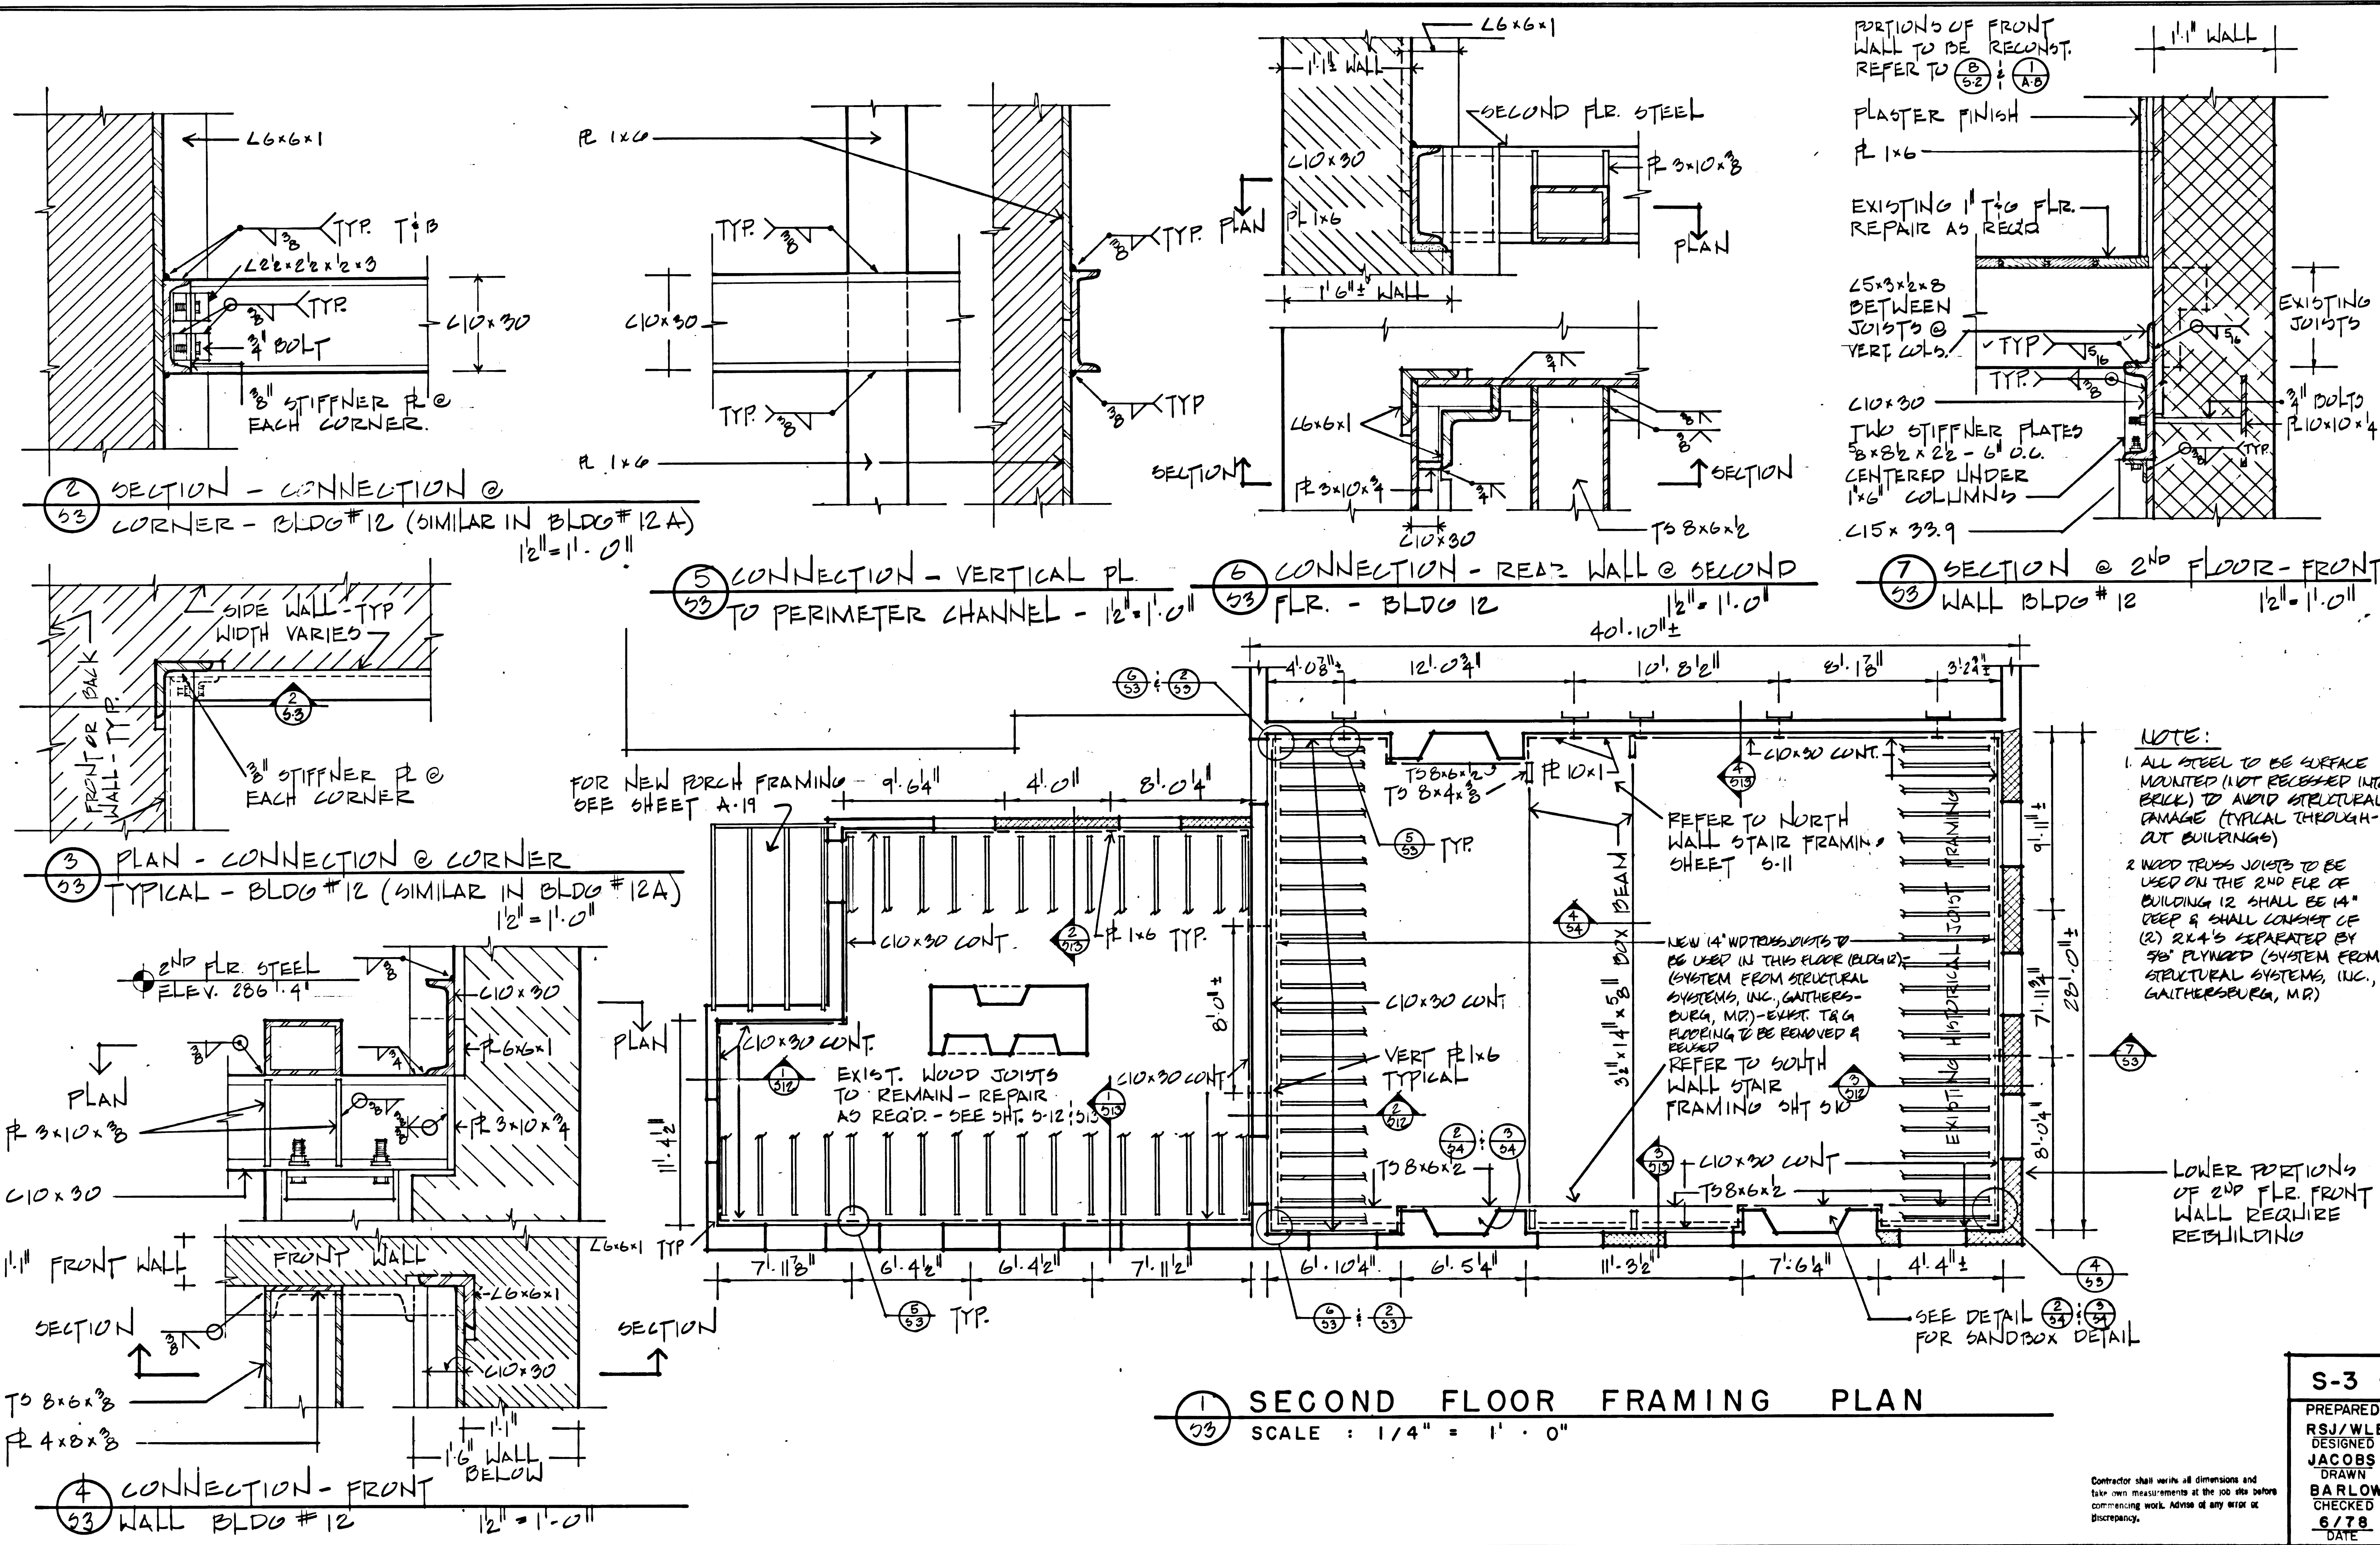


PHASE II-B RESTORATION

SECOND FLOOR PLAN - BLDG 12 & 12A

SCALE : 1/4" = 1'-0"

S-3

PREPARED RSJ/WLB DESIGNED JACOBS	DRAWING NO. 385 25,006A
DRAWN BARLOW	PKG. SHEET
CHECKED 6/78	110 48
DATE	OF 65

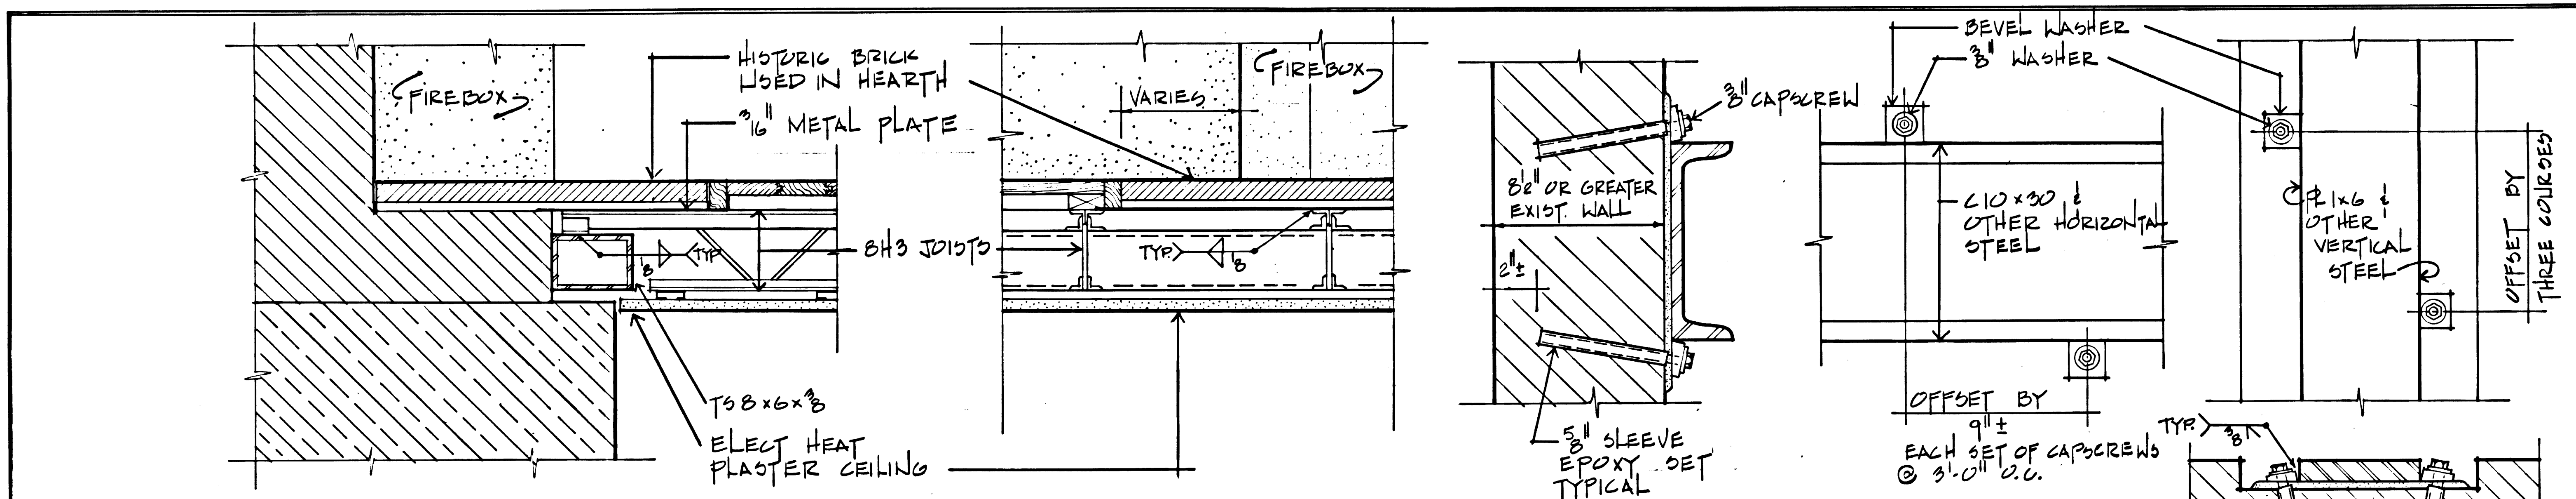


2 SECTION @ 1ST FLOOR
25 FIREPLACES - BLDG #12 12" = 1'-0"


3 SECTION @ 1ST FLOOR
25 FIREPLACES - BLDG #12 12" = 1'-0"

4 CONNECTION - HORIZ. STEEL TO
25 EXIST. BRICK WALLS - 3" = 1'-0"

5 CONNECTION - VERT. STEEL TO
25 EXIST. BRICK WALLS - 3" = 1'-0"

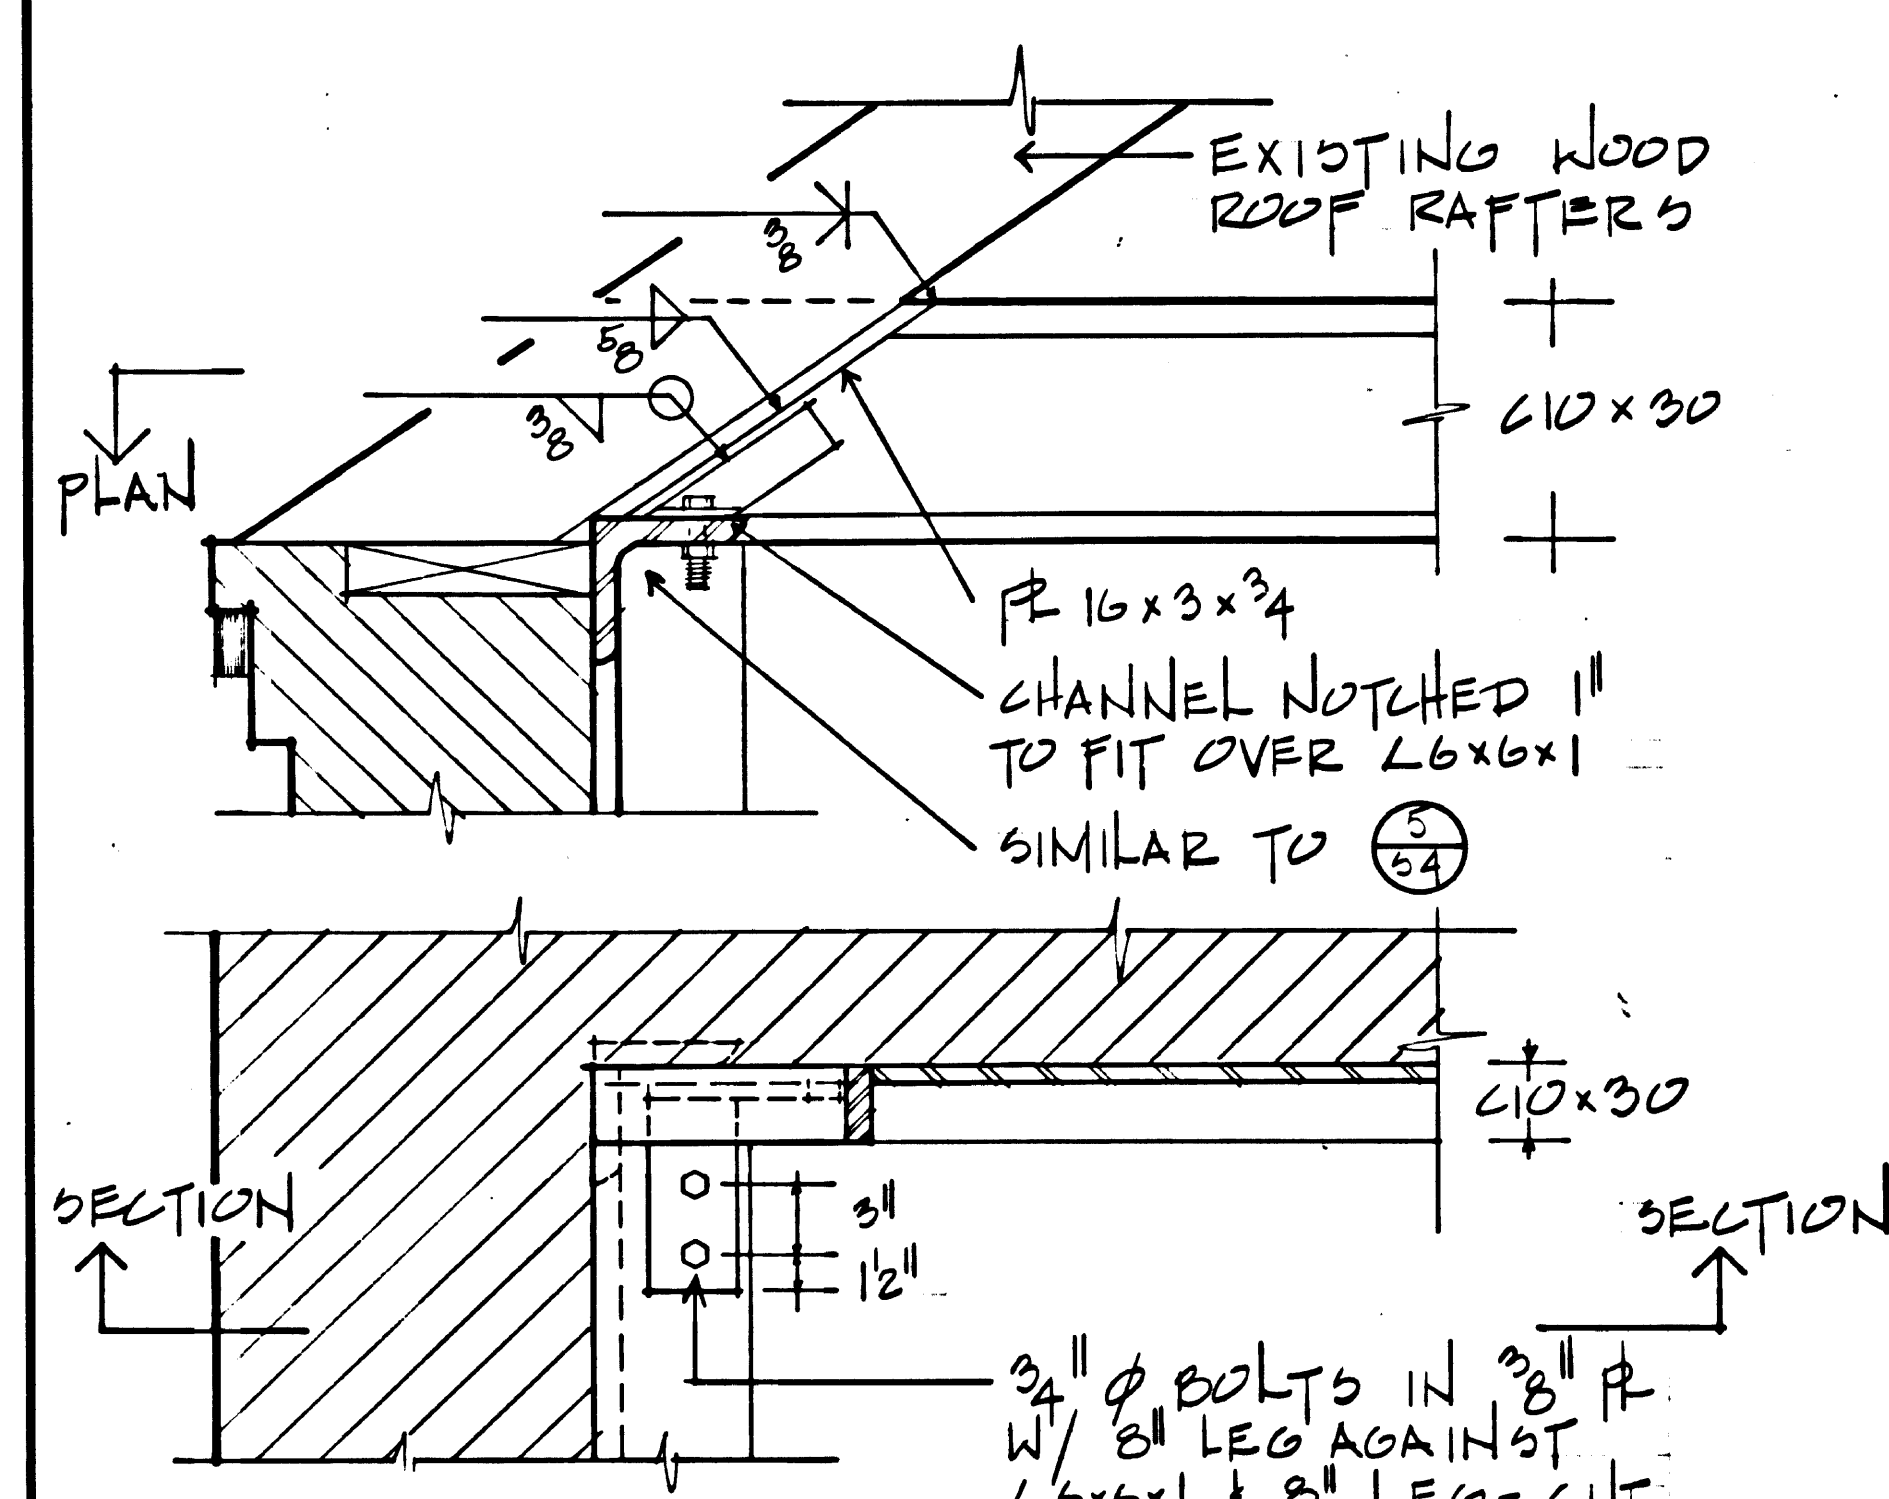

6 CONNECTION @ 4TH FLOOR
25 CORNER6 - BLDG #12 12" = 1'-0"

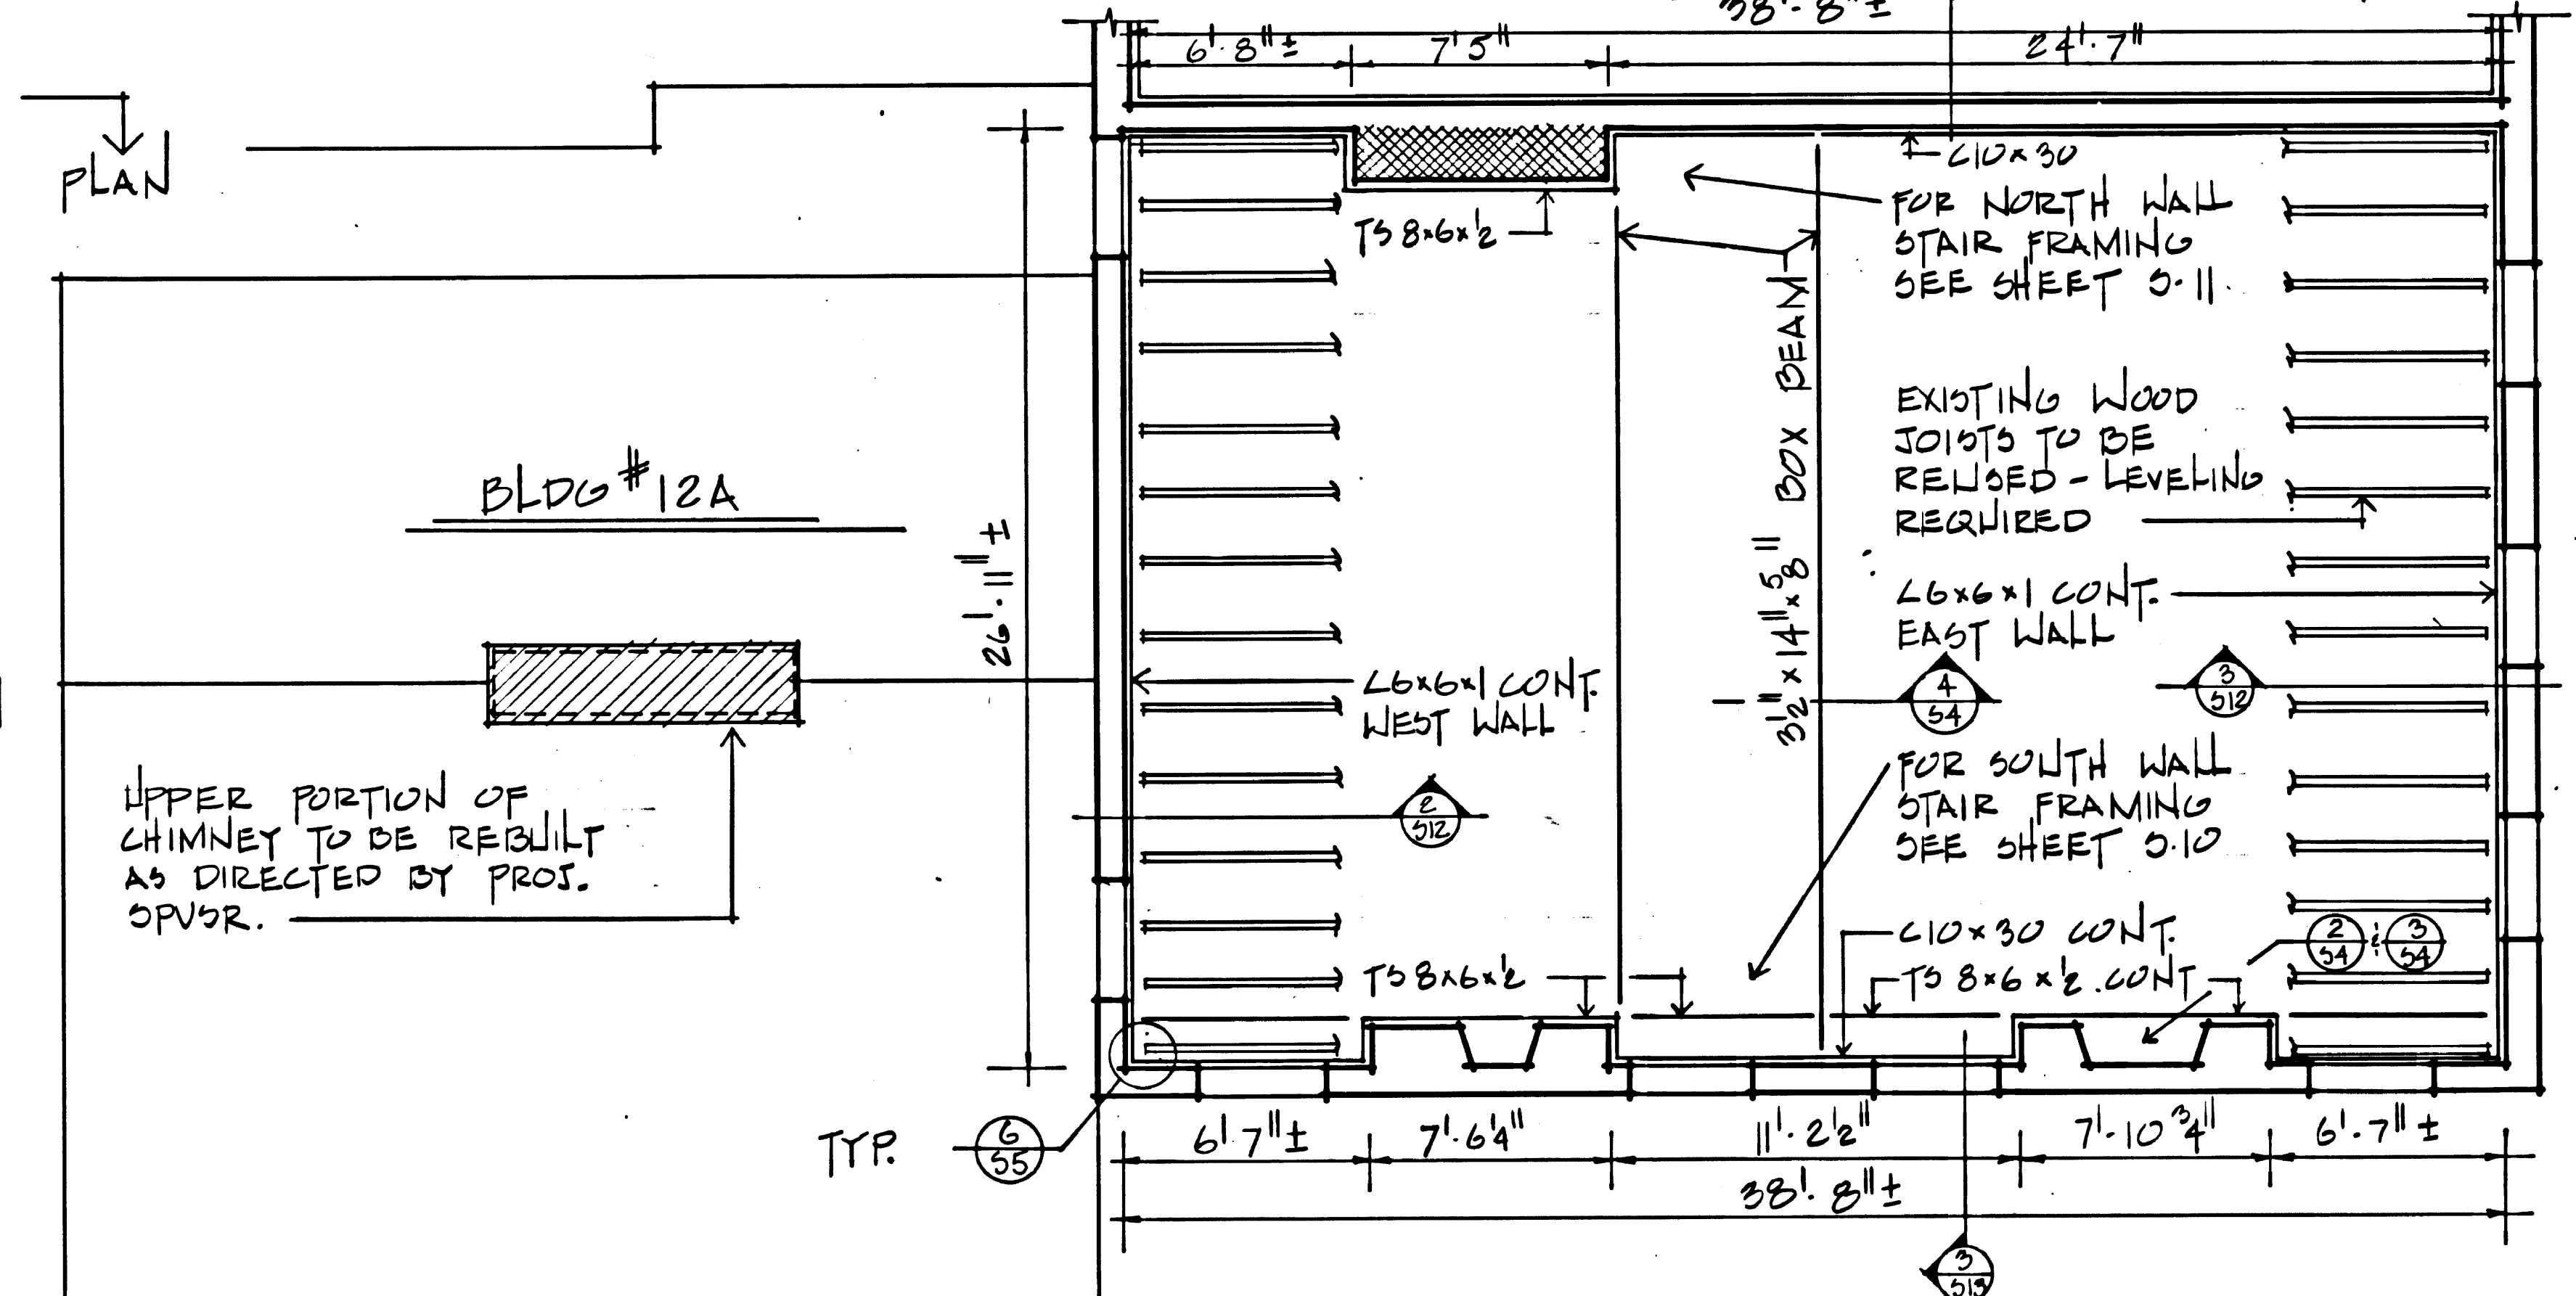

1 FOURTH FLOOR FRAMING PLAN
25 SCALE : 1/4" = 1'-0"



NOTES:
1. ALL STEEL TO BE SURFACE
PAINTED (NOT RECESSED INTO
BRICK) TO AVOID STRUCTURAL
DAMAGE (TYPICAL THROUGHOUT
BUILDINGS)

PHASE II-B
RESTORATION

FOURTH FLOOR PLAN - BLDG 128 12A
SCALE : 1/4" = 1'-0"

S-5	DRAWING NO.
PREPARED RSJ/WLB	385
DESIGNED JACOBS	25,006A
DRAWN BARLOW	SHEET
CHECKED 6/78	50
DATE	OF 65

Contractor shall verify all dimensions and
take measurements at the job site before
commencing work. Advise of any error in
discrepancy.

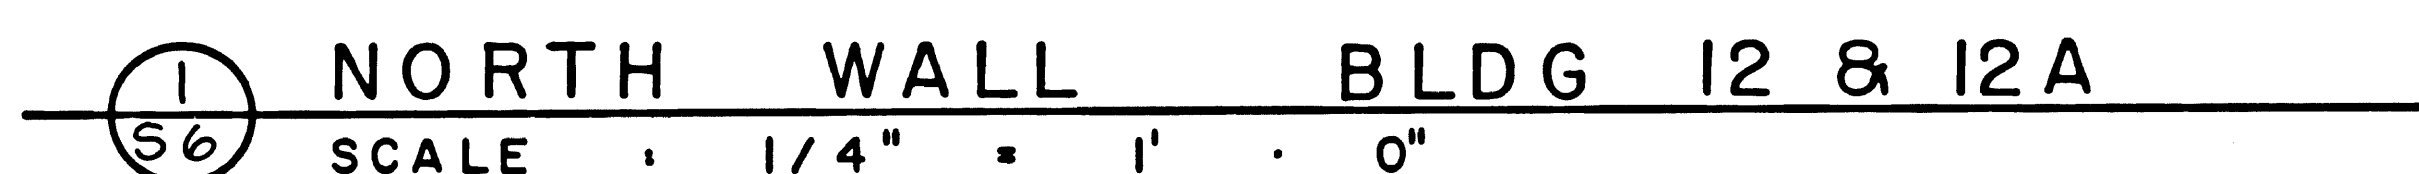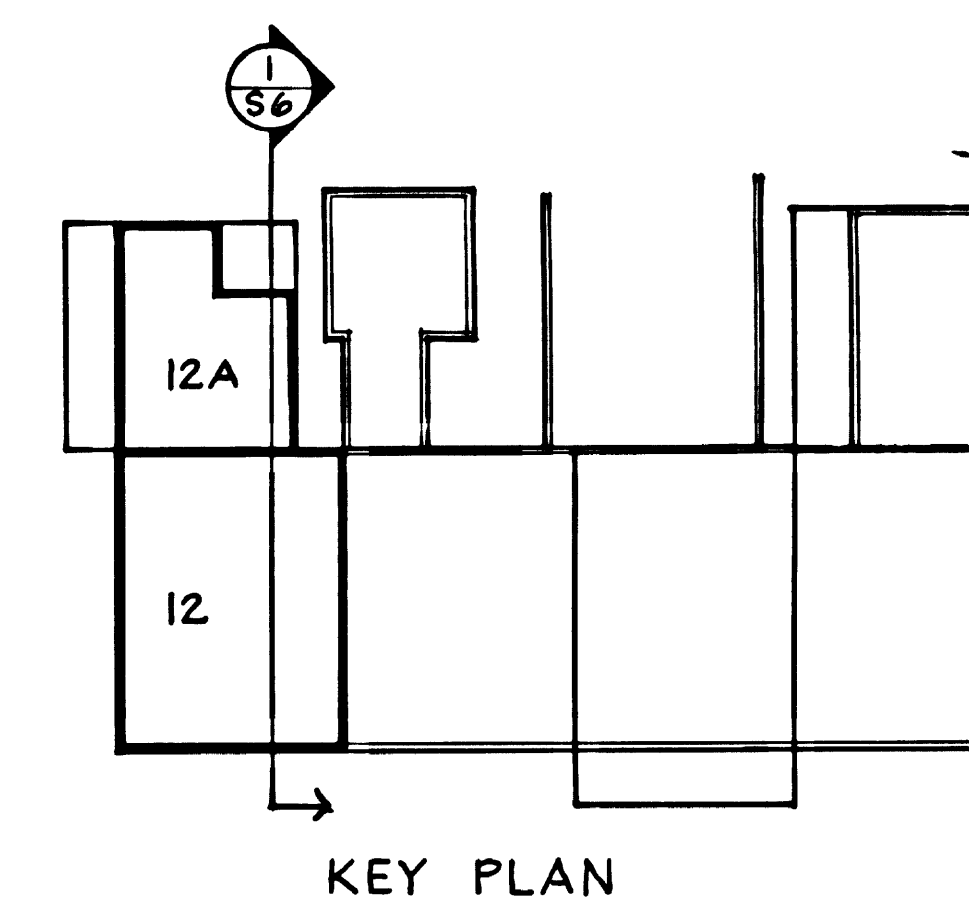

PHASE - II B RESTORATION



FRAMING SECTION — BLDG 12 & 12A

SCALE

1/4" = 1' - 0"

S-6		DRAWING NO.	
PREPARED		385	
RSJ/WLB		25.006A	
DESIGNED		PCIP	SHEET
JACOBS		PKG.	51
DRAWN		II/O	OF 65
BARLOW			
CHECKED			
6/78			
DATE			

Contractor shall verify all dimensions and take own measurements at the job site before commencing work. Advise us any error or discrepancy.

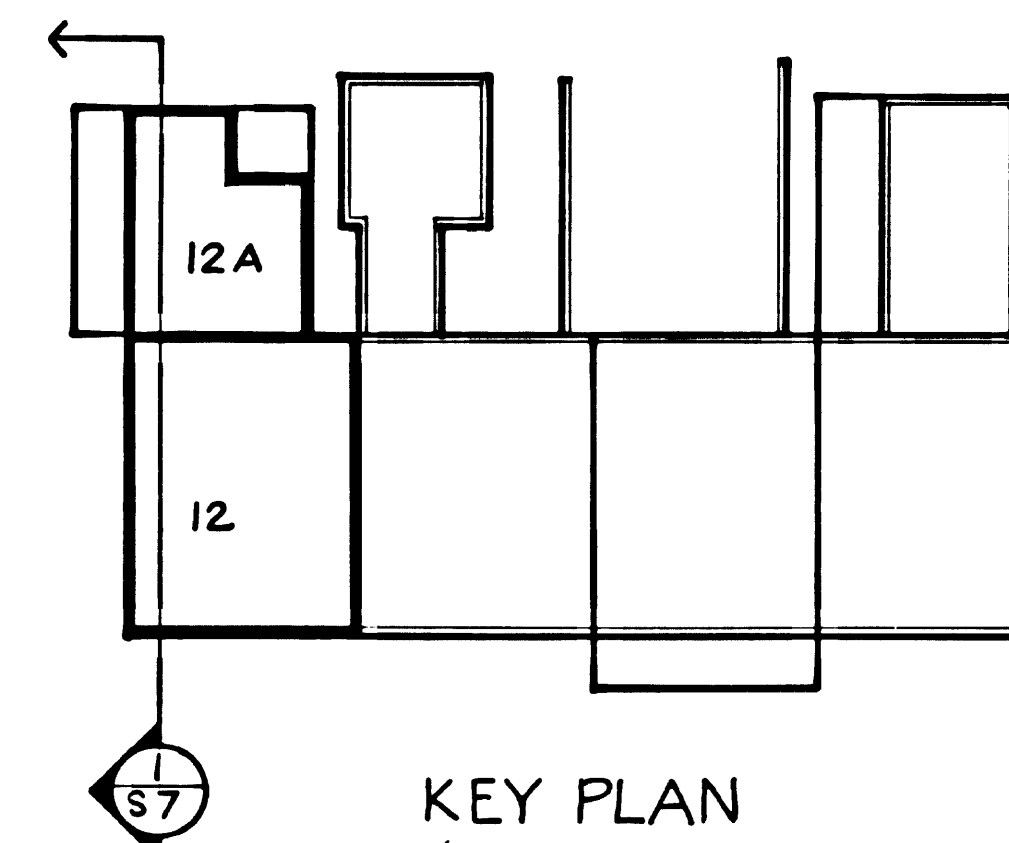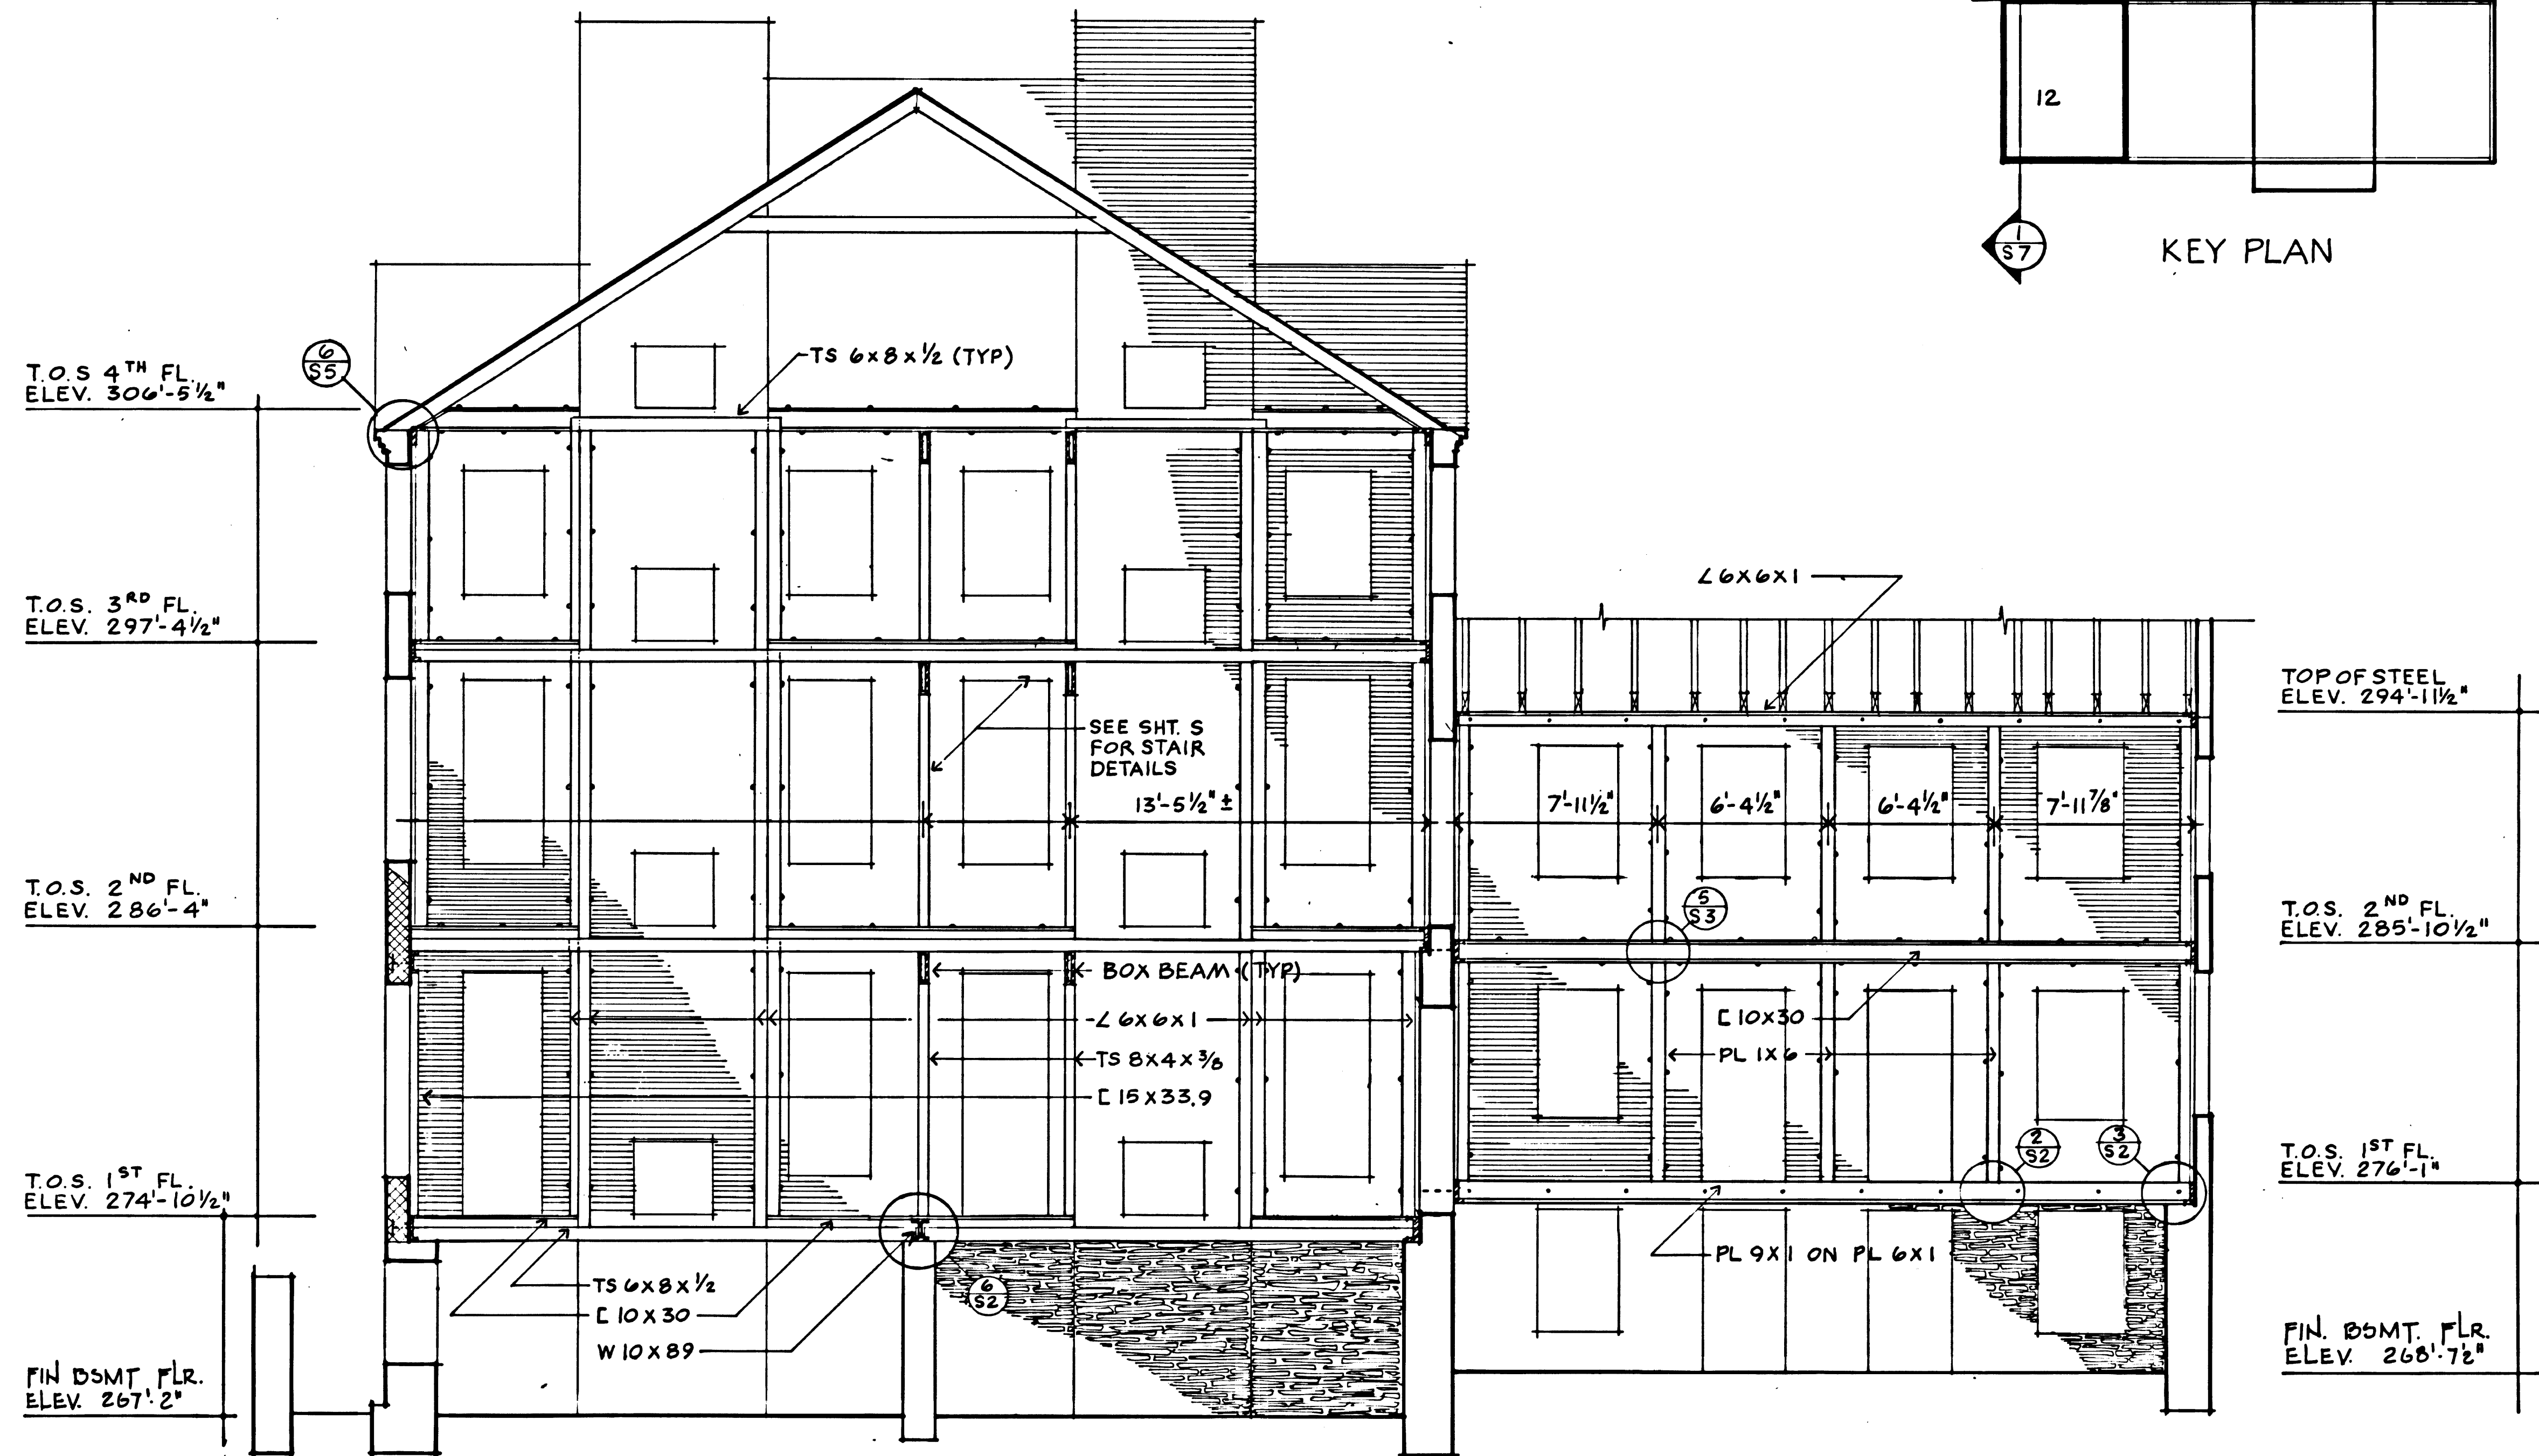

S7
SOUTH WALL BLDG 12 & 12A
 SCALE : 1/4" = 1' - 0"


PHASE II-B
RESTORATION

FRAMING SECTION — BLDG 12 & 12A


SCALE : 1/4" = 1' - 0"

S-7		DRAWING NO.	
PREPARED	RSJ/WLB	DESIGNED	385
DRAWN	JACOBS	CHECKED	25,006A
DATE	6/78	DATE	6/78
SHEET		SHEET	
110		52	
OF 65		OF 65	


Contractor shall verify all dimensions and
give own measurements at the job site before
commencing work. Advise of any errors in
drawings.

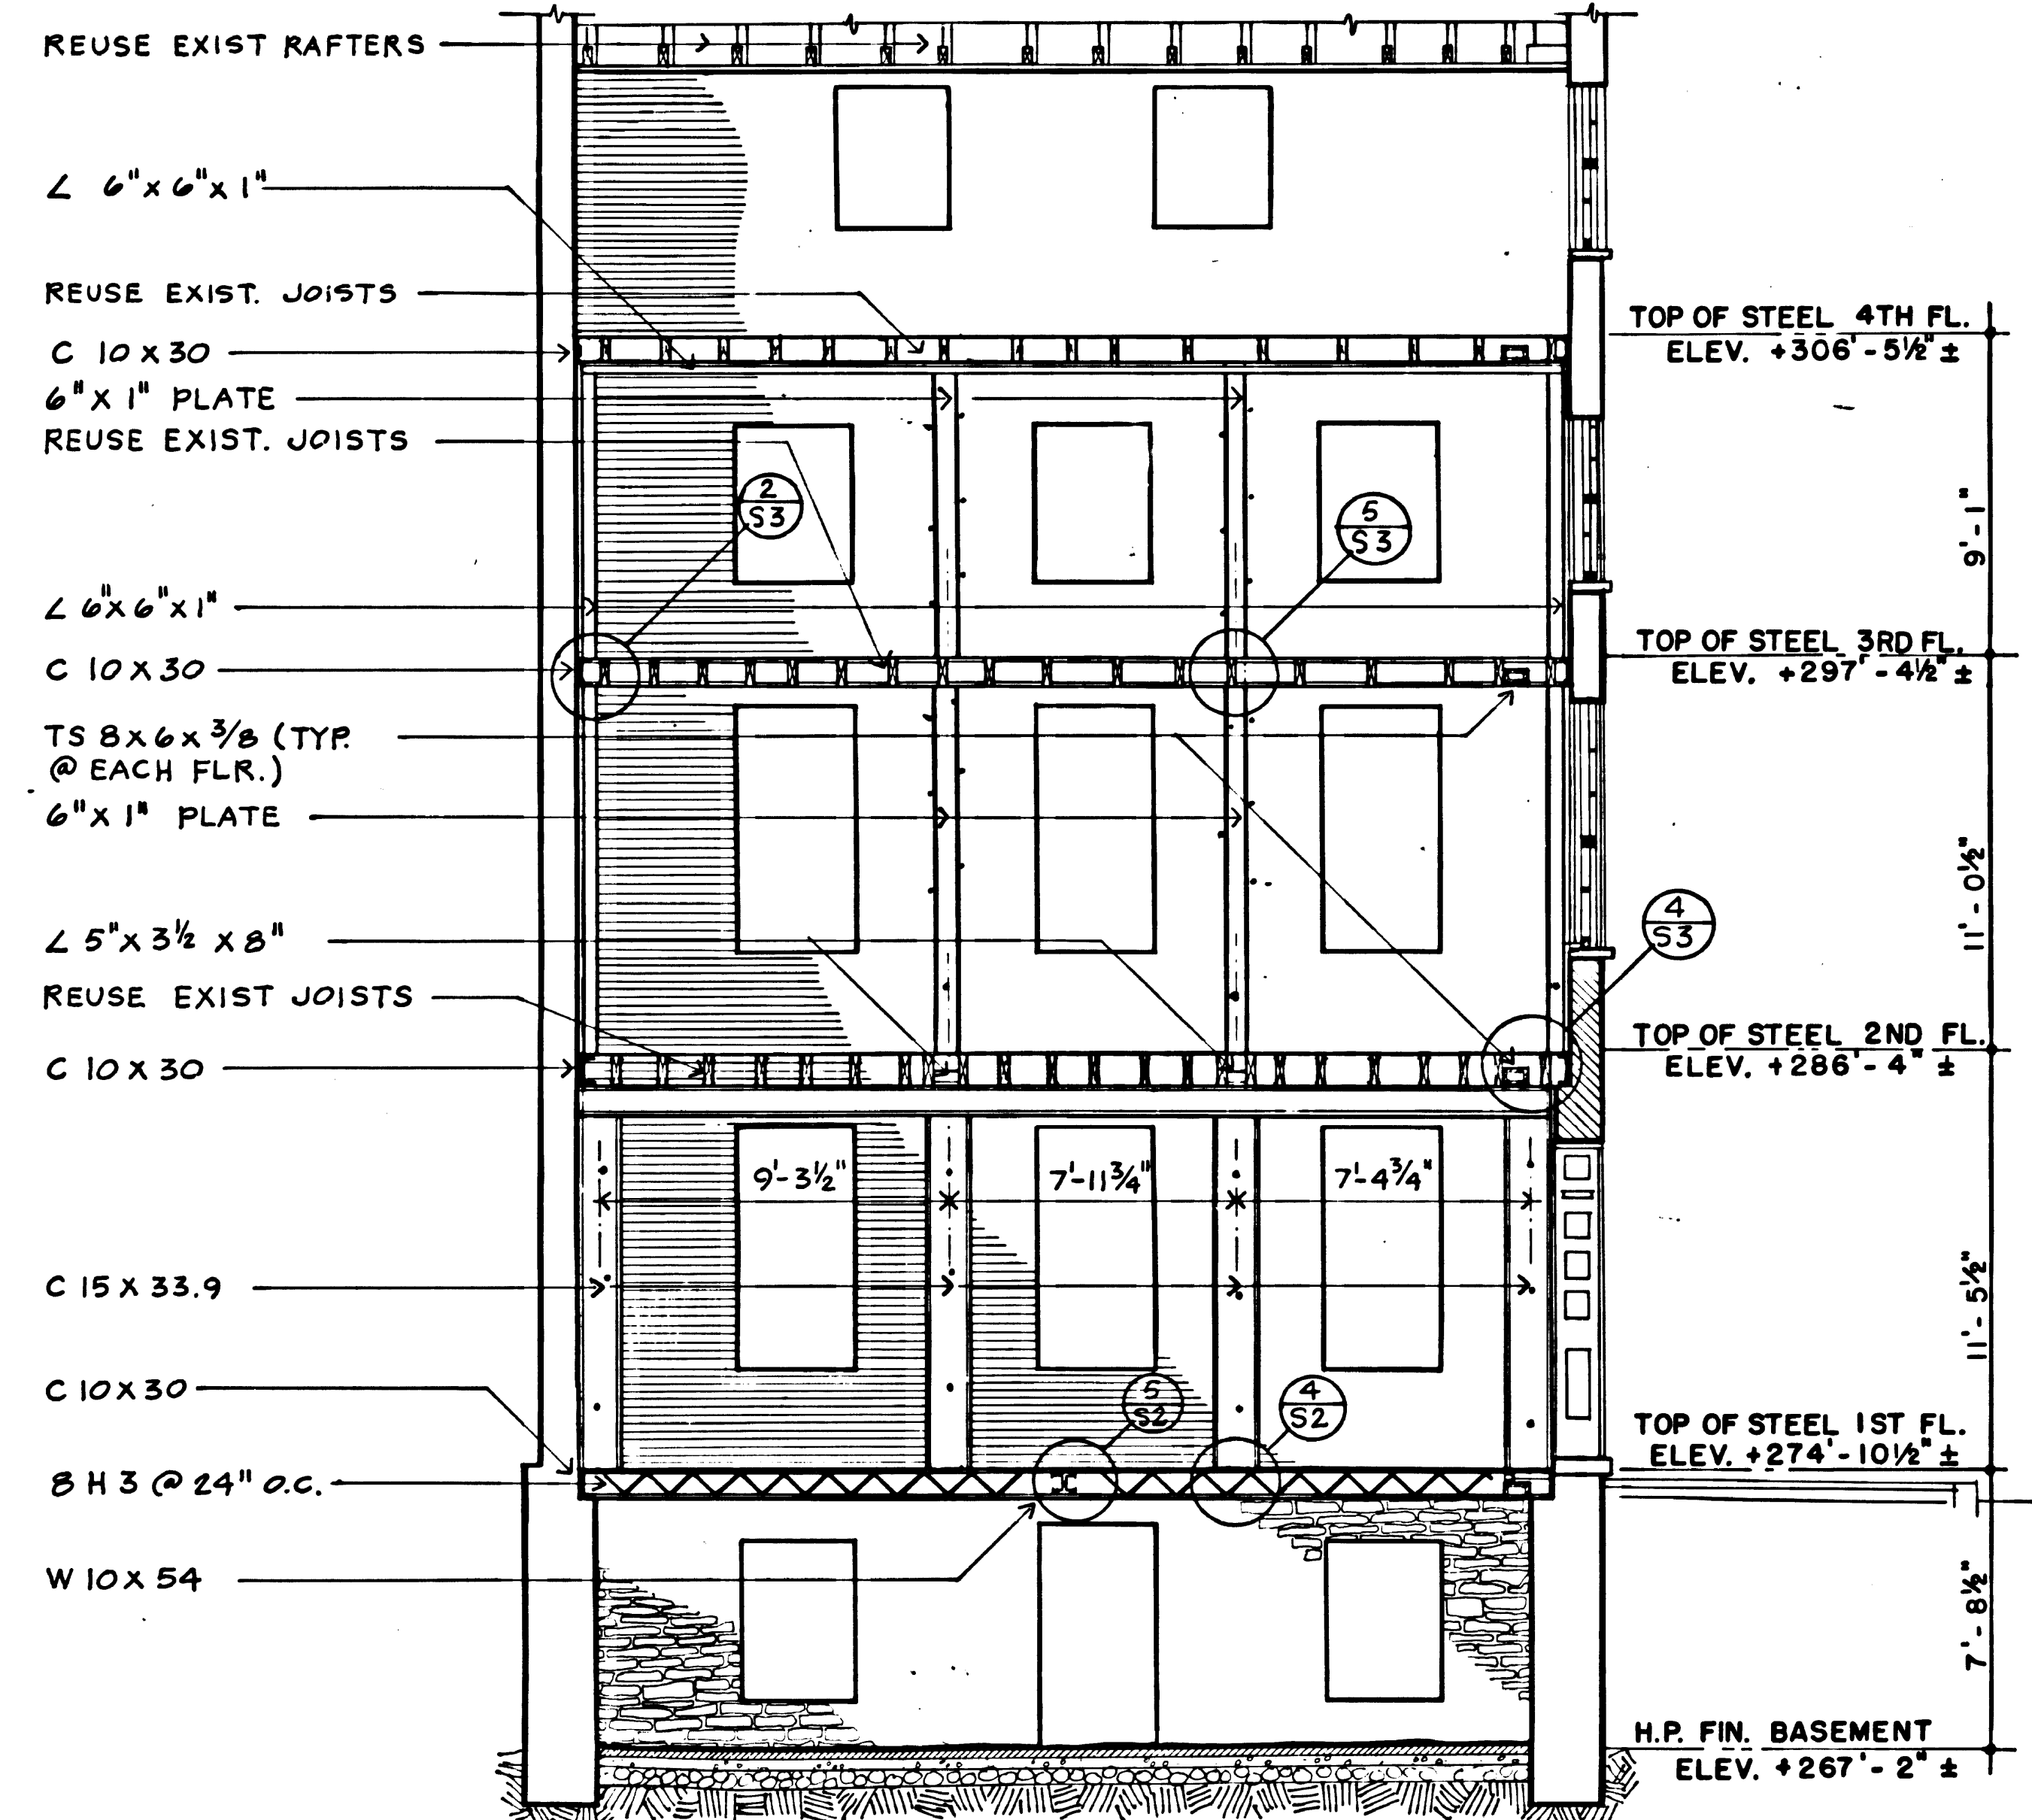

2 EAST WALL — BLDG 12
SCALE : 1/4" = 1' - 0"

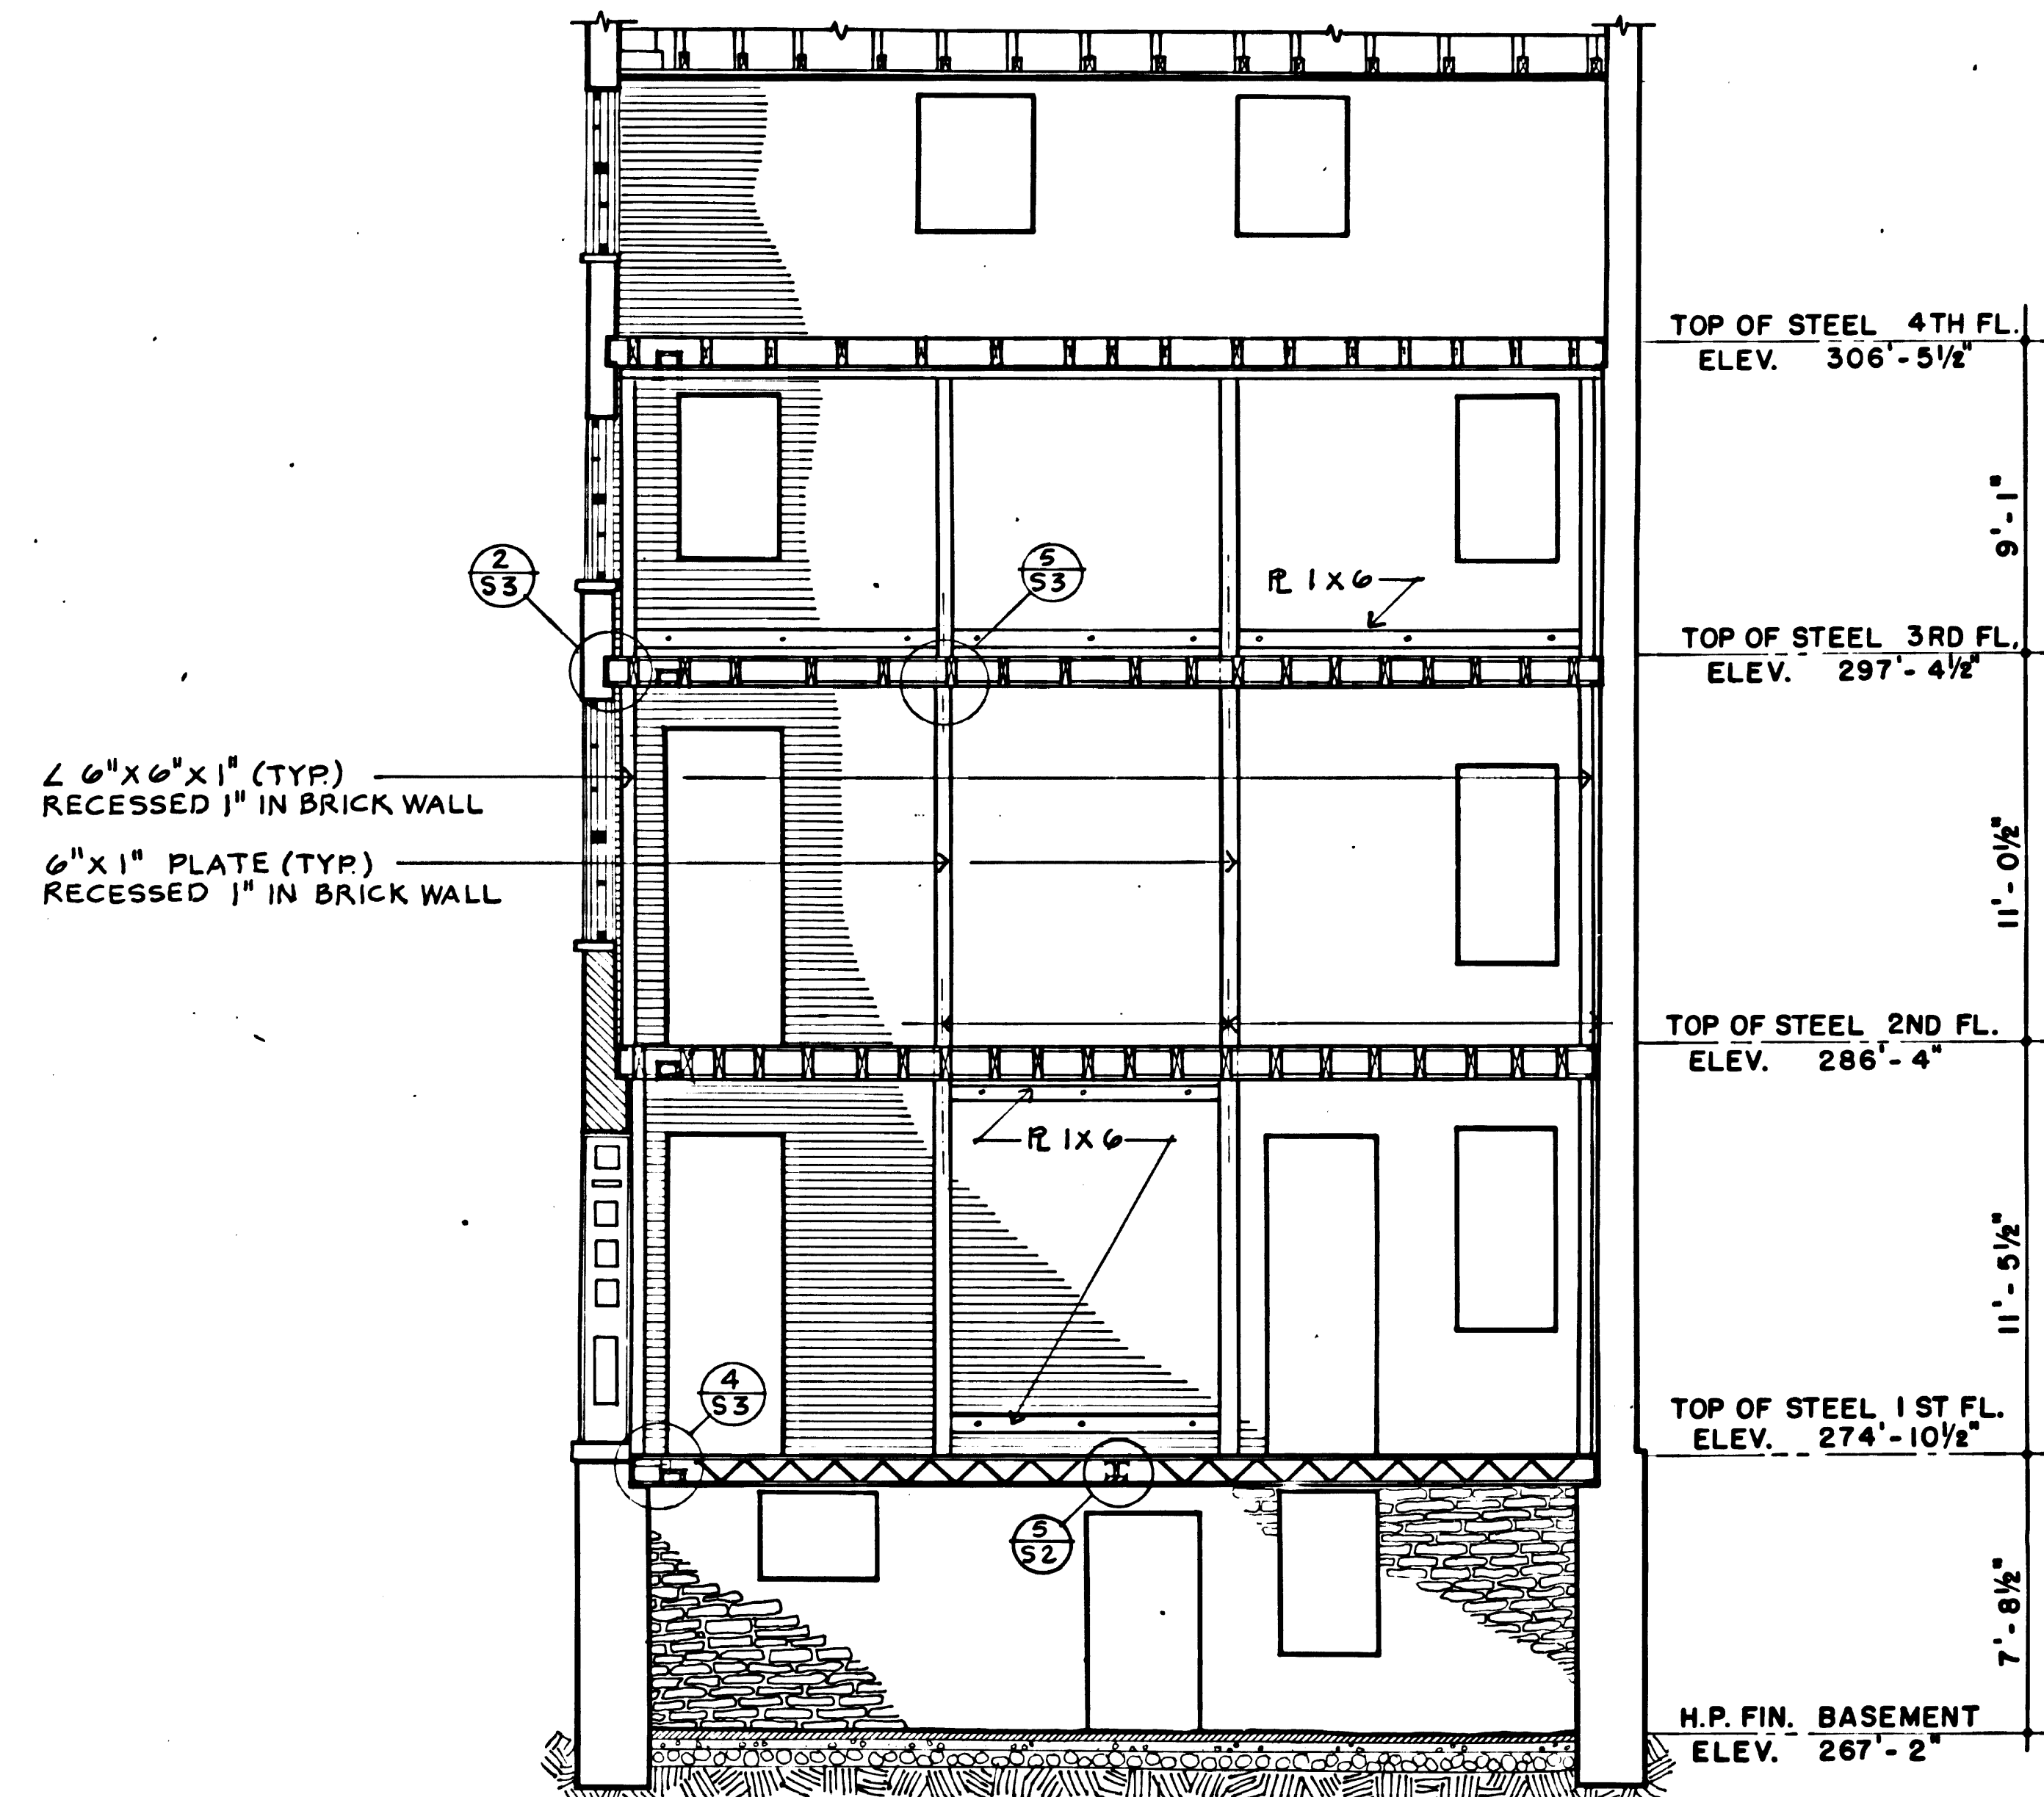

1 WEST WALL — BLDG 12
SCALE : 1/4" = 1' - 0"

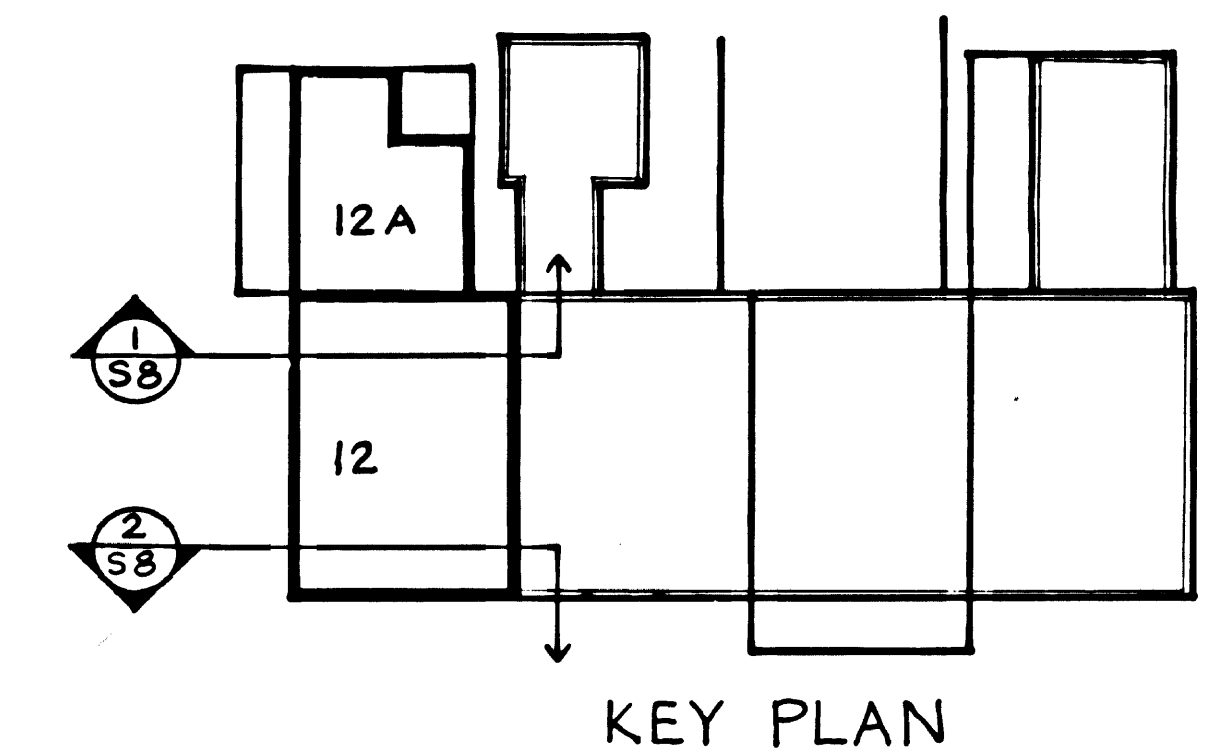

PHASE II-B
RESTORATION

FRAMING SECTIONS BLDG 12
SCALE : 1/4" = 1' - 0"

S-8		DRAWING NO.	
PREPARED		385	
RSJ/WLB		25,006A	
DESIGNED		JACOBS	
DRAWN		PKG	
BARLOW		SHEET	
CHECKED		110	
6/78		53	
DATE		OF 65	

Check for steel verify all dimensions and
to each shop drawing with a 1/4" scale before
commencing work. Approval of any detail or
modification.

NOTES ON BOLTING

IN GENERAL

1. USE $\frac{3}{4}$ " BOLTS - TYPICAL
2. BOLT AT ALL VERT / HORIZ CHANNEL CONNECTIONS. BOLTS MAY BE MOVED OFF CENTER TO CLEAR FRAMING MEMBERS (EXCEPT EPOXY SET BOLTS)
3. REFER TO FRAMING SECTIONS FOR APPROX. BOLT LOCATIONS.

EPOXY SET BOLTS


1. SEE DETAILS (4/25) (5/25) FOR METHOD & LOCATION OF ATTACHMENT
2. SETS OF BOLTS TO BE SPACED AT APPROX 3'-0" O.C.

BOLTS IN NEW WALL CONST.


1. BOLTS ATTACHED TO $\frac{1}{2}$ "x10"x4" SET IN NEW MASONRY WALLS.
2. BOLTING IS THROUGH THE CENTERS OF THE FRAMING MEMBERS.

BOLTING IN PARTY WALLS

1. BOLTING IS THROUGH THE CENTERS OF THE FRAMING MEMBERS. (EXCEPT IF EPOXY SET)
2. REFER TO WALL SECTIONS - SHEETS S-12 & S-13

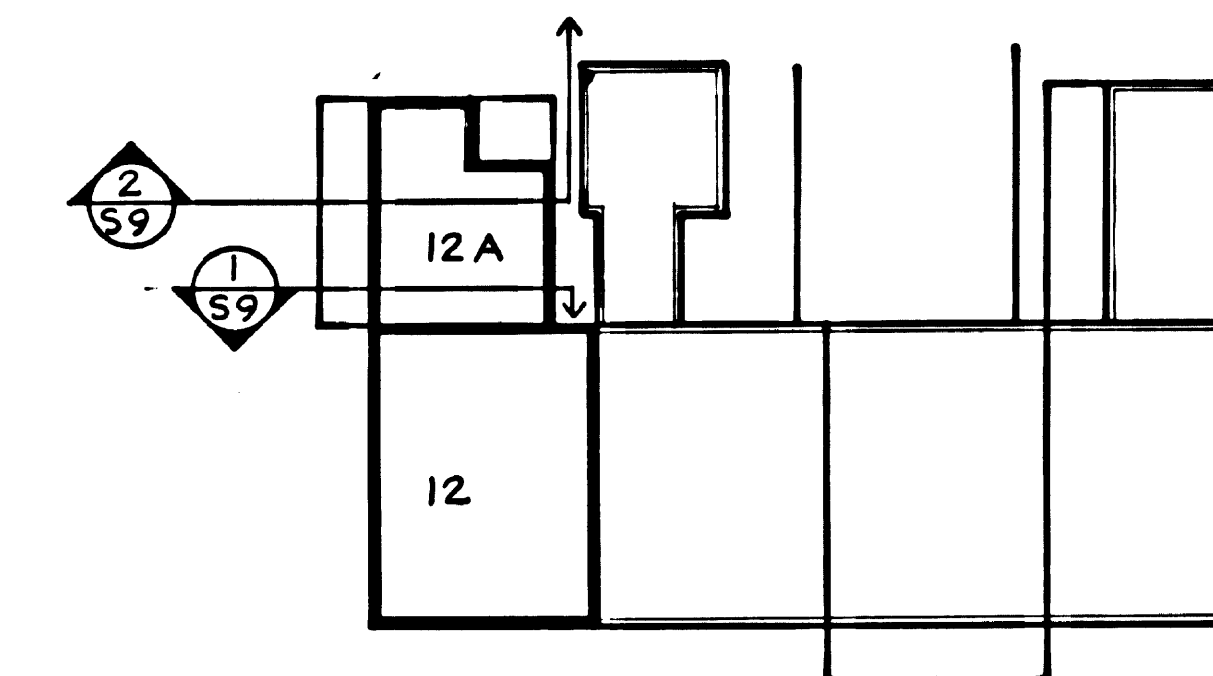

KEY PLAN

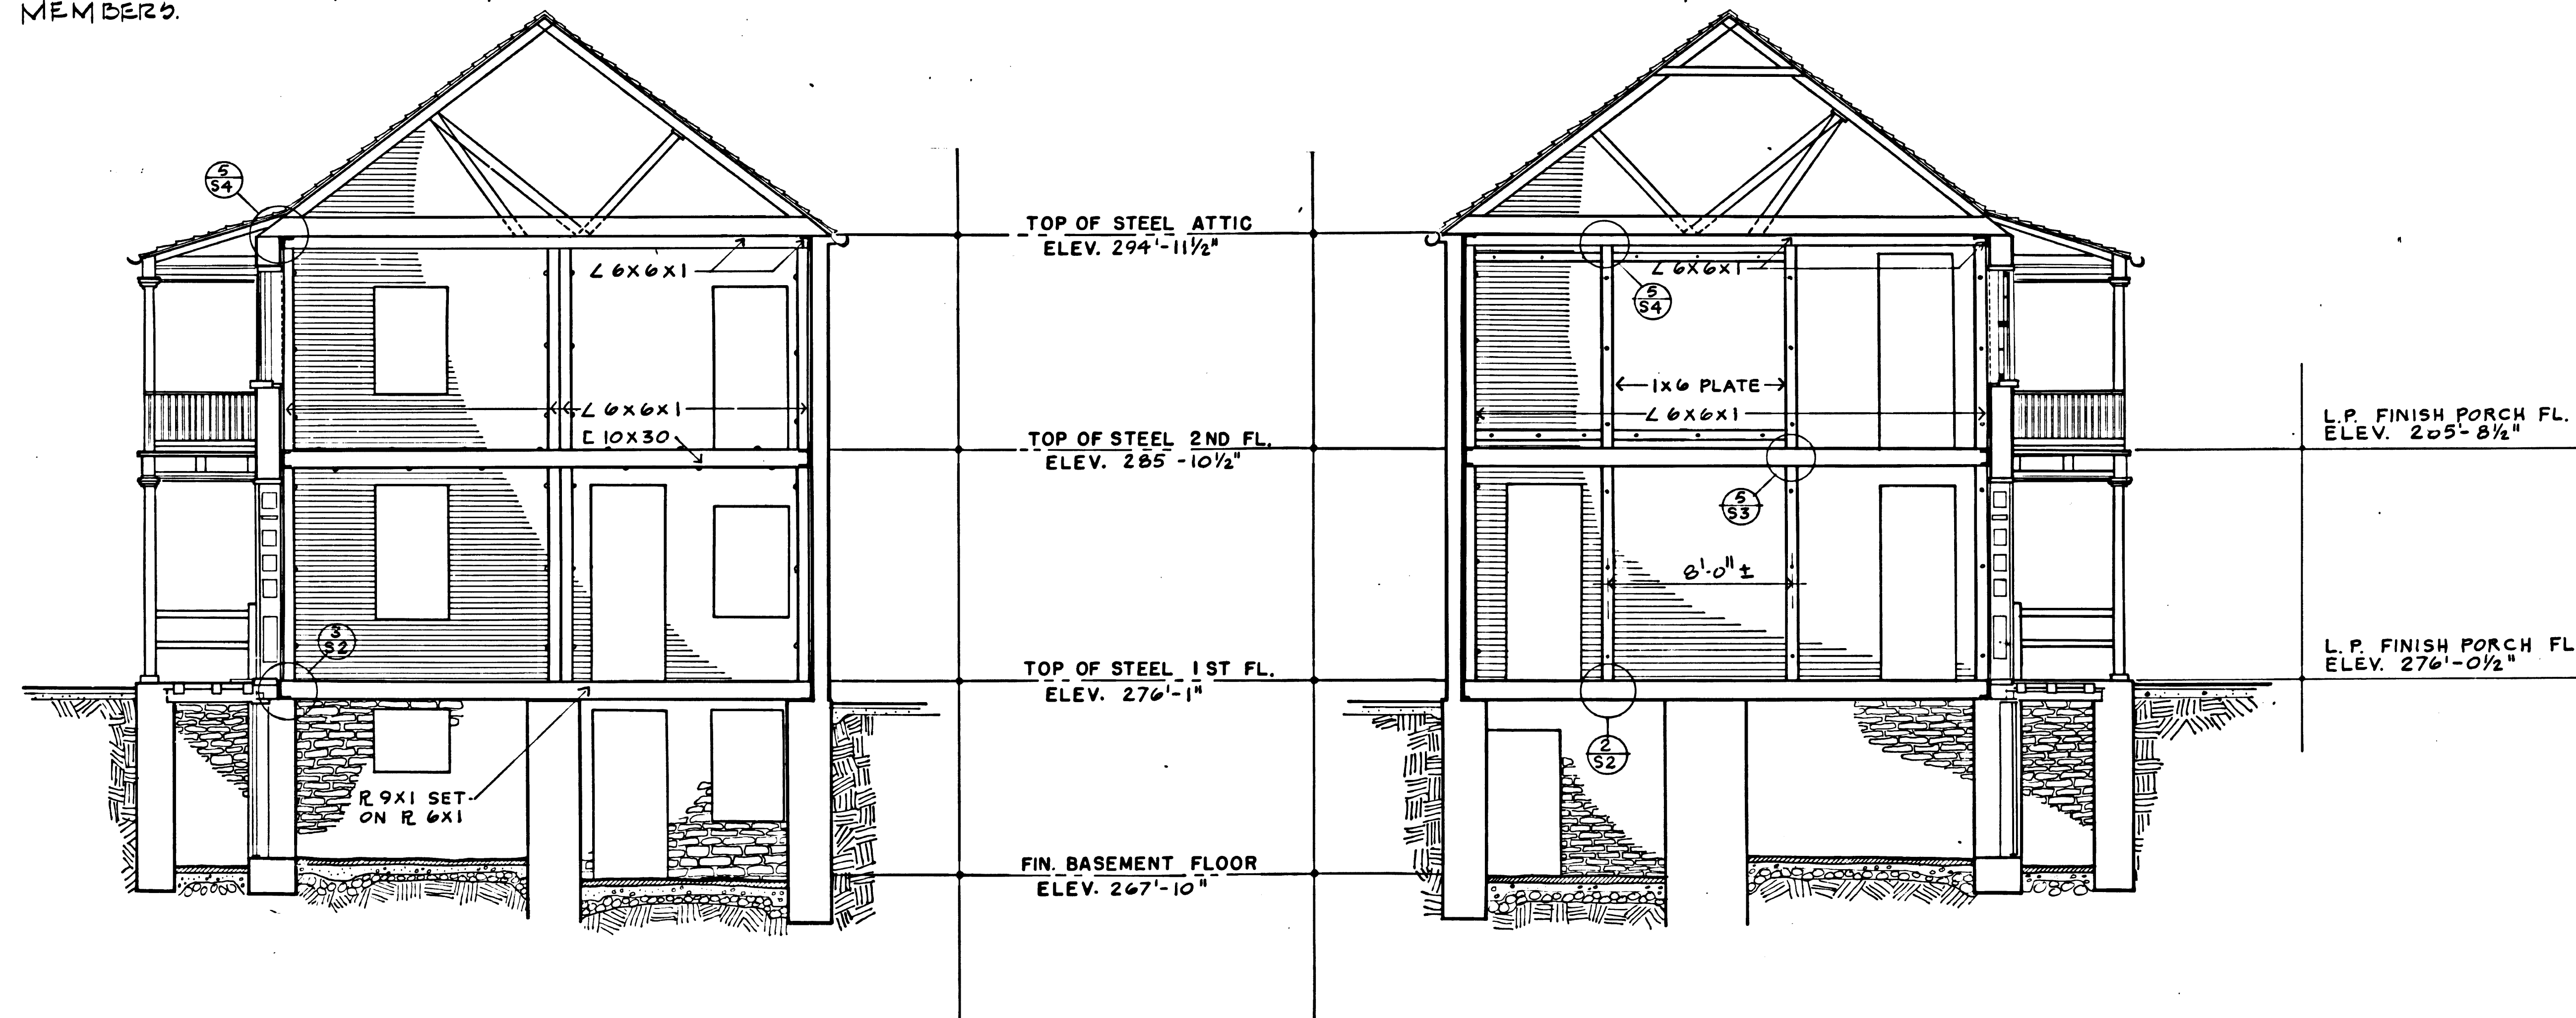

2 WEST WALL BLDG 12A
SCALE : 1/4" = 1'-0"

1 EAST WALL BLDG 12A
SCALE : 1/4" = 1'-0"

PHASE II-B
RESTORATION

FRAMING SECTION — BLDG 12 & 12A


SCALE : 1/4" = 1'-0"

S-9

PREPARED
RSJ/WLB
DESIGNED
JACOBS
DRAWN
BARLOW
CHECKED
6/78
DATE

DRAWING NO.
385
25,006A
SHEET
54
OF 65

Contractor shall verify all dimensions and take own measurements at the job site before commencing work. Advise of any error or discrepancy.

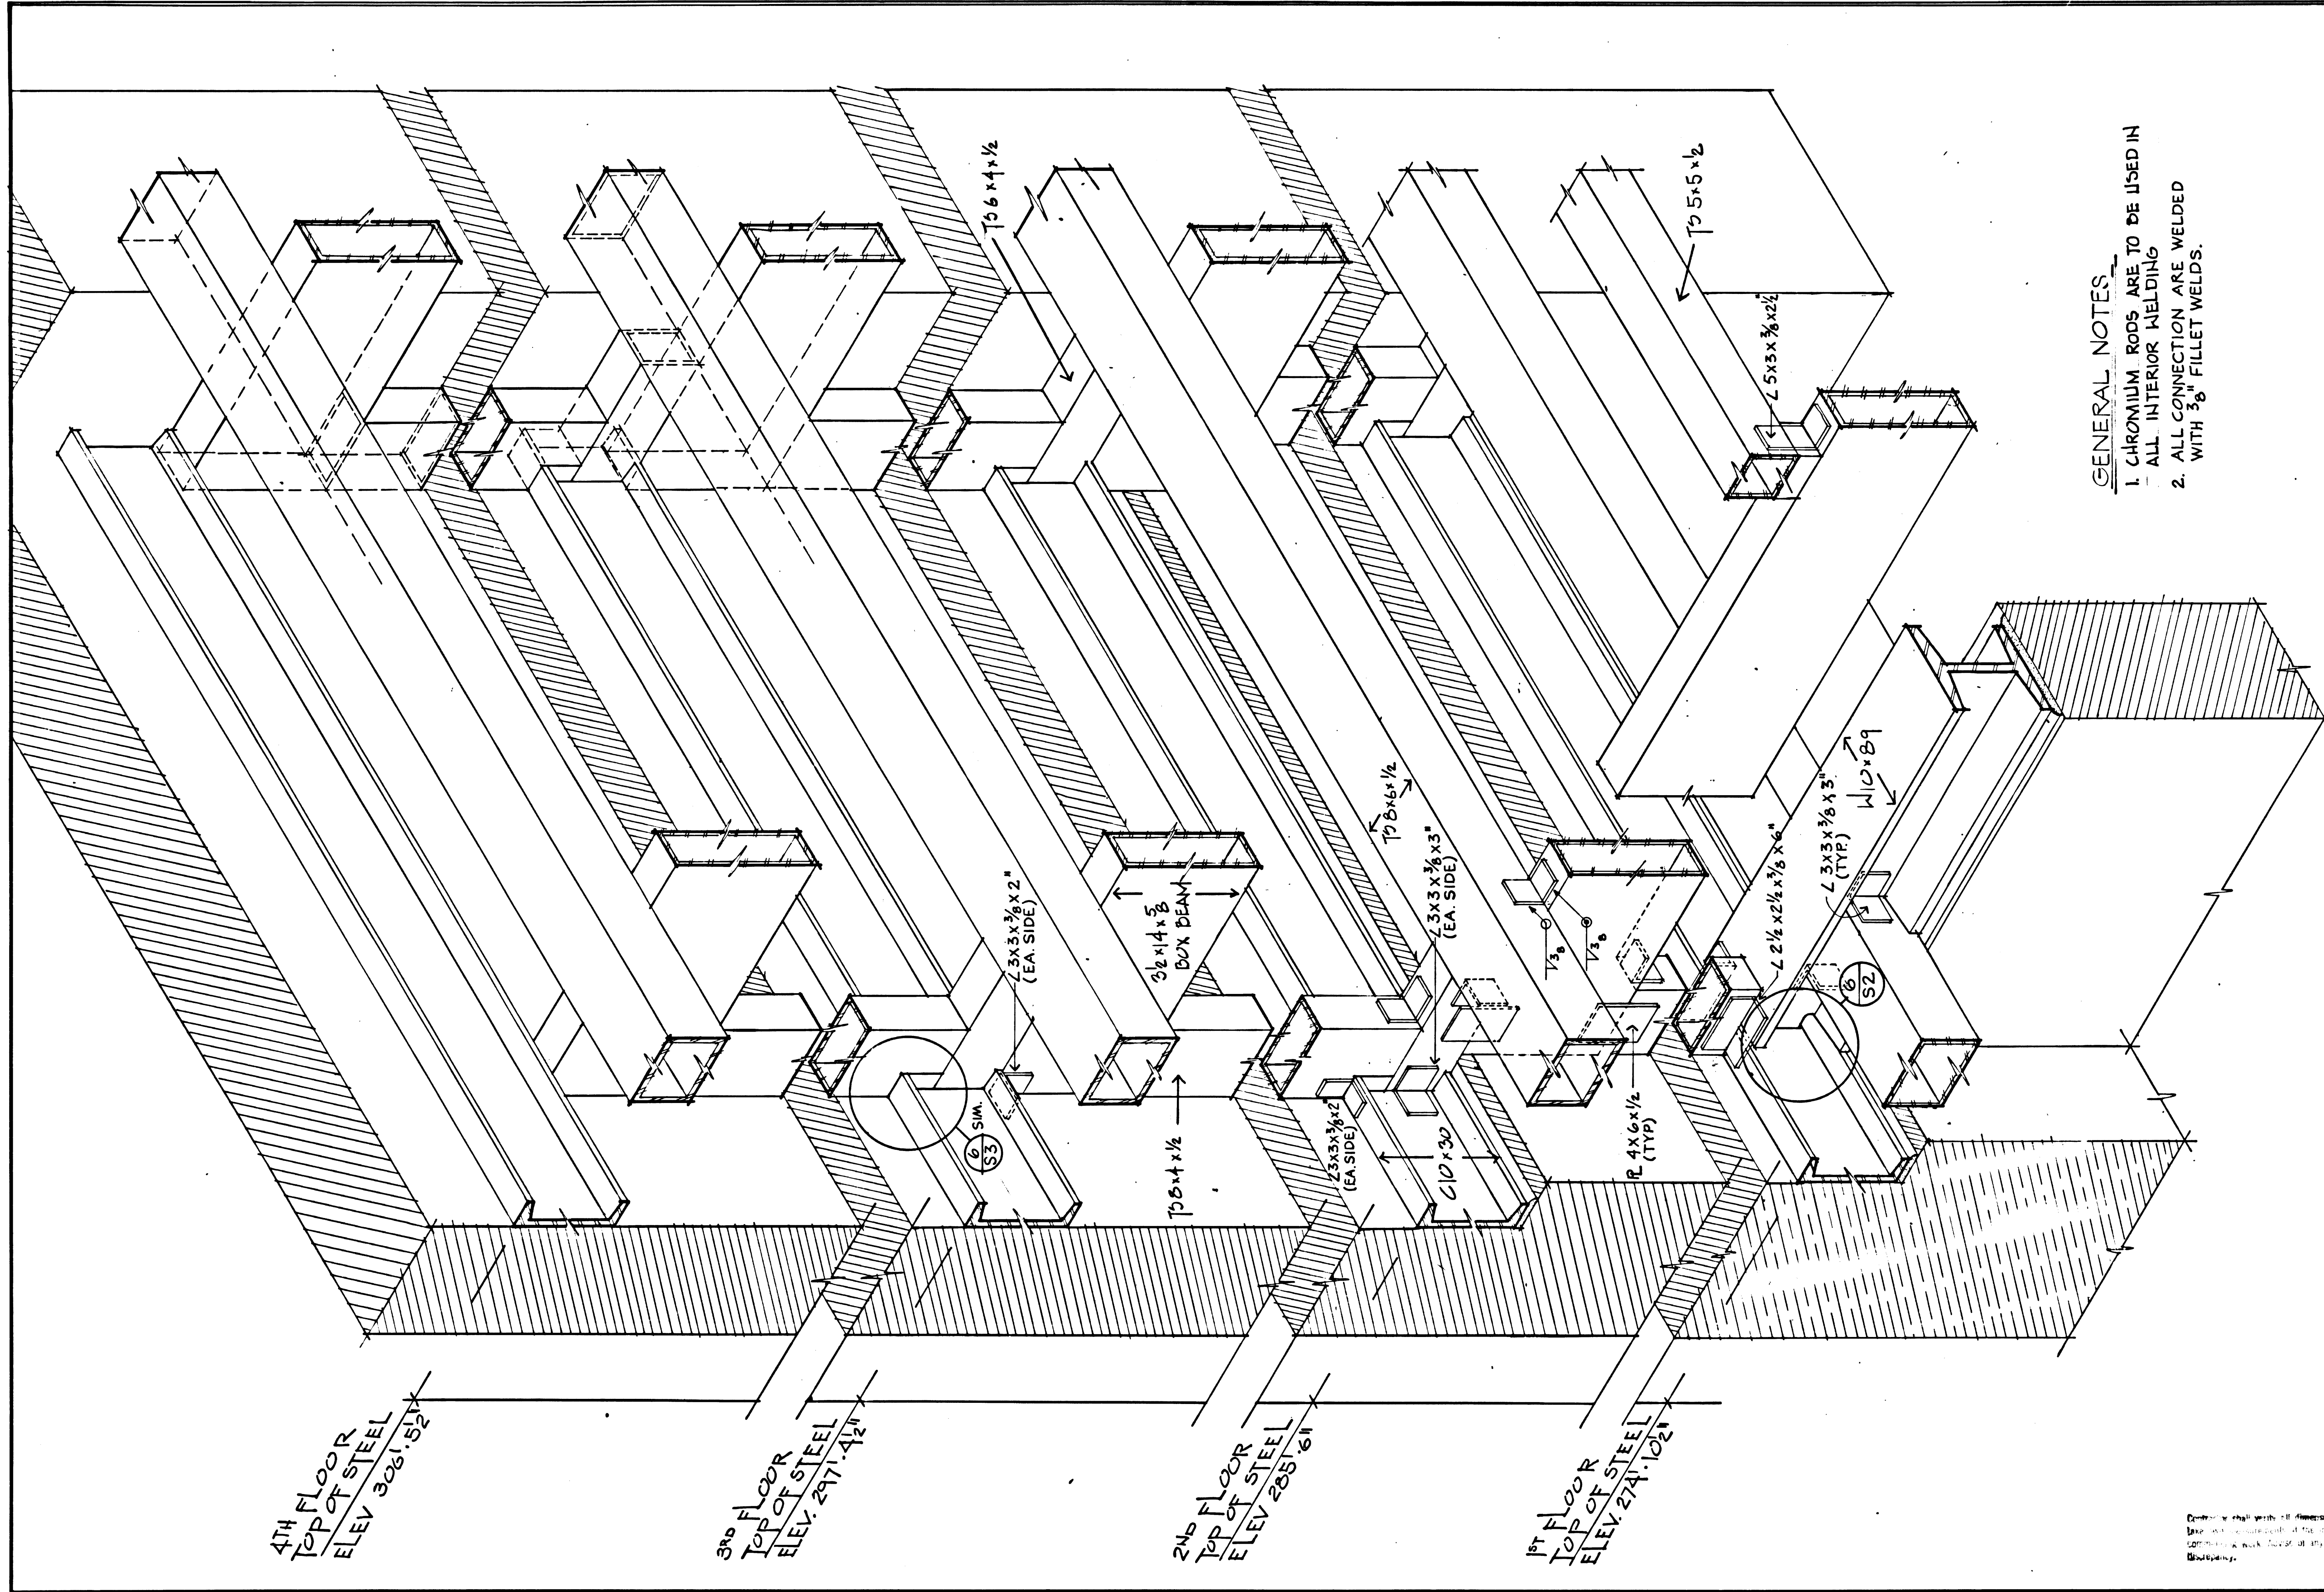

GENERAL NOTES
 1. CHROMIUM RODS ARE TO BE USED IN ALL INTERIOR WELDING
 2. ALL CONNECTIONS ARE WELDED WITH 5/8" FILLET WELDS.

1-1 SOUTH WALL STAIR FRAMING - BLDG 12

S-10


PREPARED
 RSJ/WLB
 DESIGNED
 JACOBS
 DRAWN
 BARLOW
 CHECKED
 6/78
 DATE

DRAWING NO.
 385
 25,006A
 PCIP
 PKG
 110
 SHEET
 55
 OF 65

STAIR FRAMING ISOMETRIC - BLDG 12

SCALE 0" 6" 1 1/2" = 1' - 0"

PHASE II-B
 RESTORATION

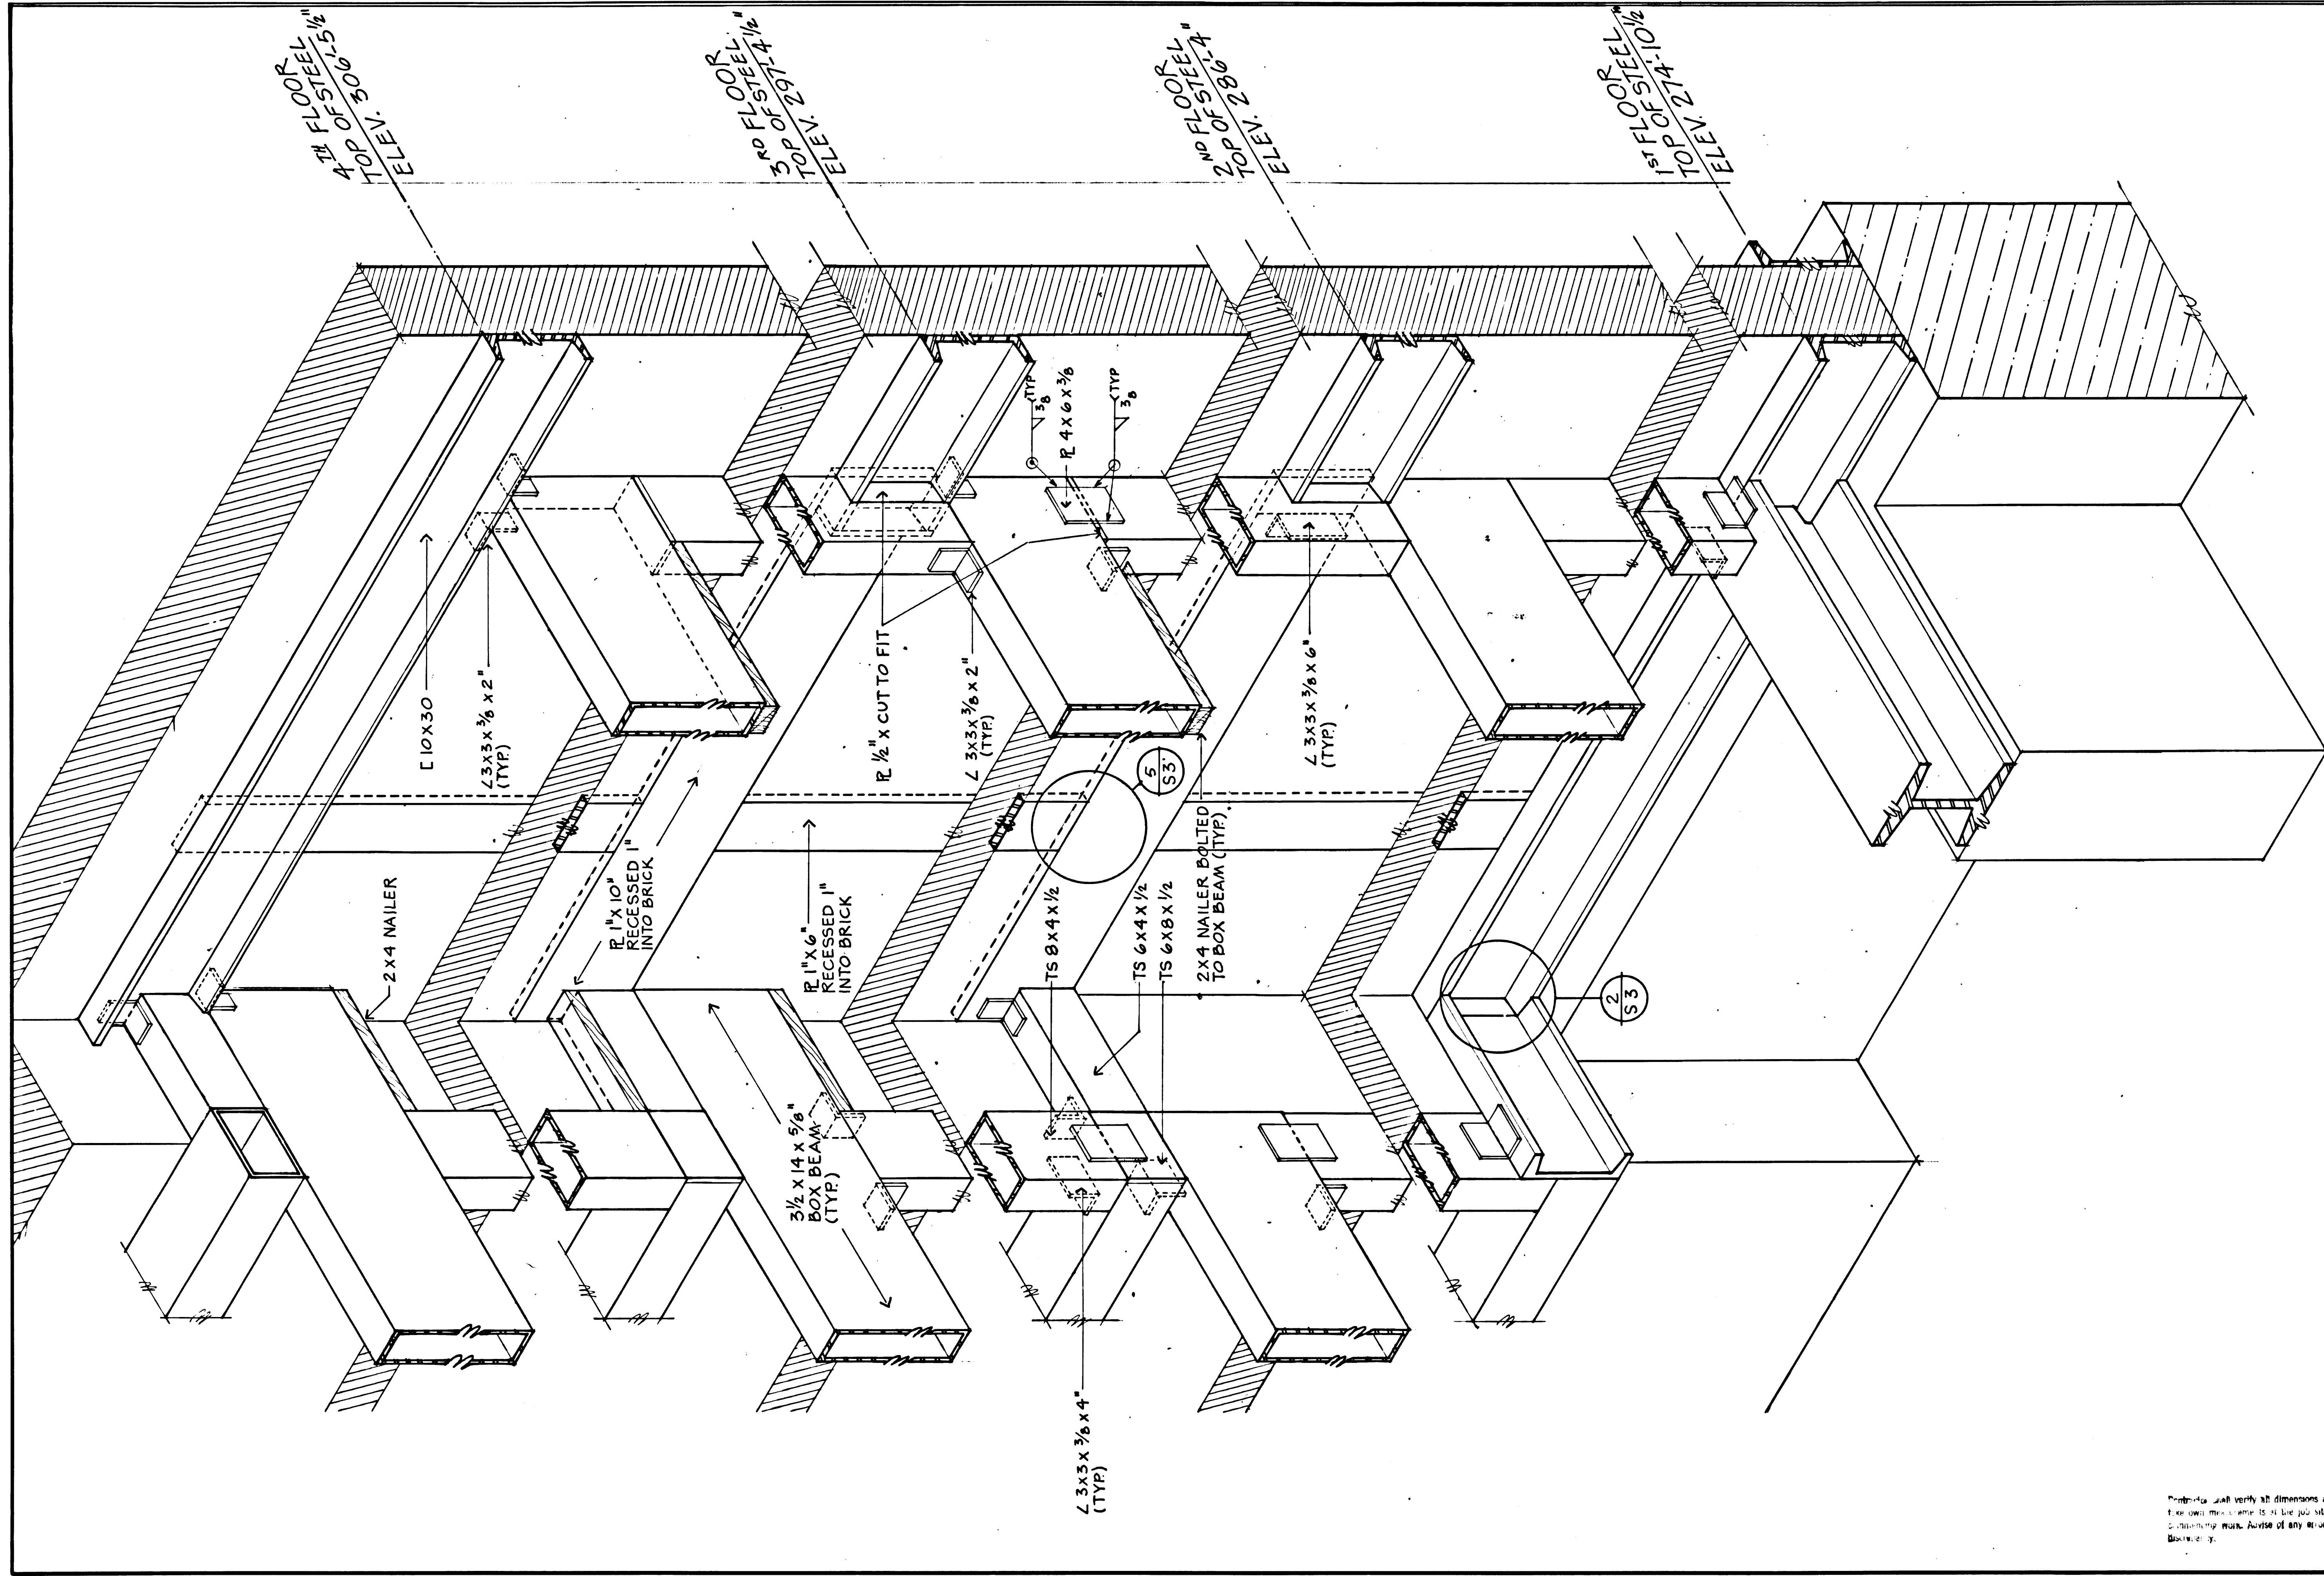

1 NORTH WALL STAIR FRAMING — BLDG 12

S-11

PREPARED
RSJ/WLB
DESIGNED
JACOBS
DRAWN
BARLOW
CHECKED
6/78
DATE


DRAWING NO.
385
25.006A
PCIP
PKG.
SHEET
56
OF 65

STAIR FRAMING ISOMETRIC — BLDG 12

PHASE II-B
RESTORATION

SCALE : 0" 6" 1" 2" 1 1/2" = 1' - 0"

Check and verify all dimensions and
locations with owner before starting work.
Do not start work until all dimensions are
checked and approved by owner.

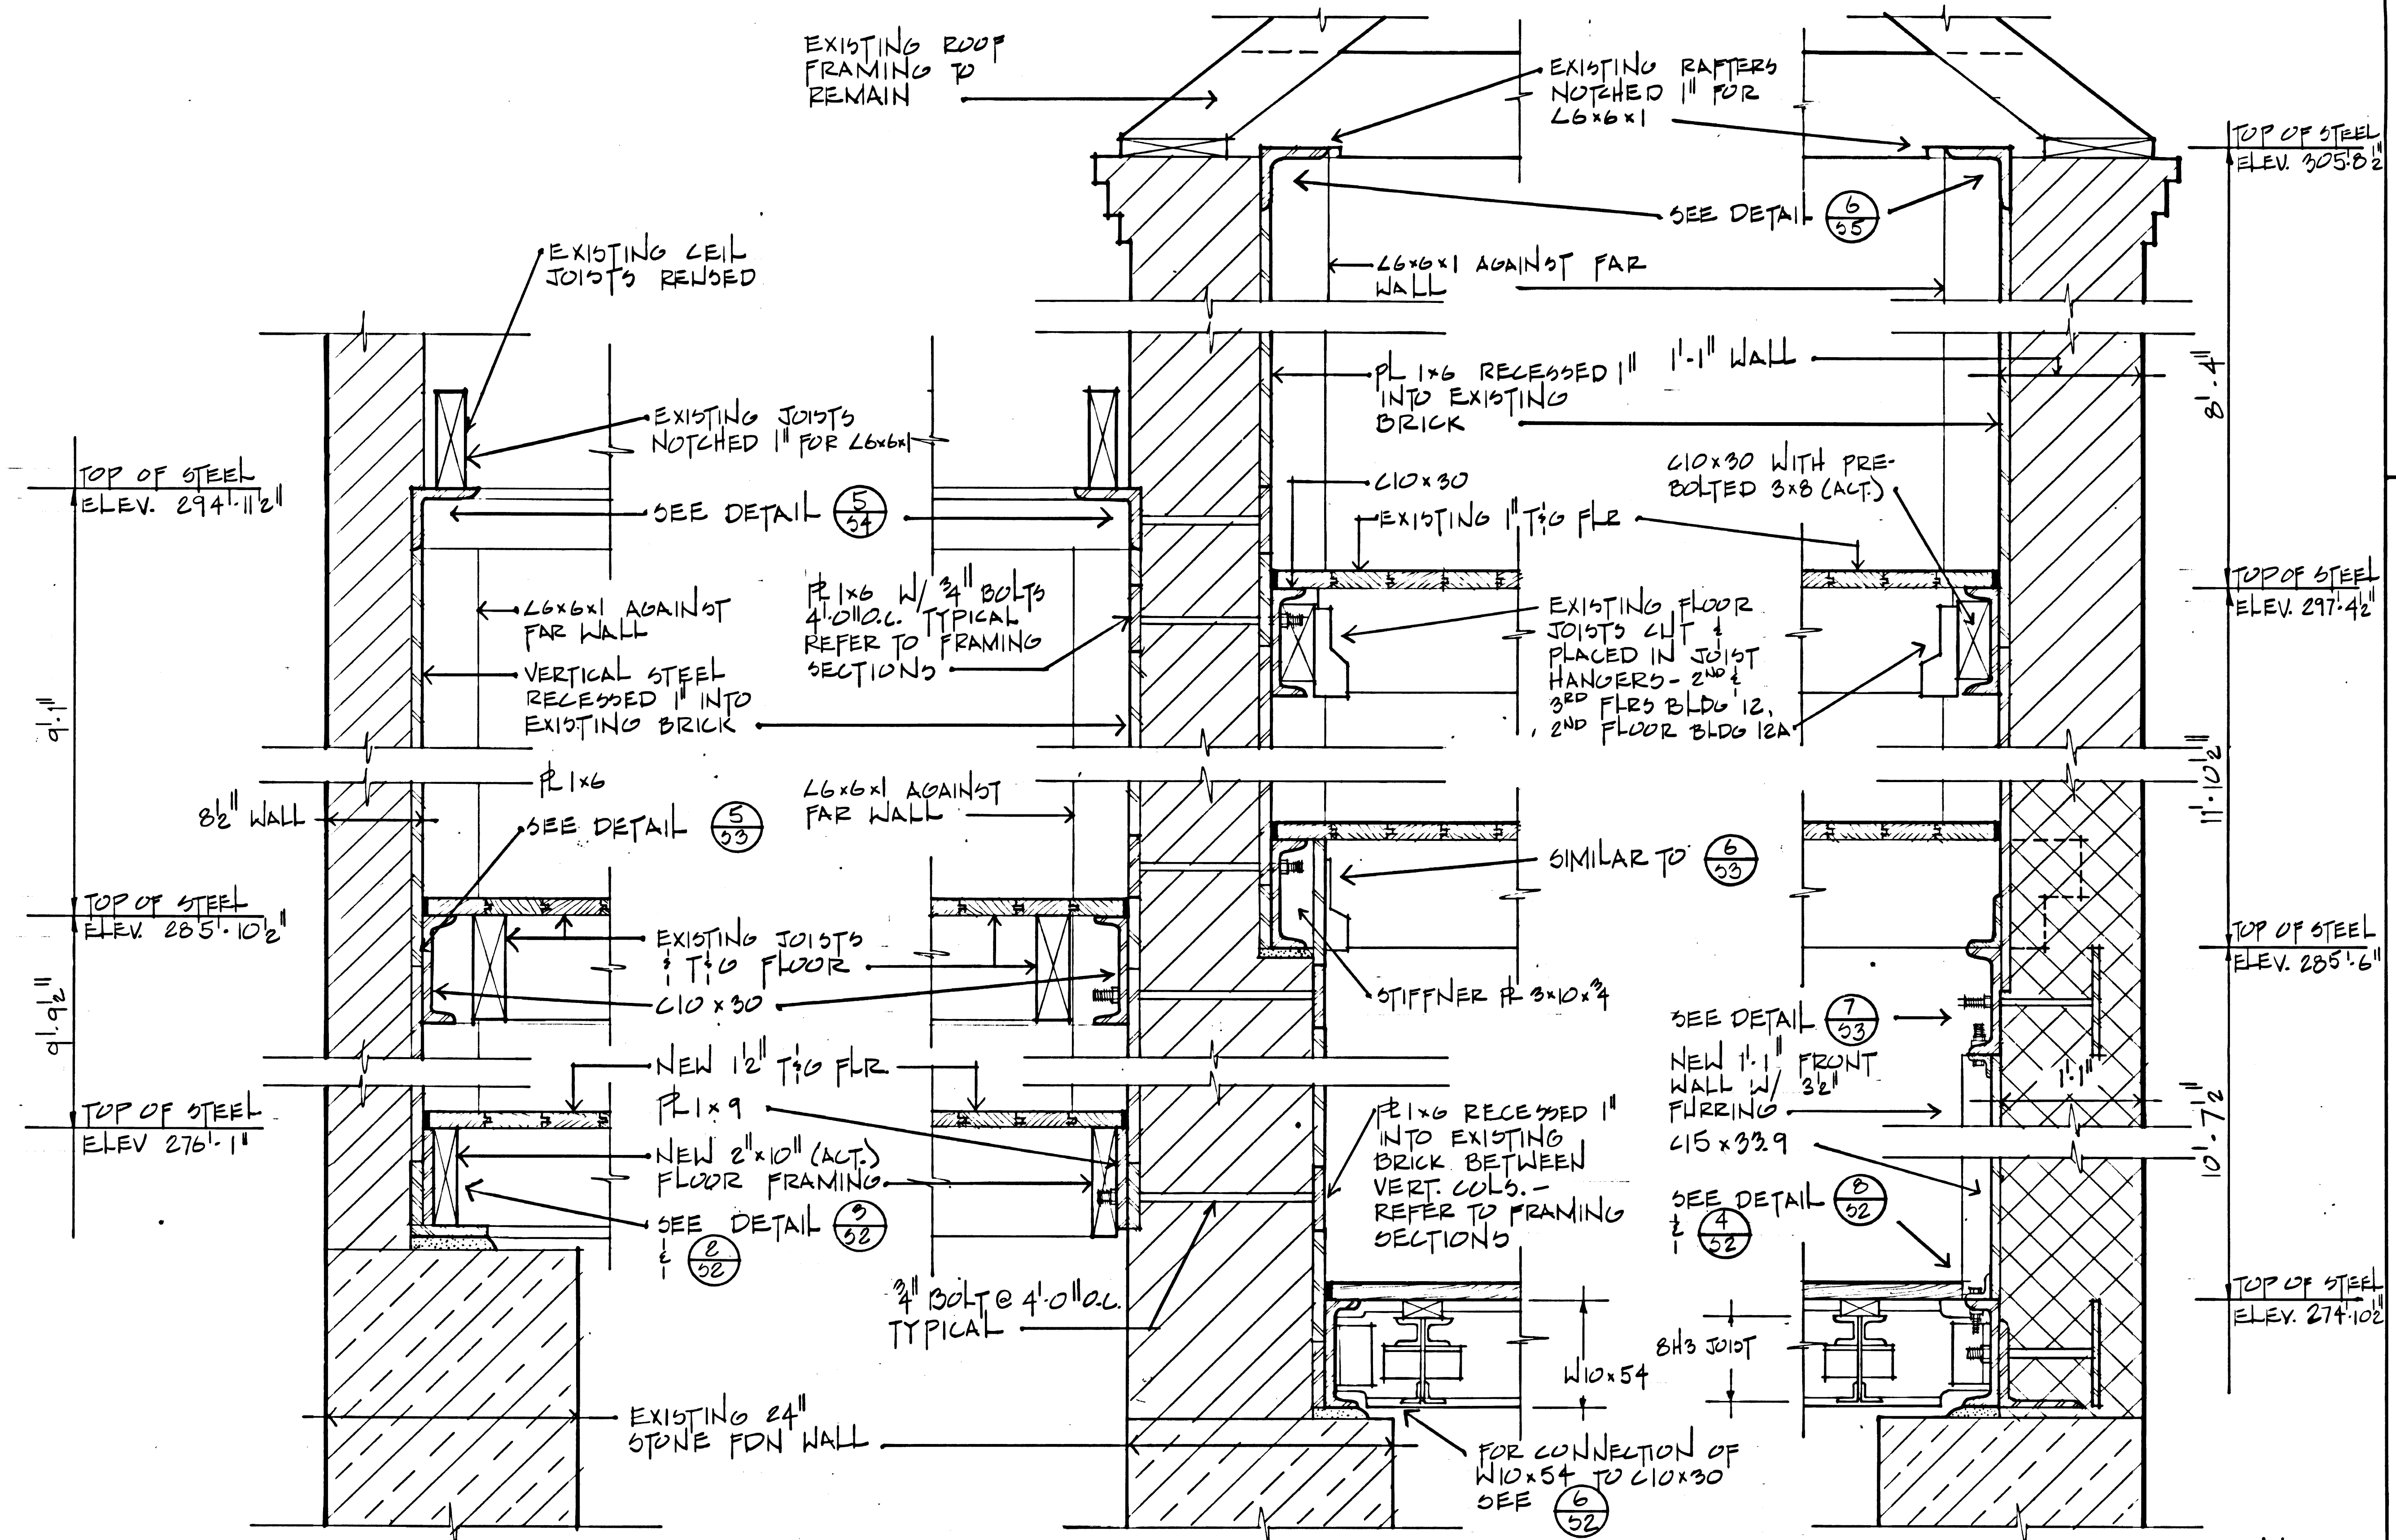

① SECTION - WEST WALL
 512 BLDG # 12A 12" = 1'-0"

② SECTION - PARTY WALL
 512 BLDG # 12 & 12A 12" = 1'-0"

③ SECTION - EAST WALL
 512 BLDG # 12 12" = 1'-0"

PHASE II-B
 RESTORATION


WALL SECTIONS — BLDG 12 & 12A
 SCALE : 1 1/2" = 1'-0"

S-12	DRAWING NO.
PREPARED RSJ/WLB	385
DESIGNED JACOBS	25,006A
DRAWN BARLOW	PKG. SHEET
CHECKED 6/78	110 57
DATE	OF 65

Do not start work until all dimensions and
 take measurements of the job site before
 the work is started. All work is to be done
 in accordance with the specifications.


NOTES:

1. FOR INTERIOR FINISHES REFER TO ARCHITECTURAL DETAILS
2. EPOXY CONNECTIONS ARE NOT SHOWN ON WALL SECTIONS SHEETS 512 & 513. FOR EPOXY CONNECTION DETAILS SEE BOLTING NOTES, FRAMING SECTIONS & DETAILS (4/55) (5/55)

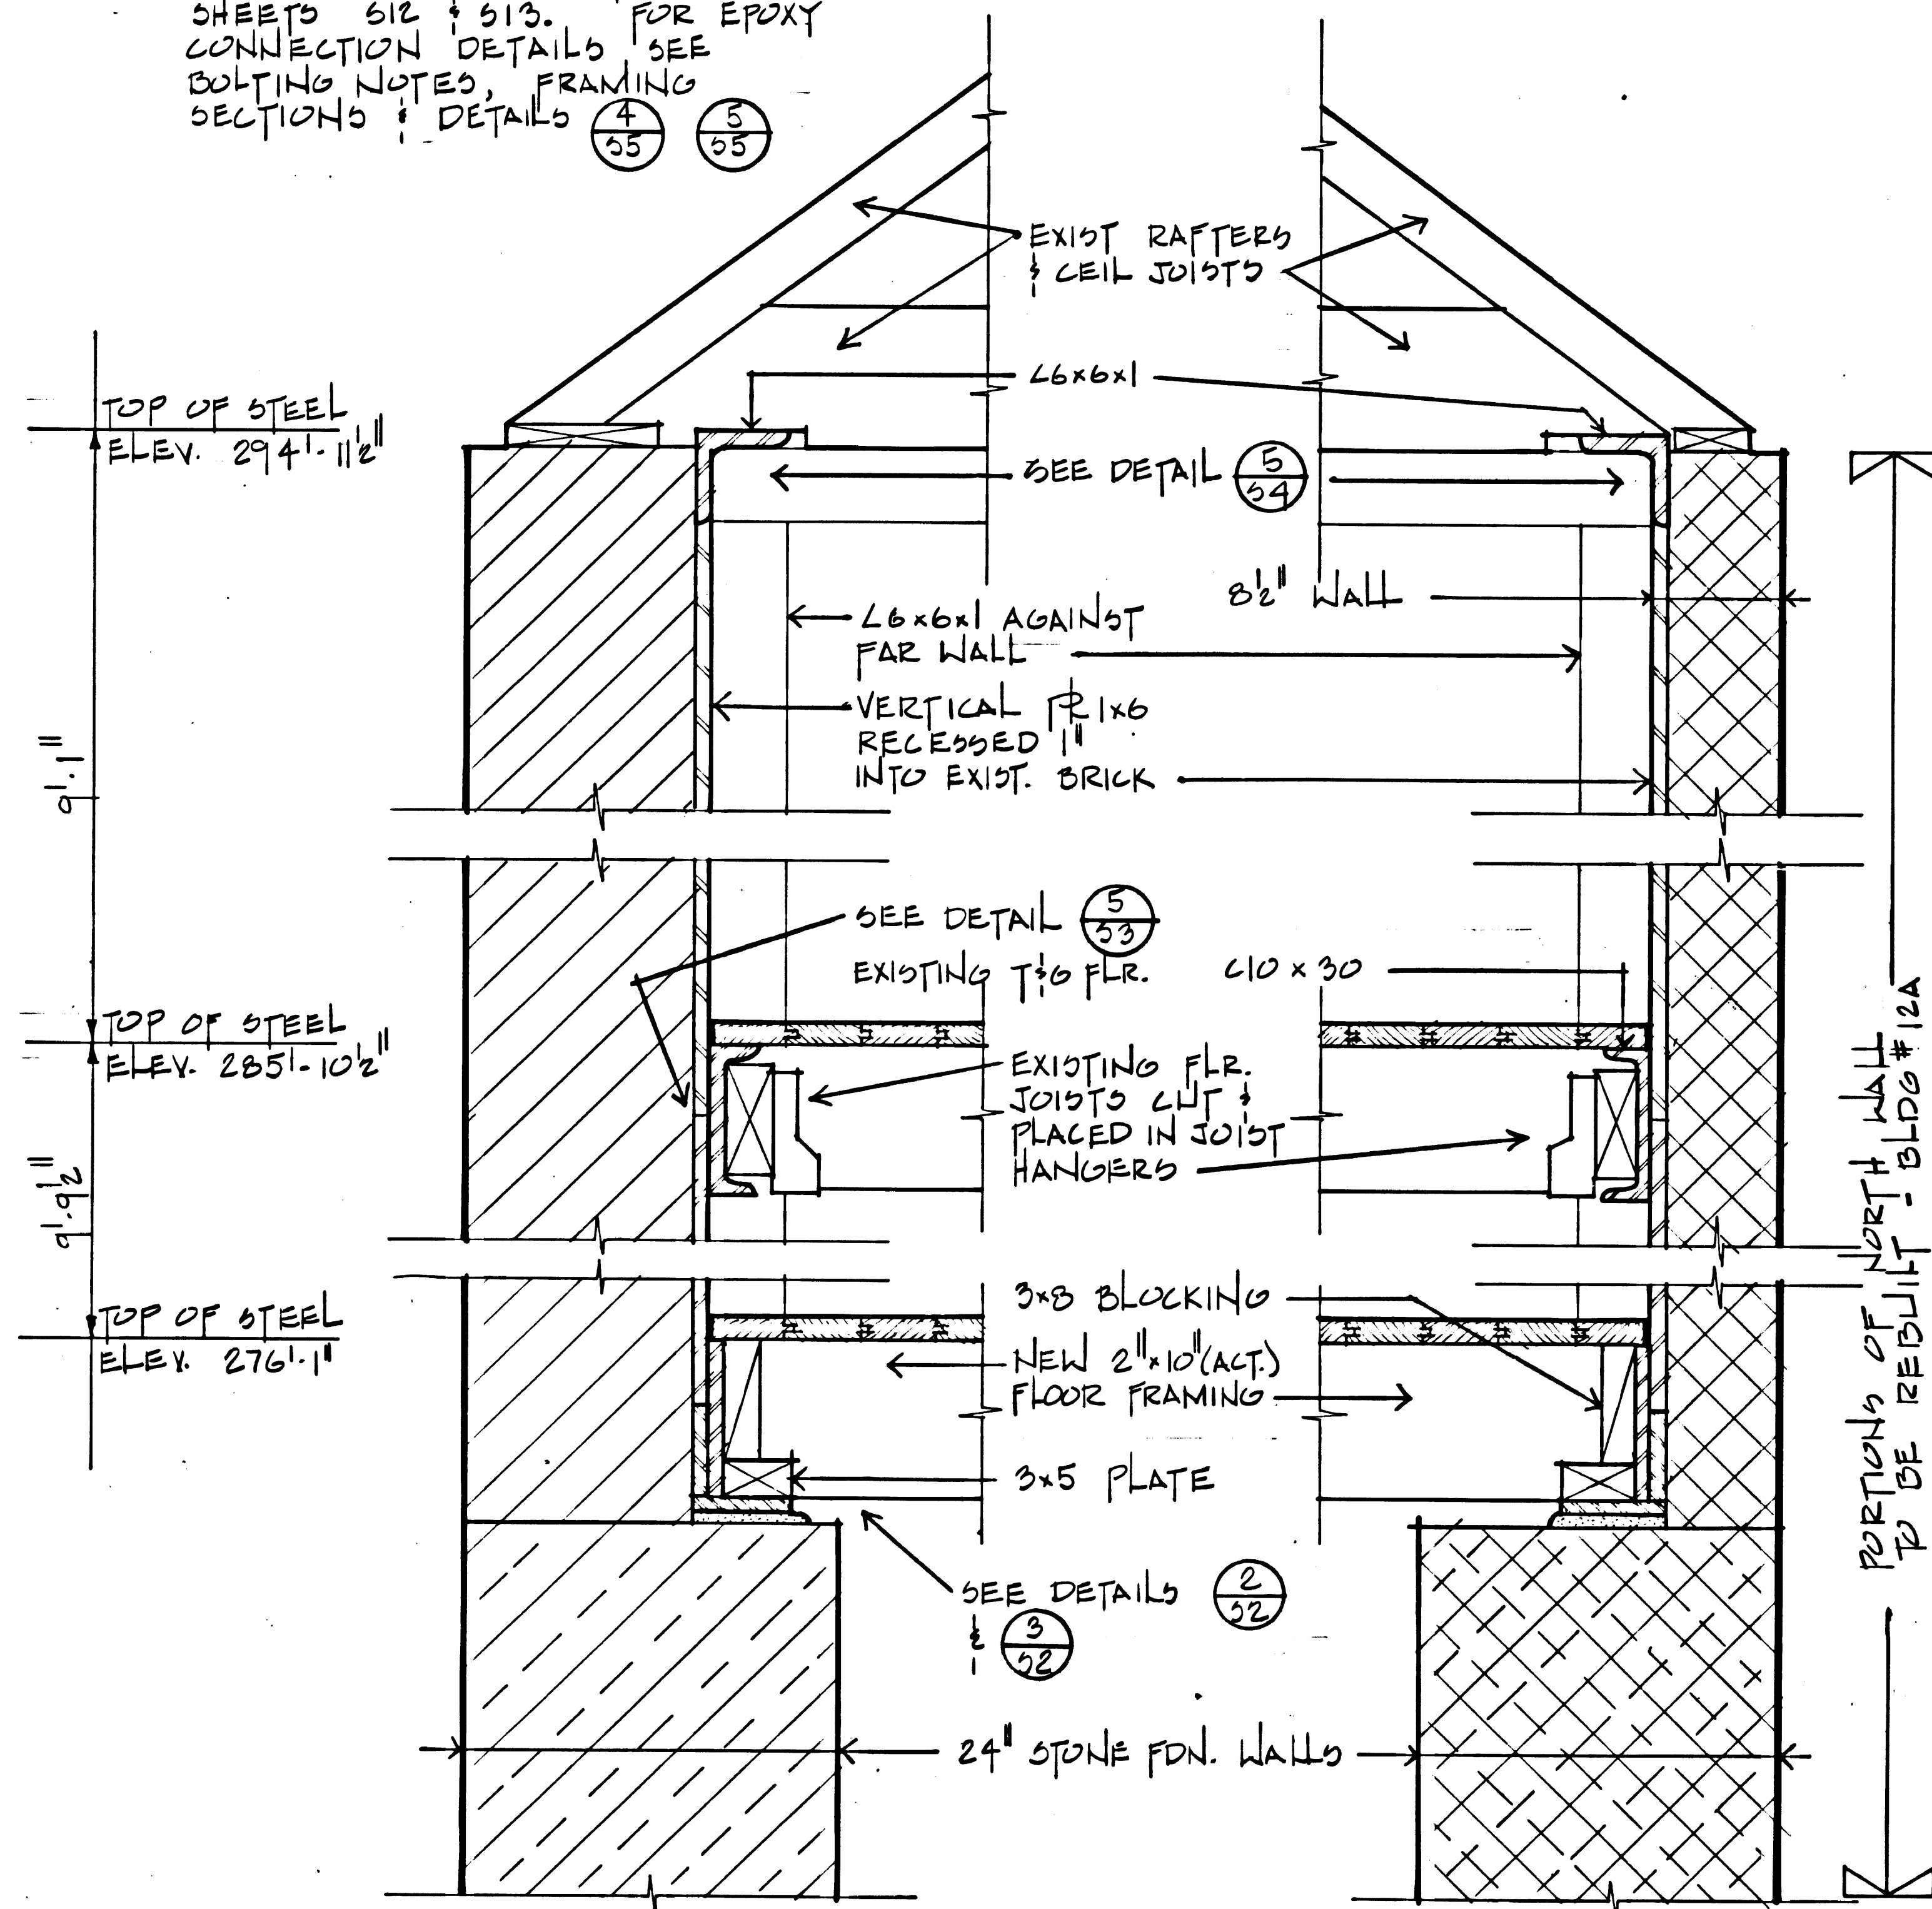

(1) SECTION - SOUTH WALL
BLDG # 12A
12' = 1'-0"

(2) SECTION - NORTH WALL
BLDG # 12A
12' = 1'-0"

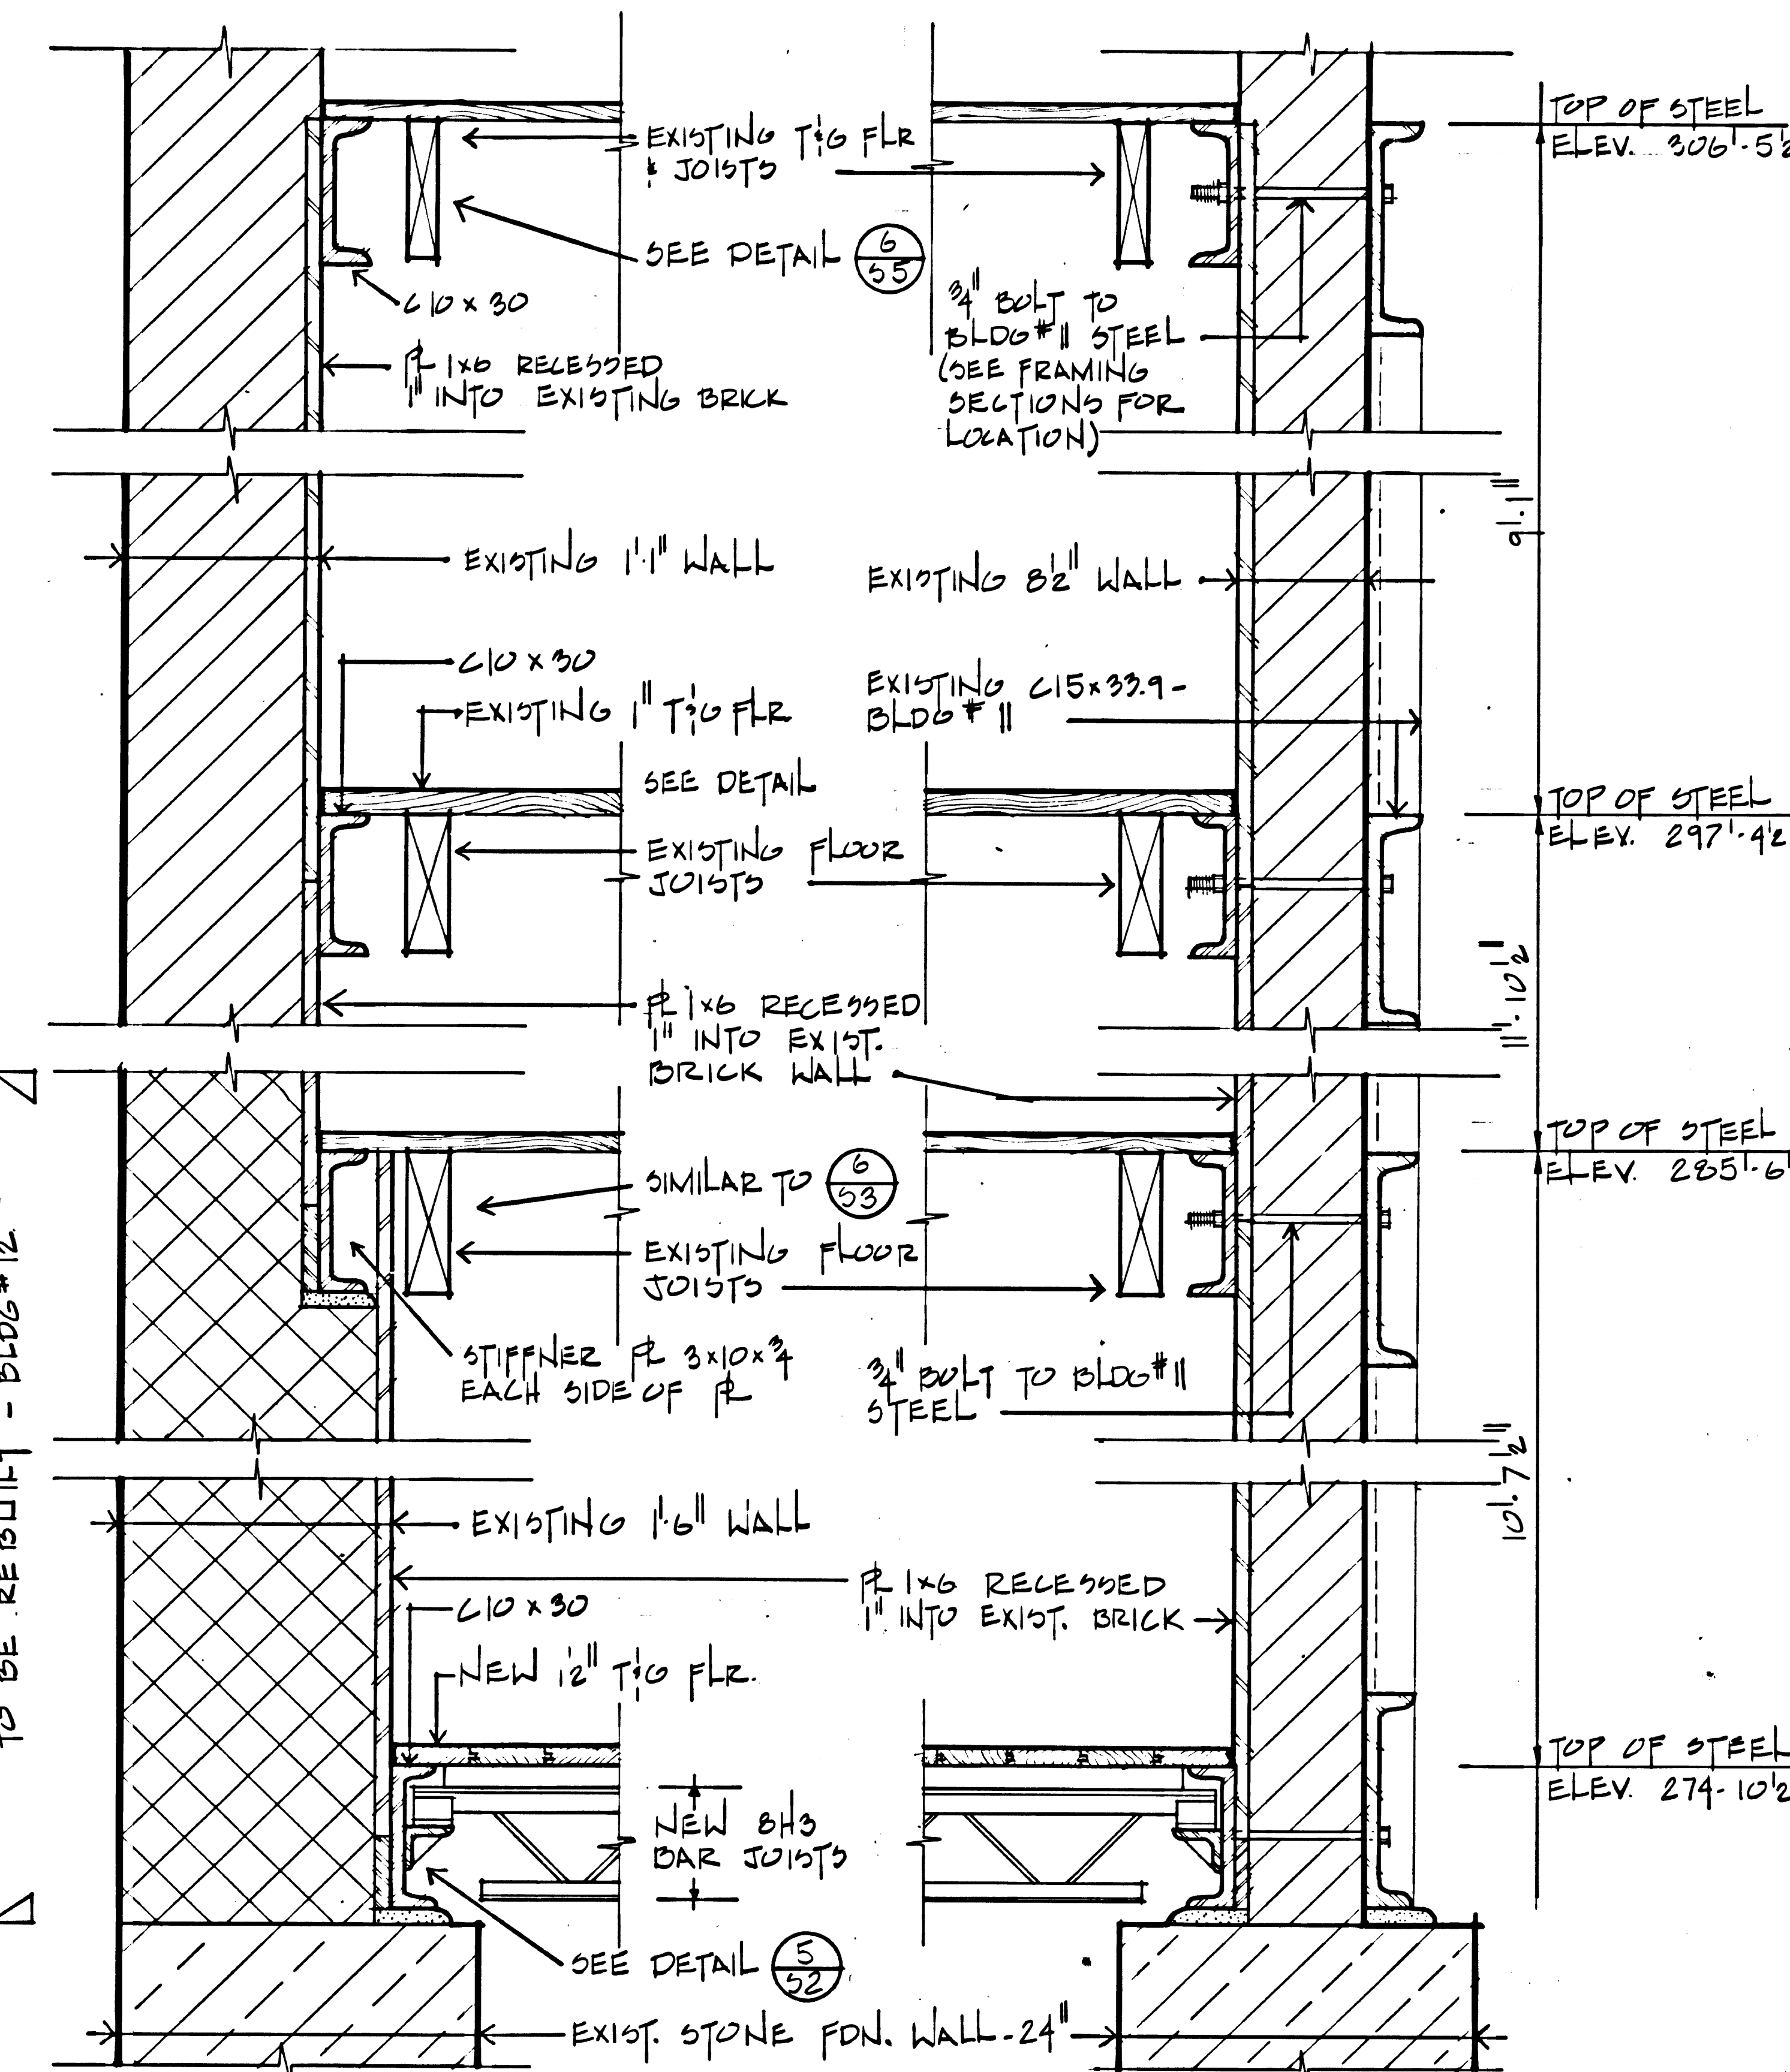

(3) SECTION - SOUTH WALL
BLDG # 12
12' = 1'-0"

(4) SECTION - PARTY WALL
BLDG # 11 & 12
12' = 1'-0"

PHASE II-B
RESTORATION

WALL SECTIONS - BLDG 12 & 12A
SCALE : 0' 6" 1' 1 1/2" = 1' - 0"

S-13	PREPARED RSJ/WLB DESIGNED JACOBS DRAWN BARLOW CHECKED 6/78 DATE	DRAWING NO. 385 25,006A PKG SHEET 58 OF 65
------	---	--



Contractor shall verify all dimensions and take measurements at the job site before commencing work. Advice of any error or discrepancy.

HEATING SCHEDULE						
DESIGNATION	TYPE	HEATING		LENGTH (FT.)	VOLTAGE	REMARKS
		CAPACITY BTUH	WATTS REQUIRED			
EH-1	RADIANT CEILING CABLE	9826	2879	2850	1040	208V, 1Ø 60 HZ SMITH-GATES CORP TYPE RCC-8 RM. 1
EH-2		6801	1993	1950	710	RM. 2
EH-3		10131	2968	3100	1135	RM. 102
EH-4 & EH-5		20241	5931	3100 & 2850	1135 & 1140	RM. 104
EH-6		6276	1839	1950	710	RM. 202
EH-7		2931	859	875	319	RM. 203
EH-8		15117	4429	4300	1576	RM. 204
EH-9		8204	2404	2400	873	RM. 302
EH-10		4601	1348	1400	510	RM. 303
EH-11		3619	1060	1050	382	RM. 304
EH-12		9343	2737	2850	1040	RM. 305
EH-13		3349	981	1050	382	RM. 402
EH-14		2723	798	875	319	RM. 403
EH-15		4661	1366	1400	510	RM. 404
EH-16		5244	1536	1550	568	RM. 405
EH-1A		4230	1239	1200	442	RM. 101
EH-2A		6561	1922	1950	710	RM. 102
EH-3A		7411	2171	2150	788	RM. 103
EH-4A		3649	1069	1050	382	RM. 201
EH-5A		6895	2020	1950	710	RM. 202
EH-6A	RADIANT CEILING CABLE	6731	1972	1950	710	208V, 1Ø 60 HZ SMITH-GATES CORP TYPE RCC-8 RM. 203
EH-8	BASE-BOARD			750		EMERSON-CHROMALOX REBEL BASEBOARD HEATER, CATALOG No. BB-H-31-2, 36" LONG WITH THERMOSTAT KIT BBT-K5, SPST RM. 103

NOTES:

- 1.) ALL RADIANT CEILING HEATING CABLES SHALL BE INSTALLED ACCORDING TO INSTRUCTIONS SUPPLIED BY THE MANUFACTURER OF THE CABLE.
- 2.) NON-HEATING LEADS OF EACH RADIANT CEILING HEATING CABLE SHALL EXTEND TO A JUNCTION BOX LOCATED IN THE CAVITY FOR THE NEAREST DUPLEX RECEPTACLE ON THE FLOOR ABOVE. SPLICES TO THE BRANCH CIRCUIT CONDUCTORS SHALL BE MADE AT THIS POINT. LEADS FOR HEATING CABLES IN THE CEILINGS ON THE FOURTH FLOOR OF BUILDING #12 AND SECOND FLOOR OF BUILDING #12A SHALL EXTEND TO JUNCTION BOXES ACCESSIBLE IN THE ATTIC.
- 3.) MINIMUM SIZE CIRCUIT WIRING TO BE NO. 12 AWG, CONTROL WIRING NO. 14 AWG.

LIGHTING FIXTURE SCHEDULE						
FIXTURE IDENT.	MANUFACTURER	MFR. NUMBER	SUSPENSION METHOD & HT.	LAMP TYPE	LAMP No. & WATTS	REMARKS & REQUIREMENTS
A	EMERSON-CHROMALOX	V219-1	CEILING MOUNTED	INCAD.	1(100W)	(1) FAN/LIGHT COMBINATION
B	LEVITON	9875	CEILING MOUNTED	INCAD.	1(100W)	(1) PORCELAIN

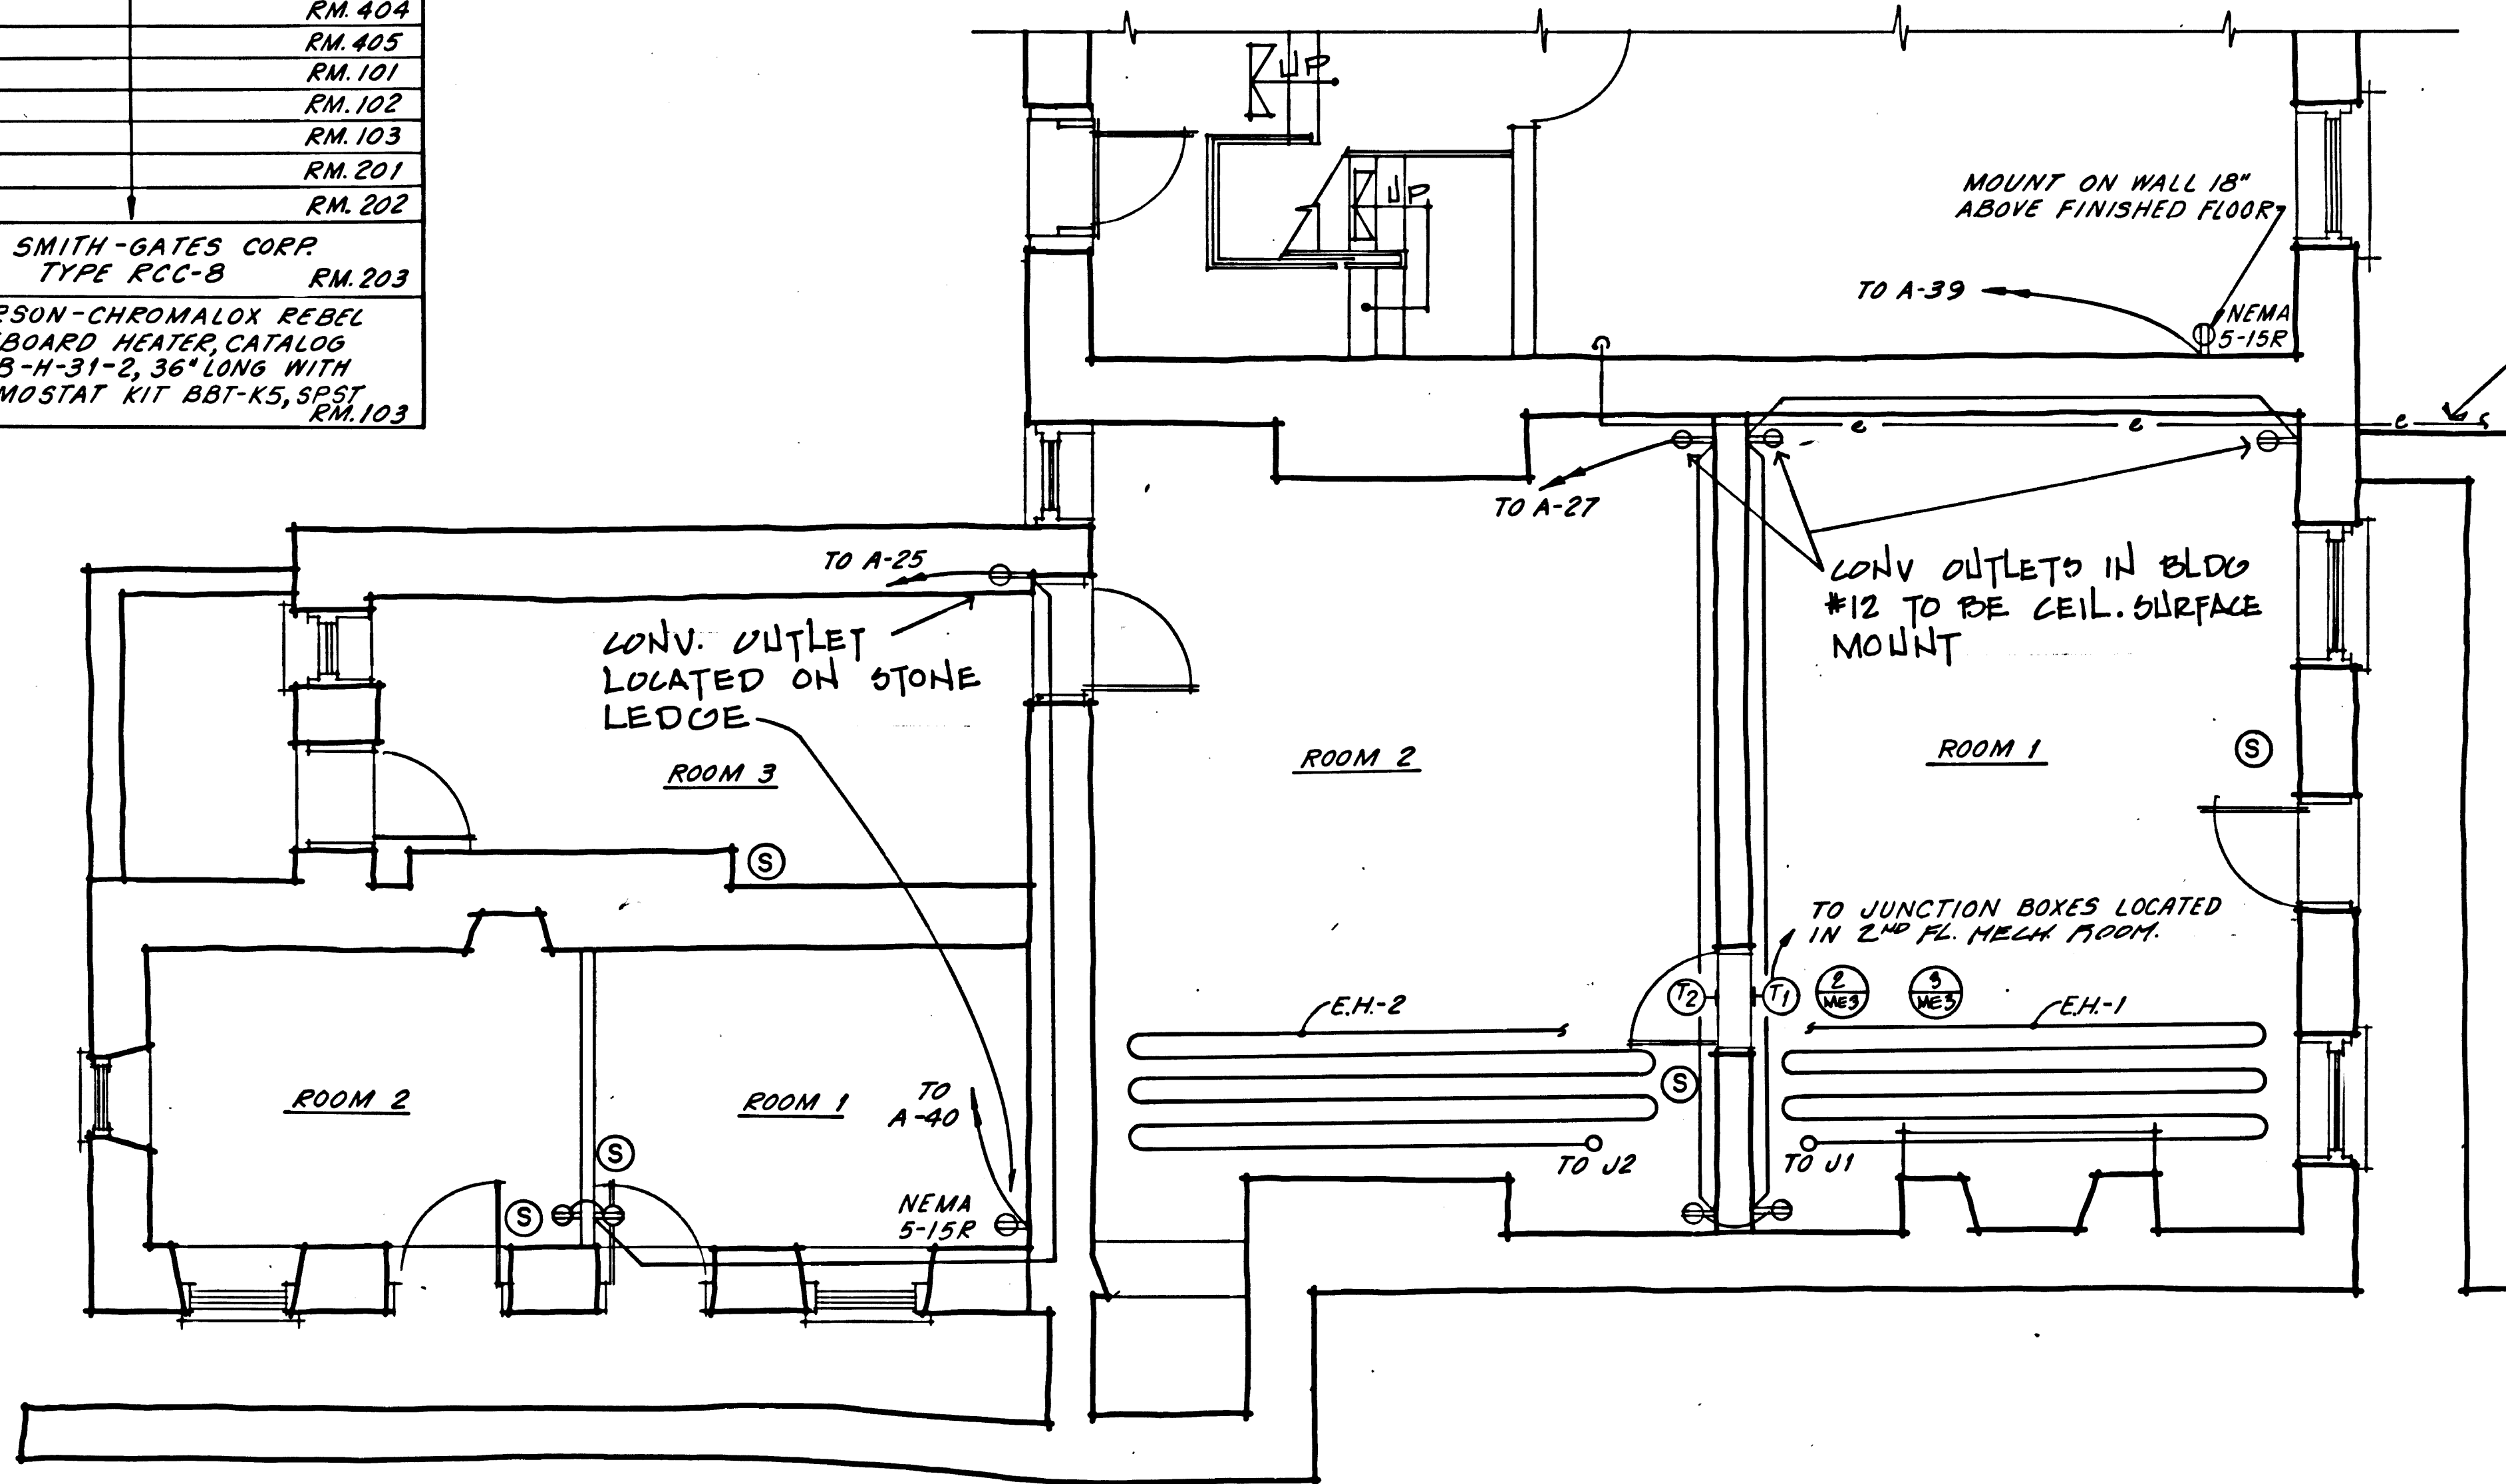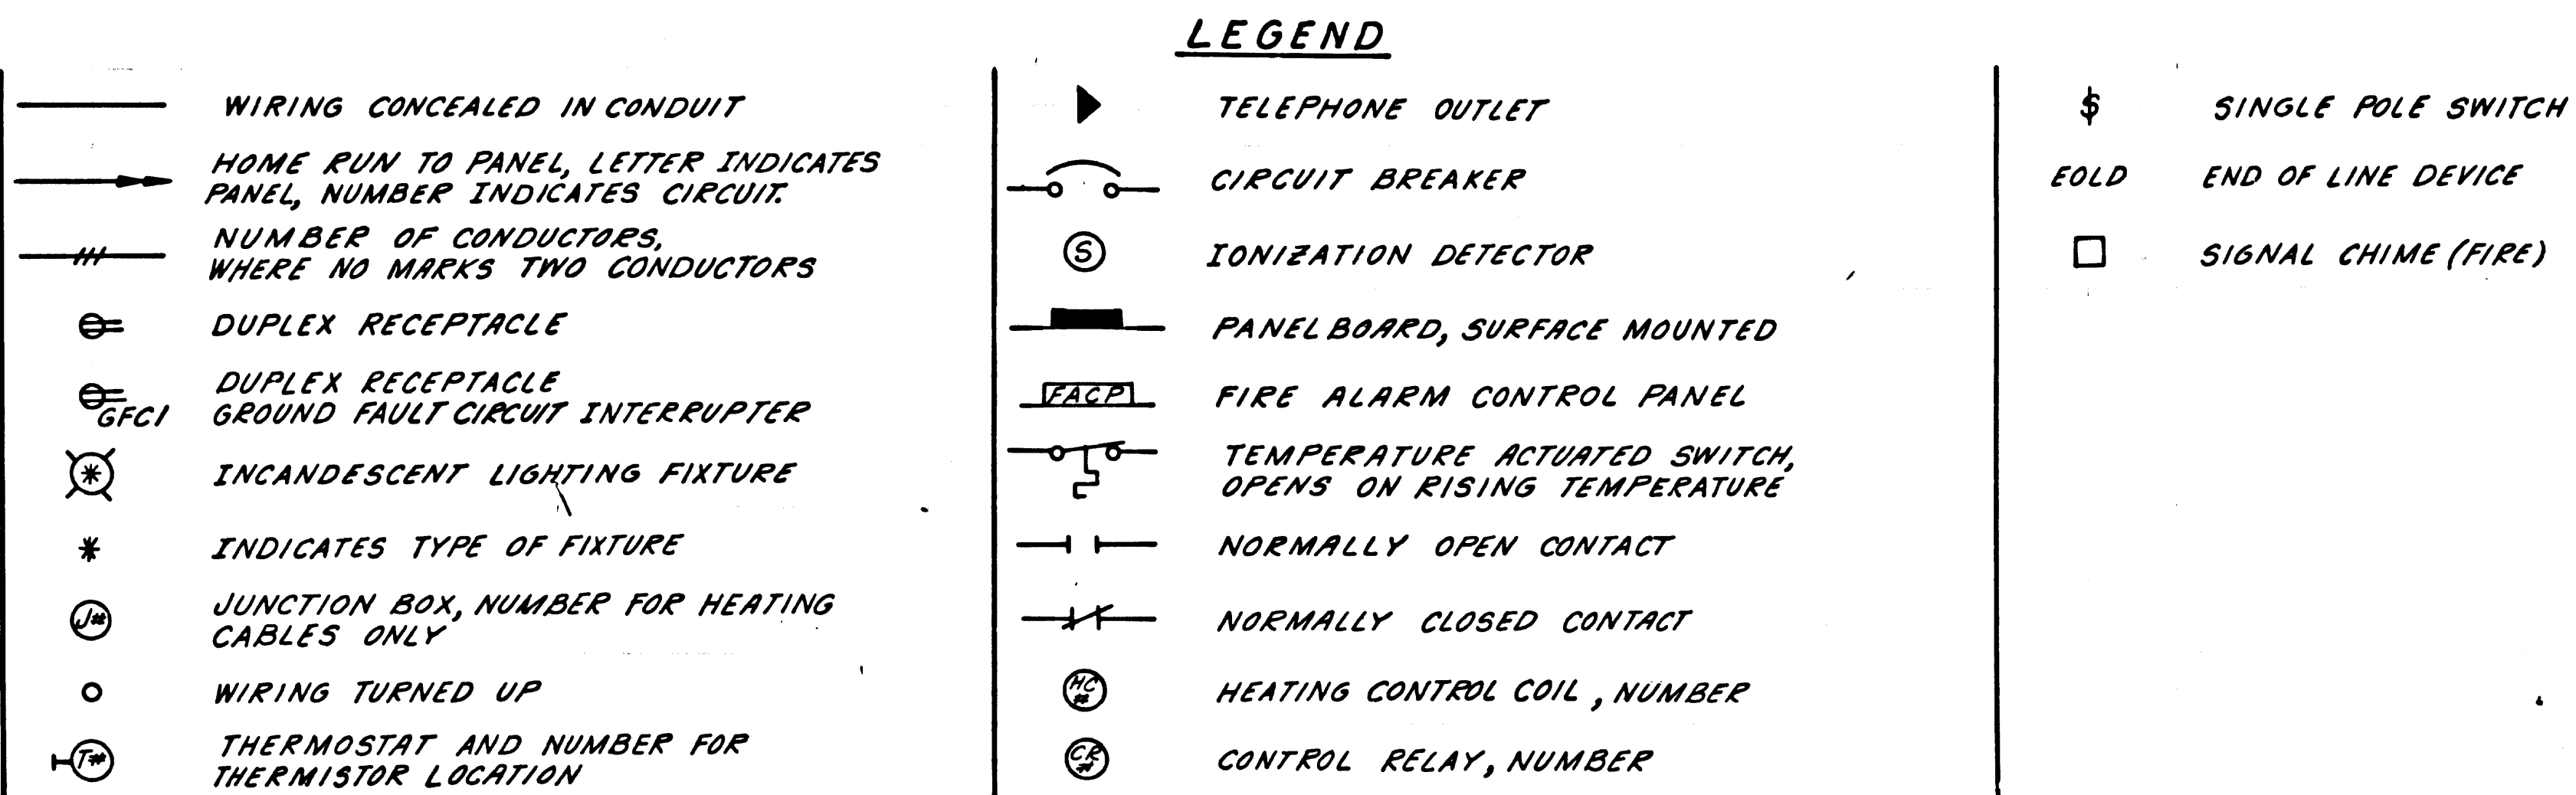

BASEMENT FLOOR PLAN
SCALE: 1/4" = 1' - 0"

PHASE II-B
RESTORATION

MECHANICAL / ELECTRICAL — BLDG 12 & 12A
SCALE: 1/4" = 1' - 0"


ME-I	
PREPARED BY R. JACOBSON	DRAWING NO. 385
DESIGNED BY JACOBS	25,006A
DRAWN BY BARLOW	SHEET 59
CHECKED BY 6/78	OF 65
DATE	


Contractor shall verify all dimensions and take own measurements at the job site before commencing work. Adjust if any error or discrepancy.

Contractor shall verify all dimensions and take own measurements at the job site before commencing work. Advise of any error or discrepancy.


MECHANICAL / ELECTRICAL -- BLDG 12 & 12A

SCALE : 1" = 10' 1/4" = 1' • 0"

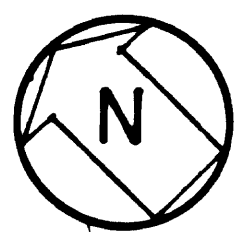


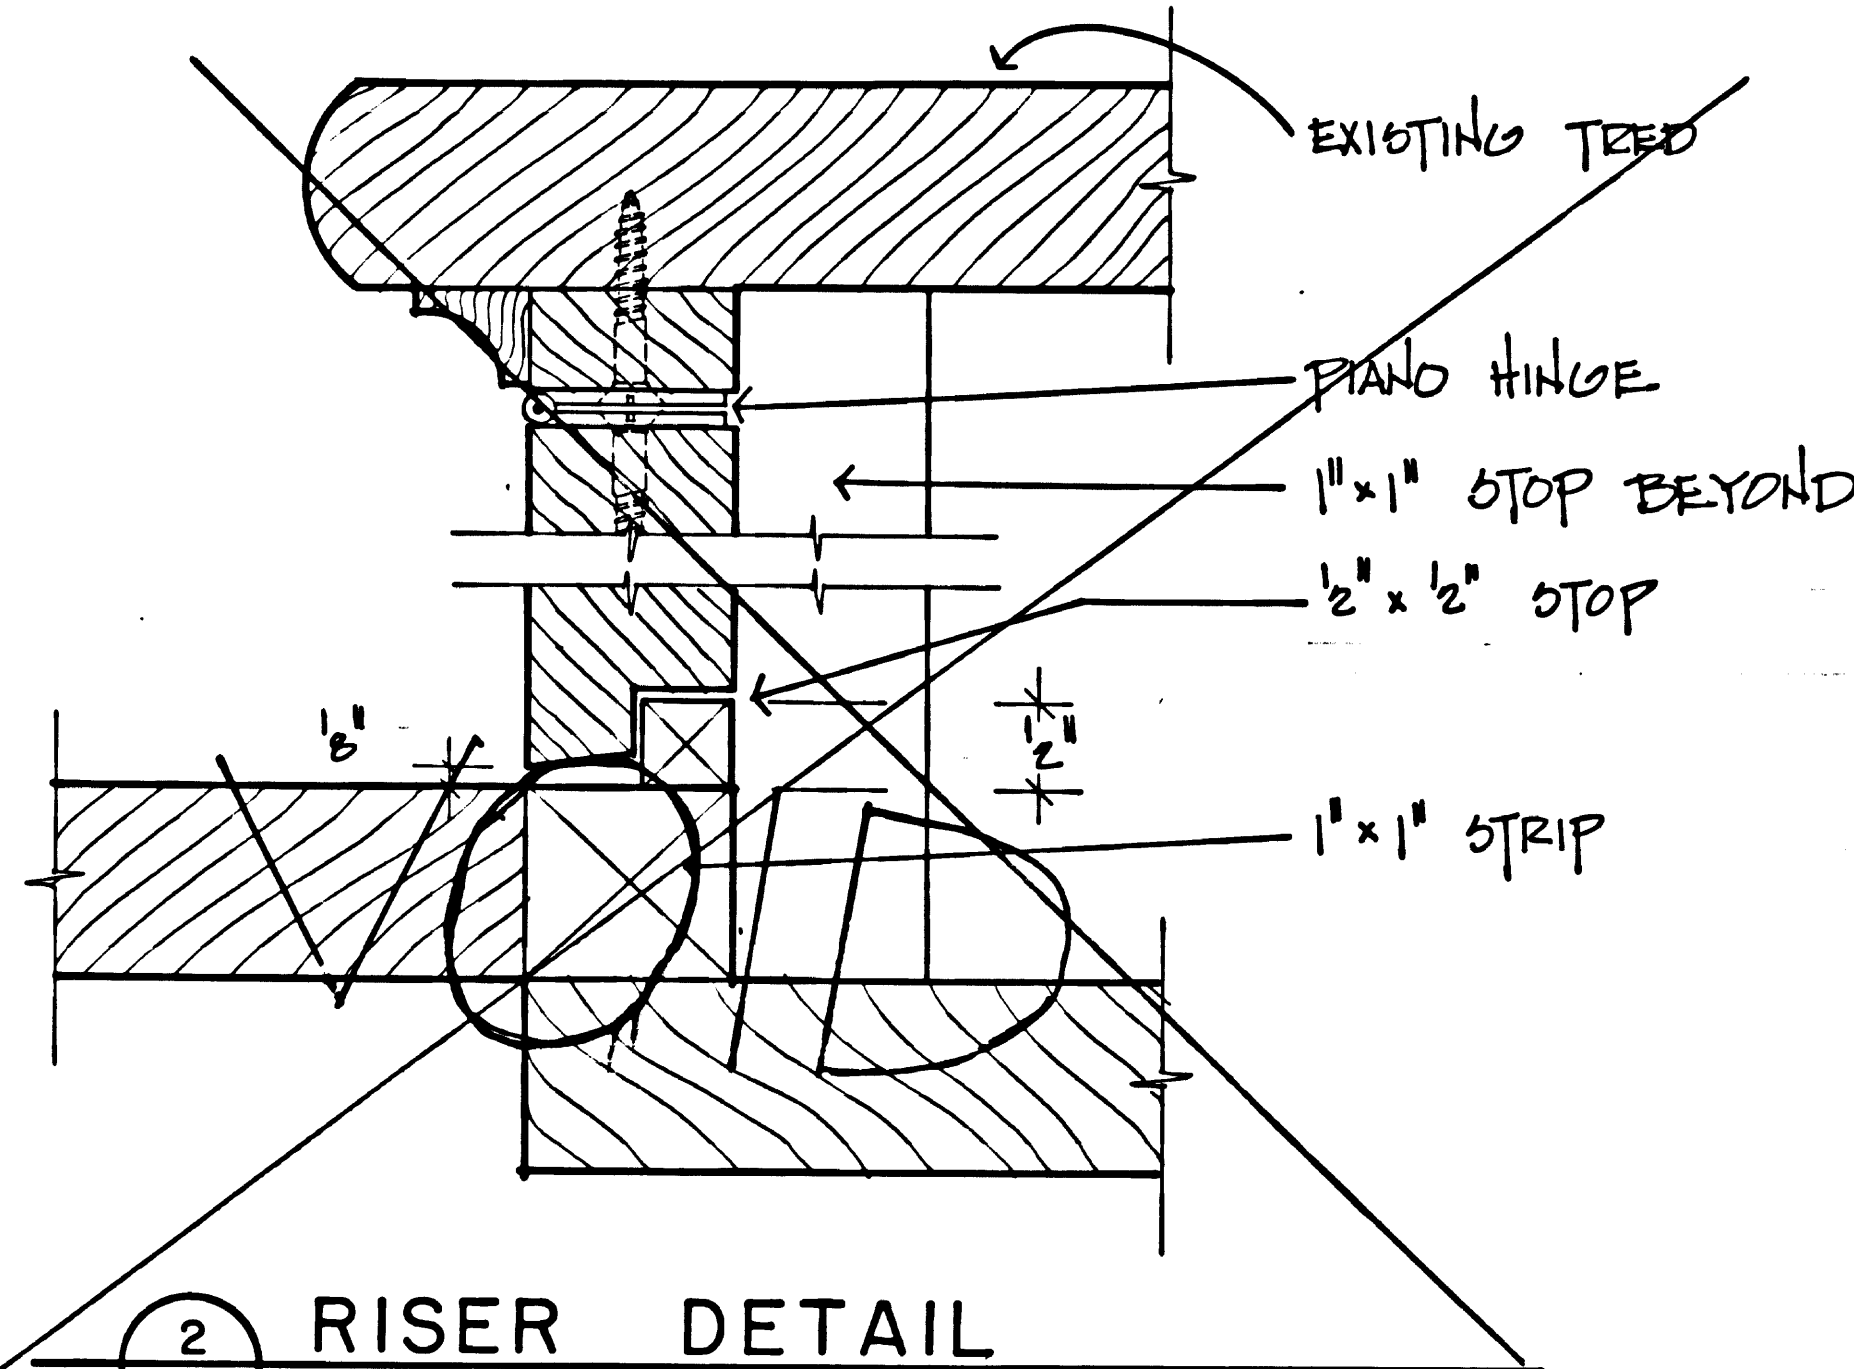


2 RISER DETAIL
ME 3
SCALE : FULL SIZE

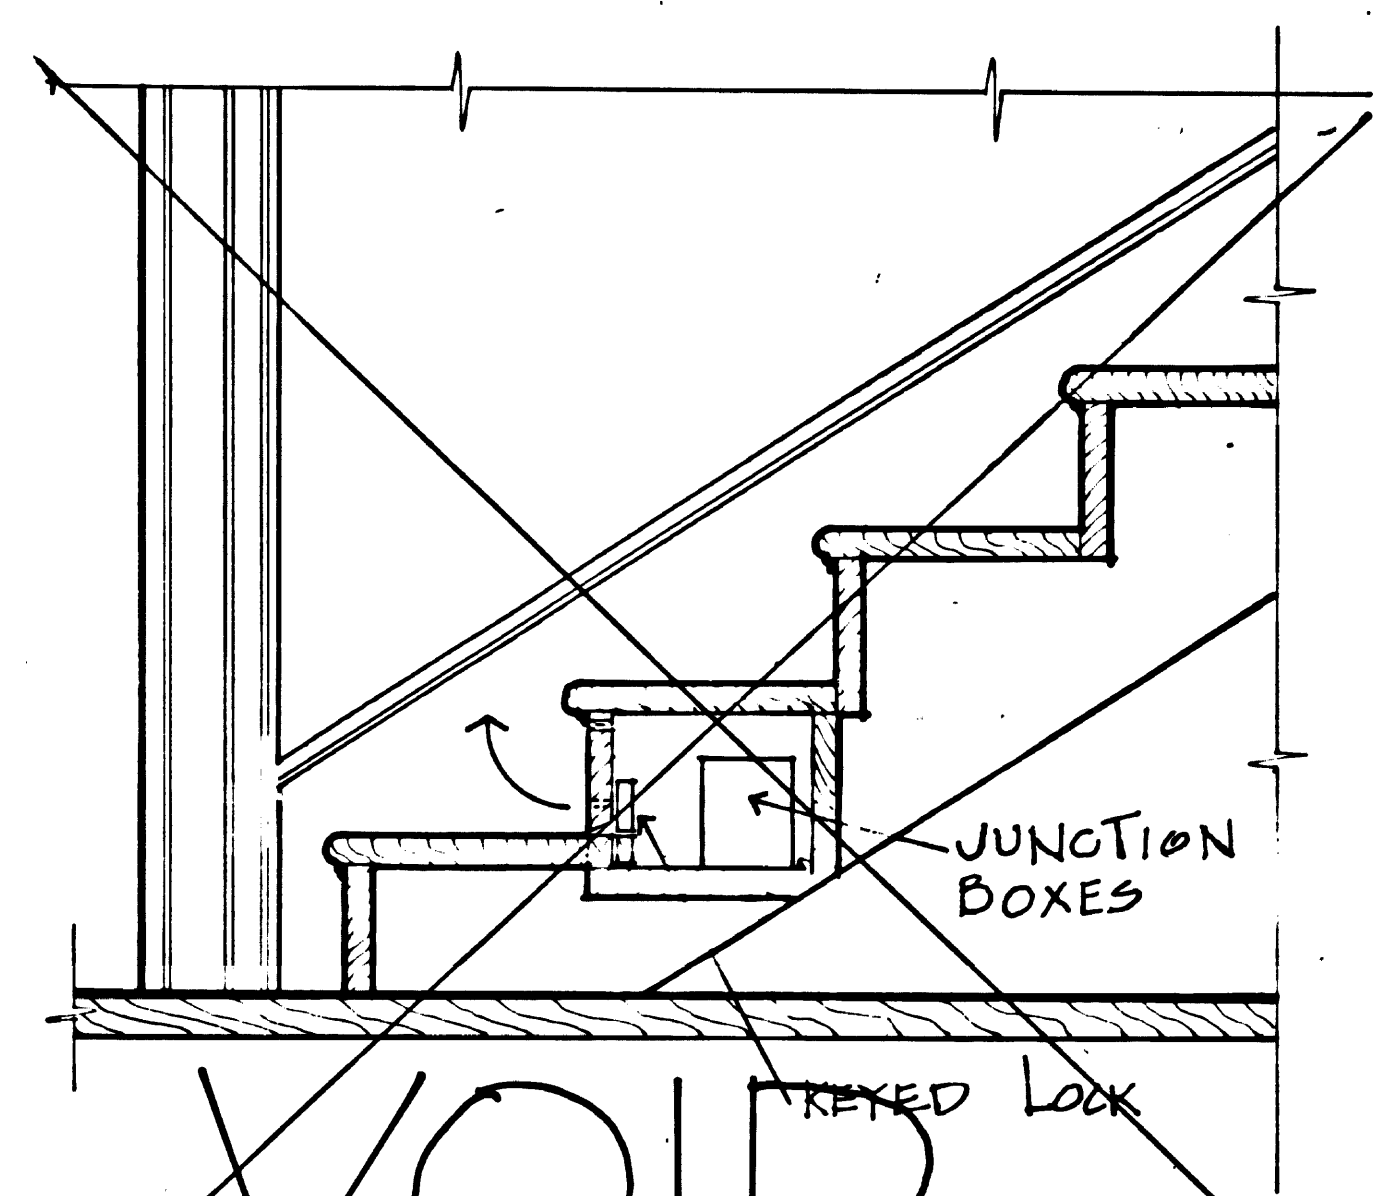


3 THERMOSTAT CONTROLS
ME 3
UNDER EXISTING STAIRS
SCALE : 1 1/2" = 1' - 0"

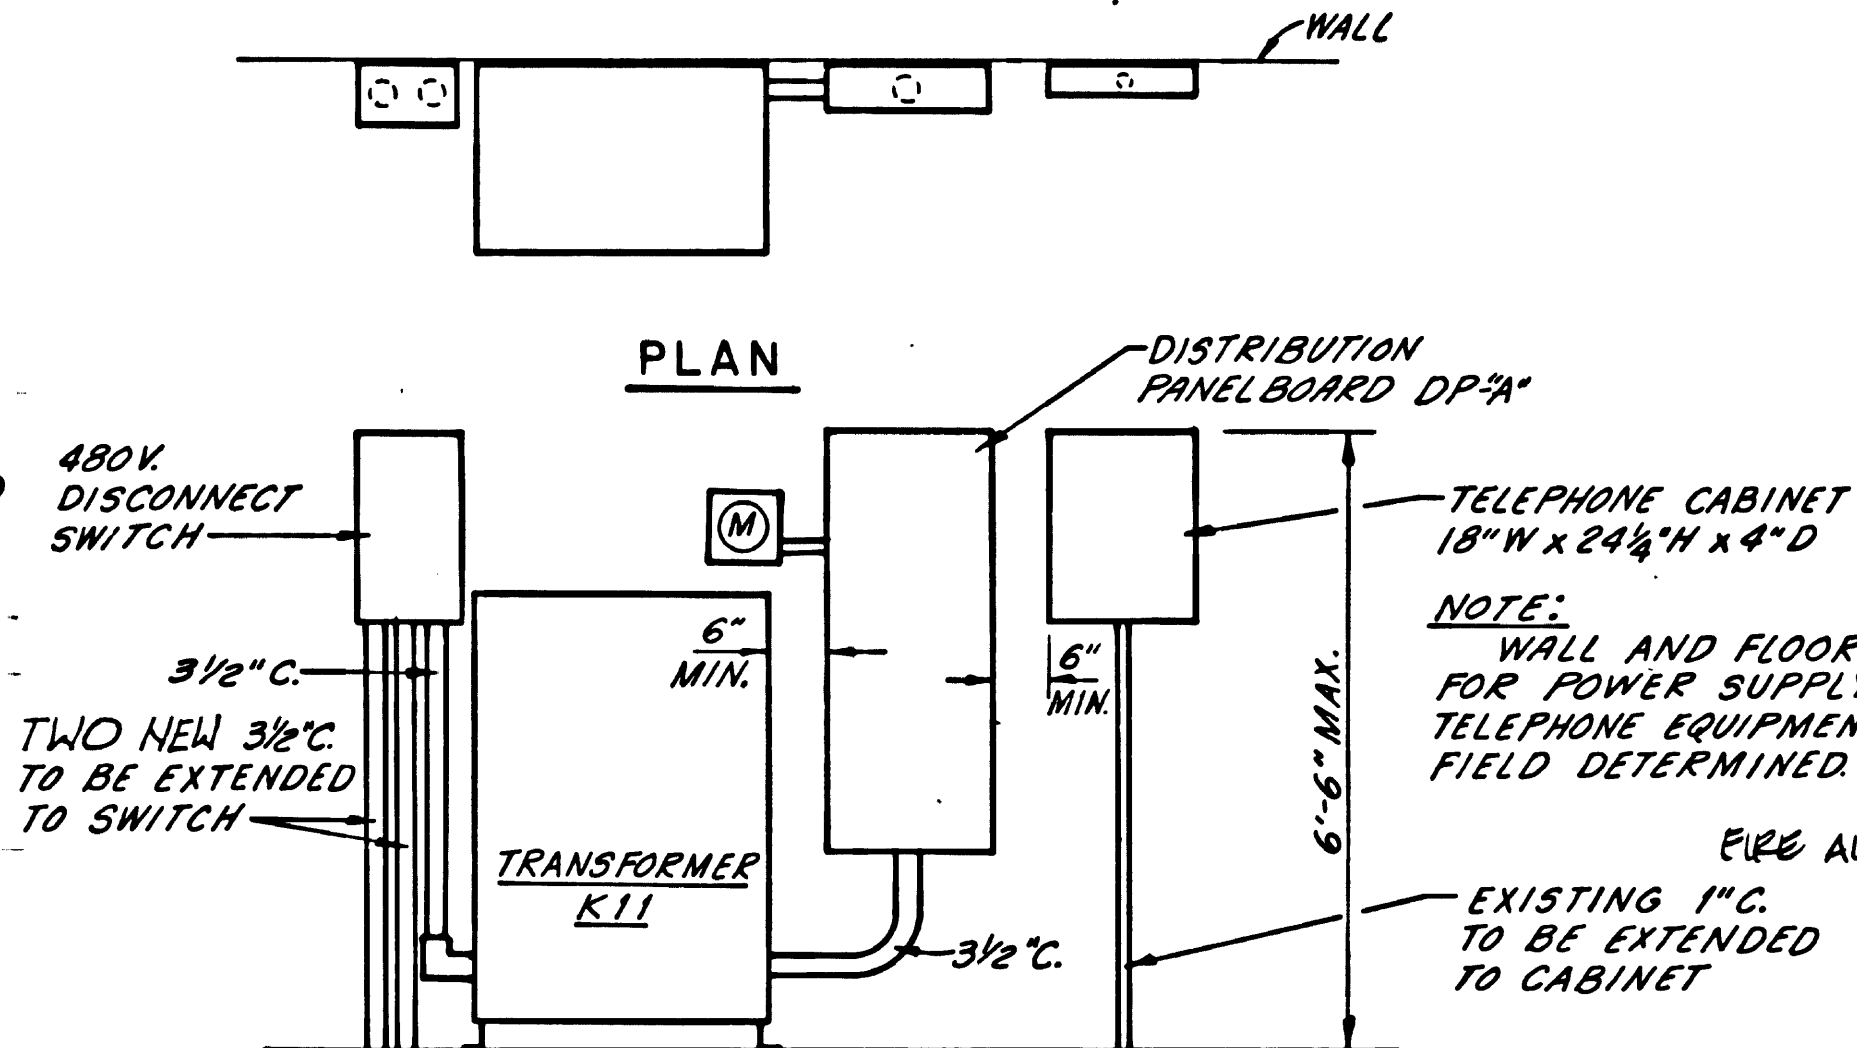

4 TYPICAL ELEVATION DETAIL
ME 3
POWER SUPPLY & TELEPHONE
SCALE: 1/2" = 1' - 0"

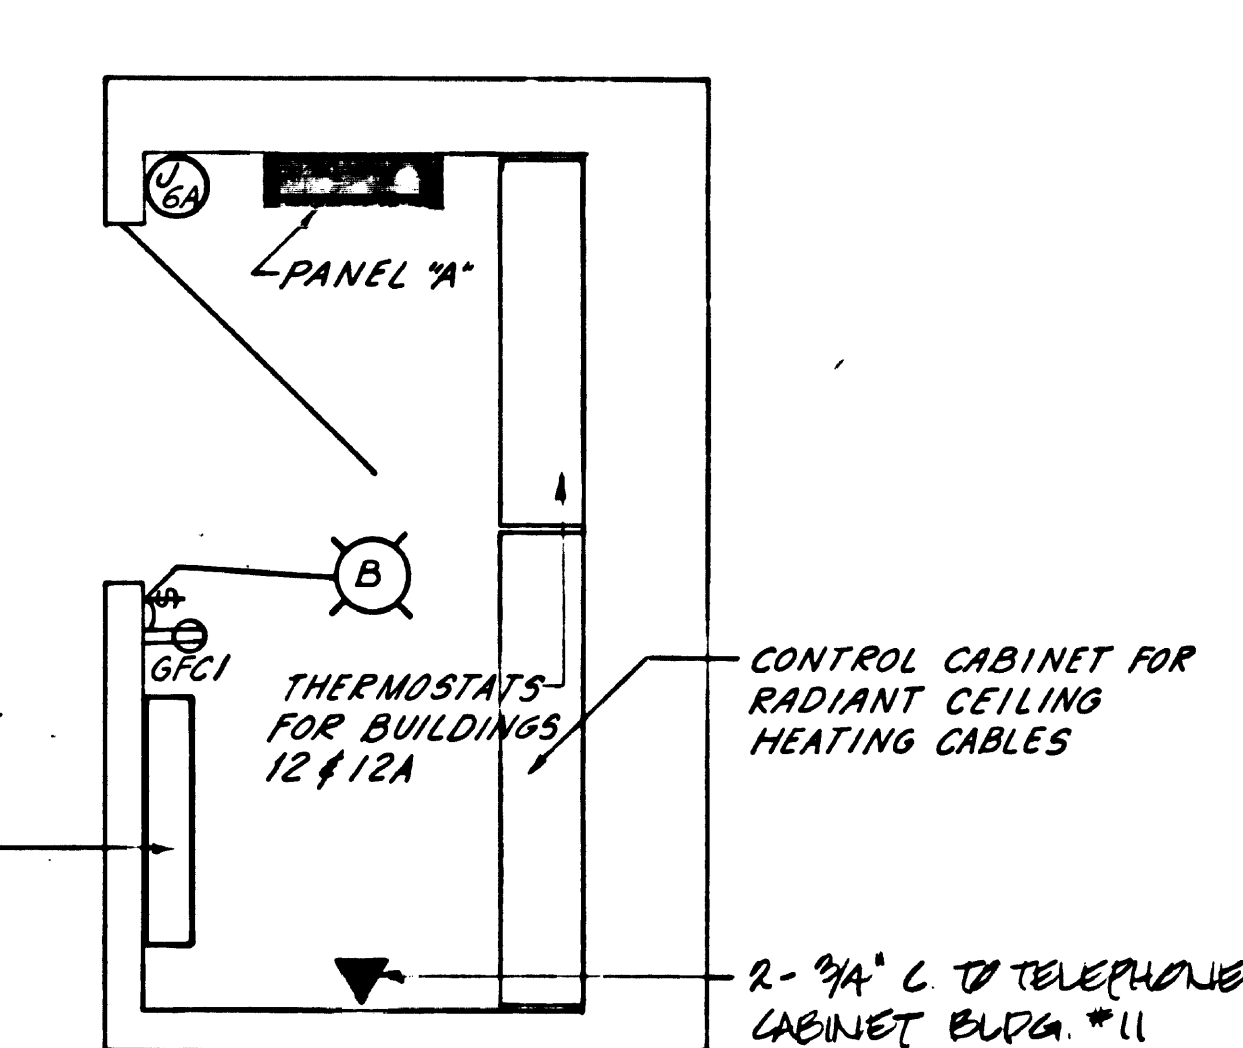

5 PLAN
ME 3
MECH. & ELECT. RM.
SCALE: 3/4" = 1' - 0"

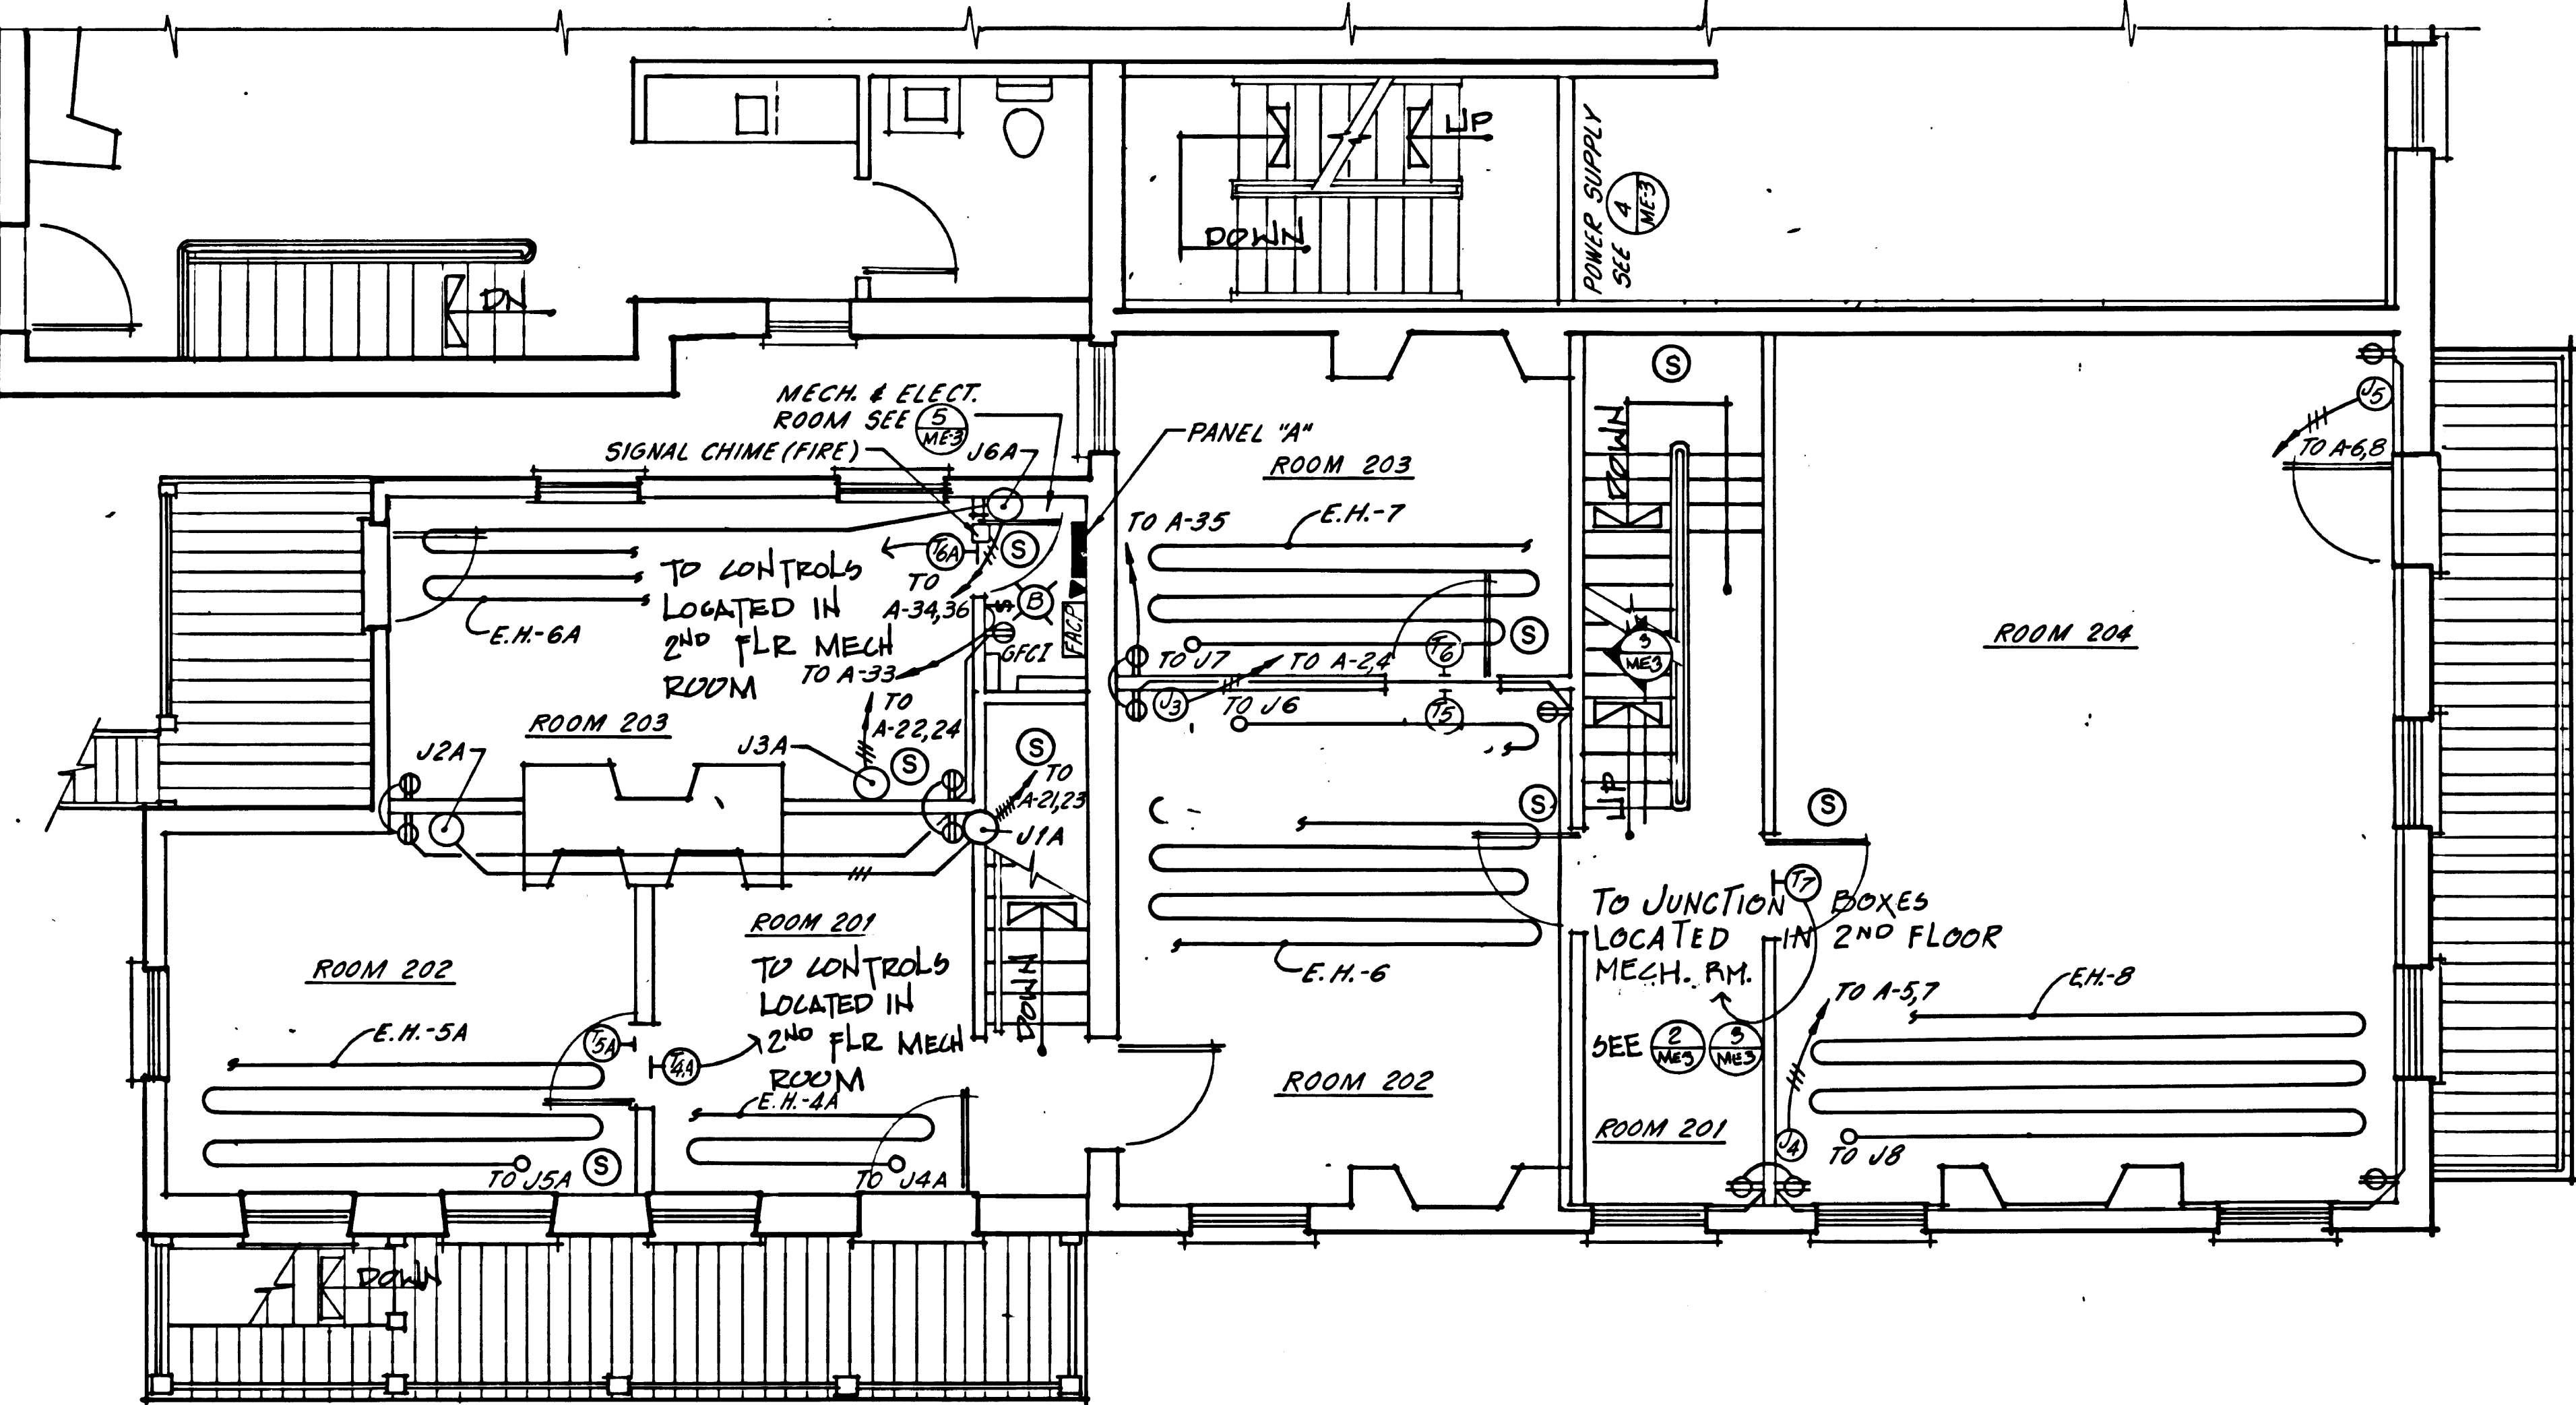


1 SECOND FLOOR PLAN
ME 3
SCALE : 1/4" = 1' - 0"

PHASE - II B
RESTORATION


MECHANICAL / ELECTRICAL - BLDG 12 & 12A
SCALE : 1/4" = 1' - 0"

SCALE : 1/4" = 1' - 0"

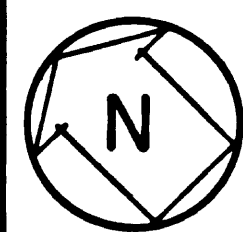


ME-3		DRAWING NO. 385	
PREPARED BY R. JACOBSON	DESIGNED BY JACOBSON	PCIP PKG.	SHEET 61
DRAWN BY BARLOW	CHECKED BY 6/78	DATE	OF 65

Contractor shall verify all dimensions and take own measurements to at the job site before commencing work. Advise of any error or discrepancy.

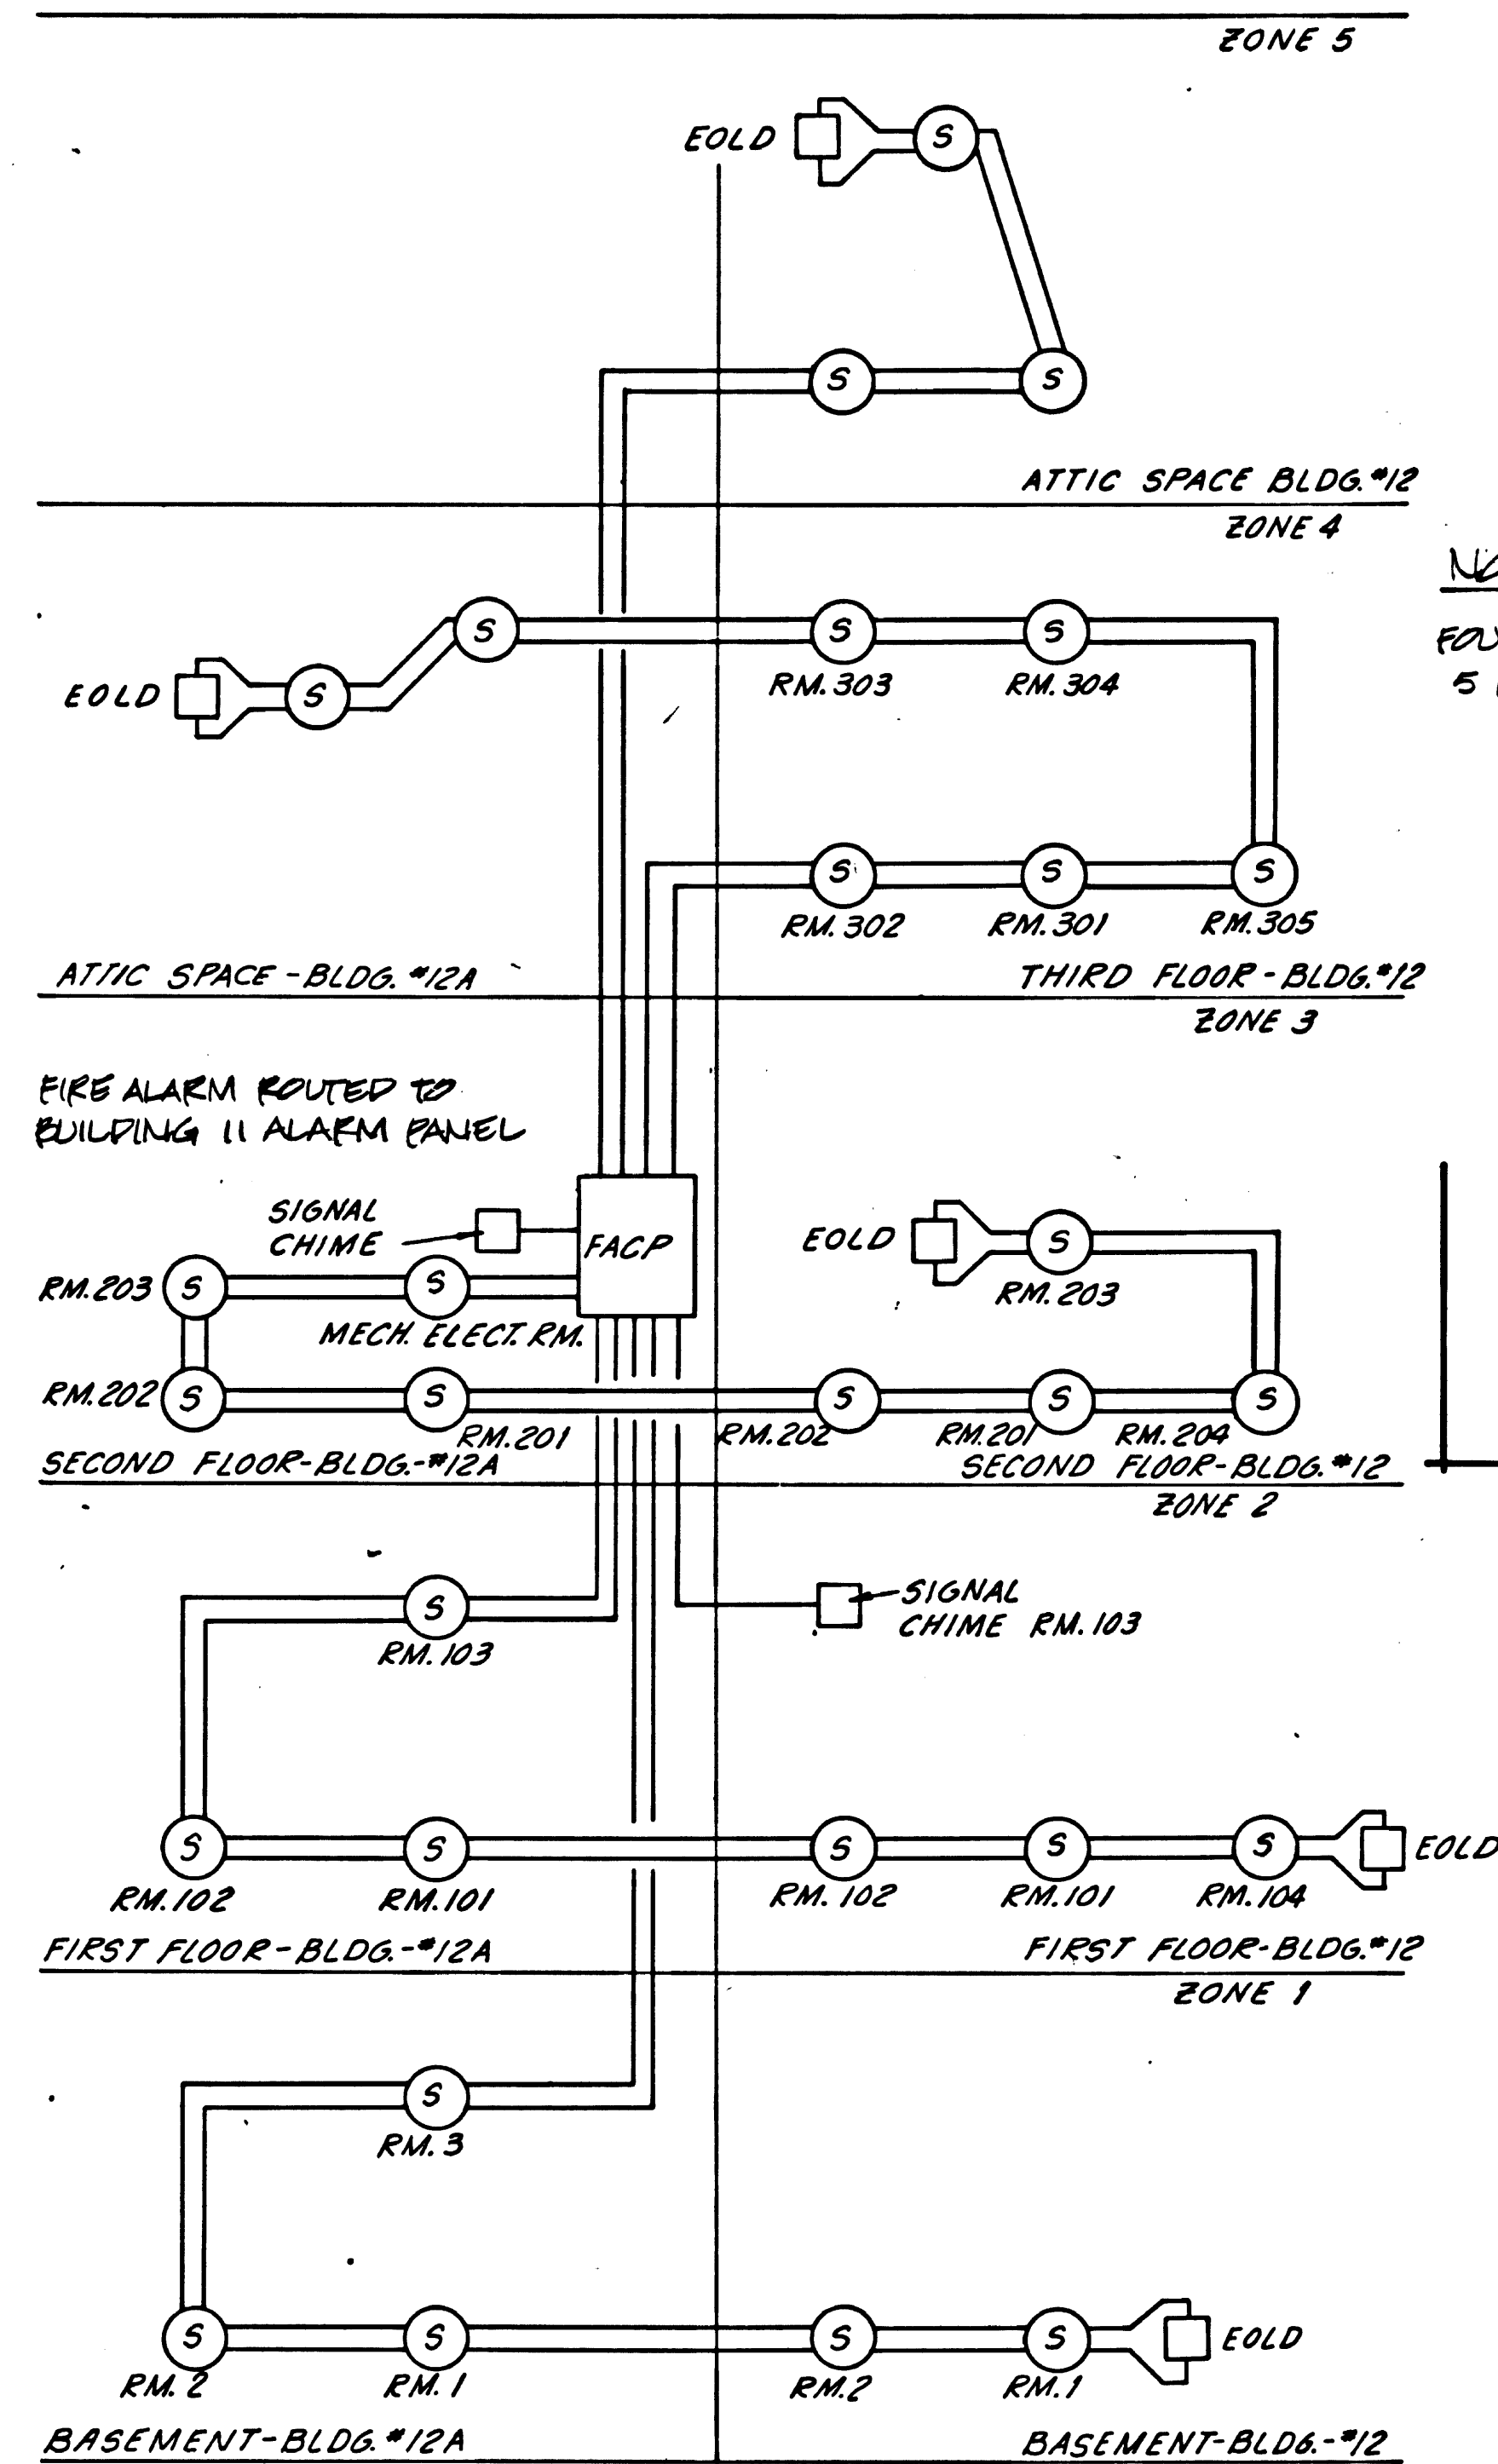

NOTE:
FOURTH FLOOR - BLDG. #12 (NOT SHOWN) -
5 DETECTORS TO BE INSTALLED

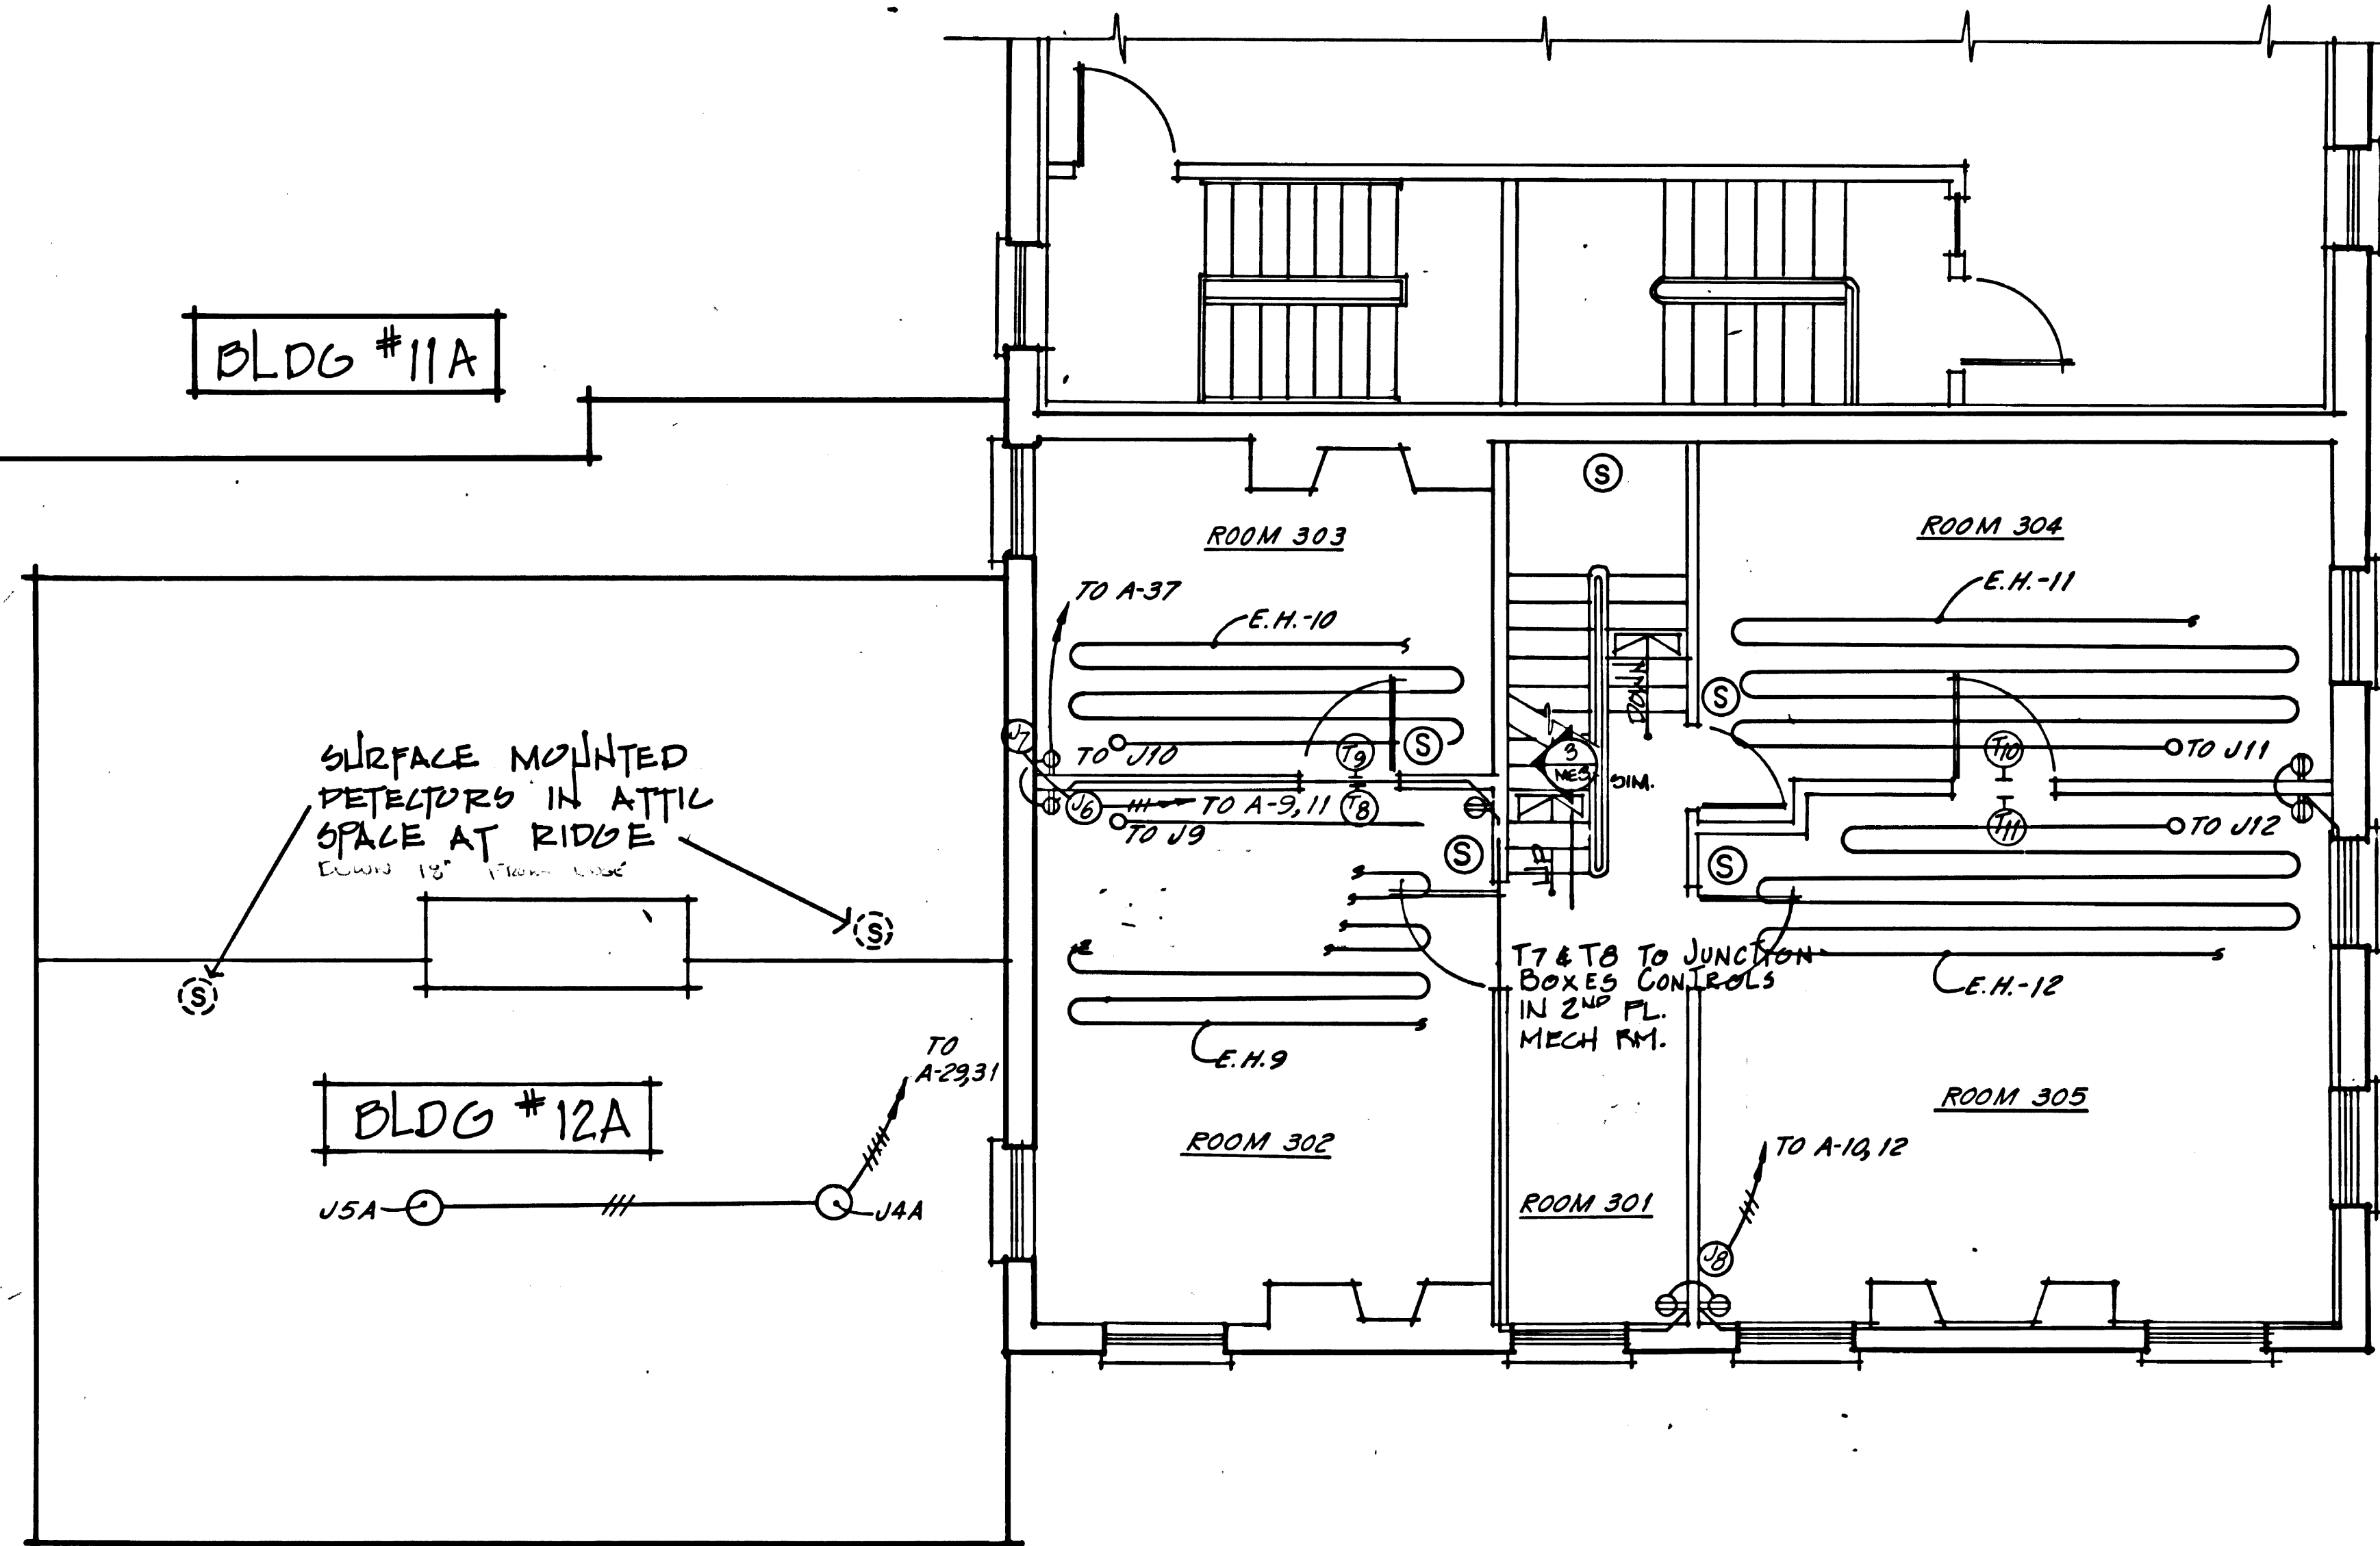


FIRE ALARM SYSTEM (WIRING)
NO SCALE

THIRD FLOOR PLAN
SCALE : 1/4" = 1' - 0"

PHASE II-B
RESTORATION


MECHANICAL / ELECTRICAL - BLDG 12 & 12A
SCALE : 1/4" = 1' - 0"

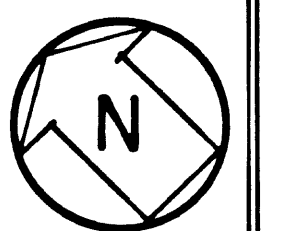


ME-4
PREPARED BY
RICHARDSON
DESIGNED BY
JACOBS
DRAWN BY
BARLOW
CHECKED
6/78
DATE

DRAWING NO.
385
25,006A
SHEET
62
OF 65


Contractor shall verify all dimensions and
base own measurements at the job site before
commencing work. Notify of any discrepancies
immediately.

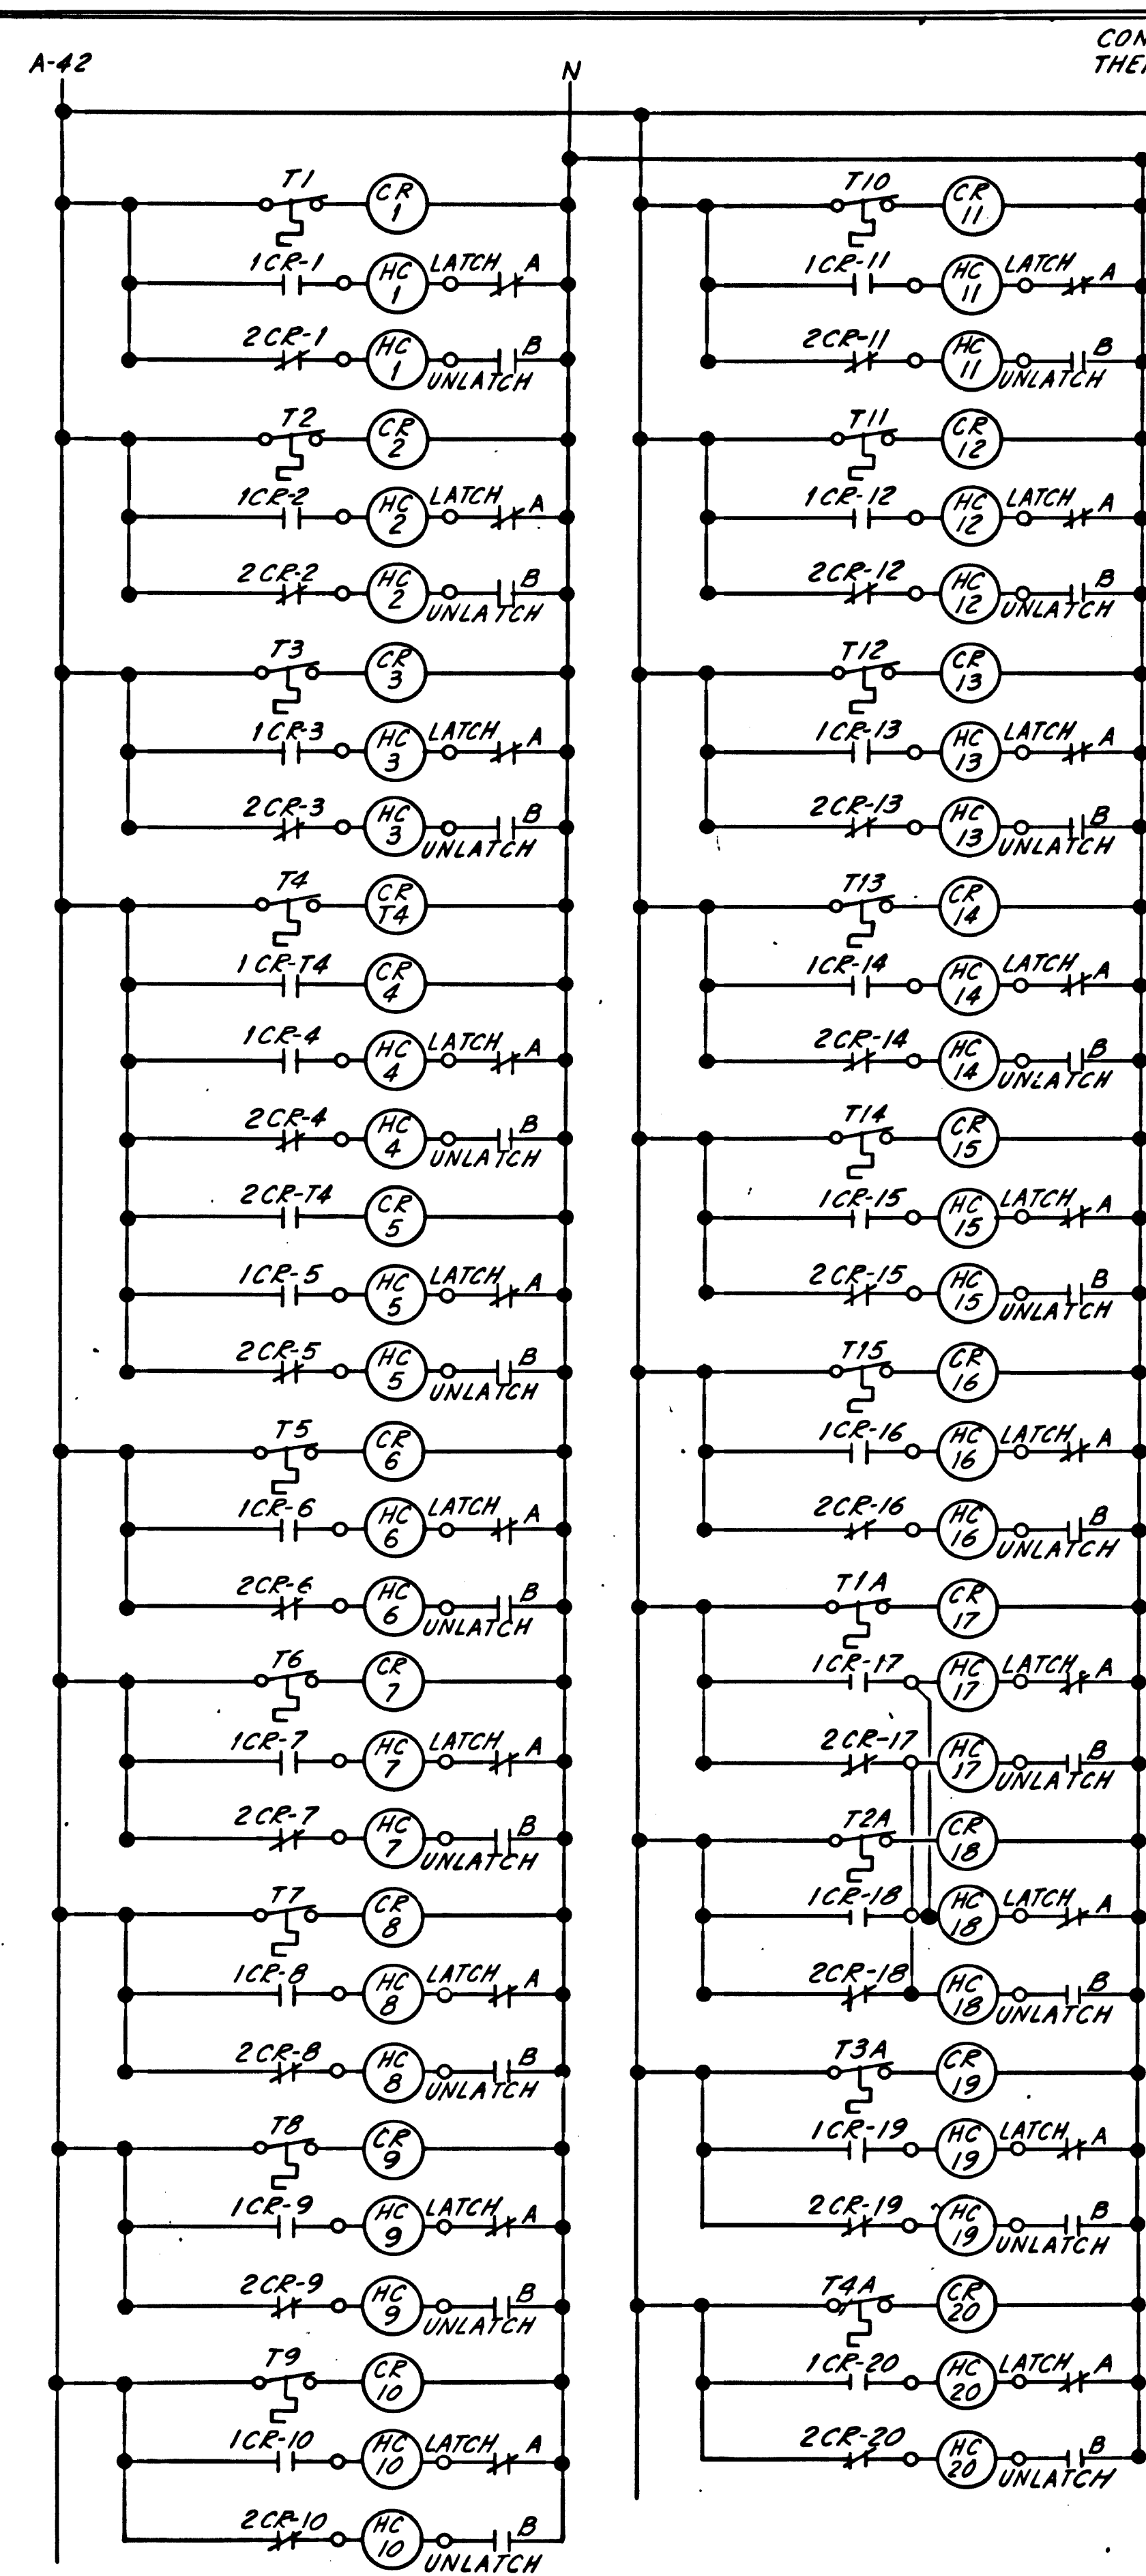

**CONTROL FOR RADIANT CEILING
HEATING CABLES BUILDING 12**
NO SCALE

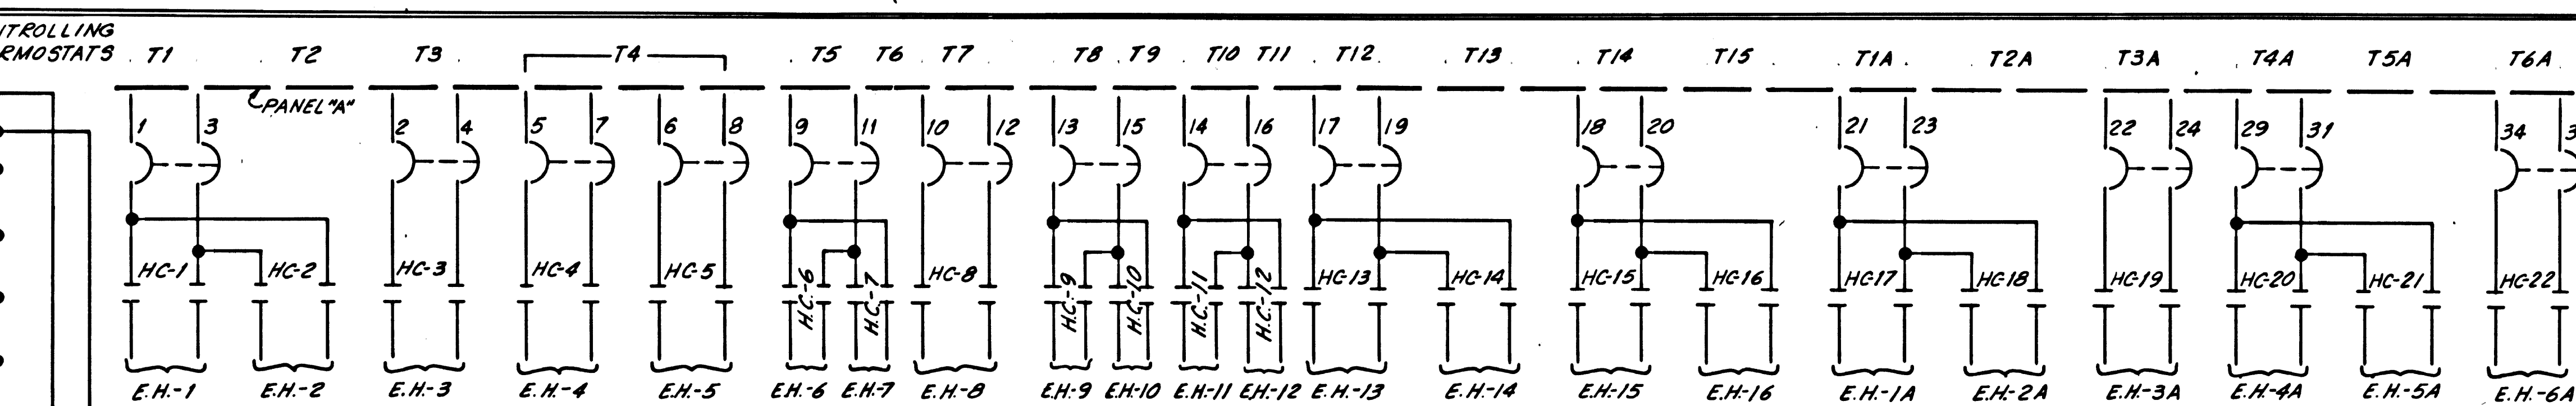

**RADIANT CEILING HEATING CABLES
POWER DIAGRAM**
NO SCALE

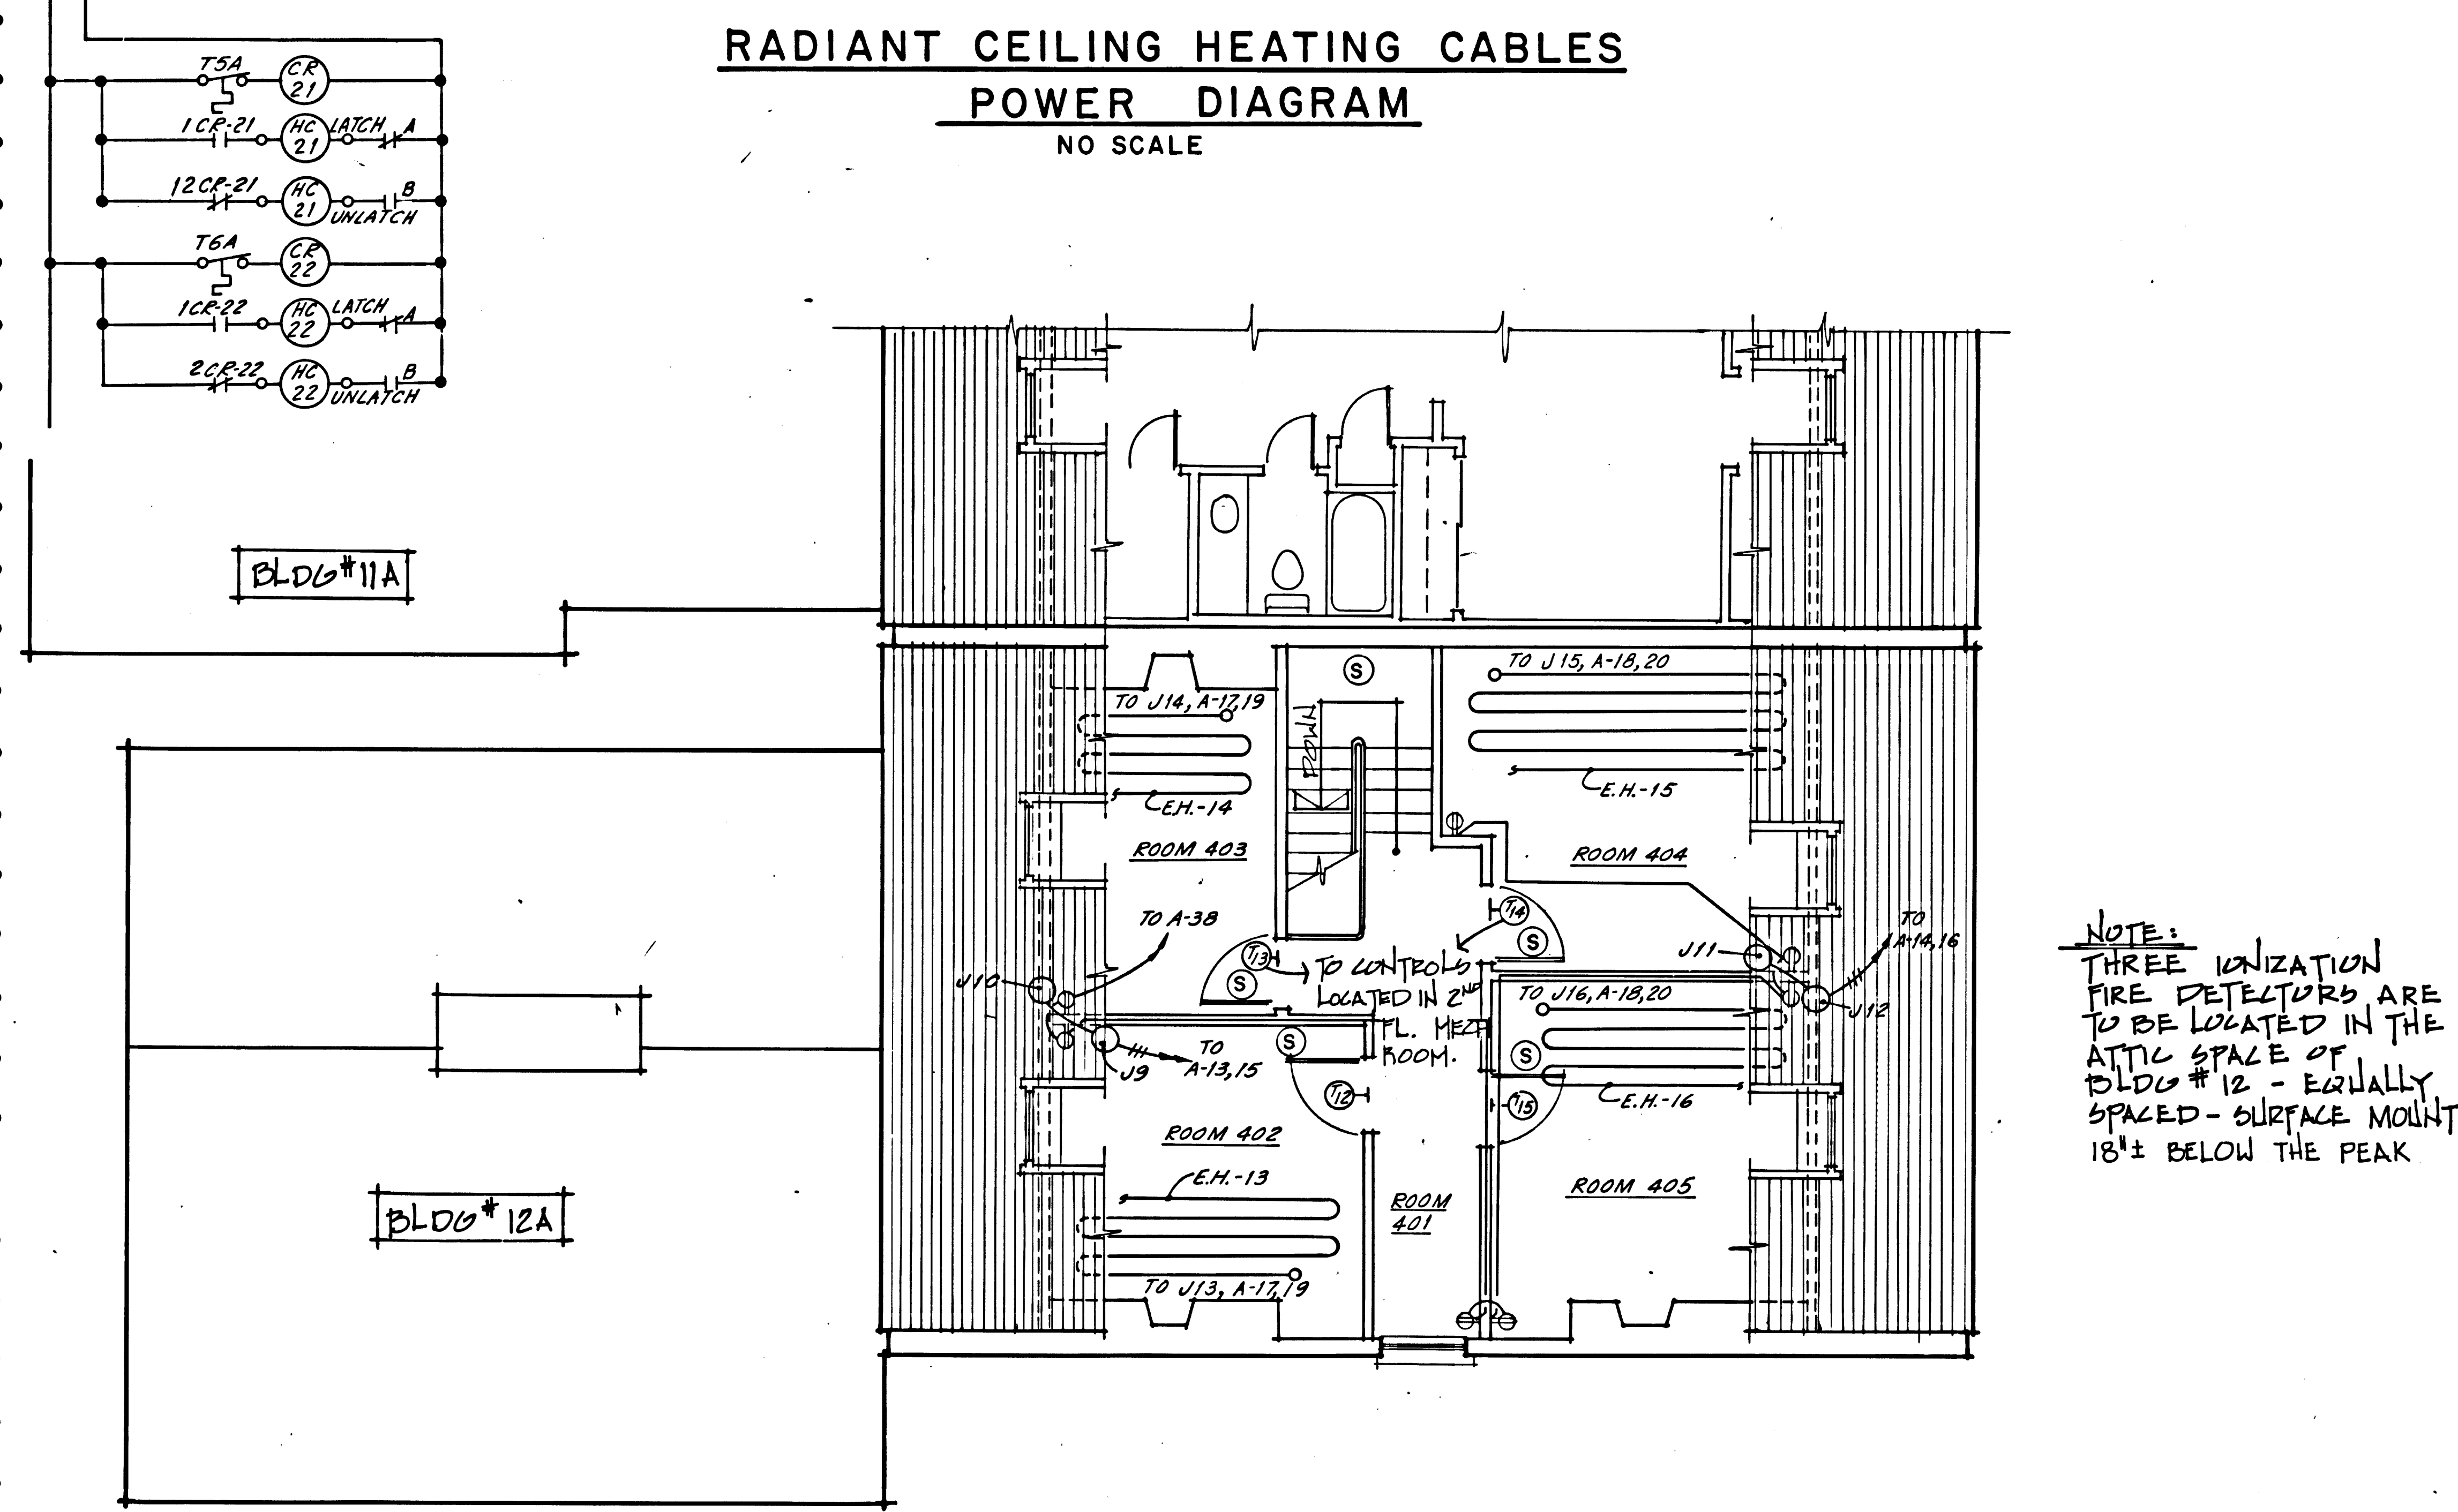

FOURTH FLOOR PLAN
SCALE : 1/4" = 1' - 0"

NOTE:
THREE IONIZATION
FIRE DETECTORS ARE
TO BE LOCATED IN THE
ATTIC SPACE OF
BLDG #12 - EQUALLY
SPACED - SURFACE MOUNT.
18"± BELOW THE PEAK

**PHASE II-B
RESTORATION**

MECHANICAL ELECTRICAL - BLDG 12 & 12A
SCALE : 1/4" = 1' - 0"




ME-5		DRAWING NO.	
PREPARED BY JACOBSON		385	
DESIGNED BY JACOBSON		25,006A	
DRAWN BY BARLOW		SHEET	
CHECKED BY 6/78		63	
DATE		OF 65	



LEGEND

	SAFETY SWITCH
	FUSED SWITCH
MP#	MANHOLE FOR POWER
MT#	MANHOLE FOR TELEPHONE
G.	CONDUIT
N.I.G.	NOT IN CONTRACT
CU.	COPPER
	WYE CONNECTION
	DELTA CONNECTION
	KILOWATT HOUR METER WITH DEMAND REGISTER
NOTE:	FOR ADDITIONAL LEGEND SEE ME 1.

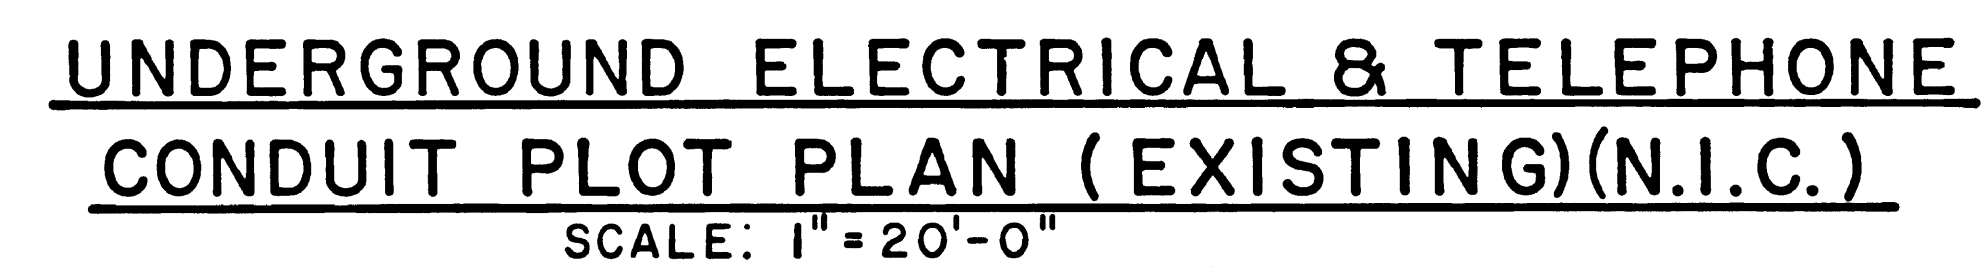

PHASE II-B RESTORATION

ELECTRICAL — BLDG. 12 & 12A

SCALE: 1" = 20'-0"

ME-6

PREPARED
PAZALOS
R. RICHARDSON
DESIGNED
PAZALOS
DRAWN
BARLOW
CHECKED
6/78
DATE

DRAWING NO.	
385	
25,006A	
PCIP PKG.	SHEET
110	64
	OF 65

Contractor shall verify all dimensions and take own measurements at the job site before commencing work. Advise of any error or discrepancy.

