


SECTION STATISTICS

LENGTH IN MILES		AREA IN ACRES		PURCHASE	TOTAL	PROFOUND
FROM STATE	FROM U.S.E.S.	NPS				
FEE SIMPLE	402.91	1007.54	0.00	1410.45	613.00	
AUGUSTA CO.	7.07	0.00	0.00	7.07	217.00	
NELSON CO.						
TOTAL	409.98	1007.54	0.00	1417.52	830.00	
SCENIC EASEMENT	0.00			0.00		
OPEN LAND	47.25					
TO BE LEASED	39.05					

LEGEND


- BOUNDARY LINES
 - NATIONAL
 - FEE SIMPLE PROPERTY
 - SCENIC EASEMENT
 - ROADS
 - PARKWAY
 - MILE POST
 - PUBLIC (OTHER)
 - PRIVATE
 - TRAILS
 - PEDESTRIAN
 - HORSE
 - APPALACHIAN
 - FENCES
 - SMOOTH WIRE
 - BARBED WIRE
 - WORM OR SNAKE
 - POST AND RAIL
 - STONE
 - GUARD RAIL
 - WOOD
 - STONE
 - RETAINING WALLS
 - BUILDINGS
 - PARKWAY: EXISTING
 - PROPOSED
 - TO BE REMOVED
 - OTHER (indicate use)
 - TELEPHONE
 - METALLIC
 - GROUND
 - UNDERGROUND
 - POWER LINES
 - AERIAL
 - UNDERGROUND
 - WATER LINES
 - CEMETERY
- LANDSCAPE SYMBOLS:
- GRADED AREAS
- TOP OF SLOPE (in cut)
 - TOE OF SLOPE (in fill)
 - LIMIT OF DAYLIGHTED CUT
- WOODS (final area stippled)
- EXISTING LIMITS
 - WELL DEVELOPED
 - CUT-OVER OR REGENERATION
 - PROPOSED LIMITS
- INDIVIDUAL TREES
- EXISTING
 - TO REMAIN
 - TO BE REMOVED
- SHRUBS
- EXISTING
 - TO REMAIN
 - PROPOSED
- ROCK OUTCROPS
- VIEW LINES
- AT EDGE OF FOLIAGE
 - OVER FOLIAGE
 - UNDER FOLIAGE
- OTHER FEATURES AND ELEMENTS LABELED

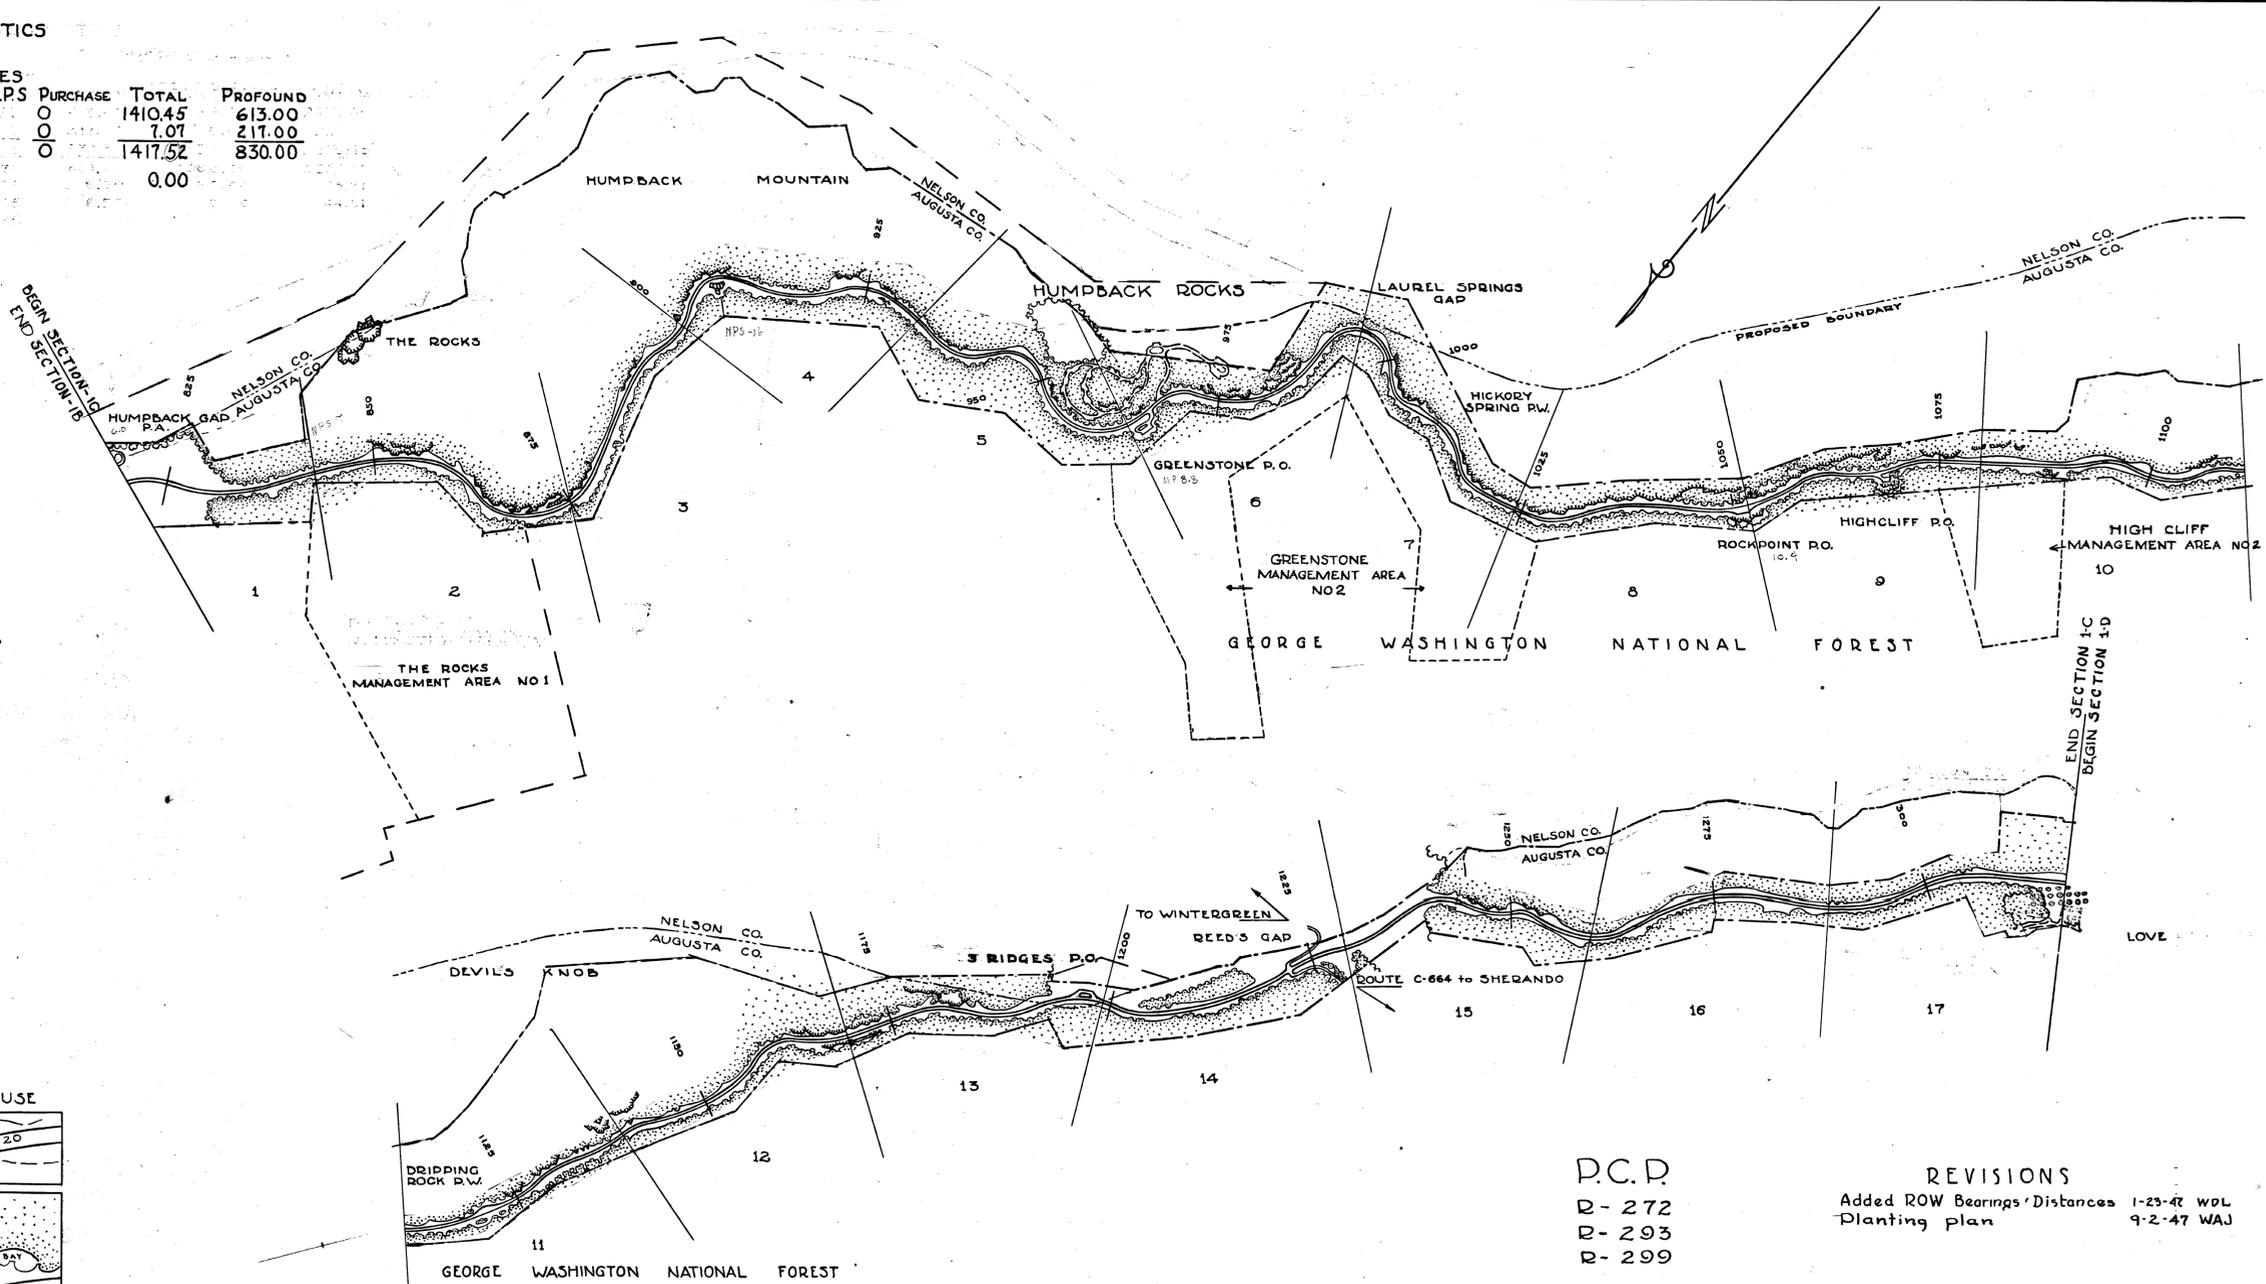

MAP LAYOUT

P.C.D.
 R-272
 R-293
 R-299

REVISIONS
 Added ROW Bearings/ Distances 1-23-47 WDL
 Planting plan 9-2-47 WAJ

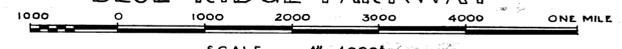

U. S. DEPARTMENT OF THE INTERIOR NATIONAL PARK SERVICE
PARKWAY LAND USE MAPS
 SECTION 1-C HUMPBACK GAP TO LOVE
BLUE RIDGE PARKWAY

RECOMMENDED Paul J. Cramer DATE 9/2/47
 A.F. SUPERINTENDENT

RECOMMENDED R.W. Emerson DATE 9/10/47
 REG. LAND. ARCH.

APPROVED Thomas J. Allen DATE 9/10/47
 REGIONAL DIRECTOR

DELIN. BY: W.A.J. DATE 6-28-44 CHECKED BY: A.H.H. DATE 6-28-44
 DATA AS OF JUNE 1, 1944 DWG. No. PKY-BR COVER SHEET
 IC-2062-A OF 17 SHEETS

DESIGNED BY: W.A.J. DATE: 6/27/44
 PLANS AND DESIGN: W.E. O'NEIL
 ENGINEERING: W.E. O'NEIL
 FORESTRY: F.H. ATYIA
 RESEARCH AND EDUCATION: 9-9-47
 SANITATION: 9-9-47
 PLANNING AND STATE COOPERATION: 9-9-47
 REGIONAL DIRECTOR: 9-9-47
 REVIEWED: 9-9-47
 CLEARED: 9-9-47

BASIC DATA FOR PROJECT CONSTRUCTION PROGRAM SEE REVISED PRIORITY LIST
 STATE RIGHT OF WAY MAPS PUBLIC ROADS ADMIN. CONTRACT DRAWINGS FIELD CHECK EASEMENT SKETCHES DEEDS MASTER PLAN


1C-1

1C1

Existing temporary rail fence.
Proposed rock & rail-rider fence
after cut is widened.

2 White Oak
1 Shagbark Hickory
5 Fl. Dogwood

Seedlings (Approx. one per 50 sq. ft.)
15 White Oak
10 Chestnut Oak
15 Am. Hornbeam
5 Shagbark Hickory
10 Red Maple
5 Black Tupelo
50 Fl. Dogwood
30 Common Witchhazel
25 Downy Serviceberry
10 Sourwood
25 Blackhaw Vib.
200 Lowbush Blueberry

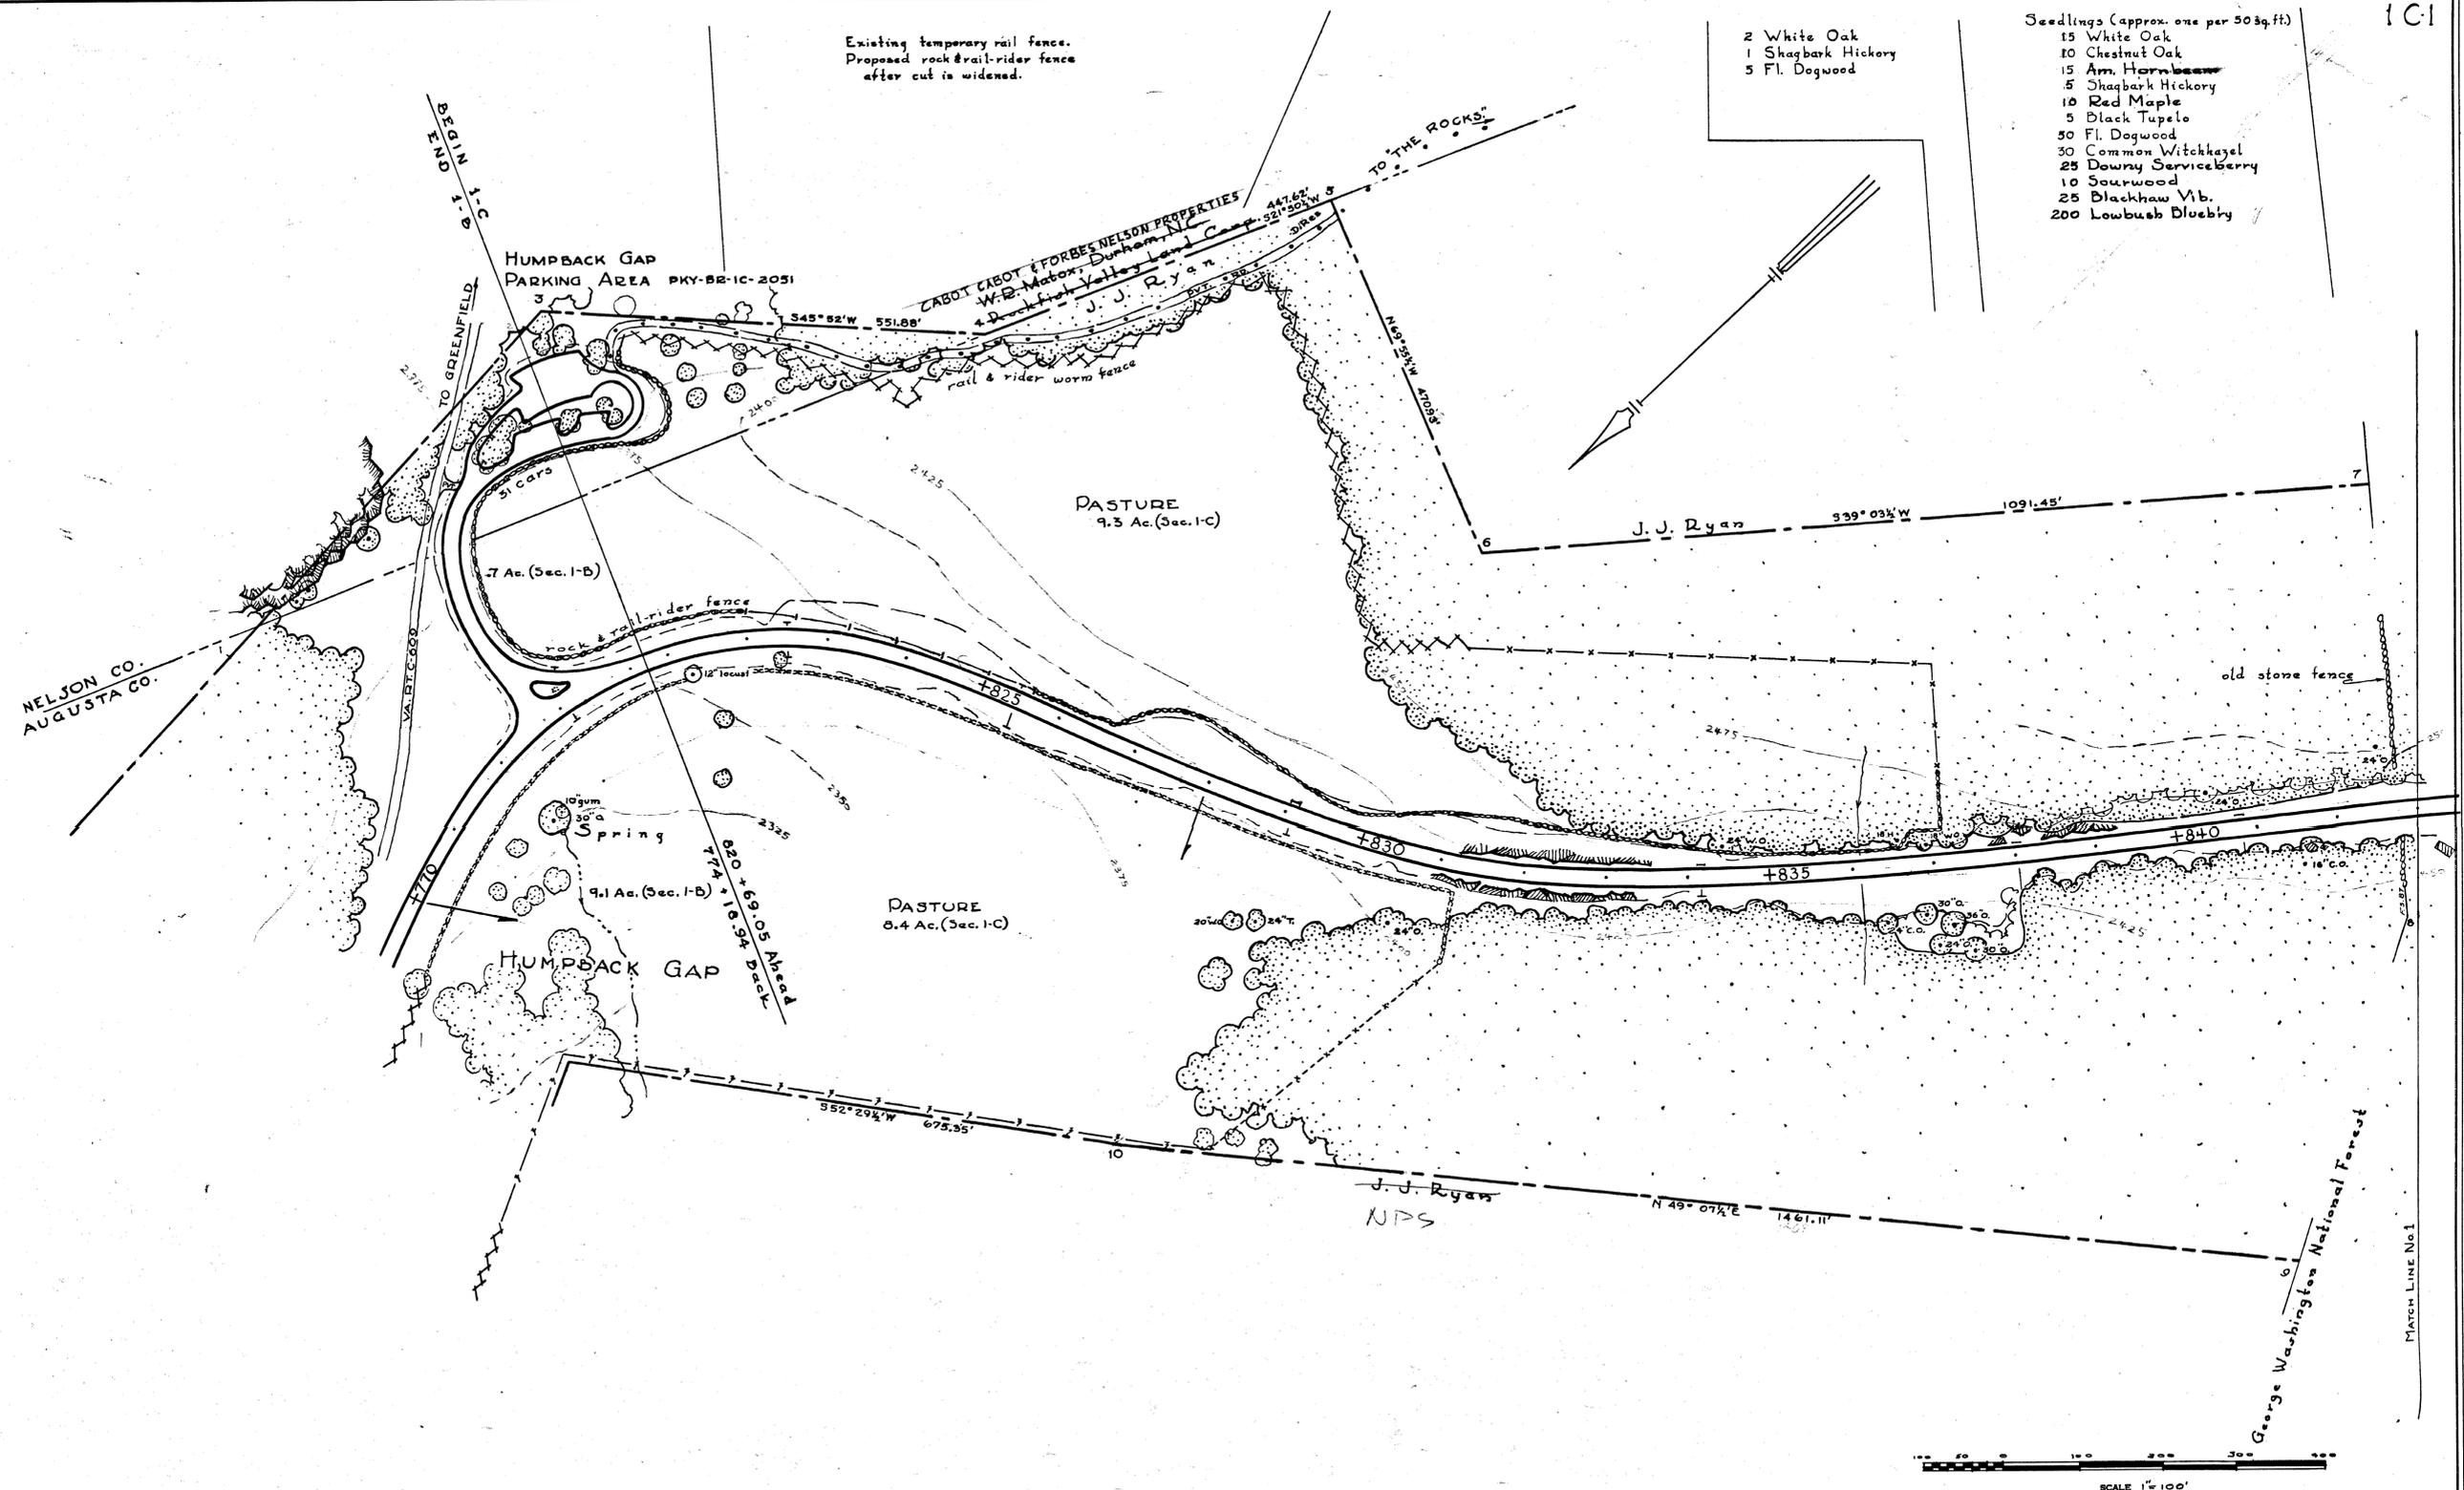

DESIGNED BY M.A.J. DATE 2/18/88	ENGINEERING	PLANS AND DESIGN	HISTORY	REVIEWED	RECREATIONAL PLANNING AND STATE COOPERATION	PERSONAL DIRECTOR
					RESEARCH AND EDUCATION	
CLEARED						



RECOMMENDED _____ DATE _____ CONCURRED _____ DATE _____ APPROVED _____ DATE _____	UNITED STATES DEPARTMENT OF THE INTERIOR NATIONAL PARK SERVICE BRANCH OF PLANS AND DESIGN ROANOKE VIRGINIA OFFICE	REGION ONE SHEET 1 OF 17
	NAME OF JOB SECTION 1-C	DRAWING NO. PKY-820
	LOCATION BLUE RIDGE PARKWAY NAME OF PARK OR MONUMENT	STA. 820 TO 843 IC-2062-A

BASIC DATA

1C-1

1C-2

1C-2

- 4 N. red oak
- 2 White oak
- 1 Red maple
- 3 Am. hophornbeam
- 6 Fl. dogwood

- Seedlings (1/10 sq.ft.)
- 1000 Lowbush Blueberry
 - 200 Roses (in var)
 - 20 Va. Creeper

Clean earth from rock cut.

- 6 Downy Serviceberry 4'-6"
- 3 Fl. Dogwood 3'-5"

- Seedlings (1/10 sq.ft.)
- 200 Lowbush Blueberry
 - 100 Roses (in Var.)
 - 10 Va. Creeper

- Face, & intermingle woods with
- 25 Fl. dogwood seedlings
 - 200 Lowbush Blueberry
 - 1 N. red oak 14' spec. 0

Rock & ground cover bay as imitation to view of "THE ROCKS."

- 100 Lowbush Blueberry
- 5 Va. Creeper

Seedlings (Appr. one per 16 sq.ft.)
 In 4 locations, stations 860+50 to 862; 866 to 867; 869 to 870; 871 to 872+25.

- 20 White Oak
- 20 Chestnut Oak
- 10 Shagbark Hickory
- 20 Black Tupelo
- 25 Am. Hornbeam
- 20 Red Maple
- 20 Fl. Dogwood
- 10 Virginia Creeper
- 50 Virginia Rose
- 10 Yellow Poplar
- 10 Downy Serviceberry
- 25 Blackhaw Vib
- 100 Lowbush Blueberry

J. J. Ryan

J. J. Ryan

NPS

MATCH LINE No. 1

MATCH LINE No. 2

- 1 White oak 14' spec. 0

- 3 N. Red oak
- 3 White oak
- 5 Am. hophornbeam
- 7 Red maple
- 5 Fl. dogwood

Face, & intermingle woods with

- 150 Fl. dogwood seedlings

- From 857 to 860
- 3 Chestnut oak
 - 2 Red maple
 - 1 Red oak

- Seedlings
- 50 Frost Grape
 - 100 Roses (in Var.)
 - 20 Va. Creeper

Seedlings 50 Frost Grape

To enframe view to "The Rocks" 1 Chestnut oak

To emphasize curve 5 Chestnut oaks, highhead



GEORGE WASHINGTON NATIONAL FOREST

DESIGNED BY
W. A. J.
2/18/54

PLANS AND DESIGN
ENGINEERING

REVIEWED
RESEARCH AND EDUCATION
SANITATION

CLEARED
REGIONAL DIRECTOR

BASIC DATA

RECOMMENDED	DATE
CONCURRED	DATE
APPROVED	DATE

UNITED STATES
DEPARTMENT OF THE INTERIOR
NATIONAL PARK SERVICE
BRANCH OF PLANS AND DESIGN
PREPARED BY
ROANOKE VIRGINIA OFFICE

SECTION 1-C
BLUE RIDGE PARKWAY

NAME OF JOB
STA. 843 TO 875

LOCATION
NAME OF PARK OR MONUMENT

REGION
ONE

SHEET 2 OF 17
DRAWING NO.
PKY. B2
1C-2062A

1C-2

1C-3

1C-3

GEORGE WASHINGTON NATIONAL FOREST

TRIM LINE

- Seedlings (1/16 sq.ft.)
- 10 Yellow Poplar
- 5 Black Tupelo
- 10 Chestnut Oak
- 5 N. Red Oak
- 10 Red Maple
- 5 Hickory (in var)
- 50 Fl. Dogwood
- 25 Virginia Creeper
- 10 Virginia Rose
- 10 Blackhaw Vib.


- Seedlings (1/25 sq.ft.)
- 5 Black Tupelo
- 5 Chestnut Oak
- 5 Red Maple
- 5 Am. Hornbeam
- 5 Yellow Poplar
- 20 Fl. Dogwood
- 10 Virginia Creeper
- 15 Virginia Rose
- 10 Am. Elder

- 2 Chestnut Oak 8'
- 1 Red Maple 8'
- 5 Shadblow 6'

- Seedlings (appr one per 25 sq.ft.)
- 10 Yellow Poplar
- 20 Chestnut Oak
- 20 N. Red Oak
- 20 Red Maple
- 20 Black Tupelo
- 10 Hickory (in var)
- 25 Fl. Dogwood
- 50 Virginia Creeper
- 50 Blackhaw Viburnum
- 25 Downy Serviceberry
- 25 Pagoda Dogwood
- 10 Sourwood
- 25 N. J. Tea
- 150 Roses (native spp.)
- 500 Lowbush Blueberry

- 1 Black Tupelo 8'
- 10 Fl. Dogwood

1 Chestnut Oak 16' spec. Ⓞ

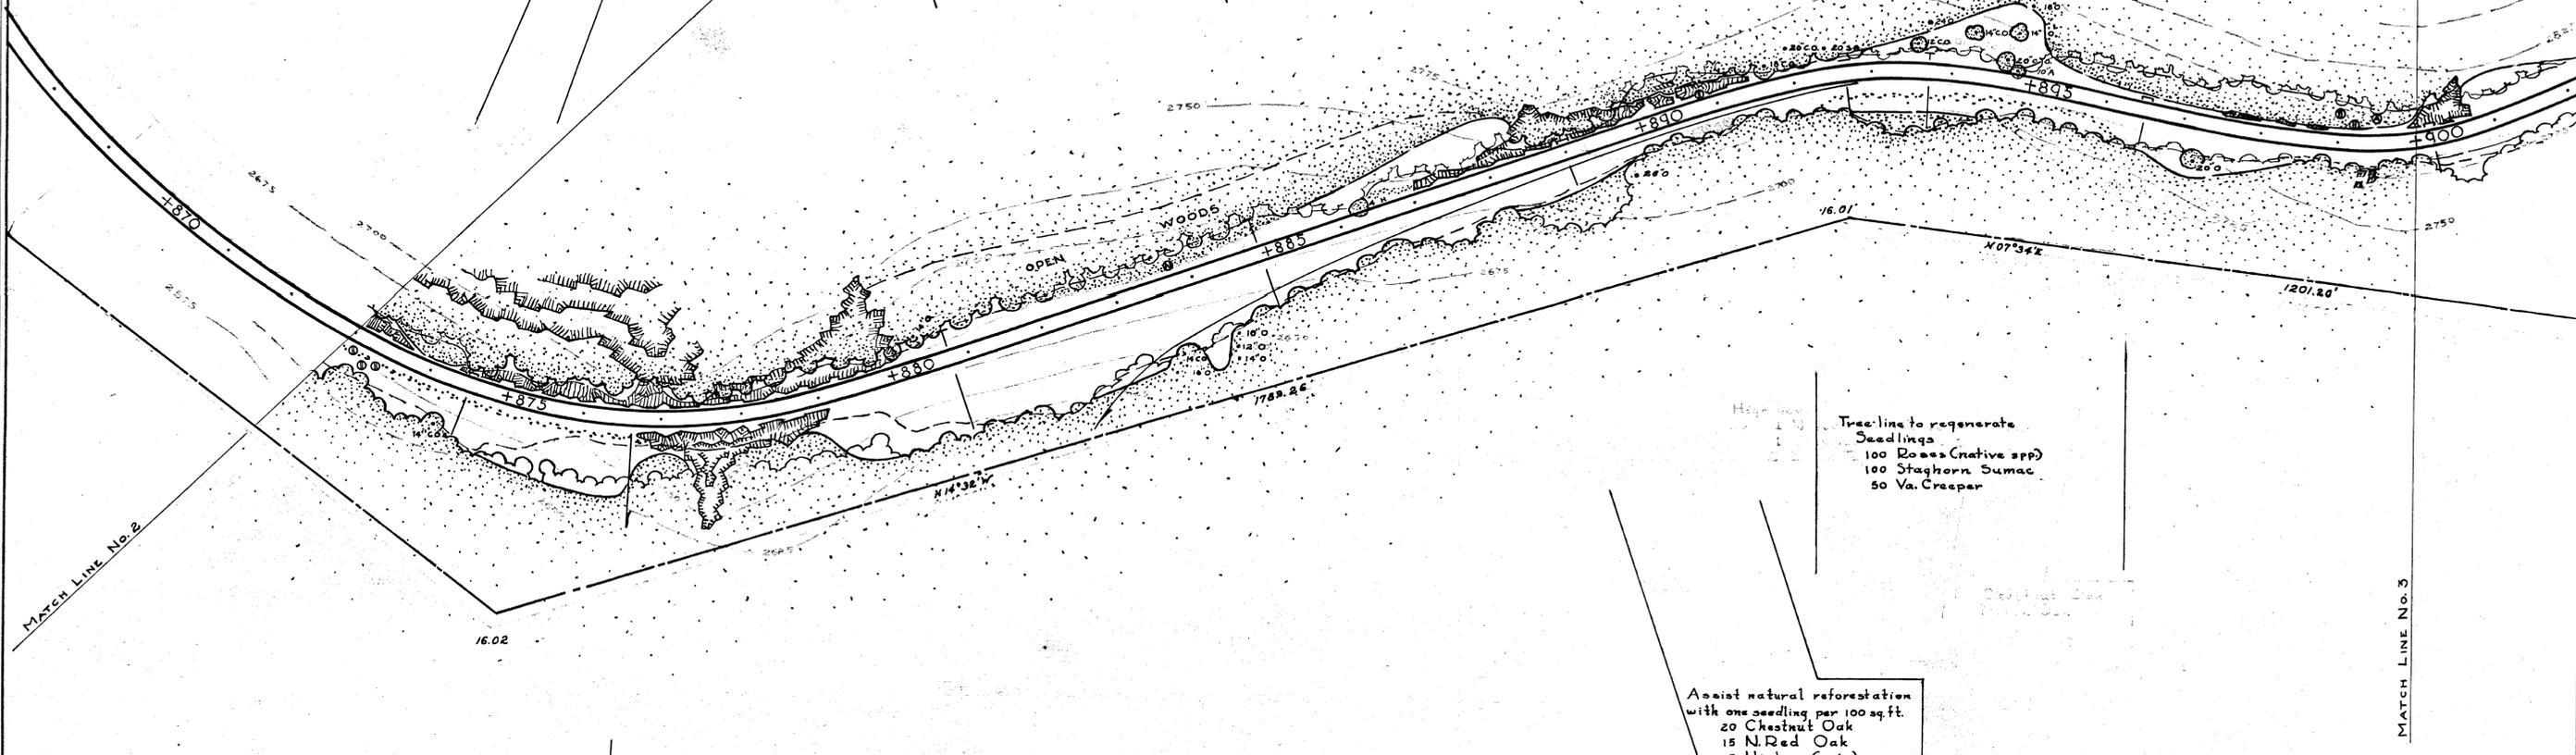

- Tree line to regenerate
- Seedlings
- 100 Roses (native spp.)
- 100 Staghorn Sumac
- 50 Va. Creeper

- Assist natural reforestation
- with one seedling per 100 sq.ft.
- 20 Chestnut Oak
- 15 N. Red Oak
- 5 Hickory (in var)

- 3 Chestnut Oak 16' spec. Ⓞ
- Seedlings
- 20 Frost Grape

- Seedlings (1/100 sq.ft.)
- 5 Yellow Poplar
- 5 Chestnut Oak
- 5 Red Maple
- 3 Shagbark Hickory
- 5 Am. Hornbeam
- 15 Fl. Dogwood
- 10 Virginia Creeper
- 10 Va. Rose
- 10 Downy Serviceberry

GEORGE WASHINGTON NATIONAL FOREST

TRIM LINE

DESIGNED BY: [] DATE: 2/21/44

REVIEWED: []

CLEARED: []

BASIC DATA



RECOMMENDED _____ DATE _____	UNITED STATES DEPARTMENT OF THE INTERIOR NATIONAL PARK SERVICE BRANCH OF PLANS AND DESIGN PREPARED BY ROANOKE VIRGINIA OFFICE	REGION ONE
CONCURRED _____ DATE _____		SHEET 3 OF 17
APPROVED _____ DATE _____		DRAWING NO. PKY. BQ 1C-2062A
SECTION 1-C BLUE RIDGE PARKWAY		NAME OF JOB STA. 075 TO 902 LOCATION NAME OF PARK OR MONUMENT

1C-3

1C-4

1C-4

Seedlings
 200 Lowbush Blueberry
 50 Mt. Laurel Kalmia
 75 Virginia Creeper
 25 Virginia Rose

2 Red Maple 8' @
 1 Scarlet Oak 10' @
 Seedlings
 30 Fl. Dogwoods
 300 Lowbush Blueberry

Selective cutting note:
 Leave only large canopy trees, and small trees close to road that can be high-headed; and shrubs.


Seedlings (appr. one per 16 sq. ft.)
 40 Chestnut Oak
 10 Red Maple
 10 Hickory (in van)
 10 Yellow Poplar
 60 Blackhaw Viburnum
 25 Common Witchhazel
 25 Va. Rose
 10 Va. Creeper

Seedlings
 100 Lowbush Blueberry

At base of rock cut
 10 Virginia Creeper

GEORGE WASHINGTON NATIONAL FOREST

DESIGNED BY: W.A.J. DATE: 2/20/44
 PLANS AND DESIGN: FORESTRY HISTORY: ENGINEERING
 REVIEWED: RESEARCH AND EDUCATION: SANITATION
 PLANNING AND STATE COOPERATION: RECREATIONAL
 CLEARED: REGIONAL DIRECTOR

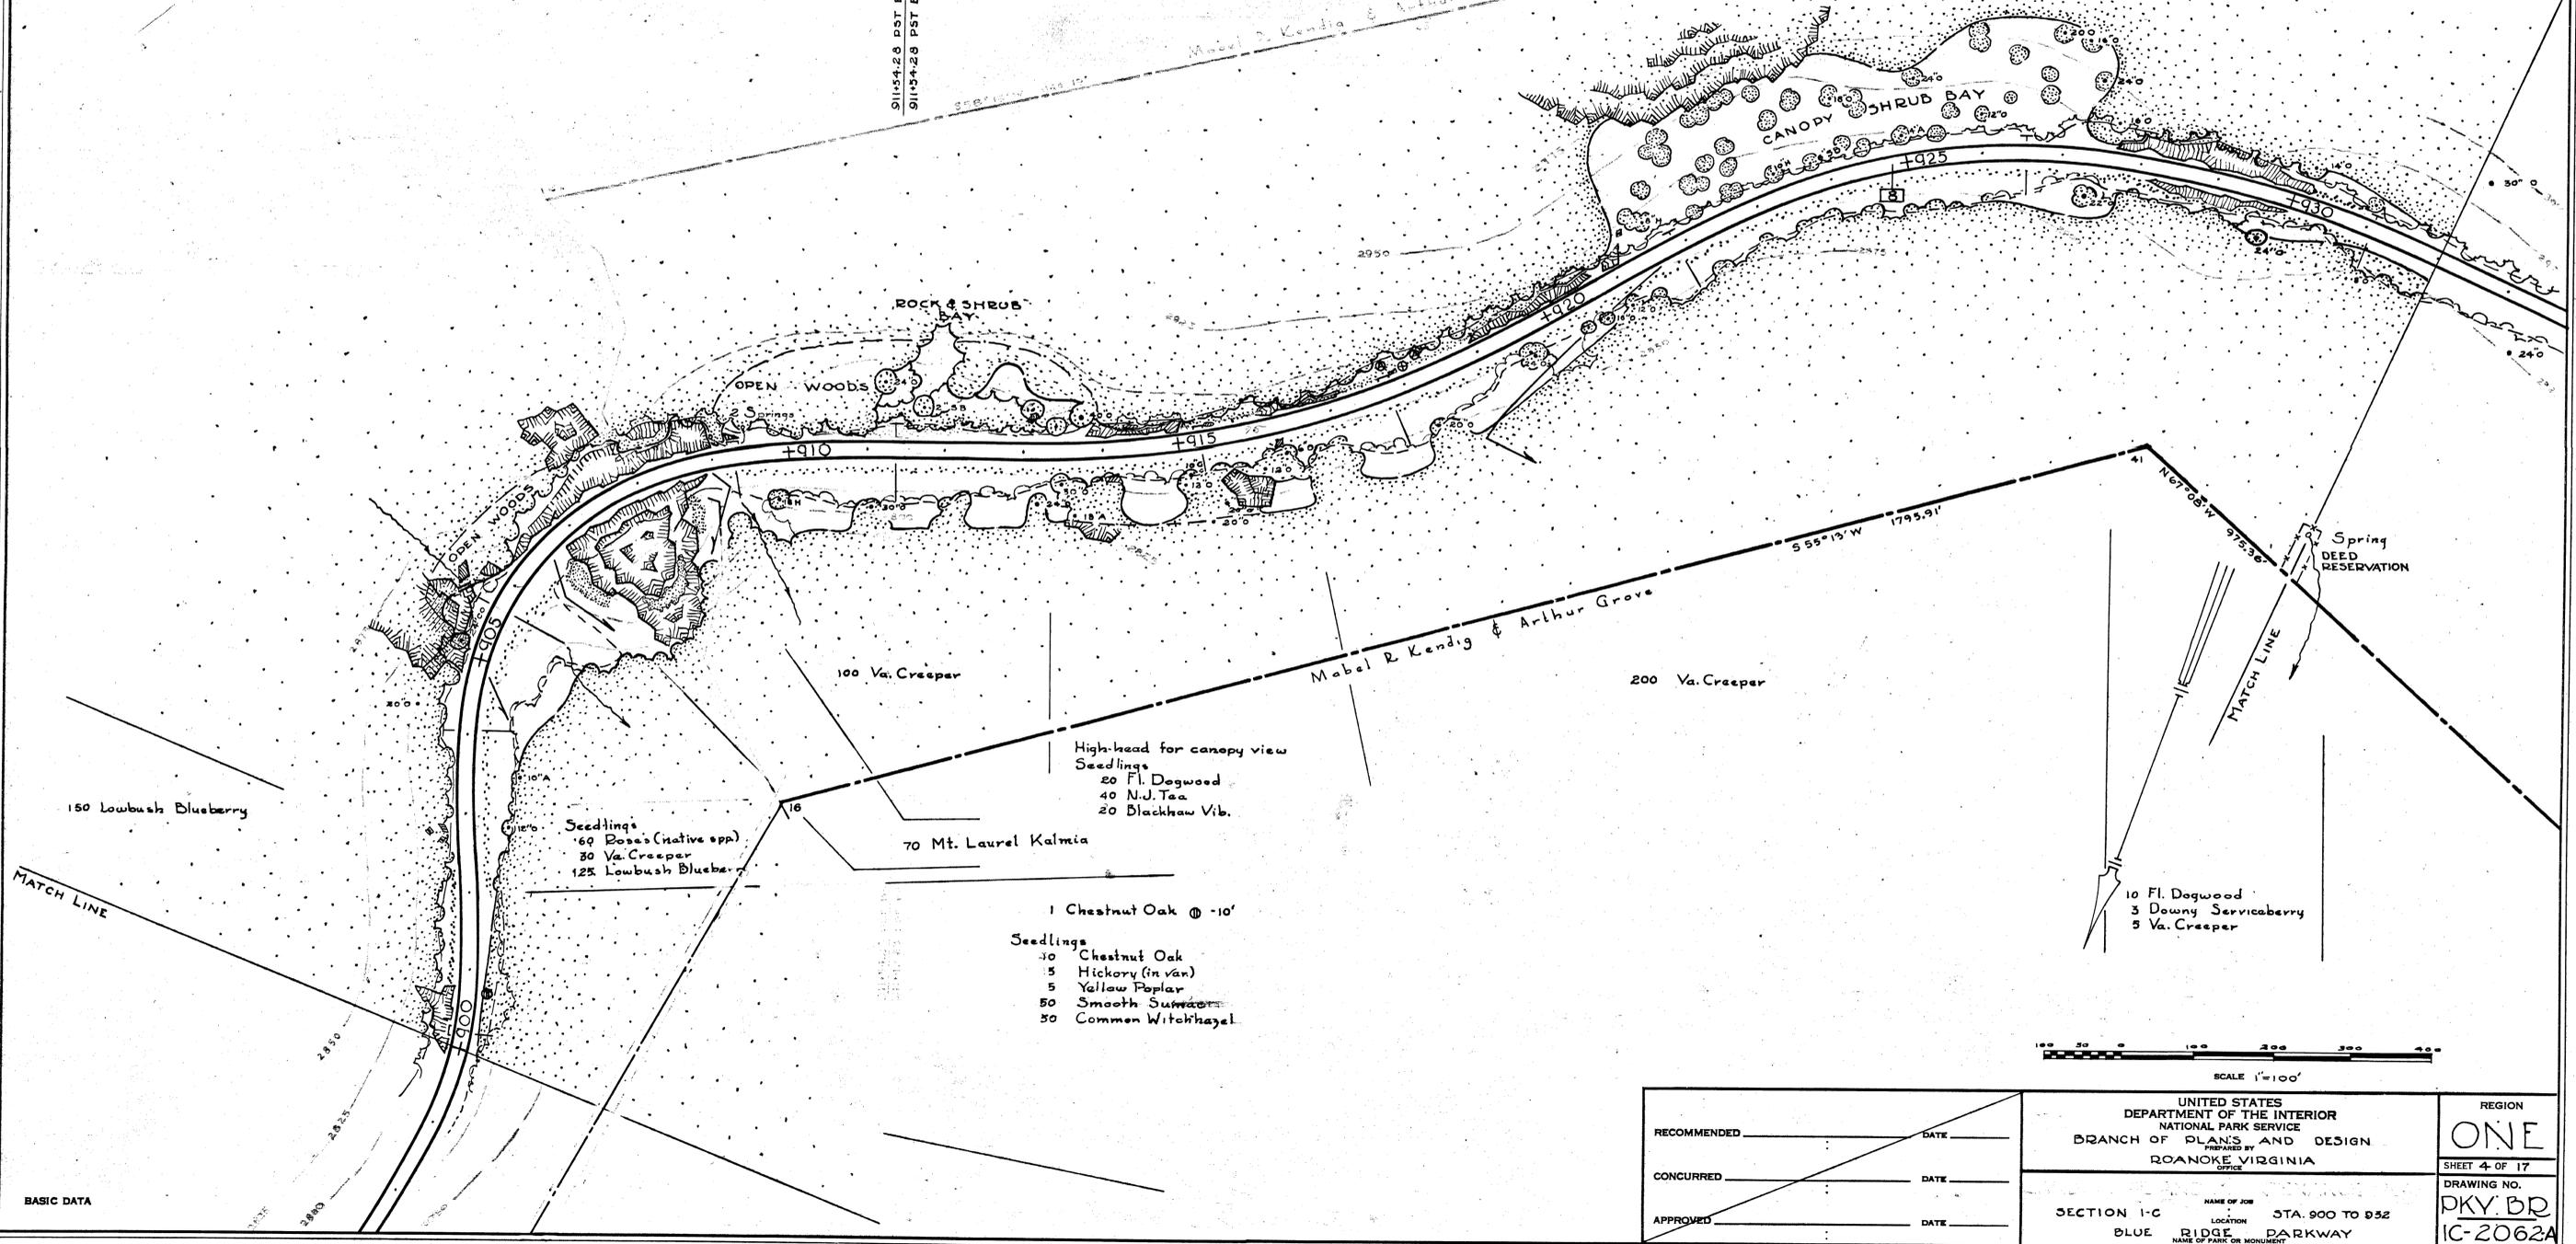

150 Lowbush Blueberry

Seedlings
 60 Rose (native spp.)
 30 Va. Creeper
 125 Lowbush Blueberry

70 Mt. Laurel Kalmia

1 Chestnut Oak @ -10'
 Seedlings
 10 Chestnut Oak
 5 Hickory (in van)
 5 Yellow Poplar
 50 Smooth Sumac
 30 Common Witchhazel

High-head for canopy view
 Seedlings
 20 Fl. Dogwood
 40 N.J. Tea
 20 Blackhaw Vib.

100 Va. Creeper

200 Va. Creeper

10 Fl. Dogwood
 3 Downy Serviceberry
 5 Va. Creeper

SCALE 1"=100'

RECOMMENDED _____ DATE _____	UNITED STATES DEPARTMENT OF THE INTERIOR NATIONAL PARK SERVICE BRANCH OF PLANS AND DESIGN PREPARED BY ROANOKE, VIRGINIA STATE	REGION ONE
CONCURRED _____ DATE _____		SHEET 4 OF 17
APPROVED _____ DATE _____		DRAWING NO. PKY:BD IC-2062A
SECTION 1-C NAME OF JOB BLUE RIDGE PARKWAY LOCATION STA. 900 TO 952 NAME OF PARK OR MONUMENT		

1C-4

TRIM LINE

IC-5

IC-5

- Seedlings (appn one per 10 sq. ft.)
- 50 Chestnut Oak
 - 10 Red Maple
 - 10 Black Tupelo
 - 10 Shagbark Hickory
 - 10 Yellow Poplar
 - 25 Pagoda Dogwood
 - 50 Azalea (pink spp.)
 - 20 N.J. Tea
 - 50 Va. Rose
 - 10 Va. Creeper
 - 100 Lowbush Blueberry

- Seedlings
- 50 Chestnut Oak
 - 50 Black Oak
 - 50 Hickory (in var.)
 - 50 Black Tupelo
 - 50 Yellow Poplar
 - 50 Red Maple
 - 50 Sourwood
 - 50 Am. Hornbeam

- 60 Downy Servicebry
- 50 Witch-hazel
- 50 Staghorn Sumac
- 25 Smooth Sumac

- In groups and specimens sta. 954 to 965, in bay:
- 100 Catawba Rhododendron
 - 75 Mt. Laurel Kalmia
 - 50 Va. Rose
 - 10 Va. Creeper
 - Seedlings
 - 100 Littlefl. Sweetfern

- 9 Chest. Oak 8'-12"
- Flatten slope 50 ft.
- Seedlings (appn 1 per 50 sq. ft.)
- 25 Chestnut Oak
 - 10 Red Maple
 - 25 Shagbark Hickory
 - 25 Downy Servicebry
 - 10 Black Tupelo
 - 50 Pagoda Dogwood
 - 25 Azalea (pink spp.)
 - 150 Lowbush Blueberry

OPEN MEADOW
6.2 Ac.
HUMPSBACK ROCKS
PKY-02-MR-2052

10 Azalea (pink spp.)

CABOT CABOT & FORBES NELSON PROPERTIES
W.D. Motes, Durham, N.C.
Rockfish Valley Land Corp.

Note - Connecting road, trails etc. to be field checked.
B.B.W.
July 27, 1958

PICNIC AREA

OPEN WOODS

OPEN WOODS

CANOPY SHRUB BAY

CANOPY SHRUB BAY

Spring

DEED RESERVATION

Mabel R. Kendig & Arthur Grove

3 Chest. Oak 8'-10" @

- As above
- 100 Catawba Rhododendron
 - 50 Mt. Laurel Kalmia
 - 25 Va. Rose
 - 5 Va. Creeper
 - Seedlings
 - 100 Littlefl. Sweetfern

- Seedlings (1/36 sq. ft.)
- 10 Chestnut Oak
 - 10 Red Oak
 - 10 Red Maple
 - 10 Black Tupelo
 - 75 Witch-hazel
 - 50 Smooth Sumac
 - 25 Fl. Dogwood
 - 25 N.J. Tea

- Seedlings (1/50 sq. ft.)
- 50 Staghorn Sumac
 - 25 Fl. Dogwood
 - 25 N.J. Tea

- Seedlings
- 50 Azalea (pink spp.)
 - 25 Pagoda Dogwood
 - 25 N.J. Tea
 - 25 Rose (native spp.)

SCALE 1"=100'

CLEARED
REVIEWED
DESIGNED BY
W.A.J.
DATE 3/16/54

BASIC DATA

RECOMMENDED _____	DATE _____
CONCURRED _____	DATE _____
APPROVED _____	DATE _____

UNITED STATES
DEPARTMENT OF THE INTERIOR
NATIONAL PARK SERVICE
BRANCH OF PLANS AND DESIGN
PREPARED BY
ROANOK, VIRGINIA OFFICE

NAME OF JOB
SECTION I-C
LOCATION
BLUE RIDGE PARKWAY
NAME OF PARK OR MONUMENT

STA. 932 TO 983

REGION
ONE
SHEET 5 OF 17
DRAWING NO.
PKY-BD
IC-2062A

IC-5

IC-6

IC-6

In groups and as specimens, in bay
 200 Catawba Rhododendron
 100 Mt. Laurel Kalmia
 25 Va. Rose
 10 Va. Creeper
 Seedlings
 100 Littlelf. Sweetfern

Station 969
 For detail of entrance to
 Humpback Rocks Recreational
 Area see plan no. PKY-BR-HR-2031-A

60 Catawba Rhododendron

Deciduous ground cover
 from top of cut to new
 woods edge.

HUMBACK ROCKS
 PKY-BR-HR-2052

2 Chestnut Oak 6'-8' @

Seedlings (1/16 sq.ft.)
 10 Black Tupelo
 10 Yellow Poplar
 20 Chestnut Oak
 10 Shellbark Hickory
 10 Red Maple
 100 Lowbush Blueberry
 50 Azalea (pink spp.)
 50 Catawba Rhododendron

6 Chestnut Oak
 4 Black Oak
 3 Shagbark Hickory
 2 Sweet Birch
 To emphasize new woods edge
 15 Mt. Laurel Kalmia
 10 Catawba Rhododendron
 10 Va. Creeper

6 Mt. Laurel Kalmia

GAS & COMFORT STATION 42

CANOPY SHRUB BAY

PICNIC AREA

COFFEE SHOP 41

GREENSTONE PARKING
 OVERLOOK. SEE PLAN
 NUMBER PKY-BR-IC-2052

Seedlings
 Pocket plant on rocky fill
 100 Virginia Creeper
 50 Virginia Rose

20 Catawba Rhododendron

50 Catawba Rhododendron
5 Red Maple

GEORGE WASHINGTON NATIONAL FOREST

4 Chestnut Oak 10'-12' @
 As above
 75 Catawba Rhododendron
 25 Mt. Laurel Kalmia
 25 Va. Rose
 15 Va. Creeper

Seedlings
 200 Sweetfern

6 Catawba Rhododendron

Seedlings
 100 Va. Creeper

Pocket plant
 6 Chestnut Oak
 2 Black Oak
 5 Fl. Dogwood

Seedlings
 Pocket plant on rocky fill
 200 Virginia Creeper



DESIGNED BY	W.A.J.	DATE	3/6/54
	PLANS AND DESIGN	ENGINEERING	
REVIEWED BY	RESEARCH AND EDUCATION	SANITATION	
	RECREATIONAL PLANNING AND STATE COOPERATION		
CLEARED	REGIONAL DIRECTOR		

RECOMMENDED	DATE
CONCURRED	DATE
APPROVED	DATE

UNITED STATES
 DEPARTMENT OF THE INTERIOR
 NATIONAL PARK SERVICE
 BRANCH OF PLANS AND DESIGN
 PREPARED BY
 ROANOKE, VIRGINIA
 OFFICE

NAME OF JOB
 SECTION 1-C
 LOCATION
 BLUE RIDGE PARKWAY
 NAME OF PARK OR MONUMENT

STA. 963 to 994+50

REGION
ONE
 SHEET 6 OF 17
 DRAWING NO.
 PKY-BR
 IC-2062-A

IC-6

TRIM LINE

U.S. GOVERNMENT PRINTING OFFICE 6-4710

1C-7

1C-7

At new woods edge
15 Catawba Rhododendron
10 Maple leaf Viburnum

5 Shellbark Hickory
1 White Oak
3 Shadblow
Seedlings
100 Lowbush Blueberry

8 Catawba Rhododendron
Seedlings (approx one per 10 sq. ft.)
5 Chestnut Oak
5 Yellow Poplar
5 Shellbark Hickory
5 Am. Hornbeam
25 Azalea (pink spp.)
25 Shadblow
10 Beaked Filbert
10 Va. Rose
20 Va. Creeper
10 Sourwood

Between roads cliff leave
only scattered canopy
trees, and shrubs.
Add
15 Azaleas (pink spp.)
10 Catawba Rhodo.

5 White Oak
3 Red Oak
2 Red Maple
25 Catawba Rhododendron

CABOT CABOT & FORBES NELSON PROPERTIES
W.D. Mabey, Durham, N.C.
Rockfish Valley Land Corp.

N 65° 39' W Blk = N 65° 40' W Ah. 2158.32'

LAUREL SPRING GAP

HICKORY SPRING
PARKING WIDENING

CANOPY GRASS BAY

OPEN WOODS

VISTA

Seedlings
40 Va. Creeper
20 Roses (spp.)

GEORGE WASHINGTON NATIONAL FOREST

Seedlings
100 Roses (spp.)
20 Shadblow

Seedlings
20 Grapes


Seedlings
40 Bkd. Filbert
20 Shadblow

5 Catawba Rhodo. 2' 4'

14 Catawba Rhodo. 2' 5'

10 Shellbark Hickory
5 Shagbark Hickory
3 White Oak
3 Sweet Birch
3 Shadblow

Block view to fill across hollow.
3 Chestnut Oak
3 Red Maple
7 Shadblow
5 Common Witch-hazel

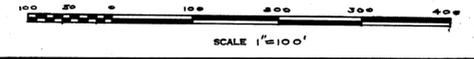

CLEARED
REVIEWED
DESIGNED BY
3/17/44

BASIC DATA

RECOMMENDED _____ DATE _____
CONCURRED _____ DATE _____
APPROVED _____ DATE _____

UNITED STATES
DEPARTMENT OF THE INTERIOR
NATIONAL PARK SERVICE
BRANCH OF PLANS AND DESIGN
PREPARED BY
ROANOKE VIRGINIA OFFICE
SECTION 1-C
BLUE RIDGE PARKWAY
NAME OF PARK OR MONUMENT

REGION
ONE
SHEET 7 OF 17
DRAWING NO.
PKY BR
1C-2062A

1C-7

TRIM LINE

U.S. GOVERNMENT PRINTING OFFICE 6-5710

1C-8

1C-8

- Seedlings (1/16 sq. ft.)
- 10 Black Tupelo
 - 10 Yellow Poplar
 - 15 Chestnut Oak
 - 10 Red Maple
 - 5 Black Oak
 - 10 Shagbark Hickory
 - 10 Am. Hornbeam
 - 60 Catawba Rhododendron
 - 50 Mt. Laurel Kalmia
 - 300 Lowbush Blueberry
 - 50 Va. Rose
 - 25 Va. Creeper

- Seedlings
- 100 Lowbush Blueberry
 - Near cliff face
 - 10 Shadblow

10 Catawba Rhode. 2'-4'

30 Catawba Rhododendron

6 Chestnut Oak
 3 Red Maple
 25 Catawba Rhododendron

Leave only canopy trees, rhododendron, laurel, for cliff emphasis.

CABOT CABOT & FORBES NELSON PROPERTIES
 W.R. Matos - Durham, N.C.
 Rockfish Valley Land Corp #2

ROCKPOINT PARKING AREA
 SEE PLAN NO. PKY-BR-1C-2053

MATCH LINE

MATCH LINE

- Seedlings
- 50 Common Witch-hazel
 - 30 Staghorn Sumac
 - 30 Roses (native spp.)
 - 20 Downy Serviceberry

20 Catawba Rhododendron
 10 Common Witch-hazel

- Seedlings
- 30 Beaked Filbert
 - 25 Downy Serviceberry
 - 25 Catawba Rhododendron
 - 50 Rose (native spp.)
 - 50 Va. Creeper

7 Catawba Rhododendron
 on fill slope

Face rock with
 3 Azaleas (pink spp) 2'-5'



CLEARED
 REGIONAL DIRECTOR

REVIEWED
 RECREATIONAL PLANNING AND STATE COOPERATION

DESIGNED BY
 MAJ
 3/19/44

GEORGE WASHINGTON NATIONAL FOREST

RECOMMENDED _____ DATE _____	UNITED STATES DEPARTMENT OF THE INTERIOR NATIONAL PARK SERVICE BRANCH OF PLANS AND DESIGN PREPARED BY ROANOKE VIRGINIA OFFICE	REGION ONE
CONCURRED _____ DATE _____		SHEET 8 OF 17
APPROVED _____ DATE _____		DRAWING NO. PKY.BR. 1C-2062-A
SECTION 1-C BLUE RIDGE PARKWAY <small>NAME OF PARK OR MONUMENT</small>		NAME OF JOB STA. 1024+50 to 1051+50 LOCATION <small>NAME OF PARK OR MONUMENT</small>

1C-8

1C-8

1C-9

1C-9

On top and back of cut
20 Catawba Rhododendron

Seedlings
400 Lowbush Blueberry
25 Va. Creeper

5 Chestnut Oak
10 Pagoda Dogwood
5 Catawba Rhododendron

Seedlings (1/16 sq.ft.)
10 Yellow Poplar
10 Black Tupelo
10 Sourwood
10 Chestnut Oak
5 Shellbark Hickory
10 Red Maple
25 Catawba Rhododendron
25 Pagoda Dogwood
10 Downy Shadblow
10 Am. Elder
10 Va. Rose
25 N.J. Tea


Seedlings (Approx. one per 50 sq.ft.)
5 Chestnut Oak
7 Pagoda Dogwood
3 Catawba Rhododendron
5 Va. Creeper

In boulders, sta. 1077+75
5 Catawba Rhododendron

5 Catawba Rhododendron

15 Catawba Rhododendron
Seedlings
100 Lowbush Blueberry
10 Va. Creeper

CAROL CABOT & FORBES NELSON PROPERTIES
W.R. Matos, Durham, N.C.
Rockfish Valley Land Corp. #3

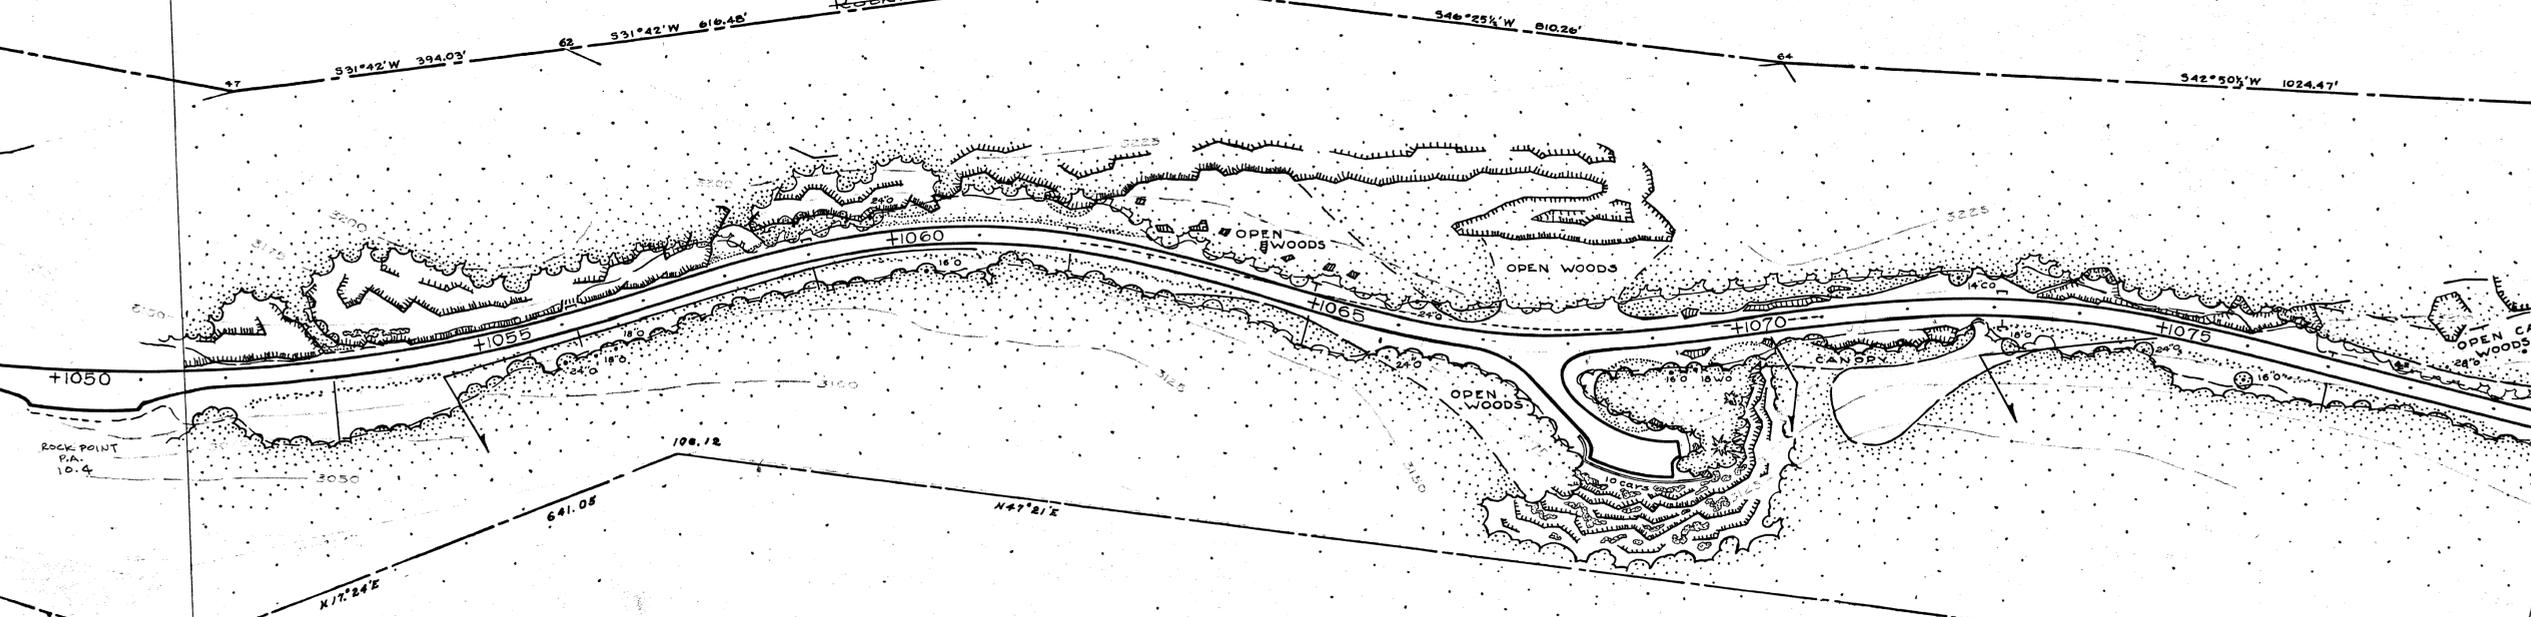

+1050

+1055

+1060

+1065

+1070

+1075

+1080

ROCK POINT P.A. 10.4

HIGHCLIFF PARKING OVERLOOK
SEE PLAN NO. PKY-BR-1C-2004
EVENING POST 10.7

MATCH LINE

Seedlings
25 Frost Grape

Seedlings
100 Beaked Filbert
100 Common Witch-hazel
200 Smooth Sumac
100 Catawba Rhodo.
200 Roses (native spp.)
50 Am. Elder
25 Fl. Dogwood
25 Blackhaw Viburnum

9 Chestnut Oak
3 Red Maple

35 Catawba Rhododendron
7 Mt. Laurel Kalmia
25 Va. Rose
5 Va. Creeper

Seedlings
50 Beaked Filbert
50 Fl. Dogwood
25 Common Witch-hazel
50 Roses (native spp.)

MATCH LINE

SCALE 1" = 100'

GEORGE WASHINGTON NATIONAL FOREST

BASIC DATA ----- STA. 962 to 1071 - AS CONSTRUCTED CENTER LINE

1C-9

CLEARED

REGIONAL DIRECTOR

DESIGNED BY

PLANS AND DESIGN

DATE

ENGINEERING

REVIEWED

RESEARCH AND EDUCATION

SANTATION

FORESTRY

HISTORY

REGIONAL PLANNING AND STATE COOPERATION

RECOMMENDED _____ DATE _____	UNITED STATES DEPARTMENT OF THE INTERIOR NATIONAL PARK SERVICE BRANCH OF PLANS AND DESIGN PREPARED BY ROANOKE, VIRGINIA OFFICE	REGION ONE
CONCURRED _____ DATE _____		SHEET 9 OF 17
APPROVED _____ DATE _____		DRAWING NO. PKY.BR 1C-2062-A
SECTION 1-C		NAME OF JOB STA. 1051+50 to 1080
BLUE RIDGE PARKWAY		LOCATION
MADE OF PARK OR MONUMENT		

TRIM LINE

6-710

1C-10

1C-10

Seedlings
100 Lowbush Blueberry

Seedlings (approx. one per 16 sq. ft.)

- 5 Shagbark Hickory
- 5 Black Tupelo
- 5 Chestnut Oak
- 3 White Oak
- 5 Red Maple
- 10 Am. Hornbeam
- 10 Yellow Poplar
- 60 Shadblow
- 30 Am. Elder
- 25 Sourwood
- 100 Azalea (pink spp.)
- 25 Roses (native spp.)
- 25 N.J. Tea

Seedlings (approx. one per 16 sq. ft.)

- 3 Chestnut Oak
- 3 White Oak
- 3 Red Maple
- 3 Shagbark Hickory
- 5 Yellow Poplar
- 10 Shadblow
- 10 Am. Elder
- 100 Lowbush Blueberry
- 40 Azalea (pink spp.)


Seedlings (approx. one per 16 sq. ft.)

- 5 Chestnut Oak
- 3 White Oak
- 3 Yellow Poplar
- 10 Red Maple
- 5 Shagbark Hickory
- 5 Black Tupelo
- 20 Shadblow
- 20 Beaked Filbert
- 30 Fl. Dogwood
- 30 Azalea (pink spp.)
- 30 N.J. Tea
- 100 Little'l'f Sweetfern
- 200 Lowbush Blueberry
- 25 Va. Creeper

At back edge of bay
Seedlings, one per 25 sq. ft.
in groups,
40 Azalea (pink spp.)
40 Shadblow

GEORGE WASHINGTON NATIONAL FOREST

CABOT CABOT & FORBES NELSON PROPERTIES
W.D. Mattox, Durham, N.C.
Rockfish Valley Land Corporation

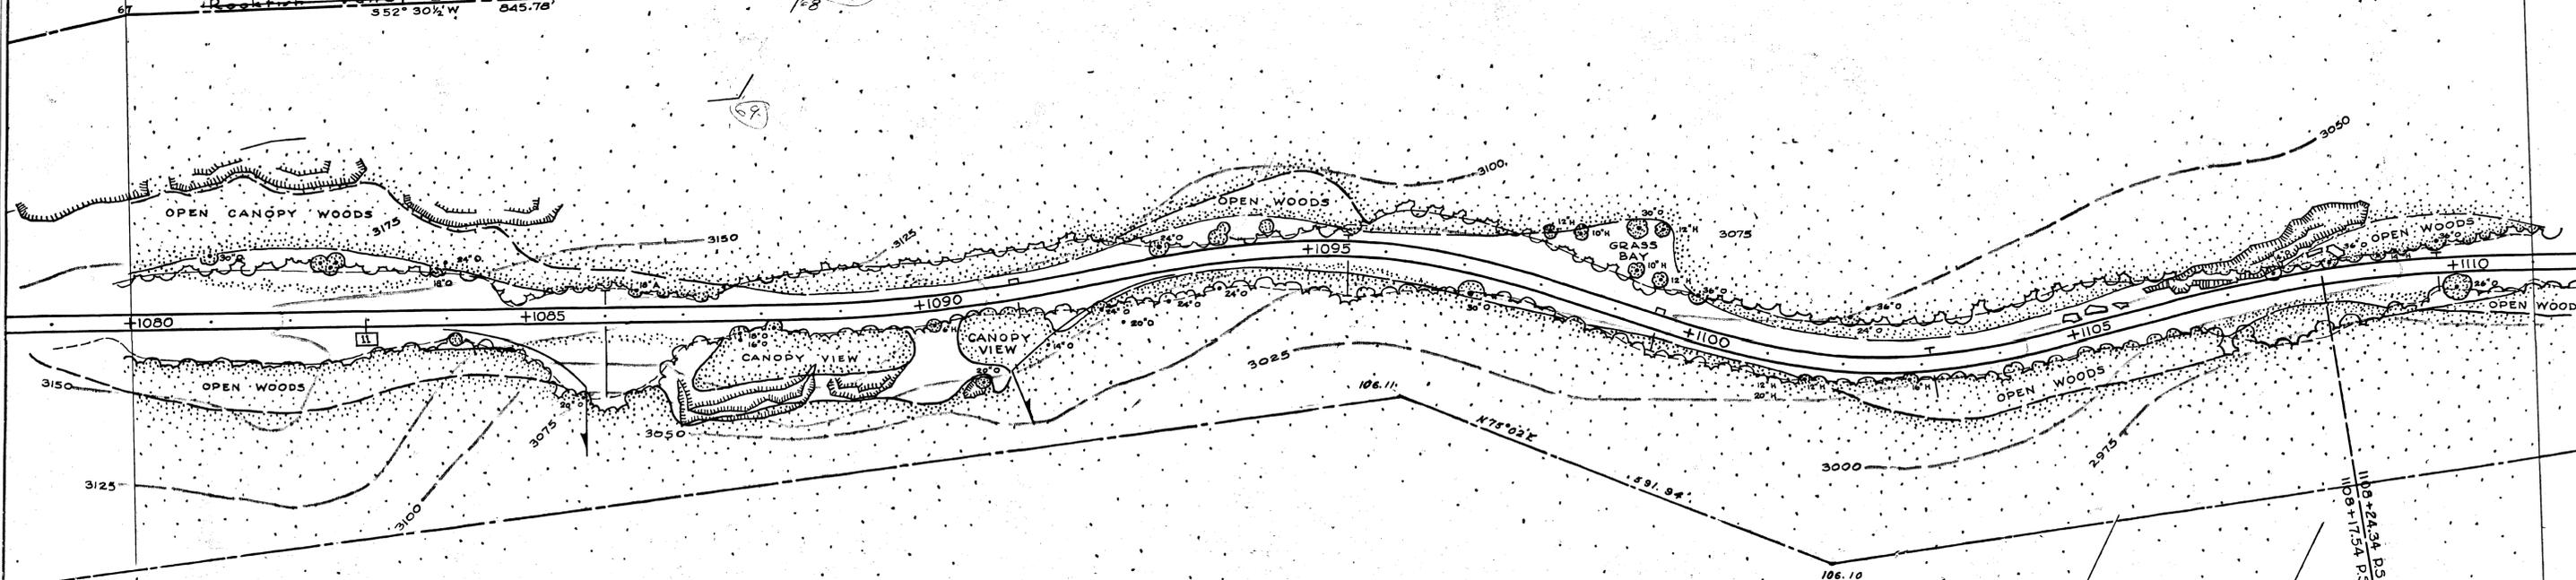

GEORGE WASHINGTON NATIONAL FOREST

Seedlings

- 5 Chestnut Oak
- 5 Shagbark Hickory
- 5 Black Tupelo
- 5 Red Maple
- 5 Sourwood
- 5 Yellow Poplar
- 40 Fl. Dogwood
- 40 Catawba Rhoda
- 30 Beaked Filbert
- 30 Roses (native spp.)
- 30 Am. Elder

3 Chestnut Oak
3 Black Oak
2 Red Maple

5 Chestnut Oak 5'-7'
3 Black Oak 5'-7'
2 Red Maple 5'-7'

Seedlings
75 Frost Grape
30 Roses (native spp.)

Seedlings (approx. one per 50 sq. ft.)

- 5 Yellow Poplar
- 5 Chestnut Oak
- 5 White Oak
- 5 Shagbark Hickory
- 5 Red Maple
- 5 Black Tupelo
- 5 Sourwood
- 30 Catawba Rhoda
- 30 Beaked Filbert
- 30 Va. Rose



CLEARED	REGIONAL DIRECTOR
REVIEWED	RESEARCH AND EDUCATION
DESIGNED BY	PLANS AND DESIGN
DATE	3/23/44
ENGINEERING	HISTORY

BASIC DATA

RECOMMENDED	DATE
CONCURRED	DATE
APPROVED	DATE

UNITED STATES
DEPARTMENT OF THE INTERIOR
NATIONAL PARK SERVICE
BRANCH OF PLANS AND DESIGN
ROANOKE VIRGINIA

SECTION 1-0
BLUE RIDGE PARKWAY


NAME OF JOB
STA. 1080 to 1111
LOCATION
NAME OF PARK OR MONUMENT

REGION
ONE
SHEET 10 OF 17
DRAWING NO.
PKY-BR
1C-2063A

1C-10

GEORGE WASHINGTON NATIONAL FOREST

CLEARED
REVISIONAL
PLANNING AND STATE COORDINATION
RESEARCH AND EDUCATION
SANITATION
DESIGNED BY
DATE
3/24/84
ENGINEERING

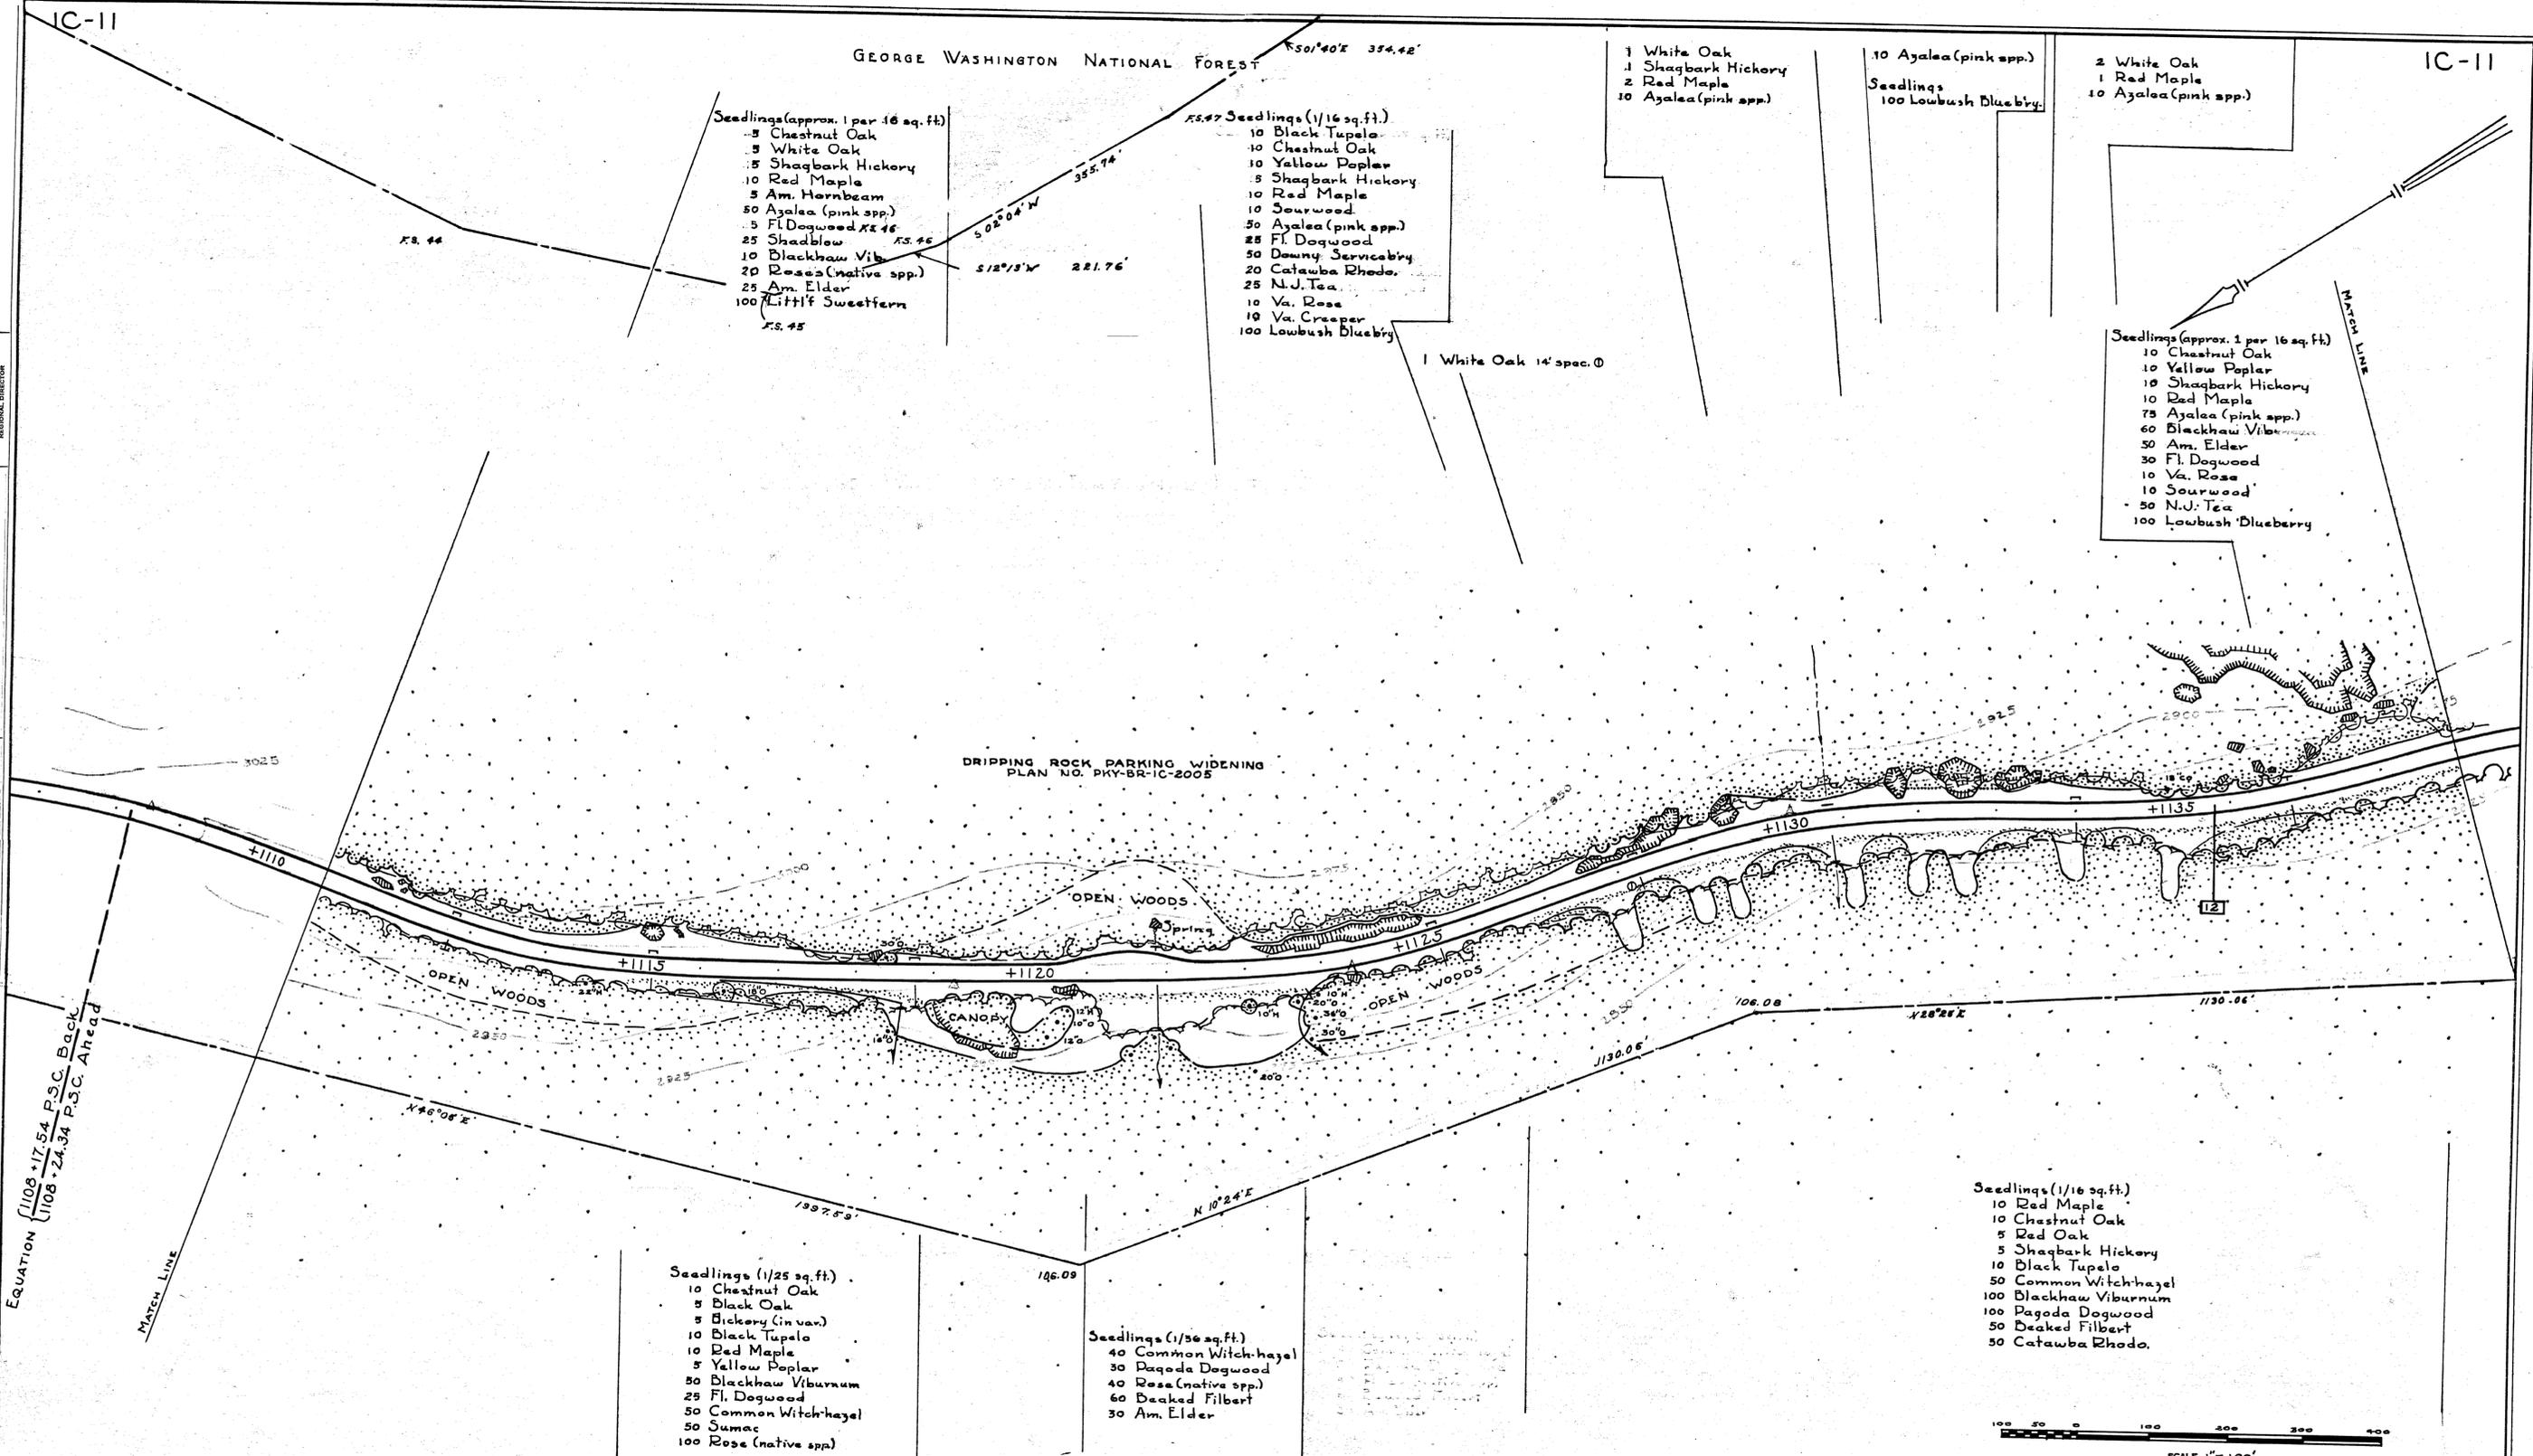

- Seedlings (approx. 1 per 16 sq. ft.)
- 5 Chestnut Oak
 - 5 White Oak
 - 5 Shagbark Hickory
 - 10 Red Maple
 - 5 Am. Hornbeam
 - 50 Ayalea (pink spp.)
 - 5 Fl. Dogwood
 - 25 Shadblow
 - 10 Blackhaw Vib.
 - 20 Rose (native spp.)
 - 25 Am. Elder
 - 100 Little Sweetfern

- Seedlings (1/16 sq. ft.)
- 10 Black Tupelo
 - 10 Chestnut Oak
 - 10 Yellow Poplar
 - 5 Shagbark Hickory
 - 10 Red Maple
 - 10 Sourwood
 - 50 Ayalea (pink spp.)
 - 25 Fl. Dogwood
 - 50 Downy Serviceberry
 - 20 Catawba Rhodo.
 - 25 N.J. Tea
 - 10 Va. Rose
 - 10 Va. Creeper
 - 100 Lowbush Blueberry

- 1 White Oak
- 1 Shagbark Hickory
- 2 Red Maple
- 10 Ayalea (pink spp.)

- Seedlings
- 100 Lowbush Blueberry

- 2 White Oak
- 1 Red Maple
- 10 Ayalea (pink spp.)


- Seedlings (approx. 1 per 16 sq. ft.)
- 10 Chestnut Oak
 - 10 Yellow Poplar
 - 10 Shagbark Hickory
 - 10 Red Maple
 - 75 Ayalea (pink spp.)
 - 60 Blackhaw Vib.
 - 50 Am. Elder
 - 30 Fl. Dogwood
 - 10 Va. Rose
 - 10 Sourwood
 - 50 N.J. Tea
 - 100 Lowbush Blueberry

- Seedlings (1/25 sq. ft.)
- 10 Chestnut Oak
 - 5 Black Oak
 - 5 Hickory (in var.)
 - 10 Black Tupelo
 - 10 Red Maple
 - 5 Yellow Poplar
 - 50 Blackhaw Viburnum
 - 25 Fl. Dogwood
 - 50 Common Witch-hazel
 - 50 Sumac
 - 100 Rose (native spp.)

- Seedlings (1/30 sq. ft.)
- 40 Common Witch-hazel
 - 30 Pagoda Dogwood
 - 40 Rose (native spp.)
 - 60 Beaked Filbert
 - 30 Am. Elder

- Seedlings (1/16 sq. ft.)
- 10 Red Maple
 - 10 Chestnut Oak
 - 5 Red Oak
 - 5 Shagbark Hickory
 - 10 Black Tupelo
 - 50 Common Witch-hazel
 - 100 Blackhaw Viburnum
 - 100 Pagoda Dogwood
 - 50 Beaked Filbert
 - 50 Catawba Rhodo.

EQUATION
 $\frac{1108 + 17.54 P.S.C. \text{ Back}}{1108 + 24.34 P.S.C. \text{ Ahead}}$

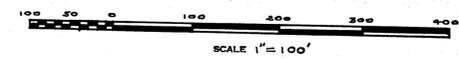

GEORGE WASHINGTON NATIONAL FOREST

RECOMMENDED _____ DATE _____	UNITED STATES DEPARTMENT OF THE INTERIOR NATIONAL PARK SERVICE BRANCH OF PLANS AND DESIGN PREPARED BY ROANOKE VIRGINIA OFFICE	REGION ONE
CONCURRED _____ DATE _____		SHEET 11 OF 17
APPROVED _____ DATE _____		DRAWING NO. PKY-BR IC-2063-A
SECTION IC LOCATION BLUE RIDGE PARKWAY <small>NAME OF PARK OR MONUMENT</small>		NAME OF JOB STA. 1111 TO 1130 <small>NAME OF PARK OR MONUMENT</small>

IC-12

IC-12

- Seedlings (1/16 sq.ft.)
- 10 Yellow Poplar
 - 10 White Oak
 - 15 Chestnut Oak
 - 15 Black Gum
 - 10 Shagbark Hickory
 - 10 Red Maple
 - 10 Sourwood
 - 15 Am. Hornbeam
 - 75 Fl. Dogwood
 - 75 Shadblow
 - 100 Catawba Rhododendron
 - 50 Blackhaw Viburnum
 - 50 Am. Elder
 - 25 Beaked Filbert
 - 250 Loubush Blueberry

- Seedlings (1/16 sq.ft.)
- 10 Sourwood
 - 10 Black Tupelo
 - 40 White Oak
 - 10 Yellow Poplar
 - 10 Shagbark Hickory
 - 45 Am. Hornbeam
 - 75 Fl. Dogwood
 - 75 Shadblow
 - 30 Common Witch-hazel
 - 30 Blackhaw Viburnum
 - 10 Am. Elder
 - 30 Rosa (native spp.)
 - 30 N.J. Tea

- Seedlings (approx. 1 per 16 sq.ft.)
- 10 White Oak
 - 5 Red Maple
 - 10 Shagbark Hickory
 - 5 Am. Hornbeam
 - 40 Fl. Dogwood
 - 25 Shadblow
 - 15 Sourwood
 - 10 Yellow Poplar
 - 10 Black Tupelo
 - 15 Blackhaw Viburnum
 - 30 Rosa (native spp.)

- Seedlings (1/16 sq.ft.)
- 20 White Oak
 - 10 Black Oak
 - 20 Shadblow
 - 20 Catawba Rhododendron
 - 10 Va. Rose
 - 200 Loubush Blueberry

- Seedlings (1/36 sq.ft.)
- 30 Fl. Dogwood
 - 75 Beaked Filbert
 - 50 Blackhaw Viburnum
 - 75 Common Witch-hazel

- Seedlings (1/36 sq.ft.)
- 5 Chestnut Oak
 - 5 Black Oak
 - 5 Yellow Poplar
 - 5 Black Tupelo
 - 5 Red Maple
 - 20 Am. Elder
 - 20 Witch-hazel
 - 20 Fl. Dogwood

- 6 Chestnut Oak 12 spec. Ⓞ
- 2 Red Maple 10 spec. Ⓞ
- Seedlings (1/50 sq.ft.)
- 50 Fl. Dogwood
- 100 Virginia Creeper
- 50 Blackhaw Viburnum
- 50 Am. Elder

3 Chestnut Oak

GEORGE WASHINGTON NATIONAL FOREST

GEORGE WASHINGTON NATIONAL FOREST

SCALE OF INSERT
1" = 200'

SCALE 1" = 100'

CLEARED

DESIGNED BY
W.A.L.
DATE
3/15/44

REVIEWED

FORESTRY

HISTORY

PLANS AND DESIGN

ENGINEERING

RESEARCH AND EDUCATION

PLANNING AND STATE COOPERATION

REGIONAL DIRECTOR

BASIC DATA ----- STA. 1165 to 1169 - AS CONSTRUCTED CENTER LINE

RECOMMENDED _____ DATE _____

CONCURRED _____ DATE _____

APPROVED _____ DATE _____

UNITED STATES
DEPARTMENT OF THE INTERIOR
NATIONAL PARK SERVICE
BRANCH OF PLANS AND DESIGN
PREPARED BY
ROANOKE VIRGINIA
OFFICE

SECTION I-C
BLUE RIDGE PARKWAY

NAME OF JOB
STA. 1139 to 1169

LOCATION
NAME OF PARK OR MONUMENT

REGION
ONE

SHEET 12 OF 17

DRAWING NO.
PKY BR
IC-2063-A

IC-12

IC-12

TRIM LINE

TRIM LINE

IC-13

IC-13

- Seedlings (Approx. 1 per 10 sq. ft.)
- 5 Chestnut Oak
 - 3 White Oak
 - 5 Yellow Poplar
 - 3 Red Maple
 - 10 Shadblow
 - 25 Catawba Rhododendron

- Seedlings
- 30 N.J. Tea
 - 50 Blueberry
 - 10 Azalea (pink app)
 - 5 Va. Creeper


- On top of cut
- 5 Shadblow
 - 10 Catawba Rhododendron
 - 10 Va. Creeper
 - 20 Lowbush Blueberry

- Seedlings (Approx. 1 per 80 sq. ft.)
- 5 Chestnut Oak
 - 5 White Oak
 - 5 Red Maple
 - 5 Shagbark Hickory
 - 5 Tulip Tree
 - 25 Fl. Dogwood
 - 10 Common Witchhazel
 - 10 Blackhaw Viburnum

Leave a few canopy trees in front of new woods line

Leave dogwoods

Spring (Approx. location)

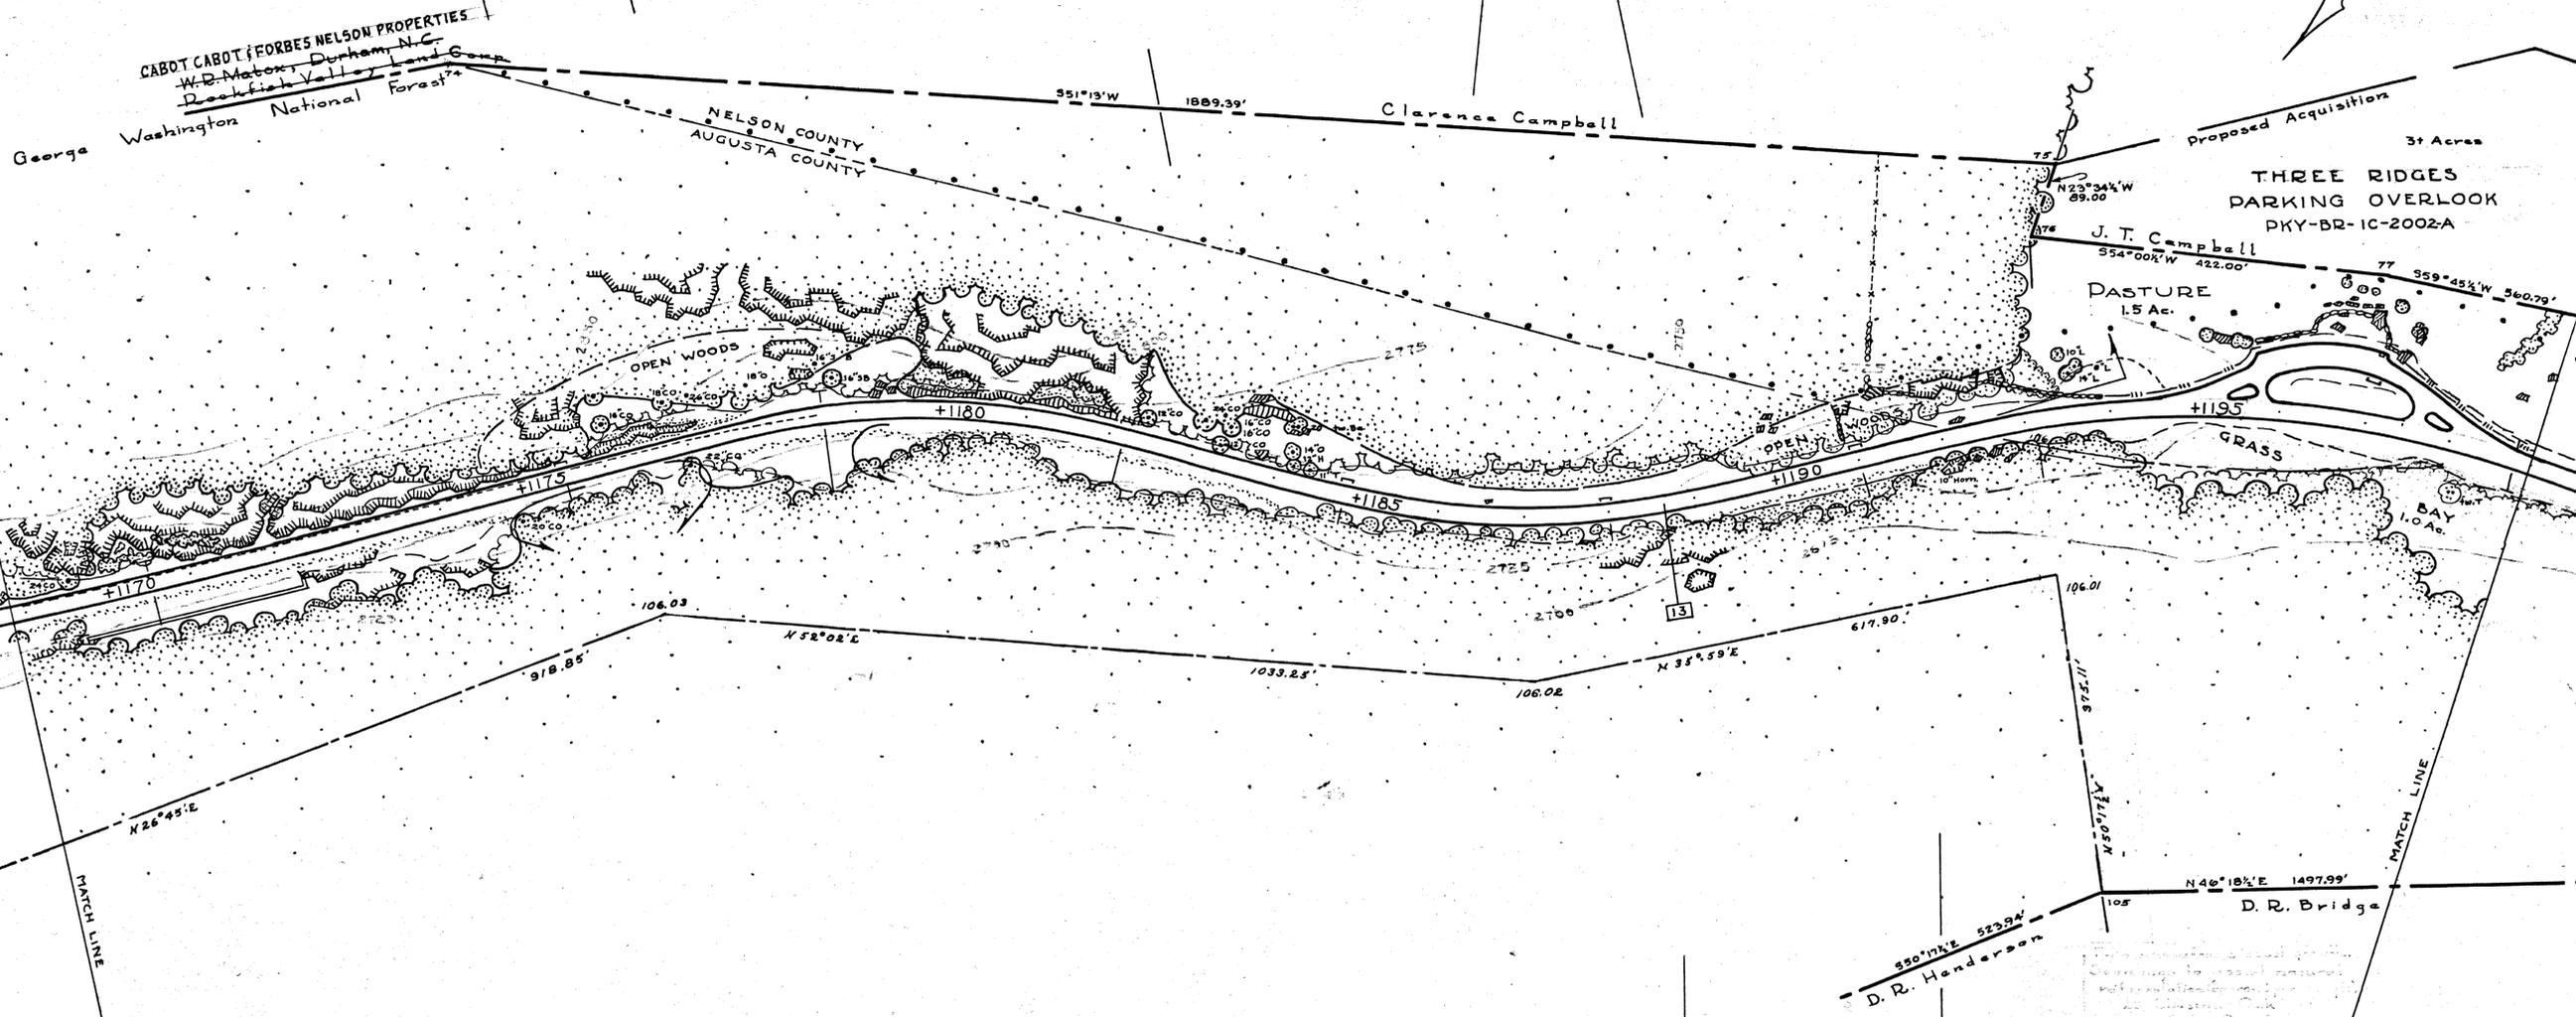

CABOT CABOT FORBES NELSON PROPERTIES
 W.D. Mattox, Durham, N.C.
 Brookfield Valley Land Comp.

NELSON COUNTY
 AUGUSTA COUNTY

Clarence Campbell

Proposed Acquisition

THREE RIDGES
 PARKING OVERLOOK
 PKY-BR-IC-2002-A

PASTURE 1.5 Ac.

GRASS

BAY 1.0 Ac.

D.R. Bridge

D. R. Henderson

- Seedlings (1/50 sq. ft.)
- 5 Chestnut Oak
 - 3 Red Maple
 - 3 Red Oak
 - 5 Sourwood
 - 20 Viburnum (Blackhaw)
 - 20 Am. Elder

- Seedlings
- 75 Frost Grape
 - 75 Va. Creeper

- Seedlings
- 20 Roses (native spp.)
 - 25 Frost Grape
 - 20 Va. Creeper

- Seedlings
- 30 Roses (native spp.)
 - 25 Fl. Dogwood
 - 25 Va. Creeper



DESIGNED BY: [] DATE: 3/29/24
 PLANS AND DESIGN: []
 ENGINEERING: []
 REVIEWED: []
 RESEARCH AND EDUCATION: []
 RECREATIONAL PLANNING AND STATE COOPERATION: []
 REGIONAL DIRECTOR: []
 CLEARED: []

BASIC DATA ----- STA. 1169 to 1179-AS CONSTRUCTED CENTER LINE

RECOMMENDED	DATE
CONCURRED	DATE
APPROVED	DATE

UNITED STATES
 DEPARTMENT OF THE INTERIOR
 NATIONAL PARK SERVICE
 BRANCH OF PLANS AND DESIGN
 ROANOKE VIRGINIA OFFICE

SECTION 1-C
 BLUE RIDGE PARKWAY

NAME OF JOB: STA. 1169 to 1199
 LOCATION: []
 NAME OF PARK OR MONUMENT: []

REGION ONE
 SHEET 13 OF 17
 DRAWING NO. PKY BR IC-2062-A

IC-13

IC-15

IC-15

- Seedlings (approx. 1 per 25 sq. ft.)
- 5 Chestnut Oak
 - 5 Black Oak
 - 5 Shagbark Hickory
 - 5 Yellow Poplar
 - 5 Red Maple
 - 50 Azalea (pink app.)
 - 15 Fl. Dogwood
 - 15 N.J. Tea

- Seedlings (approx. 1 per 16 sq. ft.)
- 10 Chestnut Oak
 - 10 Black Oak
 - 10 White Oak
 - 10 Red Maple
 - 10 Yellow Poplar
 - 5 Shagbark Hickory
 - 150 Littlelf Sweetfern
 - 75 Mt. Laurel Kalmia
 - 50 Catawba Rhododendron
 - 50 Va. Creeper
- At road side
- 4 Chestnut Oak @ 12' spp.
 - 1 Red Maple @ 12' spp.
 - 11 Mt. Laurel Kalmia

- Seedlings (approx. 1 per 16 sq. ft.)
- 10 Chestnut Oak
 - 5 White Oak
 - 10 Red Maple
 - 5 Shagbark Hickory
 - 75 Littlelf Sweetfern
 - 100 Mt. Laurel Kalmia
 - 50 Catawba Rhododendron
 - 20 Va. Creeper

- Seedlings (approx. 1 per 16 sq. ft.)
- 5 Chestnut Oak
 - 5 White Oak
 - 5 Black Oak
 - 5 White Oak
 - 5 Red Maple
 - 5 Yellow Poplar
 - 5 Shagbark Hickory
 - 60 Littlelf Sweetfern
 - 40 Mt. Laurel Kalmia
 - 15 Fl. Dogwood
 - 25 N.J. Tea

CLEARED


REVIEWED

DESIGNED BY

DATE

4/19/44

BASIC DATA

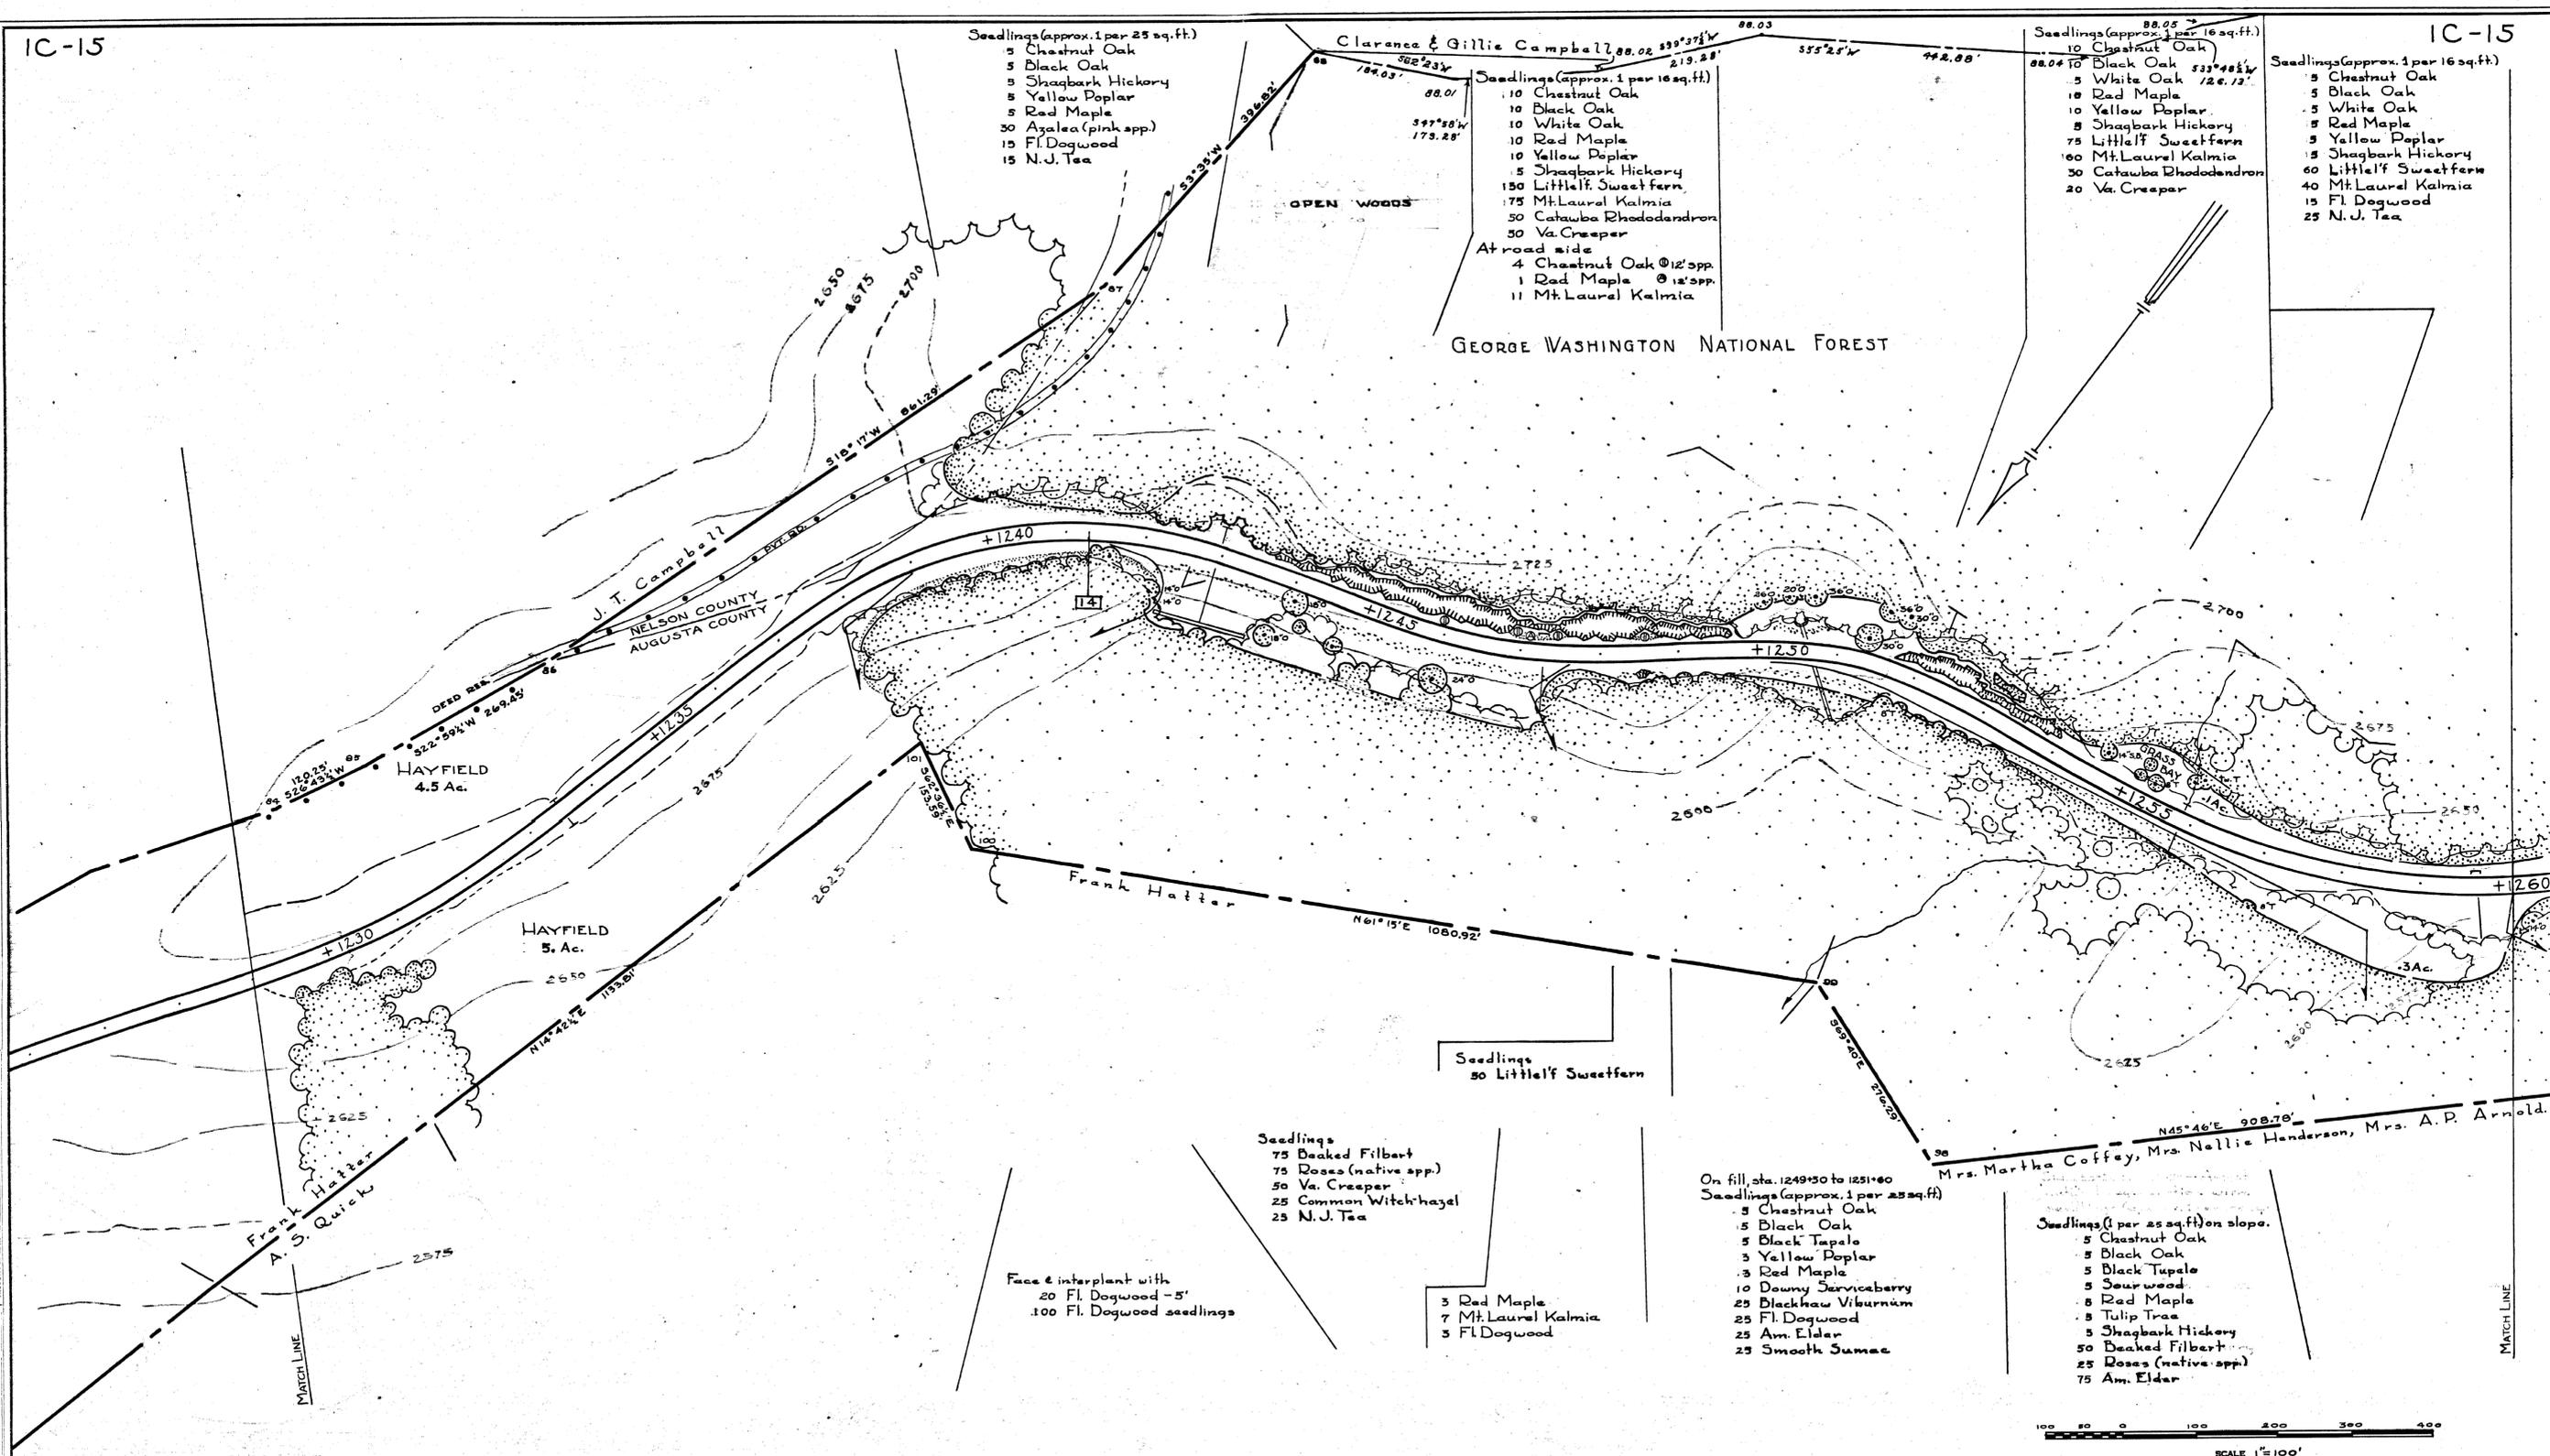

Face & interplant with

- 20 Fl. Dogwood - 5'
- 100 Fl. Dogwood seedlings

- Seedlings
- 75 Beaked Filbert
 - 75 Roses (native app.)
 - 50 Va. Creeper
 - 25 Common Witch-hazel
 - 25 N.J. Tea

- 3 Red Maple
- 7 Mt. Laurel Kalmia
- 5 Fl. Dogwood

- On fill, sta. 1249+50 to 1251+00
- Seedlings (approx. 1 per 25 sq. ft.)
- 5 Chestnut Oak
 - 5 Black Oak
 - 5 Black Tupelo
 - 3 Yellow Poplar
 - 3 Red Maple
 - 10 Downy Serviceberry
 - 25 Blackhaw Viburnum
 - 25 Fl. Dogwood
 - 25 Am. Elder
 - 25 Smooth Sumac

- Seedlings (1 per 25 sq. ft.) on slope.
- 5 Chestnut Oak
 - 5 Black Oak
 - 5 Black Tupelo
 - 5 Sourwood
 - 5 Red Maple
 - 5 Tulip Tree
 - 5 Shagbark Hickory
 - 50 Beaked Filbert
 - 25 Roses (native app.)
 - 75 Am. Elder

SCALE 1"=100'

RECOMMENDED _____ DATE _____	UNITED STATES DEPARTMENT OF THE INTERIOR NATIONAL PARK SERVICE BRANCH OF PLANS AND DESIGN PREPARED BY ROANOKE VIRGINIA OFFICE SECTION 1-C NAME OF JOB STA. 1220+1260+25 LOCATION BLUE RIDGE PARKWAY NAME OF PARK OR MONUMENT	REGION ONE
CONCURRED _____ DATE _____		SHEET 15 OF 17
APPROVED _____ DATE _____		DRAWING NO. DKY BR IC-2062A

IC-15

IC-16

IC-16

- Seedlings (approx. 1 per 16 sq. ft.)
- 15 Chestnut Oak
- 10 Black Oak
- 10 Black Tupelo
- 10 Red Maple
- 10 Yellow Poplar
- 5 Shagbark Hickory
- 150 Lowbush Blueberry
- 75 Mt. Laurel Kalmia
- 50 Fl. Dogwood
- 5 Sourwood
- 5 Am. Hornbeam
- 50 Downy Serviceberry
- 50 Alt. Lvd. Dogwood
- 50 Ayalea (Pink spp.)
- 150 Sweetfern

- 1 Red Maple @ 8'
- 5 Fl. Dogwood 3'-5'


- Seedlings (approx. 1 per 10 sq. ft.)
- 10 Chestnut Oak
- 10 Black Oak
- 10 Black Tupelo
- 10 Red Maple
- 10 Yellow Poplar
- 10 Shagbark Hickory
- 100 Lowbush Blueberry
- 50 Mt. Laurel Kalmia
- 25 Fl. Dogwood
- 50 Ayalea (pink spp.)
- 25 Alt. Lvd. Dogwood
- 100 Littleleaf Sweetfern
- 25 Downy Serviceberry
- 50 N. J. Tea

Scatter at back edge of bay
60 Ayalea (pink spp.) Seedlings.

- Seedlings (approx. 1 per 10 sq. ft.)
- 50 Chestnut Oak
- 50 Black Oak
- 25 White Oak
- 25 Red Maple
- 15 Black Tupelo
- 15 Shagbark Hickory
- 200 Lowbush Blueberry
- 200 Ayalea
- 125 Fl. Dogwood
- 50 Mt. Laurel Kalmia
- 75 Downy Serviceberry
- 150 Sweetfern
- 50 N. J. Tea

SCALE OF INSERT
1" = 200'

GEORGE WASHINGTON NATIONAL FOREST

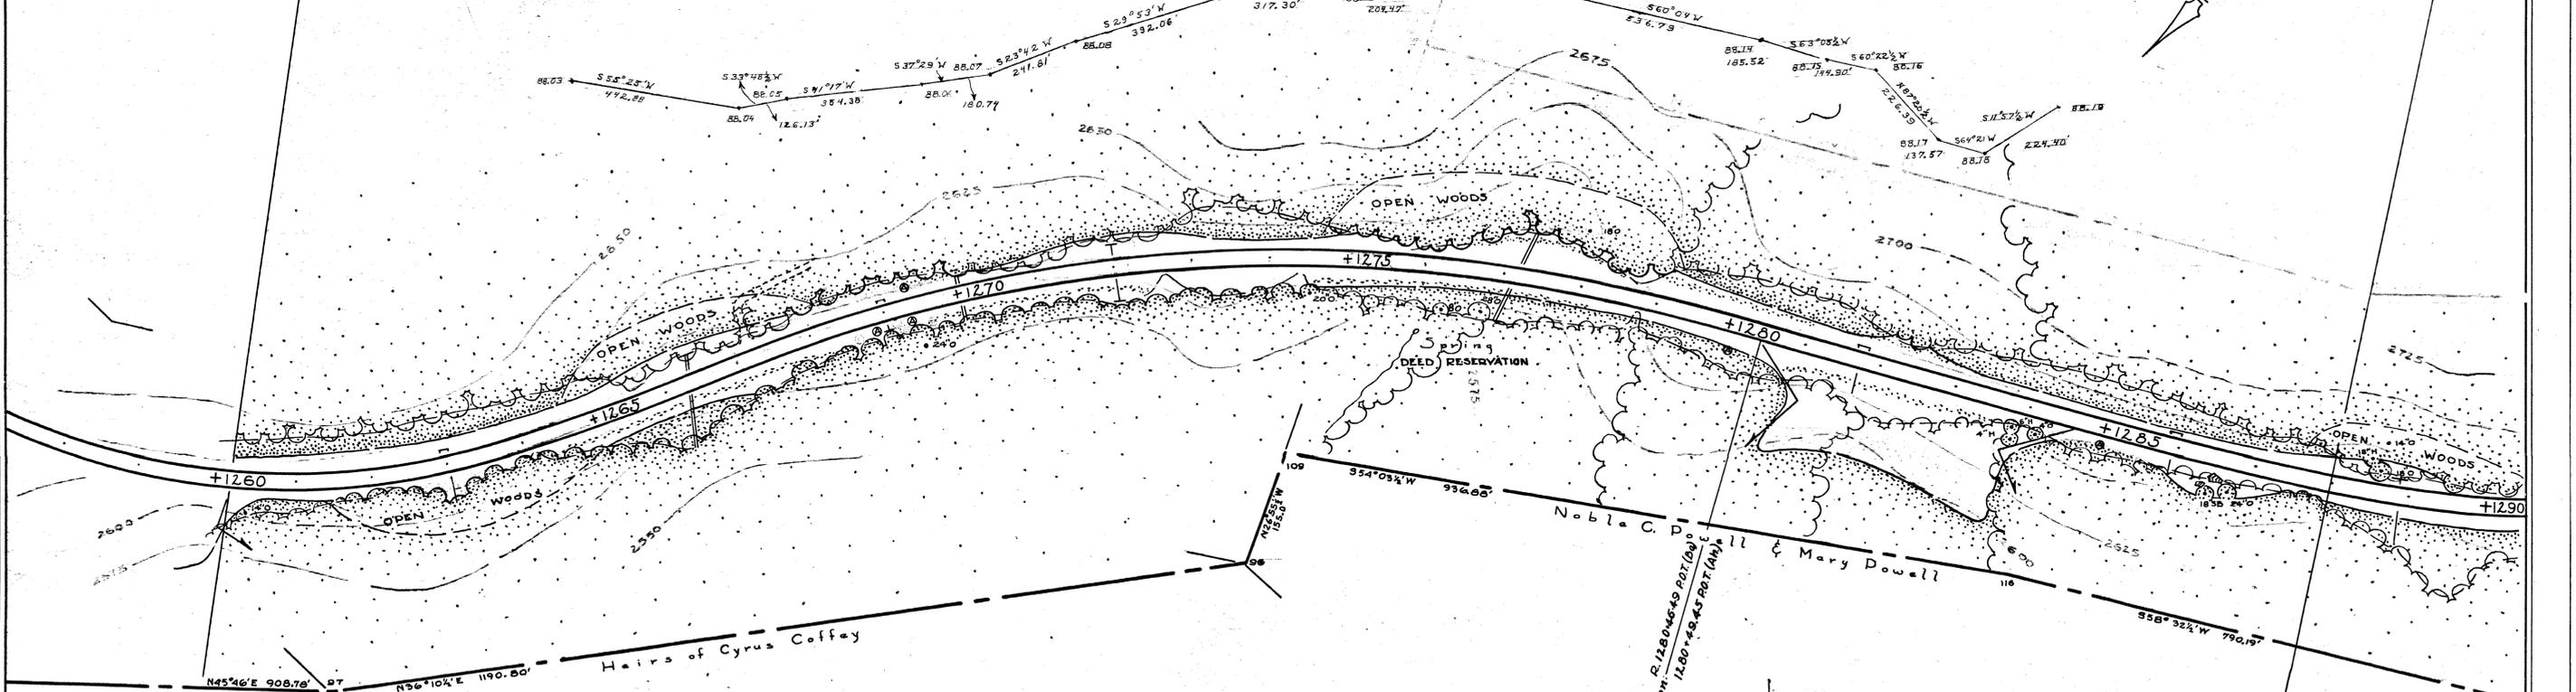

Mrs. Nellie Henderson
Mrs. Martha Coffey
Mrs. A. P. Arnold

Hairs of Cyrus Coffey

Noble C. P. Mary Dowell

- Seedlings (1/50 sq. ft.)
- 30 Staghorn Sumac
- 50 Beaked Filbert
- 50 Witch-hazel
- 30 Alt. Lvd. Dogwood


- 1 Red Maple @ 12'
- 5 Fl. Dogwood

- Seedlings (1/50 sq. ft.)
- 3 Chestnut Oak
- 3 Black Oak
- 3 Black Tupelo
- 3 Red Maple
- 25 Ayalea (pink spp.)
- 50 Fl. Dogwood
- 25 Roses (native spp.)
- 50 Am. Elder
- 25 Alt. Lvd. Dogwood
- 2 Red Maple 15' spec. @

- Seedlings (approx. 1 per 50 sq. ft.)
- 10 Chestnut Oak
- 5 Black Oak
- 5 White Oak
- 5 Red Maple
- 5 Yellow Poplar
- 5 Black Tupelo
- 10 Sourwood
- 10 Am. Hornbeam
- 60 Smooth Sumac
- 25 Fl. Dogwood
- 75 Alt. Lvd. Dogwood
- 25 Downy Serviceberry
- 25 Common Witch-hazel

- 1 Red Maple @ 10'
- 5 Fl. Dogwood 3'-5'
- 7 Ayalea (pink spp.) 2'-4'

15 Fl. Dogwood 4'

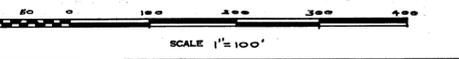

DESIGNED BY: [Blank]

DATE: 4/20/44

ENGINEERING: [Blank]

HISTORY: [Blank]

FORRESTRY: [Blank]

RESEARCH AND EDUCATION: [Blank]

PLANNING AND STATE COOPERATION: [Blank]

REGIONAL DIRECTOR: [Blank]

REVIEWED: [Blank]

CLEARED: [Blank]

BASIC DATA

RECOMMENDED	DATE
CONCURRED	DATE
APPROVED	DATE

UNITED STATES
DEPARTMENT OF THE INTERIOR
NATIONAL PARK SERVICE
BRANCH OF PLANS AND DESIGN
PREPARED BY
ROANOKE VIRGINIA OFFICE

NAME OF JOB: SECTION 1-C
LOCATION: STA. 1260+25 to 1288
NAME OF PARK OR MONUMENT: BLUE RIDGE PARKWAY

REGION ONE
SHEET 16 OF 17
DRAWING NO. PKY. BD
IC-2062A

IC-16

IC-17

IC-17

GEORGE WASHINGTON NATIONAL FOREST

Add 7 Fl. Dogwood - 5' spec.



- 88.13 Seedlings (approx. 1 per 16 sq.ft.)
- 50 Chestnut Oak
 - 25 Black Oak
 - 10 Yellow Poplar
 - 10 Black Tupelo
 - 25 Red Maple
 - 10 Shagbark Hickory
 - 10 Sourwood
 - 50 Downy Serviceberry
 - 100 Fl. Dogwood
 - 100 Azalea (pink spp)
 - 150 Mt. Laurel Kalmia
 - 10 Am. Hornbeam
 - 200 Littleleaf Sweetfern
 - 200 Lowbush Blueberry
 - 100 N.J. Tea

- At woods edge
- 5 Fl. Dogwood - 3'-4'
 - 10 Azalea (pink spp) 2'-3'
 - 10 Mt. Laurel Kalmia 2'-3'

SCALE FOR INSERT
1" = 200'

- Seedlings (approx. 1 per 50 sq.ft.)
- 10 Chestnut Oak
 - 10 Black Oak
 - 5 White Oak
 - 10 Black Tupelo
 - 10 Red Maple
 - 10 Shagbark Hickory
 - 10 Yellow Poplar
 - 25 Downy Serviceberry
 - 50 Fl. Dogwood
 - 50 Azalea (pink spp)
 - 30 Mt. Laurel Kalmia
 - 10 Sourwood
 - 75 Littleleaf Sweetfern
 - 25 Am. Elder
 - 10 Blackhaw Viburnum
 - 50 N.J. Tea

- Thin existing thicket growth.
Assist natural regeneration for
100' width. Seedlings (approx. 1
per 100 sq.ft.)
- 50 Chestnut Oak
 - 30 Black Oak
 - 20 White Oak
 - 10 Yellow Poplar
 - 10 Red Maple
 - 10 Shagbark Hickory
 - 10 Black Tupelo
 - 25 Downy Serviceberry
 - 50 Fl. Dogwood
 - 50 Azalea (pink spp)
 - 50 Mt. Laurel Kalmia

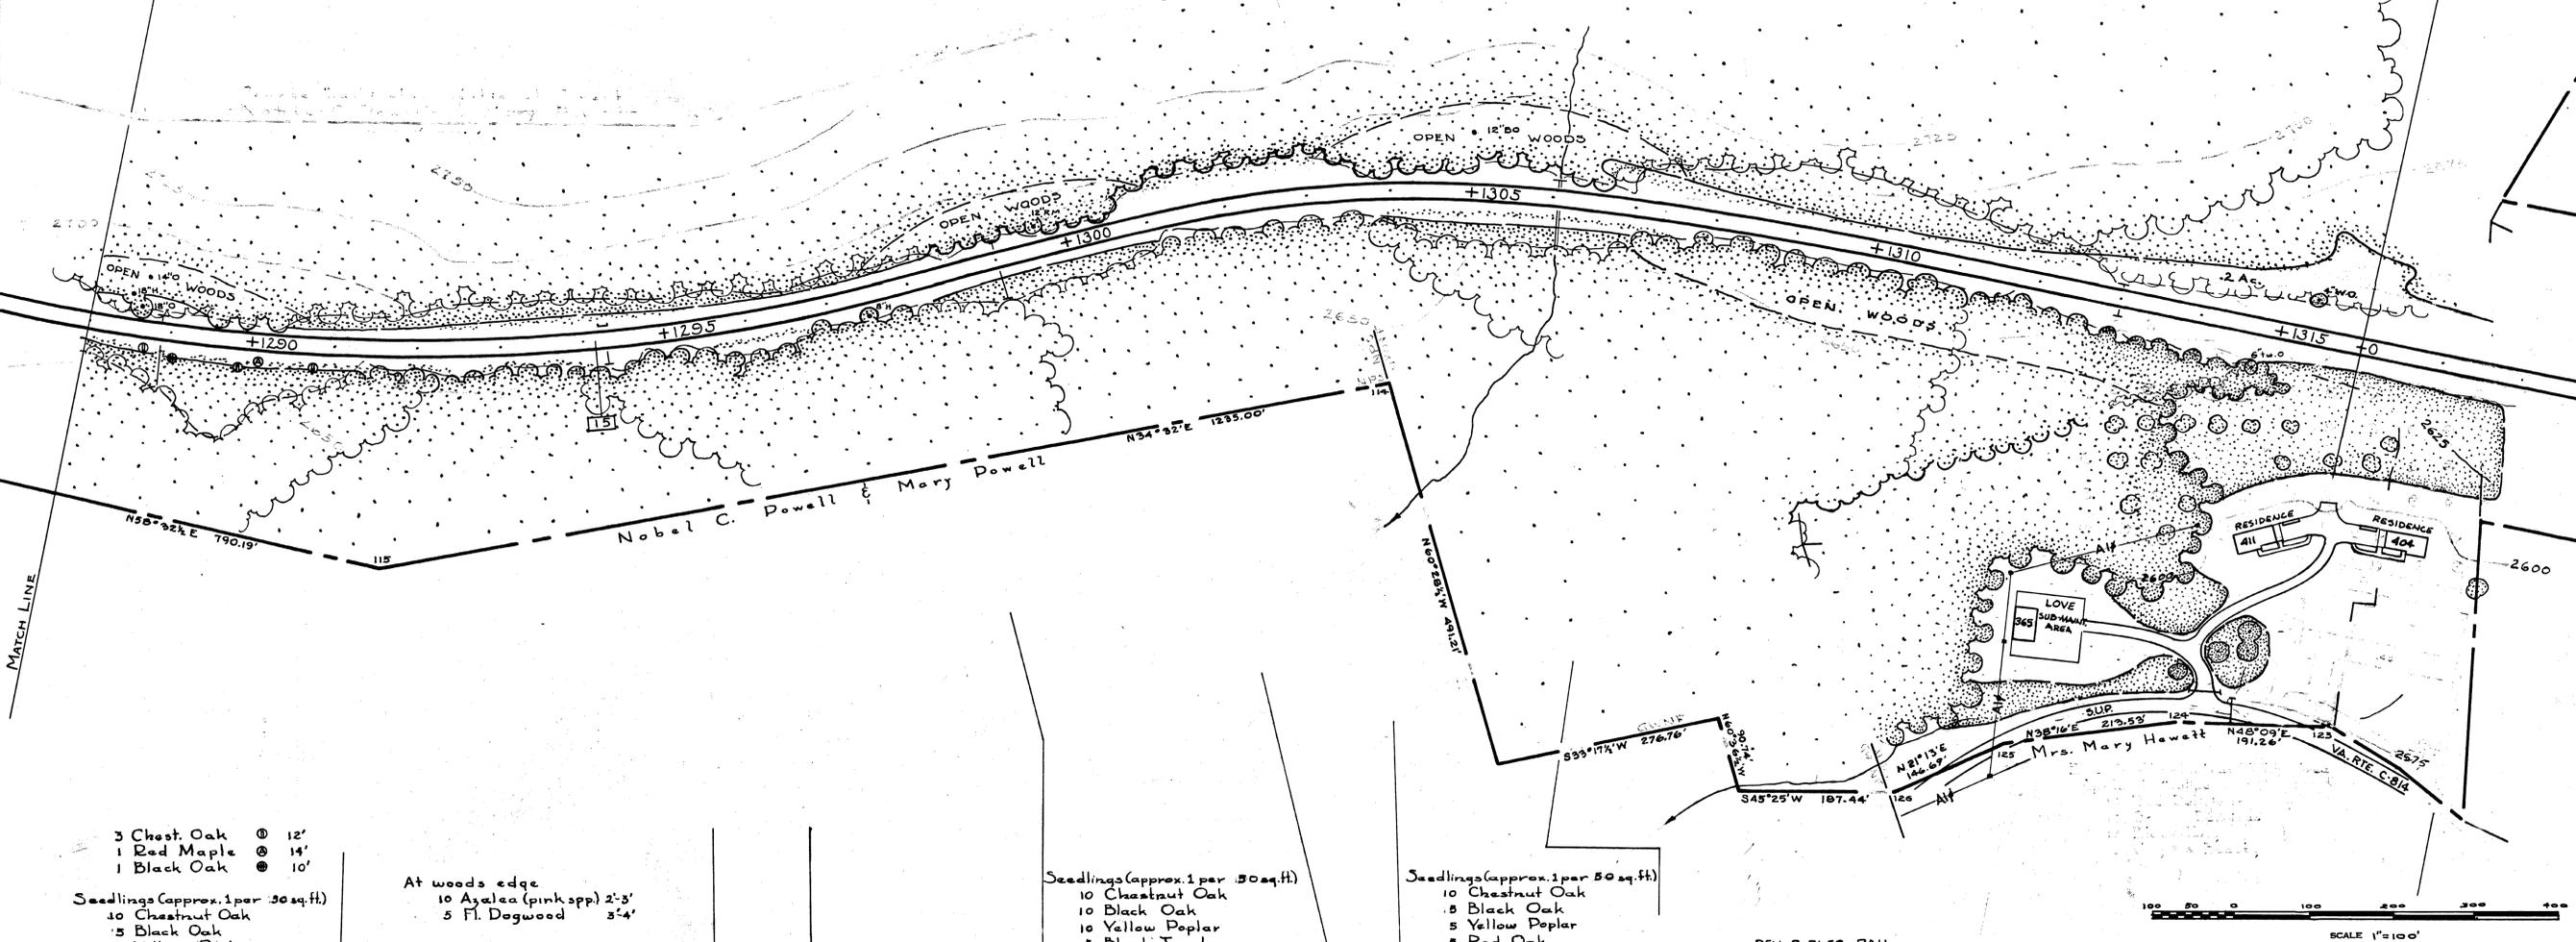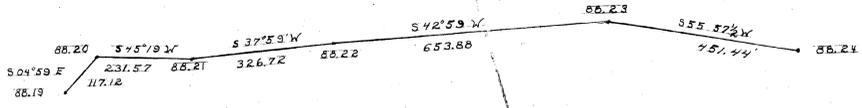

- 3 Chest. Oak @ 12'
 - 1 Red Maple @ 14'
 - 1 Black Oak @ 10'
- Seedlings (approx. 1 per 30 sq.ft.)
- 10 Chestnut Oak
 - 5 Black Oak
 - 5 Yellow Poplar
 - 5 Black Tupelo
 - 5 Red Maple
 - 5 Shagbark Hickory
 - 5 Sourwood
 - 50 Downy Serviceberry
 - 50 Common Witch-hazel
 - 50 Am. Elder
 - 50 N.J. Tea

- At woods edge
- 10 Azalea (pink spp) 2'-3'
 - 5 Fl. Dogwood 3'-4'

Seedlings
50 Fl. Dogwood

- Seedlings (approx. 1 per 50 sq.ft.)
- 10 Chestnut Oak
 - 10 Black Oak
 - 10 Yellow Poplar
 - 5 Black Tupelo
 - 5 Red Maple
 - 5 Sourwood
 - 15 Downy Serviceberry
 - 25 Common Witch-hazel

- Seedlings (approx. 1 per 50 sq.ft.)
- 10 Chestnut Oak
 - 5 Black Oak
 - 5 Yellow Poplar
 - 5 Red Oak
 - 5 Red Maple
 - 5 Black Gum
 - 15 Downy Serviceberry
 - 25 Fl. Dogwood
 - 50 Common Witch-hazel
 - 10 Mt. Laurel Kalmia
 - 50 Am. Elder

SCALE 1" = 100'

REV. 3-21-58 RAH.

RECOMMENDED _____	DATE _____
CONCURRED _____	DATE _____
APPROVED _____	DATE _____

UNITED STATES
DEPARTMENT OF THE INTERIOR
NATIONAL PARK SERVICE
BRANCH OF PLANS AND DESIGN
PREPARED BY
ROANOKE, VIRGINIA OFFICE

NAME OF JOB
SECTION 1-C

LOCATION
BLUE RIDGE PARKWAY

STA. 1288 to 1316

NAME OF PARK OR MONUMENT

REGION
ONE

SHEET 17 OF 17

DRAWING NO.
PKY. BR
IC-2062-A

DESIGNED BY
M.A.J.
DATE
5/19/44

ENGINEERING

FORESTRY

HISTORY

REVIEWED

RESEARCH AND EDUCATION

PLANNING AND DEVELOPMENT

RECREATION

CLEARED

REGIONAL DIRECTOR

IC-17

TRIM LINE

U. S. GOVERNMENT PRINTING OFFICE 16-7110